WORCESTER COUNTY

1 - 150

SHA 51.3 - 8 Revised
4.83

FCR 95

MARYLAND STATE HIGHWAY ADMINISTRATION

ROAD INVENTORY SHEET

Party Chief G.D
Recorder AH
Assistant
Map No./Dir. K-17 / W
State Coordinates 1227 - 161

Road No. Co 1
Road Name ST LUKES RD
County WORCESTER
Date 4/20/95
Sheet No. 1 OF 3

87-19
86-14,15
85-9,10

TRAFFIC CODES
TRAFFIC CONTROLS: STOP SIGN=SS, TRAFFIC LIGHT=T.L., FLASHING RED BALL=F.R.

TRAFFIC CODES
PARKING RESTRICTIONS: A.M. PEAK, P.M. PEAK, A.M./P.M. PEAK, NO PARKING ANYTIME=N.P., COMM/IND. ACCESS=E

SYSTEM				TRAFFIC		LINE DIAGRAM	TRAFFIC			PAVEMENT DATA
FED. AID.	FUNCT. CLASS.	HWY. SYS.	HPMS SAMPLE	PRKG. REST.	COM/IND. ACCESS		CONTROL	COM/IND. ACCESS	PRKG. REST.	
										20'I
										2 ML
						0 94			X	
						0 52				
	Collector					0 33 PT				
						250°				
	Major					0 31 PC				
						PT 0 23				
						30°				
	Rural					PC 0 10				20'I
										2 ML
K						SNOW HILL RD				
						MD 0 00 12	SS		Y	

LINE DIAGRAM

SYSTEM: FED. AID. | FUNCT. CLASS. | HWY. SYS. | HPMS SAMPLE

TRAFFIC: PRKG. REST. | COM/IND ACCESS

TRAFFIC: CONTROL | COM/IND ACCESS | PRKG. REST.

PAVEMENT DATA

Rural — Major Collector

PT 2 27

30°

PC 2 19

GREENBRIAR SWAMP RD

90° CO 3 2 14

2 12 CHURCH

QUAIL LANE

PIT DR 2 00

1 89 48" CMP

PHEASANT LANE

OP 1 1 78

CARDINAL LANE

PVT DR 1 64

1 24 2-60" CMP

20'I

2ML

SHA 51.3 - 8 Revised
4.83

MARYLAND STATE HIGHWAY ADMINISTRATION

ROAD INVENTORY SHEET

2000 COEX!
SS/1Φ
3-1-01

* boundary taken from K-17 1995 Index Map
12/5/97 JMK

Party Chief GD
Recorder AH
Assistant
Map No./Dir. K17 /
State Coordinates

Road No. CO 1
Road Name ST LUKES RD
County WORCESTER
Date 4/20/95
Sheet No. 3 OF 3

TRAFFIC CODES
TRAFFIC CONTROLS: STOP SIGN=SS, TRAFFIC LIGHT=T.L., FLASHING RED BALL=F.R.

TRAFFIC CODES
PARKING RESTRICTIONS: A.M. PEAK, P.M. PEAK, A.M./P.M. PEAK, NO PARKING ANYTIME=N.P., COMM/IND. ACCESS=E

SYSTEM				TRAFFIC		LINE DIAGRAM	TRAFFIC			PAVEMENT DATA
FED. AID.	FUNCT CLASS.	HWY. SYS.	HPMS SAMPLE	PRKG. REST.	COM/IND. ACCESS		CONTROL	COM/IND. ACCESS	PRKG. REST.	
	Major Collector					CO 208				
						SIGN: WICOMICO CO LINE				
						~~WORCESTER~~ 3 60 CO LINE				
						.06 WICOMICO WORCESTER 3 54 CO LINE / CO LINE				
						STEVENS RD — POCOMOKE RD				
						CO 4 — 3 44 — CO 14				
						COULBOURNE MILL RD 2				
						2 50 CO 70°				
						2 38 CHURCH				
						POWERLINES OVERHEAD 2 33				
	Rural									20' I 2 ML

SYSTEM				TRAFFIC		LINE DIAGRAM	TRAFFIC			PAVEMENT DATA
FED. AID.	FUNCT. CLASS.	HWY. SYS.	HPMS SAMPLE	PRK.G. REST.	COM/IND ACCESS		CONTROL	COM/IND ACCESS	PRK.G. REST.	

SHA 51.3-8
11-15-72

STATE HIGHWAY ADMINISTRATION OF MARYLAND

*boundary taken from K-17 1995 INDEX MAP 12/5/97 BMK

-94-12 1-11-95 GD/TM

2000 CO EXT 25/AD 3-1-01 X

T. LANDON F. RHODES VERIFIED 4/26/77

ROAD INVENTORY SHEET

Party Chief _____
Recorder _____
Helper C. MARTIN

Map No. GH 24
K17

Road No. CO 2 (Coulbourne Mill Rd)
Road Name ~~DYKES RD~~
Sheet No. 1 OF 1
Date 8-26-74
County WORCESTER
State Coordinates 1217-167

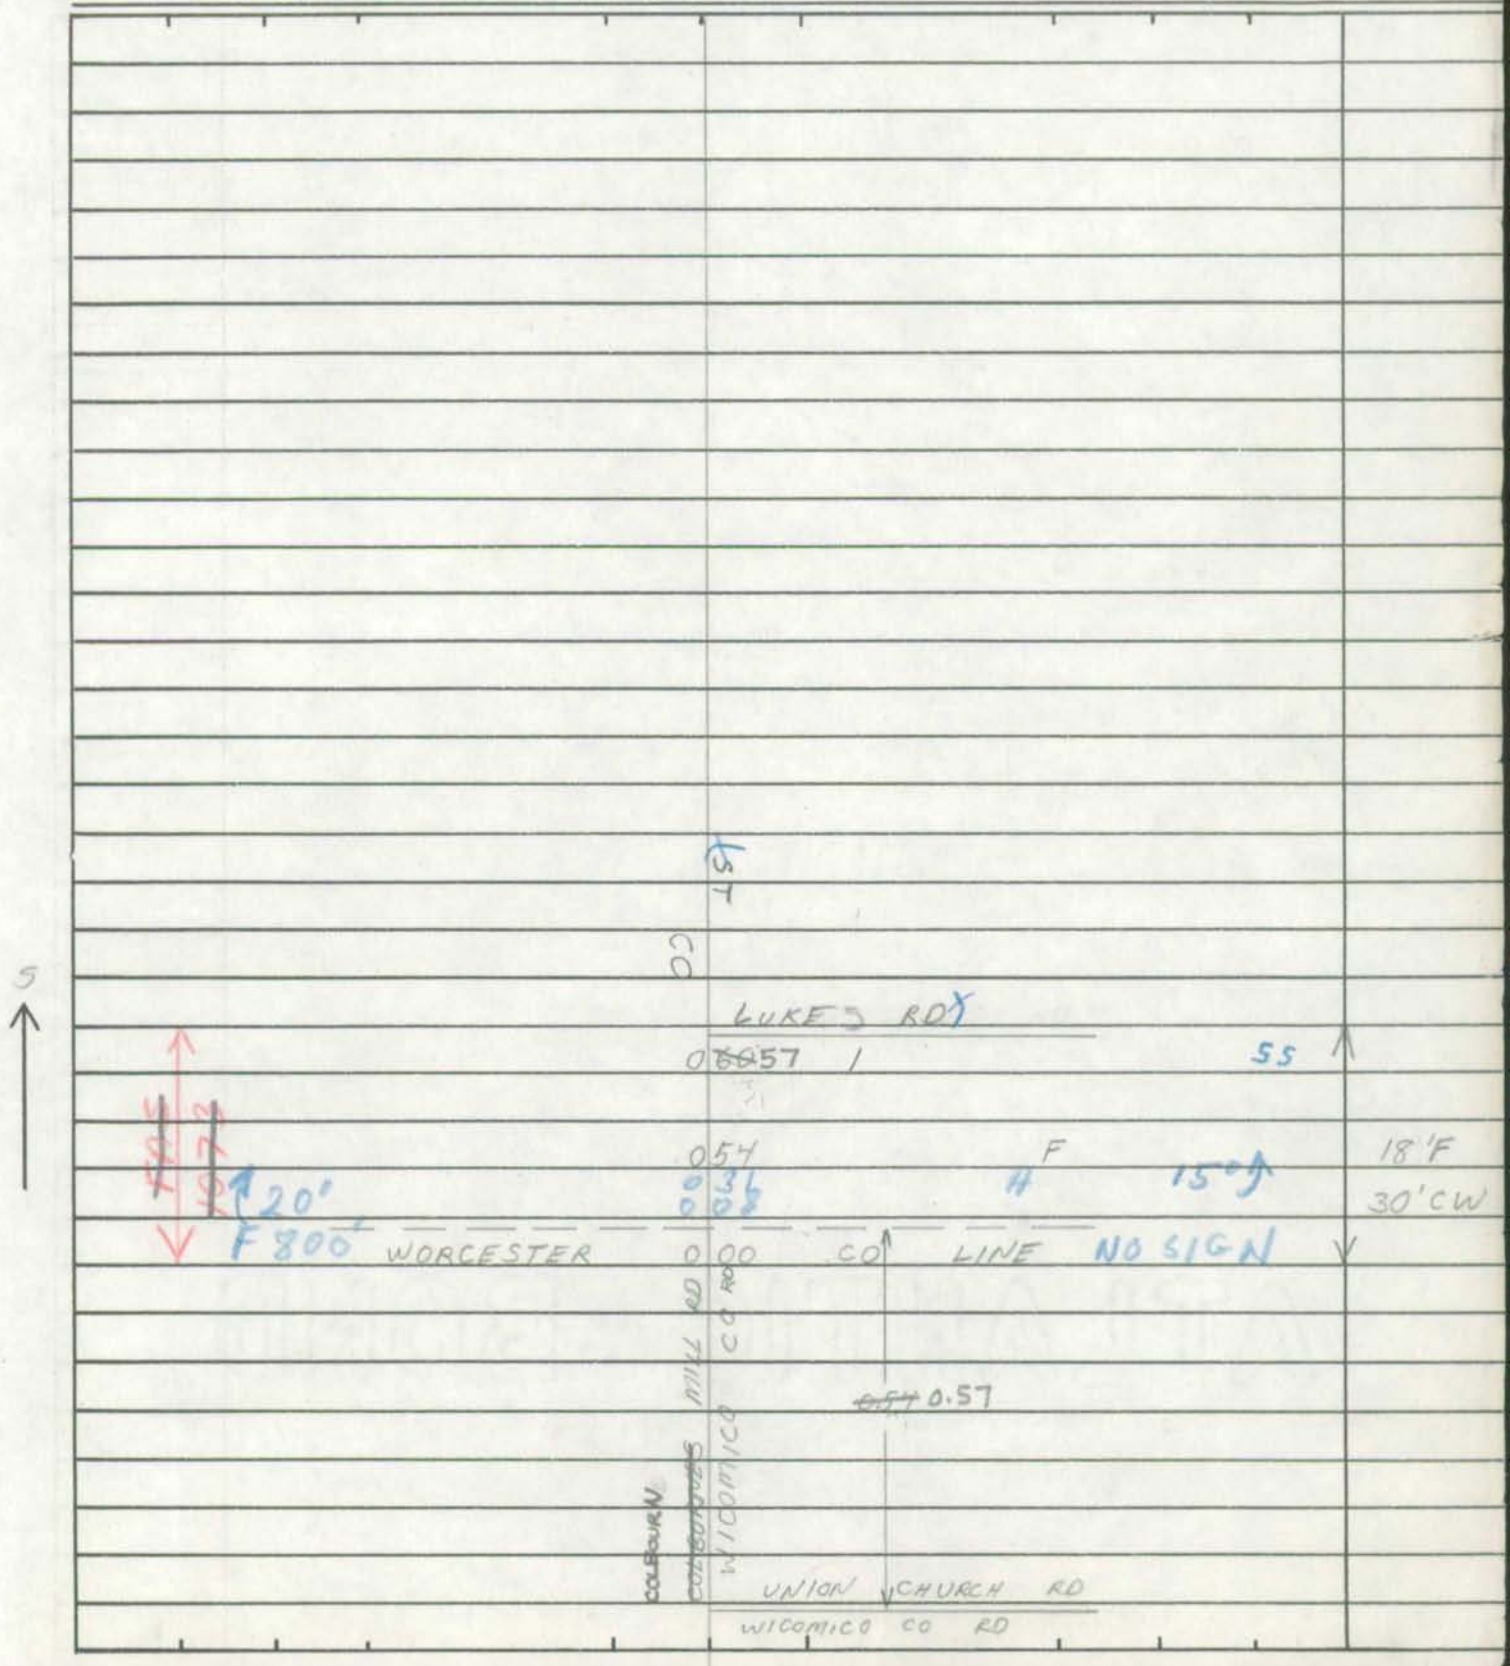

SHA 51.3-8
11-15-72

ROAD INVENTORY SHEET

Road No. _____
Road Name _____
Sheet No. _____
Date _____
County _____
State Coordinates _____

SHA 51.3-8
11-15-72

STATE HIGHWAY ADMINISTRATION OF MARYLAND

T. L. LINTON
F. KNOWLES
VERIFIED 4/27/77

ROAD INVENTORY SHEET

Party Chief _____
Recorder _____
Helper C. MARTIN

Map No. GH 24

Road No. CO 3
Road Name GREENBRIAR SWAMP RD A
Sheet No. 1 OF 2
Date 8-26-74
County WORCESTER
State Coordinates 1216-163

S

PT 35° PC	1 81	
	1 76	
	1 43	48" CMP
PT 30° PC	1 31	
	1 25	
	~~1 17~~ 117	PT 35° PC
	1 11	
	0 69	36" CMP
	PVT RD	
H	0 62 9'C	0.38 F(ABAN)
20°	0 52	
	0 38	F600' 20°↑
	0 30	24" CMP
H(VAC)	0 15	
	PVT 0 RD 0	
	0 12	18'F
	0 08	30'CW
ST	0 02	
CO	0 00	
	LUKES	
	RD	

SHA 51.3-8
11-15-72

ROAD INVENTORY SHEET

Road No. CO 3
Road Name GREENBRIER SWAMP RD
Sheet No. 2 OF 2
Date 8-26-74
County WORCESTER
State Coordinates

OLD ~~FURNACE~~ FURNACE		ROAD
CO	352	10
H	350	
↑20°	338	H
	330	
	313	18" CMP 20°↑
F	300	
↑20°	296	
	283	24" CMP
	259	24" CMP
F 800'	251	
	224	PT ↑ 40°
	220	PC ↓ SAME

SHA 51.3 - 8 Revised
4.83

FCR 95

MARYLAND STATE HIGHWAY ADMINISTRATION

ROAD INVENTORY SHEET

Party Chief GD
Recorder AH
Assistant
Map No./Dir. K-17 / S
State Coordinates 1211 - 166

Road No. Co 4
Road Name STEVENS RD
County WORCESTER
Date 4/20/95
Sheet No. 1 OF 2

90-11
87-18
86-8

TRAFFIC CODES
TRAFFIC CONTROLS: STOP SIGN=SS, TRAFFIC LIGHT=T.L., FLASHING RED BALL=F.R.

TRAFFIC CODES
PARKING RESTRICTIONS: A.M. PEAK, P.M. PEAK, A.M./P.M. PEAK, NO PARKING ANYTIME=N.P., COMM/IND. ACCESS=E

SYSTEM				TRAFFIC		LINE DIAGRAM	TRAFFIC			PAVEMENT DATA
FED. AID.	FUNCT. CLASS.	HWY. SYS.	HPMS SAMPLE	PRK.G. REST.	COM/IND. ACCESS		CONTROL	COM/IND. ACCESS	PRK.G. REST.	
	Rural Minor Collector				E	3 17 PT 30° PC 3 06 2 57 36" CMP McGRATH RD 1 17 CO 6 0 90 0 50 (ST LUKES CO RD) 0 00 RD 1 RACCMGIKE 14 CO	SS		X V	20'I ZML 22'I ZML

SYSTEM				TRAFFIC		LINE DIAGRAM	TRAFFIC				PAVEMENT DATA
FED. AID.	FUNCT. CLASS.	HWY. SYS.	HPMS SAMPLE	PRK'G. REST.	COM/IND ACCESS		CONTROL	COM/IND ACCESS	PRK'G. REST.		
	Rural Minor Collector					WHITESBURG RD 297 Co					
						OLD FURNACE RD Co 10 4 65 MEADOW BRIDGE RD Co 298					
						383 48" CMP					
						345 36" CMP					20'I 2ML

Form 6 HPS (Rev. 1961) 1204-163

ROAD INVENTORY SHEET

Party Chief F. SETTAN
Recorder T. LANDON
Chainman

L. NELSON
VERIFIED
4/26/77

Road No. CO. 5
Name (LITTLE BROWN RD)
Sheet No. 1 OF 1
Date 11-3-65
County WORCESTER

McGRATH		ROAD		
CO.	0.71	6		
H	0.55			
	0.51	F		
11	0.47			
PT	0.42			
35°				18° F
PC RT	0.33			24' CW
WICOMICO	0.08	CO LINE	20°	
APPR. WORCESTER	0.00	CO LINE		
~~0.78~~.73				
CO. 113				
WICOMICO CO RD				

W. 726

WICOMICO CO RD

Form 6 HPS (Rev. 1961) 1199-163

ROAD INVENTORY SHEET

Party Chief F. SEJTAN T. LANDON
Recorder T. LANDON F. RHODES
Chainman VERIFIED 4/26/77

Road No. Co. 6
Name (Mc GRATH RD
Sheet No. 1 OF 2
Date 11-3-65
County WORCESTER

	132	F	
	128	18" CMP	
F 1000'	124		
H (ABAN)	122		
F	113		
	109	12" CP	
	PVT FARM RD 106 9'C 0.19 F		
H	103		
(LITTLE BROWN RD) Co. 5	101		
H	096		
↑20° F 800' (ABAN)	070		
E ↑ ~~H (ABAN)~~	058	36" CMP	
	050	F	
4 H	022		18' F
	009	H	30' CW
(MEADOW BRIDGE Co.	000	ROAD) ✕ 298	

Form 6 HPS (Rev. 1961)

ROAD INVENTORY SHEET

Party Chief F. SETTIAN
Recorder T. LANDON
Chainman

Road No. Co. 6
Name
Sheet No. 2 OF 2
Date 11-3-65
County WORCESTER

	(STEVENS	ROAD)	
	Co.	2 27	4' ↑
↑20°		2 23	
		2 08	18" CP
		1 87	F 700'
		1 77	PT 30' H
	H	1 69	PC
		1 67	18" CMP
	↑30' H	1 63	
		1 58	H
	F	1 55	
		1 45	2-36" CMP
	H	1 40	
		1 35	H
			SAME

SHA 51.3-8
11-15-72

STATE HIGHWAY ADMINISTRATION OF MARYLAND

T. LANDON RHOADES
F. VERIFIED 4/25/77

ROAD INVENTORY SHEET

Party Chief _____
Recorder _____
Helper C. MARTIN

Map No. GH 24

Road No. CO 7
Road Name (OLD BEECH RD)
Sheet No. 1 OF 2
Date 8-27-74
County WORCESTER
State Coordinates 1220 - 132

	1 51	12" CP	
	1 39	18" CP	
	1 06	PT ↑ 90°	
	1 03	PC	
	0 87	24" CMP	
↑ PT ~~35°~~ 55°	0 79		
PC	0 76		
	0 61	12" CMP	
↑ 20°	0 46		
	0 43	PT ↑	
NE ↑	0 40	50° ~~35°~~ 12" CMP	
	0 39	PC	
	0 13	24" CMP	16' E 24' CW
WHITESBURG CO	0 00	ROAD 297	

SHA 51.3-8
11-15-72

ROAD INVENTORY SHEET

Road No. CO 7
Road Name OLD BEECH RD
Sheet No. 2 OF 2
Date 8-27-74
County WORCESTER
State Coordinates

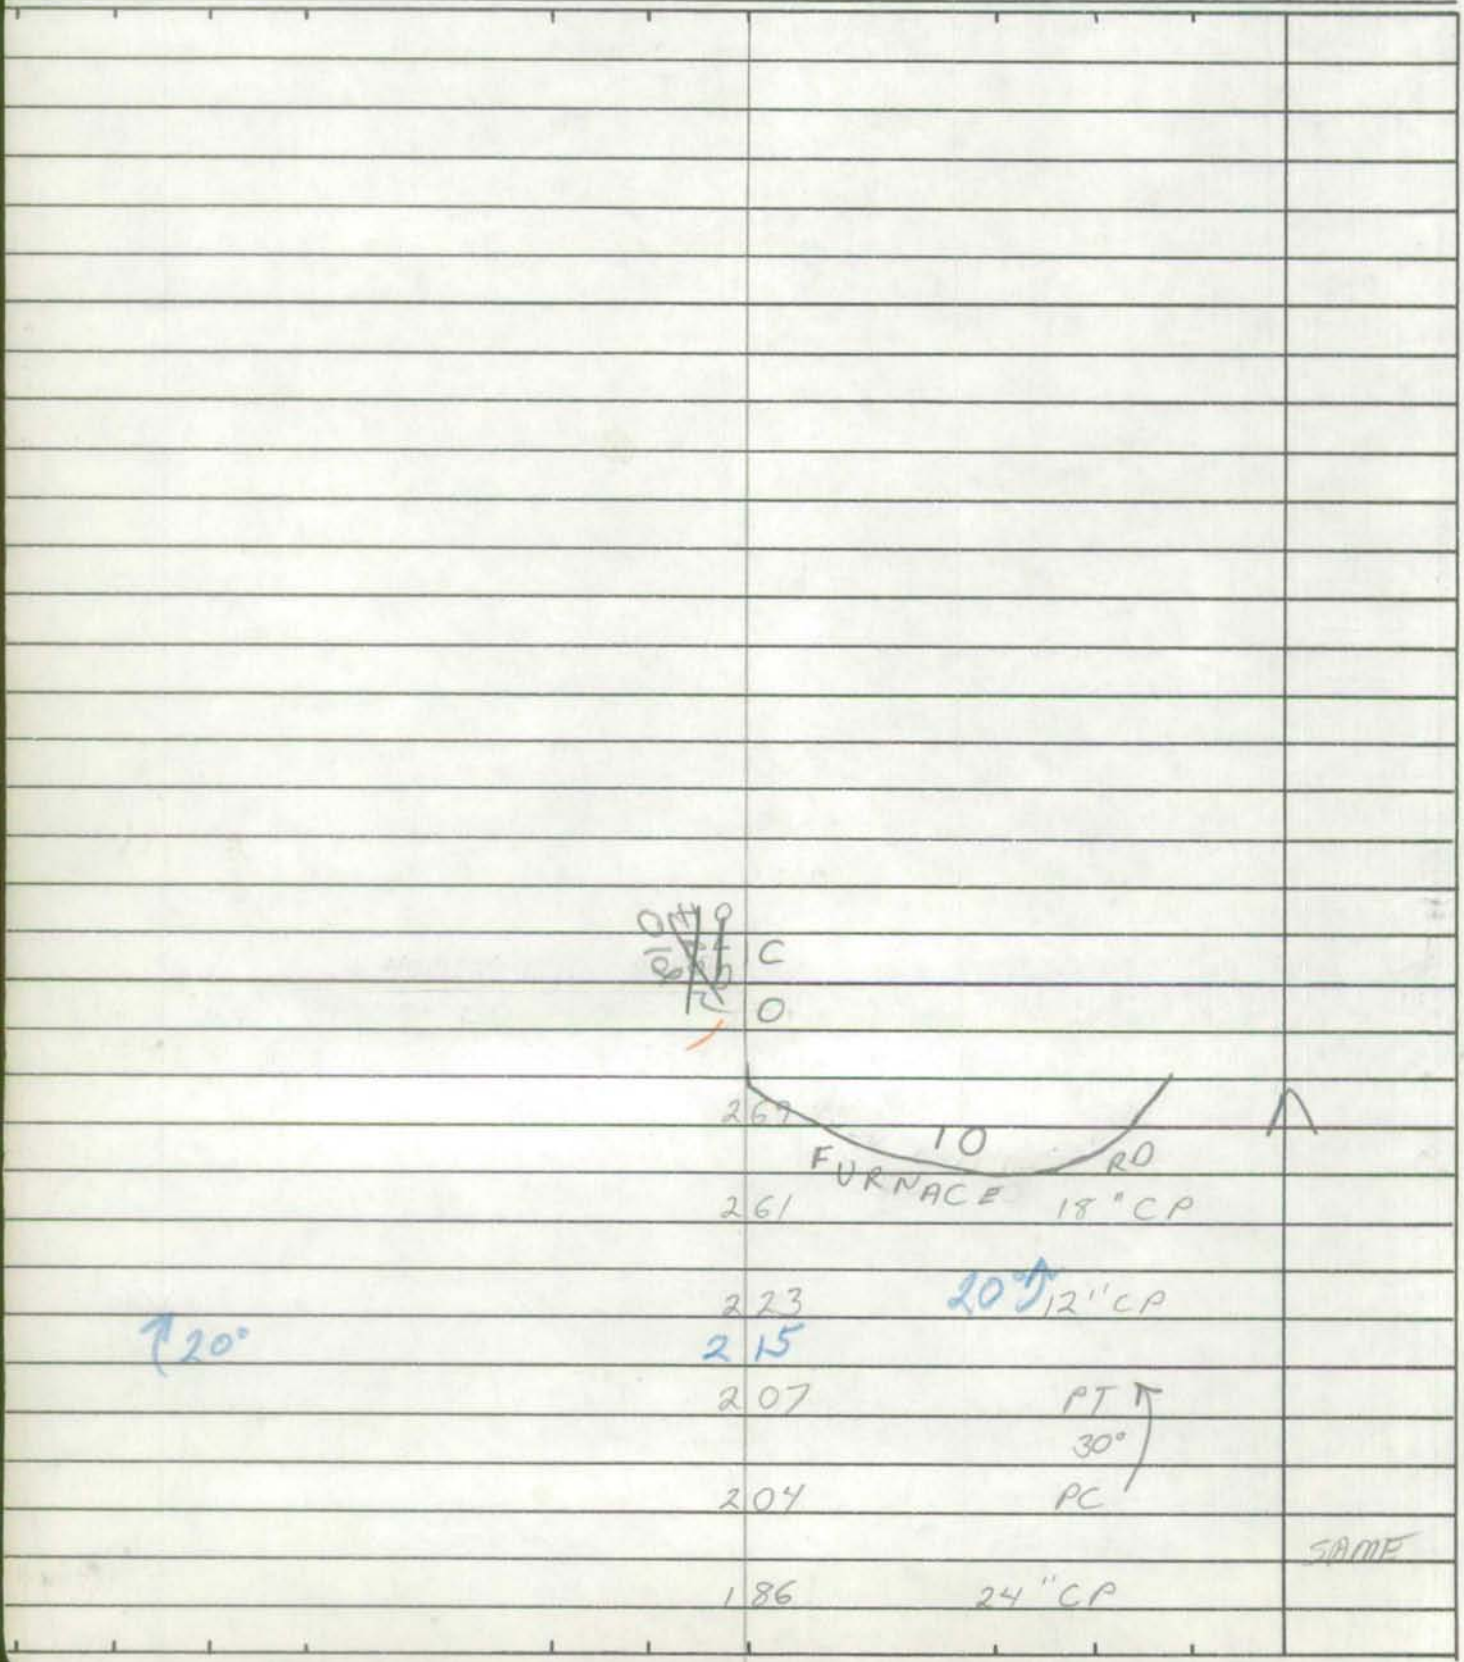

SHA 51.3 - 8 Revised
4.83

MARYLAND STATE HIGHWAY ADMINISTRATION

86-24 BB
2-18-87 TM

Verified = 4/25/77

ROAD INVENTORY SHEET

Party Chief E. SETTAN
Recorder T. LANDON
Assistant REWRITTEN (JEL) 1/20/92
Map No./Dir. K-17 / SW
State Coordinates 1219 - 143

Road No. CO 8
Road Name (HONEYWELL RD)
County WORCHESTER
Date 1-3-85
Sheet No. 1 OF 1

TRAFFIC CODES
TRAFFIC CONTROLS: STOP SIGN=SS, TRAFFIC LIGHT=T.L., FLASHING RED BALL=F.R.

TRAFFIC CODES
PARKING RESTRICTIONS: A.M. PEAK, P.M. PEAK, A.M./P.M. PEAK, NO PARKING ANYTIME=N.P., COMM/IND. ACCESS=E

SYSTEM				TRAFFIC		LINE DIAGRAM	TRAFFIC			PAVEMENT DATA
FED. AID.	FUNCT CLASS.	HWY. SYS.	HPMS SAMPLE	PRKG. REST.	COM/IND. ACCESS		CONTROL	COM/IND. ACCESS	PRKG. REST.	
						Whitesburg RD				
						CO 120 2977				
						CHURCH 119				
										20' F
										36' CW
						100				
										16' E
										18' CW
						080				
						old				
						~~Dead~~ FURNACE RD				20' F (91-45)
						CO 000 10				

NON FLA RURAL LOCALE

SYSTEM				TRAFFIC		LINE DIAGRAM	TRAFFIC				PAVEMENT DATA
FED. AID.	FUNCT. CLASS.	HWY. SYS.	HPMS SAMPLE	PRK.G. REST.	COM/IND ACCESS		CONTROL	COM/IND ACCESS	PRK.G. REST.		

Form 6 HPS (Rev. 1961) 1219-133

95-1
BB-AH
1/4/95

ROAD INVENTORY SHEET

Party Chief F. SETTAN
Recorder T. LANDON
Chainman

T. LANDON
F. RHODES
VERIFIED
4/22/77

K17

Road No. Co. 9
Name ~~FIVE~~ BRIDGES RD
Sheet No. 1 OF 1
Date 11-73 -65
County WORCESTER

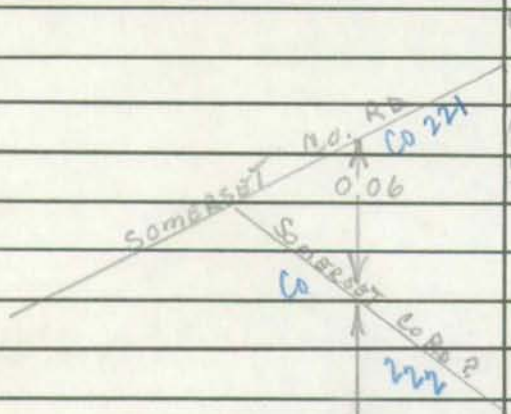

SOMERSET / WORCESTER
~~#WP 705~~ DIVIDING
SOMERSET
#WP705

0.86 — CO LINE / CK LINE
CREEK
0.85 — CO LINE

W

0.80 WPC L 16' X W 15' X D 2'

0.77 PT
70° ~~50°~~
FROM PC
20'

0.74
0.71
18 I
2 UML

PT
~~35~~ 75° H
PC

0.49
0.47
18 G
~~2~~ UML
~~35~~ CW

0.45

WHITESBURG
CO.

0.00 ROAD
~~#~~ 297
SS

SHA 51.3 - 8 Revised
4.83

FCR 95

MARYLAND STATE HIGHWAY ADMINISTRATION

ROAD INVENTORY SHEET

92-15
93-10 ST
91-13
90-10
85-11
83-7
84-135

Party Chief G.D.
Recorder A.H.
Assistant
Map No./Dir. K-17 / E
State Coordinates 1213 - 143

Road No. CO 10
Road Name OLD FURNACE RD
County WORCESTER
Date 4/20/95
Sheet No. 1 OF 4

TRAFFIC CODES
TRAFFIC CONTROLS: STOP SIGN=SS, TRAFFIC LIGHT=T.L., FLASHING RED BALL=F.R.

TRAFFIC CODES
PARKING RESTRICTIONS: A.M. PEAK, P.M. PEAK, A.M./P.M. PEAK, NO PARKING ANYTIME=N.P., COMM/IND. ACCESS=E

SYSTEM: FED. AID.	SYSTEM: FUNCT CLASS.	SYSTEM: HWY. SYS.	SYSTEM: HPMS SAMPLE	TRAFFIC: PK.K.G. REST.	TRAFFIC: COM/IND. ACCESS	LINE DIAGRAM	TRAFFIC: CONTROL	TRAFFIC: COM/IND ACCESS	TRAFFIC: PK.K.G. REST.	PAVEMENT DATA
						PT 1 20				
						70°				
						PC 1 14				
						GREENBRIAR SWAMP RD				
						CO 3 1 10				
						PT 0 93				
						30°				
						PC 0 74				
						PT 0 60				
	Collector				E	30° 0 57		E		
	Major					PC 0 53				
										20'-I
										2 ML
	Rural					STEVENS RD				
K						CO 4 0 00				
						CO 297	55		V	
						NEWARK BUS RD CO 276				

SYSTEM: FED. AID. | FUNCT. CLASS. | HWY. SYS. | HPMS SAMPLE
TRAFFIC: PRKG. REST. | COM/IND ACCESS

LINE DIAGRAM

TRAFFIC: CONTROL | COM/IND ACCESS | PRKG. REST.

PAVEMENT DATA

Rural — Major — Collector

3 81 FOREST CO 12 RD
(FOREST RD)
3 80 CO 11
3 78 PC

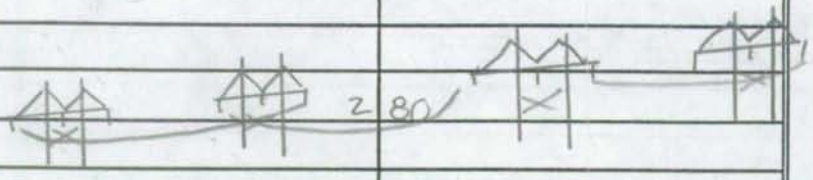

2 80

CEMETERY 1 77

PUSEY 1 74 22'I WOOD W.D BRANCH

1 70 OLD BEECH RD CO 10 PT
1 65 90°
1 64 PC

(HONEYWELL RD)
1 54 CO 8

20'I
2 ML

SHA 51.3 - 8 Revised
4.83

MARYLAND STATE HIGHWAY ADMINISTRATION

ROAD INVENTORY SHEET

Party Chief: GD
Recorder: AH
Assistant:
Map No./Dir.: K17 /
State Coordinates:

Road No.: Co 10
Road Name: OLD FURNACE RD
County: WORCESTER
Date: 4/20/95
Sheet No.: 3 OF 4

TRAFFIC CODES
TRAFFIC CONTROLS: STOP SIGN=SS,
TRAFFIC LIGHT=T.L.,
FLASHING RED BALL=F.R.

TRAFFIC CODES
PARKING RESTRICTIONS: A.M. PEAK,
P.M. PEAK, A.M./P.M. PEAK, NO PARKING
ANYTIME=N.P., COMM/IND. ACCESS=E

SYSTEM				TRAFFIC		LINE DIAGRAM			TRAFFIC			PAVEMENT DATA
FED. AID.	FUNCT CLASS.	HWY. SYS.	HPMS SAMPLE	PRK.G. REST.	COM/IND. ACCESS				CONTROL	COM/IND. ACCESS	PRK.G. REST.	
	Rural Major Collector							#W0211 21'I WOOD W-W				
						NASSAWANGO	5 92	CREEK				
								#W0212 20' WOOD WOOD W-W				
						NASSAWNGO	5 85	CREEK				20'I 2ML
							5 83				X	
							5 81	FURNACE TOWN		E		
						(MILLVILLE		RD)				
						CO	S 71	13				
												22'I 2ML
							4 44				X	
							3 92	PT				20'I 2ML
								35°				

SYSTEM				TRAFFIC		LINE DIAGRAM	TRAFFIC			PAVEMENT DATA
FED. AID.	FUNCT. CLASS.	HWY. SYS.	HPMS SAMPLE	PRKG. REST.	COM/IND ACCESS		CONTROL	COM/IND ACCESS	PRKG. REST.	
Rural Major Collector * Rural Local						PRIVATE DRIVE				
						ROAD 713 END			X	
						704 30°				16'I 2UML
						SNOW HILL RD				
						MD 690 12	55		X	
										22'I 2ML
						605			X	
										20'I 2ML

Form 5-HPS
(Revised 1961)

MARYLAND STATE ROADS COMMISSION
PLANNING AND PROGRAMMING DIVISION

S26130

IN COOPERATION WITH
U.S. BUREAU OF PUBLIC ROADS

FIELD CHECKED 2-8-71

BRIDGE SHEET

ROAD NO. 10

SHEET NO. 1-A

PARTY NO.

DATE 12-2-70

COUNTY Worcester

RATED CAPACITY

FOR ALL STRUCTURES HAVING A TOTAL OPENING OF MORE THAN 20 FEET AS DEFINED IN NOTE 1.

ODOMETER READING ~~1.08~~ 1.76 NAME OF (STREAM,) RAILROAD OR HIGHWAY CROSSED Pusey Branch

NUMBER OF RAILROAD TRACKS

KIND OF CROSSING (NOTE 2) Bridge Over Stream

UNDERPASS-SIMPLE UNDERPASS-COMBINED (NOTE 3) OVERPASS BRIDGE OVER SYSTEM

DESCRIPTION

NUMBER OF SPANS	LENGTH EACH SPAN (NOTE 4)	TYPE (NOTE 5)
4	14'-1", 14'-1", 14'-2", 14'-3"	Girder

TOTAL LENGTH-ON LINE OF ROAD OVER-ALL (NOTE 6) 57'-7"

MATERIAL

SUBSTRUCTURE Creosoted Timber SUPERSTRUCTURE Creosoted Timber

FLOOR WOOD

CLEARANCES

ROADWAY (NOTE 7) 17'Wood c-c SIDEWALK WIDTHS: RIGHT None LEFT None

SURFACE OF ROAD TO STREAM BED 13'-0 FOR OVERPASSES, SHOW DISTANCES TO TOP OF RAIL OR SURFACE OF LOWER ROAD. (NOTE 8)

SURFACE OF ROAD TO BOTTOM PORTAL (MINIMUM OVERHEAD CLEARANCE

CLEAR DISTANCE OF OPENING ABOVE STREAM BED 8 (WATERWAYS ONLY)

POSTED LOAD LIMITS BRIDGE NO. 708 CONSTRUCTION DATE 10-23-70

GENERAL CONDITION OF BRIDGE: CHECK IF GOOD, FAIR, OR POOR, DESCRIBE DEFECTS IF SERIOUS.

	GOOD X	FAIR	POOR
SUPERSTRUCTURE	Good		
FLOOR	Good		
SUBSTRUCTURE	Good		

PAINT BADLY CORRODED OR RUSTED

TYPE OF PROTECTION FOR DRAWBRIDGES (NOTE9)

(NOTES ON REVERSE SIDE)

S26130

Notes:

1. In agreement with Federal-aid standards, a bridge is defined as a structure including supports erected over a depression or an obstruction, as water, highway, or railway, and having a track or passageway for carrying traffic or other moving loads, and having a length measured along the center of roadway of more than 20 feet between undercoping of abutments or spring lines of arches, or extreme ends of openings for multiple boxes and pipes, where the clear distance between openings is less than half of the smaller contiguous opening.

2. Show kind of crossing by checking descriptive item applicable. For multiple-span bridges give complete information on each span including approach spans. Indicate on leg sheet the odometer reading, position, and angle of skew of structure with respect to center line of road and by arrow the direction of stream flow.

3. Give information on the span over the highway only.

4. For span length use center to center of bearings, otherwise the clear opening. Skew bridges will be measured along center line of road. See Note 1.

5. Show general type such as: Trestle, Truss, Girder, I-Beam, Rigid Frame, Arch, Slab, Suspension, or Covered Bridge. See illustrations attached. Describe draw spans by classifications listed in Article X, Section 2 of Manual.

6. The length of a bridge structure is the over-all length measured along the line of survey stationing back to back of back-walls of abutments, if present, otherwise end to end of bridge floor, but in no case less than the total clear opening of the structure.

7. Give minimum lateral clearance. Where traffic lanes are separated by bridge numbers, show clearance width of each lane separately. Special conditions should be explained by notes.

8. In case of overhead bracing or arch construction, measurement shall be made to the lowest point above the road surface.

9. Use classification listed on RR crossing sheets. Form 4 HPS.

Remarks: _____

A rearrangement of the form similar to that shown on the attachment may be used to provide space for coding.

Form 5-HPS
(Revised 1961)

MARYLAND STATE ROADS COMMISSION
PLANNING AND PROGRAMMING DIVISION

S26130

IN COOPERATION WITH
U.S. BUREAU OF PUBLIC ROADS

ROAD NO. 0010

BRIDGE SHEET

SHEET NO. 1-C

PARTY NO.

(92-15)
GD/AH
1/13/93

DATE 12-2-68

COUNTY WORCESTER

RATED CAPACITY

FOR ALL STRUCTURES HAVING A TOTAL OPENING OF MORE THAN 20 FEET AS DEFINED IN NOTE 1.

ODOMETER READING ~~4.32~~ 6.00 NAME OF STREAM, RAILROAD OR HIGHWAY CROSSED OLD FURNACE ROAD

NUMBER OF RAILROAD TRACKS

KIND OF CROSSING (NOTE 2) BRIDGE OVER STREAM

UNDERPASS-SIMPLE UNDERPASS-COMBINED (NOTE 3) OVERPASS BRIDGE OVER SYSTEM

DESCRIPTION

NUMBER OF SPANS	LENGTH EACH SPAN (NOTE 4)	TYPE (NOTE 5)
5	14.0-14.5	GIRDER

TOTAL LENGTH-ON LINE OF ROAD OVER-ALL (NOTE 6) 72.0 FEET

MATERIAL

SUBSTRUCTURE CREOSOTED TIMBER SUPERSTRUCTURE CREOSOTED TIMBER

FLOOR ~~WOOD~~, 21'I

CLEARANCES

ROADWAY (NOTE 7) SIDEWALK WIDTHS: RIGHT NONE LEFT NONE

SURFACE OF ROAD TO STREAM BED 9.0FT FOR OVERPASSES, SHOW DISTANCES TO TOP OF RAIL OR SURFACE OF LOWER ROAD. (NOTE 8)

SURFACE OF ROAD TO BOTTOM PORTAL (MINIMUM OVERHEAD CLEARANCE

CLEAR DISTANCE OF OPENING ABOVE STREAM BED ~~7.99 FT.~~ (WATERWAYS ONLY)

POSTED LOAD LIMITS NONE BRIDGE NO. ~~511~~ CONSTRUCTION DATE 10-15-68

GENERAL CONDITION OF BRIDGE: CHECK IF GOOD, FAIR, OR POOR, DESCRIBE DEFECTS IF SERIOUS.

	GOOD x	FAIR	POOR
SUPERSTRUCTURE	GOOD		
FLOOR	GOOD		
SUBSTRUCTURE	GOOD		

PAINT BADLY CORRODED OR RUSTED

TYPE OF PROTECTION FOR DRAWBRIDGES (NOTE9)

(NOTES ON REVERSE SIDE)

S26130

Notes:

1. In agreement with Federal-aid standards, a bridge is defined as a structure including supports erected over a depression or an obstruction, as water, highway, or railway, and having a track or passageway for carrying traffic or other moving loads, and having a length measured along the center of roadway of more than 20 feet between undercoping of abutments or spring lines of arches, or extreme ends of openings for multiple boxes and pipes, where the clear distance between openings is less than half of the smaller contiguous opening.

2. Show kind of crossing by checking descriptive item applicable. For multiple-span bridges give complete information on each span including approach spans. Indicate on leg sheet the odometer reading, position, and angle of skew of structure with respect to center line of road and by arrow the direction of stream flow.

3. Give information on the span over the highway only.

4. For span length use center to center of bearings, otherwise the clear opening. Skew bridges will be measured along center line of road. See Note 1.

5. Show general type such as: Trestle, Truss, Girder, I-Beam, Rigid Frame, Arch, Slab, Suspension, or Covered Bridge. See illustrations attached. Describe draw spans by classifications listed in Article X, Section 2 of Manual.

6. The length of a bridge structure is the over-all length measured along the line of survey stationing back to back of back-walls of abutments, if present, otherwise end to end of bridge floor, but in no case less than the total clear opening of the structure.

7. Give minimum lateral clearance. Where traffic lanes are separated by bridge numbers, show clearance width of each lane separately. Special conditions should be explained by notes.

8. In case of overhead bracing or arch construction, measurement shall be made to the lowest point above the road surface.

9. Use classification listed on RR crossing sheets. Form 4 HPS.

Remarks: _____

A rearrangement of the form similar to that shown on the attachment may be used to provide space for coding.

IN COOPERATION WITH
FEDERAL HIGHWAY ADMINISTRATION

BRIDGE SHEET

ROAD NO. 3 10

SHEET NO. _____

PARTY NO. _____

DATE 12/29/89

COUNTY Worcester

RATED CAPACITY Not available at this time

FOR ALL STRUCTURES HAVING A TOTAL OPENING OF MORE THAN 20 FEET AS DEFINED IN NOTE 1.

ODOMETER READING _____ NAME OF STREAM, RAILROAD OR HIGHWAY CROSSED Nassawango Creek (Old Furnace Road)

NUMBER OF RAILROAD TRACKS _____

KIND OF CROSSING (NOTE 2) Bridge over Creek

UNDERPASS-SIMPLE UNDERPASS-COMBINED (NOTE 3) OVERPASS BRIDGE OVER SYSTEM

DESCRIPTION

NUMBER OF SPANS	LENGTH EACH SPAN (NOTE 4)	TYPE (NOTE 5)
Four (4)	12'3", 14'9", 13'0", 13'0"	Timber

TOTAL LENGTH-ON LINE OF ROAD OVER-ALL (NOTE 6) 53'0"

MATERIAL

SUBSTRUCTURE Timber (Creosote) SUPERSTRUCTURE Timber (Creosote)

FLOOR Timber (Creosote)

CLEARANCES

ROADWAY (NOTE 7) 20'3" SIDEWALK WIDTHS: RIGHT LEFT

SURFACE OF ROAD TO STREAM BED 14'0"± FOR OVERPASSES, SHOW DISTANCES TO TOP OF RAIL OR SURFACE OF LOWER ROAD. (NOTE 8)

SURFACE OF ROAD TO BOTTOM PORTAL _____ (MINIMUM OVERHEAD CLEARANCE

CLEAR DISTANCE OF OPENING ABOVE STREAM BED _____ (WATERWAYS ONLY)

POSTED LOAD LIMITS Not available BRIDGE NO. Wo212 CONSTRUCTION DATE 10/89

GENERAL CONDITION OF BRIDGE: CHECK IF GOOD, FAIR, OR POOR, DESCRIBE DEFECTS IF SERIOUS.

	GOOD	FAIR	POOR
SUPERSTRUCTURE	Good		
FLOOR	Good		
SUBSTRUCTURE	Good		

PAINT BADLY CORRODED OR RUSTED

TYPE OF PROTECTION FOR DRAWBRIDGES _____

SHA 51.3 - 22
10-1-73

(NOTES ON REVERSE SIDE)

Notes:

1. In agreement with Federal-aid standards, a bridge is defined as a structure including supports erected over a depression or an obstruction, as water, highway, or railway, and having a track or passageway for carrying traffic or other moving loads, and having a length measured along the center of roadway of more than 20 feet between undercoping of abutments or spring lines of arches, or extreme ends of openings for multiple boxes and pipes, where the clear distance between openings is less than half of the smaller contiguous opening.

2. Show kind of crossing by checking descriptive item applicable. For multiple-span bridges give complete information on each span including approach spans. Indicate on leg sheet the odometer reading, position, and angle of skew of structure with respect to center line of road and by arrow the direction of stream flow.

3. Give information on the span over the highway only.

4. For span length use center to center of bearings, otherwise the clear opening. Skew bridges will be measured along center line of road. (See note 1.)

5. Show general type such as: Trestle, Truss, Girder, I-Beam, Rigid Frame, Arch, Slab, Suspension, or Covered Bridge.

6. The length of a bridge structure is the over-all length measured along the line of survey stationing back to back of back-walls of abutments, if present, otherwise end to end of bridge floor, but in no case less than the total clear opening of the structure.

7. Give minimum lateral clearance. Where traffic lanes are separated by bridge members, show clearance width of each lane separately. Special conditions should be explained by notes.

8. In case of overhead bracing or arch construction, measurement shall be made to the lowest point above the road surface.

Remarks: _____

_____

SHA 51.3-8
11-15-72

STATE HIGHWAY ADMINISTRATION OF MARYLAND

ROAD INVENTORY SHEET

Party Chief _____
Recorder K. HESS
Helper _____

Map No. _____ VER 4-25-77

Road No. Co 11
Road Name (FOREST RD)
Sheet No. 1 of 1
Date 11-5-65 (REVISED 10-5-77)
County WORCESTER
State Coordinates 1229-131

N ↑

	Old (~~FURN~~ FURNACE CO)		
		139 ROAD) 10	↑
		(FOREST RD) 10 12	
		136	
	071		20° ↑
	065		20° ↑
↑50°	033	DR.	16'E. 18'CW
	(SAND CO RD) 000 36		↓

SHA 51.3-8
11-15-72

ROAD INVENTORY SHEET

Road No. _____
Road Name _____
Sheet No. _____
Date _____
County _____
State Coordinates _____

Form 6 HPS (Rev. 1961) 1229-137

ROAD INVENTORY SHEET

Party Chief F. SETTAN
Recorder T. LANDON
Chainman

T. LANDON
F. RHODES
VERIFIED
4/25/77

Road No. CO. 12
Name (FOREST RD)
Sheet No. 1 OF 1
Date 11-3-65
County WORCESTER

NE

old
~~Old~~ FURNACE
Co.

ROAD
10
005

16'E
~~13'E~~
18'W

(FOREST
Co.
000

ROAD
11)

NOTE: M.P 2.67 - 3.43 WAS CO 14
90-32,37

SHA 51.3 - 8 Revised
4.83

MARYLAND STATE HIGHWAY ADMINISTRATION

ROAD INVENTORY SHEET

Party Chief: F. SETTAN
Recorder: T. LANDON
Assistant: Rewritten 4-25-89 JE
Map No./Dir.: 1 / S
State Coordinates: 1236-151

Road No.: CO 13
Road Name: (MILLVILLE RD)
County: WORCESTER
Date: 11-9-65
Sheet No.: 1 OF 3

TRAFFIC CODES
TRAFFIC CONTROLS: STOP SIGN=SS, TRAFFIC LIGHT=T.L., FLASHING RED BALL=F.R.

TRAFFIC CODES
PARKING RESTRICTIONS: A.M. PEAK, P.M. PEAK, A.M./P.M. PEAK, NO PARKING ANYTIME=N.P., COMM/IND. ACCESS=E

SYSTEM				TRAFFIC		LINE DIAGRAM	TRAFFIC			PAVEMENT DATA
FED. AID.	FUNCT CLASS.	HWY. SYS.	HPMS SAMPLE	PRK.G. REST.	COM/IND. ACCESS		CONTROL	COM/IND. ACCESS	PRK.G. REST.	
						0 95 24" CMP				
						PT 0 82				18' F
						30°				~~18' E~~
						PC 0 80				X 28' C-W
						0 48 PT				
						30°				
						0 42 PC				
						25° 0 33				
						20° 0 13				22' F
										28' C-W
						SNOW HILL RD				
						MD 0 00 12				V
						LA RD				
						OLD STAGE COACH RD 0 396 P 0				

SYSTEM				TRAFFIC		LINE DIAGRAM	TRAFFIC			PAVEMENT DATA
FED. AID.	FUNCT. CLASS.	HWY. SYS.	HPMS SAMPLE	PRKG. REST.	COM/IND ACCESS		CONTROL	COM/IND ACCESS	PRKG. REST.	
						10° 2 77				
						~~OLD IRON~~ FURNACE RD				22'F
						CO 2 67 10			X	
						2 58 20°				
						20° 2 50				
						20° 1 90				
						1 68 PT 30°				
						1 63 PC				
										20'F
										~~20'E~~
										30'C-W
						1 26			X	
						# W0709				
						FURNACE 1 23 BRANCH				
										18'F
										~~18'E~~
										28'C-W
										SAME

SHA 51.3 - 8 Revised
4.83

MARYLAND STATE HIGHWAY ADMINISTRATION

ROAD INVENTORY SHEET

Party Chief _____
Recorder _____
Assistant Rewritten 4-25-89 JE
Map No./Dir. /
State Coordinates _____

Road No. Co 13
Road Name Millville Rd
County Worcester
Date 11-9-65
Sheet No. 3 OF 3

SYSTEM				TRAFFIC		LINE DIAGRAM	TRAFFIC			PAVEMENT DATA
FED. AID.	FUNCT. CLASS.	HWY. SYS.	HPMS SAMPLE	PRK.G. REST.	COM/IND. ACCESS		CONTROL	COM/IND. ACCESS	PRK.G. REST.	
						SAND CO 3 63 RD 36				
						3 53 12" CP				
						20° 3 41				20'F
										~~20'E~~
										20'C-W
						3 27 25°				
						2 9&7				
						2 84 35°				
										22'F
										SAME

TRAFFIC CODES

TRAFFIC CONTROLS: STOP SIGN=SS, TRAFFIC LIGHT=T.L., FLASHING RED BALL=F.R.

TRAFFIC CODES

PARKING RESTRICTIONS: A.M. PEAK, P.M. PEAK, A.M./P.M. PEAK, NO PARKING ANYTIME=N.P., COMM/IND. ACCESS=E

SYSTEM				TRAFFIC		LINE DIAGRAM	TRAFFIC				PAVEMENT DATA
FED. AID.	FUNCT. CLASS.	HWY. SYS.	HPMS SAMPLE	PRK'G. REST.	COM/IND ACCESS		CONTROL	COM/IND ACCESS	PRK'G. REST.		

Form 5-HPS (Revised 1961)

MARYLAND STATE ROADS COMMISSION
PLANNING AND PROGRAMMING DIVISION

S26130

IN COOPERATION WITH
U. S. BUREAU OF PUBLIC ROADS

BRIDGE SHEET

ROAD NO. Co. 13

SHEET NO. 1 A

PARTY NO. _____

DATE 11-9-65

COUNTY DORCHESTER

RATED CAPACITY _____

FOR ALL STRUCTURES HAVING A TOTAL OPENING OF MORE THAN 20 FEET AS DEFINED IN NOTE 1.

ODOMETER READING 1.23 NAME OF STREAM, RAILROAD OR HIGHWAY CROSSED FURNACE BRANCH

NUMBER OF RAILROAD TRACKS _____

KIND OF CROSSING (NOTE 2) _____

UNDERPASS-SIMPLE UNDERPASS-COMBINED (NOTE 3) OVERPASS BRIDGE OVER SYSTEM

DESCRIPTION

NUMBER OF SPANS	LENGTH EACH SPAN (NOTE 4)	TYPE (NOTE 5)
2	14'	WOOD PILE

TOTAL LENGTH-ON LINE OF ROAD OVER-ALL (NOTE 6) 28'

MATERIAL

SUBSTRUCTURE WOOD SUPERSTRUCTURE WOOD

FLOOR WOOD

CLEARANCES

ROADWAY (NOTE 7) 15' SIDEWALK WIDTHS: RIGHT _____ LEFT _____

SURFACE OF ROAD TO STREAM BED 5' FOR OVERPASSES, SHOW DISTANCES TO TOP OF RAIL OR SURFACE OF LOWER ROAD. (NOTE 8)

SURFACE OF ROAD TO BOTTOM PORTAL 2' (MINIMUM OVERHEAD CLEARANCE

CLEAR DISTANCE OF OPENING ABOVE STREAM BED 3' (WATERWAYS ONLY)

POSTED LOAD LIMITS _____ BRIDGE NO. 709 CONSTRUCTION DATE _____

GENERAL CONDITION OF BRIDGE: CHECK IF GOOD, FAIR, OR POOR, DESCRIBE DEFECTS IF SERIOUS.

	GOOD	FAIR	POOR
SUPERSTRUCTURE	✓		
FLOOR	✓		
SUBSTRUCTURE	✓		

PAINT _____ BADLY CORRODED OR RUSTED

TYPE OF PROTECTION FOR DRAWBRIDGES (NOTE 9) _____

(NOTES ON REVERSE SIDE)

S26130

Notes:

1. In agreement with Federal-aid standards, a bridge is defined as a structure including supports erected over a depression or an obstruction, as water, highway, or railway, and having a track or passageway for carrying traffic or other moving loads, and having a length measured along the center of roadway of more than 20 feet between undercoping of abutments or spring lines of arches, or extreme ends of openings for multiple boxes and pipes, where the clear distance between openings is less than half of the smaller contiguous opening.

2. Show kind of crossing by checking descriptive item applicable. For multiple-span bridges give complete information on each span including approach spans. Indicate on leg sheet the odometer reading, position, and angle of skew of structure with respect to center line of road and by arrow the direction of stream flow.

3. Give information on the span over the highway only.

4. For span length use center to center of bearings, otherwise the clear opening. Skew bridges will be measured along center line of road. See Note 1.

5. Show general type such as: Trestle, Truss, Girder, I-Beam, Rigid Frame, Arch, Slab, Suspension, or Covered Bridge. See illustrations attached. Describe draw spans by classifications listed in Article X, Section 2 of Manual.

6. The length of a bridge structure is the over-all length measured along the line of survey stationing back to back of back-walls of abutments, if present, otherwise end to end of bridge floor, but in no case less than the total clear opening of the structure.

7. Give minimum lateral clearance. Where traffic lanes are separated by bridge numbers, show clearance width of each lane separately. Special conditions should be explained by notes.

8. In case of overhead bracing or arch construction, measurement shall be made to the lowest point above the road surface.

9. Use classification listed on RR crossing sheet. Form 4 HPS.

Remarks: _____

A rearrangement of the form similar to that shown on the attachment may be used to provide space for coding.

SHA 51.3 - 8 Revised 4.83

* Was part of Co 4 till index map comparison + '95 FCRI Per KP & WB

FCR EX #1

MARYLAND STATE HIGHWAY ADMINISTRATION

ROAD INVENTORY SHEET

Party Chief: GD
Recorder: AH
Assistant:
Map No./Dir.: K-17 / N
State Coordinates: 1211 - 166

Road No.: Co 14
Road Name: POCOMOKE RD
County: WORCESTER
Date: 4/20/95
Sheet No.: 1 OF 1

TRAFFIC CODES

TRAFFIC CONTROLS: STOP SIGN=SS, TRAFFIC LIGHT=T.L., FLASHING RED BALL=F.R.

PARKING RESTRICTIONS: A.M. PEAK, P.M. PEAK, A.M./P.M. PEAK, NO PARKING ANYTIME=N.P., COMM/IND. ACCESS=E

SYSTEM				TRAFFIC		LINE DIAGRAM	TRAFFIC			PAVEMENT DATA
FED. AID.	FUNCT CLASS.	HWY. SYS.	HPMS SAMPLE	PRKG. REST.	COM/IND. ACCESS		CONTROL	COM/IND. ACCESS	PRKG. REST.	
	Rural Local					219 CO WICOMICO Co LINE ~~WORCHESTER~~ Worcester 005 Co LINE ATLANTIC STEEL PRODUCTS (ST LUKES Co 000 RD) STEVENS RD 4 Co		E 55		16'6 2 UML

SYSTEM				TRAFFIC		LINE DIAGRAM	TRAFFIC				PAVEMENT DATA
FED. AID.	FUNCT. CLASS.	HWY. SYS.	HPMS SAMPLE	PRK'G. REST.	COM/IND ACCESS		CONTROL	COM/IND ACCESS	PRK'G. REST.		

Form 6 HPS (Rev. 1961) 1241-145

ROAD INVENTORY SHEET

WEST HILLS DR. (69-16)

Party Chief F. SETTAN
Recorder T. LANDON
Chainman

T. LANDON
F. RHODES
VERIFIED
4/25/77

Road No. Co. 15
Name ~~WEST DRIVE~~
Sheet No. 1 OF 1
Date 11-4-65
County WORCESTER

	ROAD	END	
	0 17		↑
SW ↑	0 16	17	
	(PAIGE Co 282		
69-10 Co 282	0 13		
H	0 10	H	20'F
H	0 08	H	40'CW
	SNOW HILL	RD	
	MD. 0 00	12	↓

SHA 51.3 - 8 Revised
4.83

FCR 95

MARYLAND STATE HIGHWAY ADMINISTRATION

ROAD INVENTORY SHEET

Party Chief G.D.
Recorder A.H.
Assistant
Map No./Dir. K-17 / NE
State Coordinates 1243-144

Road No. Co 16
Road Name MT. OLIVE CHURCH RD
County WORC. ESTER
Date 4/ 195
Sheet No. 1 OF 4

94-13
86-16,17,18
85-12,13

TRAFFIC CODES
TRAFFIC CONTROLS: STOP SIGN=SS, TRAFFIC LIGHT=T.L., FLASHING RED BALL=F.R.

TRAFFIC CODES
PARKING RESTRICTIONS: A.M. PEAK, P.M. PEAK, A.M./P.M. PEAK, NO PARKING ANYTIME=N.P., COMM/IND. ACCESS=E

SYSTEM				TRAFFIC		LINE DIAGRAM	TRAFFIC			PAVEMENT DATA
FED. AID.	FUNCT CLASS.	HWY. SYS.	HPMS SAMPLE	PRKG. REST.	COM/IND. ACCESS		CONTROL	COM/IND. ACCESS	PRKG. REST.	
						PIPER LA				
						1 71 PVT RD				
	Collector				E	C&P MICROWAVE STATION 1 13				18'I
										2ML
						0 63 2-48" CMP			X	
	Minor					0 60 PT				
						30°				
						0 49 PC				
										20'I
										2ML
	Rural					(SNOW HILL RD)				
K						MD 0 00 12			Y	

LINE DIAGRAM

SYSTEM: FED. AID. | FUNCT. CLASS. | HWY. SYS. | HPMS SAMPLE

FUNCT. CLASS: Rural — Collector — Minor

TRAFFIC: PKG. REST. | COM/IND ACCESS

TRAFFIC: CONTROL | COM/IND ACCESS | PKG. REST.

PAVEMENT DATA

2 88 PT

2 86 CH & CEM

45°

2 81 PC

2 62 ELECT. SUB STAT.

OVERHEAD POWERLINES

2 61

PT

2 46

30°

PC

2 41

18'I

2ML

2 29 PT

35°

2 21 PC

SHA 51.3 - 8 Revised
4.83

MARYLAND STATE HIGHWAY ADMINISTRATION

ROAD INVENTORY SHEET

Party Chief G.D.
Recorder A.H
Assistant
Map No./Dir. K-17 /
State Coordinates

Road No. Co 16
Road Name MT OLIVE CHURCH RD
County WORCESTER
Date 4/20/95
Sheet No. 3 OF 4

02-11 A/T

SYSTEM: FED. AID. | FUNCT. CLASS. | HWY. SYS. | HPMS SAMPLE
TRAFFIC: PRKG. REST. | COM/IND. ACCESS

LINE DIAGRAM

TRAFFIC: CONTROL | COM/IND. ACCESS | PRKG. REST.

PAVEMENT DATA

Rural Minor Collector * Rural Local

PT 4 21
30°
PC 4 16

W0601
20' WOOD
W-WALL-WALL
NASSAWAGO 4 68 CREEK

(STURGES RD)
3 60 CO 17

16' F
2 UNL

2 93 *

2 91 (DISHAROON)
01/18'I
2 ML
2 89 Co 17 RD)

18'I
2 ML

TRAFFIC CODES
TRAFFIC CONTROLS: STOP SIGN=SS, TRAFFIC LIGHT=T.L., FLASHING RED BALL=F.R.

TRAFFIC CODES
PARKING RESTRICTIONS: A.M. PEAK, P.M. PEAK, A.M./P.M. PEAK, NO PARKING ANYTIME=N.P., COMM/IND. ACCESS=E

* boundary changed to reflect 1995 K-17 INDEX MAP
12/5/97 MK

SYSTEM				TRAFFIC		LINE DIAGRAM	TRAFFIC			PAVEMENT DATA
FED. AID.	FUNCT. CLASS.	HWY. SYS.	HPMS SAMPLE	PRK.G. REST.	COM/IND ACCESS		CONTROL	COM/IND ACCESS	PRK.G. REST.	
	Rural Minor Collector					SPEARIN RD WICOMICO CO RD ↑ (6 18) 0.22 ↓ WICOMICO CO LINE? ~~ROCHESTER~~ Worcester 596 CO LINE?				19'G 19'G
						593			X	
						560 PT 30° 554 PC				
						PT 469 30° PC 44 64				16'F ZUML

Form 5-HPS
(Revised 1961)

MARYLAND STATE ROADS COMMISSION
PLANNING AND PROGRAMMING DIVISION

S26130

IN COOPERATION WITH
U.S. BUREAU OF PUBLIC ROADS

ROAD NO. Co 16

BRIDGE SHEET

SHEET NO. 1A

PARTY NO. _____

DATE 2-15-80

COUNTY Worcester

RATED CAPACITY _____

FOR ALL STRUCTURES HAVING A TOTAL OPENING OF MORE THAN 20 FEET AS DEFINED IN NOTE 1.

ODOMETER READING 4.12 NAME OF STREAM, RAILROAD OR HIGHWAY CROSSED Nassawango Creek

NUMBER OF RAILROAD TRACKS _____
KIND OF CROSSING (NOTE 2) _____

UNDERPASS-SIMPLE UNDERPASS-COMBINED (NOTE 3) OVERPASS BRIDGE OVER SYSTEM

DESCRIPTION

NUMBER OF SPANS	LENGTH EACH SPAN (NOTE 4)	TYPE (NOTE 5)
3	14'	Wood

TOTAL LENGTH-ON LINE OF ROAD OVER-ALL (NOTE 6) 42'

MATERIAL
SUBSTRUCTURE Wood SUPERSTRUCTURE Wood
FLOOR Wood

CLEARANCES
ROADWAY (NOTE 7) 21' wood wood c-c SIDEWALK WIDTHS: RIGHT LEFT
SURFACE OF ROAD TO STREAM BED 96" FOR OVERPASSES, SHOW DISTANCES TO TOP OF RAIL OR SURFACE OF LOWER ROAD. (NOTE 8)
SURFACE OF ROAD TO BOTTOM PORTAL _____ (MINIMUM OVERHEAD CLEARANCE
CLEAR DISTANCE OF OPENING ABOVE STREAM BED 7' (WATERWAYS ONLY)
POSTED LOAD LIMITS _____ BRIDGE NO. _____ CONSTRUCTION DATE _____

GENERAL CONDITION OF BRIDGE: CHECK IF GOOD, FAIR, OR POOR, DESCRIBE DEFECTS IF SERIOUS.

	GOOD	FAIR	POOR
SUPERSTRUCTURE	✓		
FLOOR		✓	
SUBSTRUCTURE		✓	

PAINT BADLY CORRODED OR RUSTED

TYPE OF PROTECTION FOR DRAWBRIDGES (NOTE9) _____

(NOTES ON REVERSE SIDE)

S26130

Notes:

1. In agreement with Federal-aid standards, a bridge is defined as a structure including supports erected over a depression or an obstruction, as water, highway, or railway, and having a track or passageway for carrying traffic or other moving loads, and having a length measured along the center of roadway of more than 20 feet between undercoping of abutments or spring lines of arches, or extreme ends of openings for multiple boxes and pipes, where the clear distance between openings is less than half of the smaller contiguous opening.

2. Show kind of crossing by checking descriptive item applicable. For multiple-span bridges give complete information on each span including approach spans. Indicate on leg sheet the odometer reading, position, and angle of skew of structure with respect to center line of road and by arrow the direction of stream flow.

3. Give information on the span over the highway only.

4. For span length use center to center of bearings, otherwise the clear opening. Skew bridges will be measured along center line of road. See Note 1.

5. Show general type such as: Trestle, Truss, Girder, I-Beam, Rigid Frame, Arch, Slab, Suspension, or Covered Bridge. See illustrations attached. Describe draw spans by classifications listed in Article X, Section 2 of Manual.

6. The length of a bridge structure is the over-all length measured along the line of survey stationing back to back of back-walls of abutments, if present, otherwise end to end of bridge floor, but in no case less than the total clear opening of the structure.

7. Give minimum lateral clearance. Where traffic lanes are separated by bridge numbers, show clearance width of each lane separately. Special conditions should be explained by notes.

8. In case of overhead bracing or arch construction, measurement shall be made to the lowest point above the road surface.

9. Use classification listed on RR crossing sheets. Form 4 HPS.

Remarks: _____

A rearrangement of the form similar to that shown on the attachment may be used to provide space for coding.

SHA 51.3 - 8 Revised
4.83

PCR 95

MARYLAND STATE HIGHWAY ADMINISTRATION

ROAD INVENTORY SHEET

Party Chief G.D.
Recorder A.H.
Assistant
Map No./Dir. K-17 / N
State Coordinates 1244 - 160

Road No. Co 17
Road Name (STURGES RD)
County WORCESTER
Date 4/20 195
Sheet No. 1 OF 2

94-13

SYSTEM				TRAFFIC		LINE DIAGRAM	TRAFFIC			PAVEMENT DATA
FED. AID.	FUNCT. CLASS.	HWY. SYS.	HPMS SAMPLE	PRK'G. REST.	COM/IND. ACCESS		CONTROL	COM/IND. ACCESS	PRK'G. REST.	
	Collector					1 00 PT				
						30°				
						0 96 PC				
						PT 0 45				
						30°				
						PC 0 39				
						0 09 30°				
	Rural Minor									18' D
										2 UML
						(MT OLIVE CHURCH RD)				
K						CO 0 00 16				

TRAFFIC CODES
TRAFFIC CONTROLS: STOP SIGN=SS, TRAFFIC LIGHT=T.L., FLASHING RED BALL=F.R.

TRAFFIC CODES
PARKING RESTRICTIONS: A.M. PEAK, P.M. PEAK, A.M./P.M. PEAK, NO PARKING ANYTIME=N.P., COMM/IND. ACCESS=E

* boundary changed to reflect 1995 IC-17 INDEX 12/5/97 SMC 2 OF 2

SYSTEM				TRAFFIC		LINE DIAGRAM	TRAFFIC				PAVEMENT DATA
FED. AID.	FUNCT. CLASS.	HWY. SYS.	HPMS SAMPLE	PRKG. REST.	COM/IND ACCESS		CONTROL	COM/IND ACCESS	PRKG. REST.		
	Rural Minor Collector					WICOMICO CO 732 RD 0.59 0.62 BEECH ISLAND CREEK 0.32 .29 No SGN LINE WICOMICO CO LINE WORCHESTER 1 89 86 CO LINE PT 1 73 30 PC 1 63 1 39 PVT CEM 30° 1 03 1 01 2-36" CMP					18'D 2 UML

Form 5-HPS (Revised 1961) MARYLAND STATE ROADS COMMISSION PLANNING AND PROGRAMMING DIVISION S26130

IN COOPERATION WITH
U. S. BUREAU OF PUBLIC ROADS

BRIDGE SHEET

ROAD NO. Co. 17

SHEET NO. 1-A

PARTY NO.

DATE 11-4-65

COUNTY ~~DORCHESTER~~

Wicomico Co BRIDGE

RATED CAPACITY

FOR ALL STRUCTURES HAVING A TOTAL OPENING OF MORE THAN 20 FEET AS DEFINED IN NOTE 1.

ODOMETER READING 2.23 NAME OF STREAM, RAILROAD OR HIGHWAY CROSSED ~~NASSAWANGO CREEK~~ Beech Island Creek

NUMBER OF RAILROAD TRACKS

KIND OF CROSSING (NOTE 2)

UNDERPASS-SIMPLE UNDERPASS-COMBINED (NOTE 3) OVERPASS BRIDGE OVER SYSTEM

DESCRIPTION

NUMBER OF SPANS	LENGTH EACH SPAN (NOTE 4)	TYPE (NOTE 5)
1	12'	WOOD PILE
1	11'	WOOD PILE

TOTAL LENGTH-ON LINE OF ROAD OVER-ALL (NOTE 6) 23'

MATERIAL

SUBSTRUCTURE WOOD SUPERSTRUCTURE WOOD

FLOOR

CLEARANCES

ROADWAY (NOTE 7) 16' SIDEWALK WIDTHS: RIGHT LEFT

SURFACE OF ROAD TO STREAM BED 3' FOR OVERPASSES, SHOW DISTANCES TO TOP OF RAIL OR SURFACE OF LOWER ROAD. (NOTE 8)

SURFACE OF ROAD TO BOTTOM PORTAL 2' (MINIMUM OVERHEAD CLEARANCE

CLEAR DISTANCE OF OPENING ABOVE STREAM BED 1 (WATERWAYS ONLY)

POSTED LOAD LIMITS BRIDGE NO. CONSTRUCTION DATE

GENERAL CONDITION OF BRIDGE: CHECK IF GOOD, FAIR, OR POOR, DESCRIBE DEFECTS IF SERIOUS.

	GOOD	FAIR	POOR
SUPERSTRUCTURE	✓		
FLOOR	✓		
SUBSTRUCTURE	✓		

PAINT BADLY CORRODED OR RUSTED

TYPE OF PROTECTION FOR DRAWBRIDGES (NOTE 9)

(NOTES ON REVERSE SIDE)

S26130

Notes:

1. In agreement with Federal-aid standards, a bridge is defined as a structure including supports erected over a depression or an obstruction, as water, highway, or railway, and having a track or passageway for carrying traffic or other moving loads, and having a length measured along the center of roadway of more than 20 feet between undercoping of abutments or spring lines of arches, or extreme ends of openings for multiple boxes and pipes, where the clear distance between openings is less than half of the smaller contiguous opening.

2. Show kind of crossing by checking descriptive item applicable. For multiple-span bridges give complete information on each span including approach spans. Indicate on leg sheet the odometer reading, position, and angle of skew of structure with respect to center line of road and by arrow the direction of stream flow.

3. Give information on the span over the highway only.

4. For span length use center to center of bearings, otherwise the clear opening. Skew bridges will be measured along center line of road. See Note 1.

5. Show general type such as: Trestle, Truss, Girder, I-Beam, Rigid Frame, Arch, Slab, Suspension, or Covered Bridge. See illustrations attached. Describe draw spans by classifications listed in Article X, Section 2 of Manual.

6. The length of a bridge structure is the over-all length measured along the line of survey stationing back to back of back-walls of abutments, if present, otherwise end to end of bridge floor, but in no case less than the total clear opening of the structure.

7. Give minimum lateral clearance. Where traffic lanes are separated by bridge numbers, show clearance width of each lane separately. Special conditions should be explained by notes.

8. In case of overhead bracing or arch construction, measurement shall be made to the lowest point above the road surface.

9. Use classification listed on RR crossing sheet. Form 4 HPS.

Remarks: _____

A rearrangement of the form similar to that shown on the attachment may be used to provide space for coding.

SHA 51.3-8
11-15-72

STATE HIGHWAY ADMINISTRATION OF MARYLAND

ROAD INVENTORY SHEET

T. LANDON
F. RHODES
VERIFIED 4/18/77

Party Chief _____
Recorder _____
Helper C. MARTIN

Map No. GH 24

Road No. CO 18
Road Name LAWS RD
Sheet No. 1 OF 2
Date 9-4-74
County WORCESTOR
State Coordinates 1249 - 158

	269	12" CP
	249	F
	241	PT ↑ 30°
	238	PC
	231	2-36" CMP
	223	
↑15° ~~H ACON~~	~~126~~ 173	
↑20°	146	
	118	24" CMP
	112	H
PT ↑ 30°		
PC	106	
	105	24" CMP
	100	H 25°↑
	093	F
↑20°	086	30°↑
0.02/15'F →	069	
	002	SPUR ROAD
	000	CO 19
		DISCHARGE

18'F 30'CW

16'F 30'CW

E ↑

SHA 51.3-8
11-15-72

ROAD INVENTORY SHEET

Road No. CO 18
Road Name LAWS RD
Sheet No. 2 OF 2
Date 9-4-74
County WORCESTOR
State Coordinates

WHITON MD

384
380
365
347
341
336
325
288
280
272

RD 354

25° ↑
H
↑15° H
↑PT 30° PC
SHOCKLEY CO
↑15°
H(VAC)
RDMD 20
PVT CEM 20 GRAVES
SAME

SHA 51.3-8
11-15-72

STATE HIGHWAY ADMINISTRATION OF MARYLAND

T. LANDON - F. RHODES
VERIFIED 4/1977

ROAD INVENTORY SHEET

Party Chief _____
Recorder _____
Helper C. MARTIN

Map No. GH 24

Road No. CO 19
Road Name DISHAROON RD
Sheet No. 1 OF 2
Date 9-4-74
County WORCESTOR
State Coordinates 1259-135

	1 51	18" cmp	
F	1 46		
	1 29	18" cmp	
	1 27	24" cmp	
~~0 91~~		~~#~~	
	0 90	24" cmp	
F (CARMEAN) RD CO 299	0 82		16' F
↑25°	0 74 (SHELL RD CO 27)		
	0 70		X
	0 61	36" CP	
~~0 56~~		~~#~~	
F 800'	0 42		
	0 29	F	(91-17) 18' I
	0 17	18" CMP	~~16' F~~ 24' CW
WHITON MD RD 354	0 00		V

NW ↑

SHA 51.3-8
11-15-72

ROAD INVENTORY SHEET

Road No. CO 19
Road Name DISHAROON RD
Sheet No. 2 OF 2
Date 9-4-74
County WORCESTOR
State Coordinates

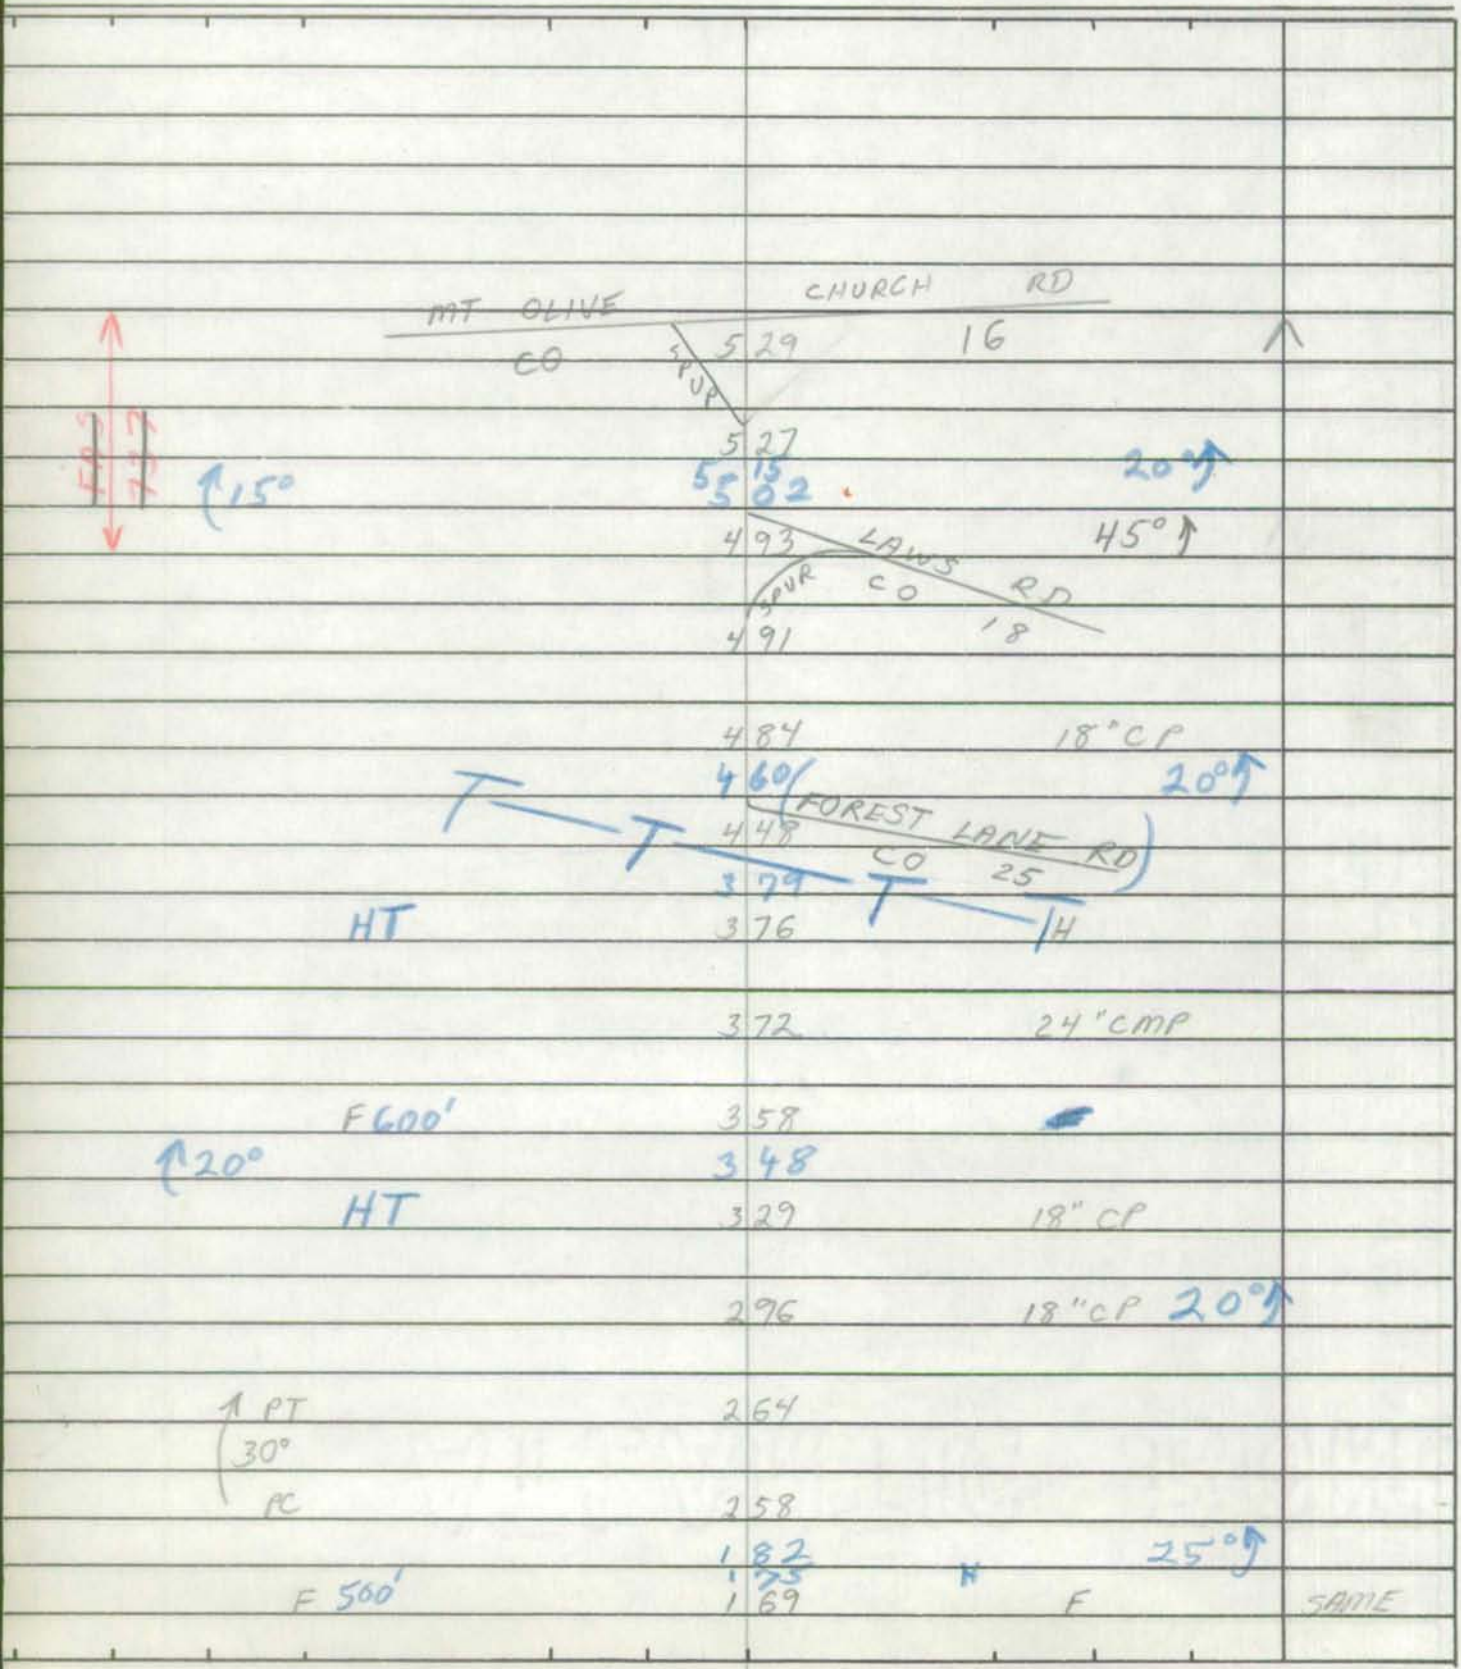

Form 6 HPS (Rev. 1961) 1265 - 167

ROAD INVENTORY SHEET

Party Chief F. SETTAN
Recorder T. LANDON
Chainman

T. LANDON
F. RHODES
VERIFIED
4/18/77

Road No. Co. 20
Name SHOCKLEY RD
Sheet No. 1 OF 2
Date 11-4-65
County WORCESTER

	2 05		
~~H~~ 3 H ~~H~~	~~2 04~~		
	2 00		
	1 85	PT	
		30°	
	1 80	PC	
↑30° H	1 55		
	1 28	PT	
		30°	
	1 23	PC	ROAD 18
LAWS CO.	1 21		
↑25°	1 19	CHURCH CEM	
H	0 95		
	0 88	END CEM	
(MT. ZION CHURCH ROAD)			
CO. 22	0 84	CHURCH CEM	
F	0 65		
H	0 28		
MD. WHITE OAK	0 10	F 15°↑	18'G 30'CW
	0 00		
			RD 854

S ↑

Form 6 HPS (Rev. 1961)

ROAD INVENTORY SHEET

Party Chief F. SETTAN
Recorder T. LANDON
Chainman

89-114

Road No. Co. 20
Name
Sheet No. 2 OF 2
Date 11-4-65
County WORCESTER

		RD 354	
WHITON MD,	3	50	↑
	3	23	F
			18' I
F	3	13	
(SAMUEL ROAD)			
Co. 23	3	02	
			~~16'6~~
F	2	96	~~24'6~~
		PVT. RD	
	2	62 9.0	18' I
			(9|-18)
	2	54	H
	2	50	X
	2	48	H
H-300'± H-~~AGAIN~~	2	44	
H-800'	2	42	
~~F.H.~~	~~2~~	~~29~~	
F	2	27	
		(VOTING HOUSE ROAD)	
HT	2	20 Co. 24	15° ↑
H	2	16	
H	2	14	
H	2	10	
			SAME

SHA 51.3-8
11-15-72

STATE HIGHWAY ADMINISTRATION OF MARYLAND

ROAD INVENTORY SHEET Davis Branch RD (89-14)

Party Chief _____
Recorder K. HESS
Helper _____

Map No. _____

VER 4-18-77

Road No. Co 21
Road Name ~~(DAVIS RD.)~~
Sheet No. 1 of 2
Date 11-4-65 (REVISED 10-6-77)
County WORCESTER
State Coordinates 1265-167

↑ 30°	1 50	
↑ 30°	1 08	
↑ 35°	0 94	
	0 84	PT ↑ 70° PC
	0 82	
	0 70	20° ↑
	0 58	WPC L-18'x W-15'x D-4' ≠ W#026
↑ 30°	0 44	
	0 40	60° ↑
↑ 20°	0 23	
↑ PT 35° PC	0 13	
	0 09	
	0 08	PT ↑ 30° PC
	0 06	
↑ 20°	0 01	12" CP 16'E 20'CW
WHITON MD	0 00 RD 354	

W ↑

SHA 51.3-8
11-15-72

ROAD INVENTORY SHEET

Road No. Co 21
Road Name
Sheet No. 2 of 2
Date
County WORCESTER
State Coordinates

PRIVATE ROAD AHEAD

ROAD 1 86 END

1 80 30° ↑

↑ 20° 1 71

SAME

Form 6 HPS (Rev. 1961) 1266-162

ROAD INVENTORY SHEET

Party Chief F. SETTAN
Recorder T. LANDON
Chainman

T. LANDON
F. RHODES
VERIFIED
4/18/17

Road No. Co. 22
Name (MT. ZION CHURCH RD)
Sheet No. 1 OF 1
Date 11-4-65
County WORCESTER

W

(SHOCKLEY RD)
Co. 030 20

16'F
30'CW

WHITON RD
MD 000 354

Form 6 HPS (Rev. 1961) 1267-152

ROAD INVENTORY SHEET

Party Chief F SETTAN
Recorder T LANDON
Chainman

T. LANDON
F. RHODES
VERIFIED
4/18/77

Road No. Co. 23
Name (SAMUEL RD)
Sheet No. 1 OF 1
Date 11-4-65
County WORCESTER

W

(SHOCKLEY ROAD)
Co. 031 20

16'G
24'CW

WHITIN RD
MP 000 354

Form 6 HPS (Rev. 1961) 1263-155

ROAD INVENTORY SHEET

Party Chief F SETTAN
Recorder T LANDEN
Chainman

T. LANDON
F. RHODES
VERIFIED
4/19/77

Road No. Co. 24
Name (VOTING HOUSE RD)
Sheet No. 1 OF 1
Date 11-4-65
County WORCESTER

		ROAD 25	
FOREST LANE CO.			
	1	43	
	1	42	002/16'G
	1	18	12" CP
↑20°	1	08	
	0	62	F 25° ↑
SW ↑			
	0	40	18" CMP
HT			
↑ PT	0	37	
30'			18'G
PC	0	29	30'CW
SHOCKLEY CO.	0	00	ROAD 20

Form 6 HPS (Rev. 1961) 1250-156

92-10
GD. AHATTEN
1-13-93

ROAD INVENTORY SHEET

T. LANDON
F. RHODES
VERIFIED
4/18/77

Party Chief F. SETTAN
Recorder T. LANAGAN
Chainman

K-17 Rural

Road No. Co. 25
Name ~~Co. Rt.~~ FOREST LANE RD
Sheet No. 1 OF 2
Date 11-5-65
County WORCESTER

	F 400'	2 75	
	SWEETSPARE LANE	2 55	20° ↓
	Co ~~S.R. 8~~ 694	2 48	
↑25°	SCHOOL - ABAN	2 46	
	H	2 31	
	H	2 17	
		2 13	PT 35' PC ↑
		2 10	
↑20°		2 06	
		1 96	18" CP
	(VOTING HOUSE ROAD		
		1 94	30° ↑
↑25°	Co. 24	1 85	
		~~1 80~~	
↑PT 40° PC		1 42	0.02/16'G
		1 40	
E ↑			
		1 11	18" CP
↑20°		0 96	20° ↑
		0 75	
	↑PT 30' PC	0 53	
			18' F
		0 48	30' Cul
↑20°	DISHAROON	0 35	20° ↑
		0 21	ROAD
	Co.	0 00	19

Form 6 HPS (Rev. 1961)

ROAD INVENTORY SHEET

Party Chief F. SETTAN
Recorder T. L. HANDON
Chainman

Road No. Co. 25
Name
Sheet No. 2 OF 2
Date 11-5-65
County WORCESTER

WHITON		RD	
MD.	378	354	
	329		36" CMP
~~334~~		~~"~~	
~~344~~		~~"~~	
			SAME

SHA 51.3-8
11-15-72

STATE HIGHWAY ADMINISTRATION OF MARYLAND

90 EX #4
1-22-91
BB/TM

ROAD INVENTORY SHEET

Party Chief _____
Recorder K. HESS
Helper _____

Map No. GH24

VER 4-19-77

Road No. Co 26
Road Name PORTERS CROSSING RD.
Sheet No. 1 of 1
Date 12-15-65 (REVISED 10-7-77)
County WORCESTER
State Coordinates 1267 - 148

8321
88-218

WORCESTER
US 214 113 HWY SS

PT
30°
PC

205

202

172

PT
40°
PC

168

16'F
22'CW

20° 158

135 H 15°

18'I
22'CW

30° 129

#W-0213

108

POCOMOKE 099 RIVER
SEE BR. SH. 1-A

88-218

079

PT
70°
PC

16'F

075

20'I
2ML

SE

068 20°

PT
75°
PC

054

F 900'

051

18'I

F

039

16'F
22'CW
2ML

WHITON
MD 000 354 RD SS

SHA 51.3-8
11-15-72

ROAD INVENTORY SHEET

Road No. _____
Road Name _____
Sheet No. _____
Date _____
County _____
State Coordinates _____

IN COOPERATION WITH
FEDERAL HIGHWAY ADMINISTRATION

026

BRIDGE SHEET

ROAD NO. 3 26

SHEET NO. _____

PARTY NO. _____

DATE 12/14/90

COUNTY Worcester

RATED CAPACITY HS 20-44

FOR ALL STRUCTURES HAVING A TOTAL OPENING OF MORE THAN 20 FEET AS DEFINED IN NOTE 1.

ODOMETER READING _____ NAME OF STREAM, RAILROAD OR HIGHWAY CROSSED Pocomoke River (Porters Crossing Road)

NUMBER OF RAILROAD TRACKS _____

KIND OF CROSSING (NOTE 2) _____

UNDERPASS-SIMPLE UNDERPASS-COMBINED (NOTE 3) OVERPASS BRIDGE OVER SYSTEM

DESCRIPTION

NUMBER OF SPANS	LENGTH EACH SPAN (NOTE 4)	TYPE (NOTE 5)
2	46'0"	Glue Laminate Timber

TOTAL LENGTH-ON LINE OF ROAD OVER-ALL (NOTE 6) 92'0"

MATERIAL

SUBSTRUCTURE Timber Creosote SUPERSTRUCTURE Glue Laminate Timber treated with Pentachlorophenol

FLOOR Glue Laminate Timber treated with Pentachlorophenol

CLEARANCES

ROADWAY (NOTE 7) 22'0" SIDEWALK WIDTHS: RIGHT LEFT

SURFACE OF ROAD TO STREAM BED 8'0" FOR OVERPASSES, SHOW DISTANCES TO TOP OF RAIL OR SURFACE OF LOWER ROAD. (NOTE 8)

SURFACE OF ROAD TO BOTTOM PORTAL _____ (MINIMUM OVERHEAD CLEARANCE

CLEAR DISTANCE OF OPENING ABOVE STREAM BED _____ (WATERWAYS ONLY)

POSTED LOAD LIMITS None BRIDGE NO. Wo-0213 CONSTRUCTION DATE 12/90

GENERAL CONDITION OF BRIDGE: CHECK IF GOOD, FAIR, OR POOR, DESCRIBE DEFECTS IF SERIOUS.

	GOOD	FAIR	POOR
SUPERSTRUCTURE	X		
FLOOR	X		
SUBSTRUCTURE	X		

PAINT BADLY CORRODED OR RUSTED

TYPE OF PROTECTION FOR DRAWBRIDGES _____

SHA 51.3 - 22
10-1-73

(NOTES ON REVERSE SIDE)

Notes:

1. In agreement with Federal-aid standards, a bridge is defined as a structure including supports erected over a depression or an obstruction, as water, highway, or railway, and having a track or passageway for carrying traffic or other moving loads, and having a length measured along the center of roadway of more than 20 feet between undercoping of abutments or spring lines of arches, or extreme ends of openings for multiple boxes and pipes, where the clear distance between openings is less than half of the smaller contiguous opening.

2. Show kind of crossing by checking descriptive item applicable. For multiple-span bridges give complete information on each span including approach spans. Indicate on leg sheet the odometer reading, position, and angle of skew of structure with respect to center line of road and by arrow the direction of stream flow.

3. Give information on the span over the highway only.

4. For span length use center to center of bearings, otherwise the clear opening. Skew bridges will be measured along center line of road. (See note 1.)

5. Show general type such as: Trestle, Truss, Girder, I-Beam, Rigid Frame, Arch, Slab, Suspension, or Covered Bridge.

6. The length of a bridge structure is the over-all length measured along the line of survey stationing back to back of back-walls of abutments, if present, otherwise end to end of bridge floor, but in no case less than the total clear opening of the structure.

7. Give minimum lateral clearance. Where traffic lanes are separated by bridge members, show clearance width of each lane separately. Special conditions should be explained by notes.

8. In case of overhead bracing or arch construction, measurement shall be made to the lowest point above the road surface.

Remarks: _____

_____

SHA 51.3-8
11-15-72

STATE HIGHWAY ADMINISTRATION OF MARYLAND

ROAD INVENTORY SHEET

T. LANDON
F. RHOADES
VERIFIED
4/9/77.

Party Chief _____
Recorder _____
Helper C. MARTIN

Map No. GH 24

Road No. CO 27
Road Name SHELL RD
Sheet No. 1 OF 1
Date 9-4-74
County WORCESTOR
State Coordinates 1261-142

		(CARMEAN RD) 299	
DISHAROON CO	118	ROAD 19	↑
	094	24" CMP	
	093	F	
F	057	F	
↑20°	046		
	031	F	
	029	36" CMP	
SW ↑	021	H	
0.01 SLOPE 12'I	002	F 600'	18'I 16'G 24'CW
30 WELTON (E) 254.	000	H	↓

SHA 51.3-8
11-15-72

ROAD INVENTORY SHEET

Road No. _____
Road Name _____
Sheet No. _____
Date _____
County _____
State Coordinates _____

SHA 51.3 - 8 Revised
4.83

FCR 95

MARYLAND STATE HIGHWAY ADMINISTRATION

ROAD INVENTORY SHEET

Party Chief G.D.
Recorder A.H.
Assistant
Map No./Dir. K-17 / SW
State Coordinates 1257 - 134

Road No. Co 28
Road Name NASSAWANGO RD
County WORCESTER
Date 4/20/95
Sheet No. 1 OF 6

98-5 NT
89-15
79-3
78-6
77-13

TRAFFIC CODES
TRAFFIC CONTROLS: STOP SIGN=SS, TRAFFIC LIGHT=T.L., FLASHING RED BALL=F.R.

TRAFFIC CODES
PARKING RESTRICTIONS: A.M. PEAK, P.M. PEAK, A.M./P.M. PEAK, NO PARKING ANYTIME=N.P., COMM/IND. ACCESS=E

SYSTEM				TRAFFIC		LINE DIAGRAM			TRAFFIC			PAVEMENT DATA
FED. AID.	FUNCT. CLASS.	HWY. SYS.	HPMS SAMPLE	PRK'G. REST.	COM/IND. ACCESS				CONTROL	COM/IND. ACCESS	PRK'G. REST.	
	Collector											
						1	48	2-36" CMP				
								PENNEWELL RD				
	Major					1	32 Co	30				
								SPENCER RD				
						0	37 Co	29				
	Rural											22'I
												2ML
							(SNOW	HILL RD)				
K							MD 0 00	12	FR SS			
						Rd						
						354						
						Whiton MD						

SYSTEM: FED. AID. | FUNCT. CLASS. | HWY. SYS. | HPMS SAMPLE

Rural Major Collector

TRAFFIC: PRKG. REST. | COM/IND ACCESS

LINE DIAGRAM

30°

4 10

2 36 PT

CREEK RD 502 45°

CO

2 33

2 32 PC

PT

2 16

70°

#W0207

20' WOOD WOOD H.W.

PC

2 11

NASSAWANGO

2 09

CREEK

2 08

TRAFFIC: CONTROL | COM/IND ACCESS | PRKG. REST.

PAVEMENT DATA

22' I

2 M L

SHA 51.3 - 8 Revised
4.83

MARYLAND STATE HIGHWAY ADMINISTRATION

ROAD INVENTORY SHEET

Party Chief: GD
Recorder: AH
Assistant:
Map No./Dir.: K-17 /
State Coordinates:

Road No.: Co 28
Road Name: NASSAWANGO RD
County: WORCESTER
Date: 4/20/45
Sheet No.: 3 OF 6

TRAFFIC CODES
TRAFFIC CONTROLS: STOP SIGN=SS, TRAFFIC LIGHT=T.L., FLASHING RED BALL=F.R.

TRAFFIC CODES
PARKING RESTRICTIONS: A.M. PEAK, P.M. PEAK, A.M./P.M. PEAK, NO PARKING ANYTIME=N.P., COMM/IND. ACCESS=E

SYSTEM				TRAFFIC		LINE DIAGRAM	TRAFFIC			PAVEMENT DATA
FED. AID.	FUNCT CLASS.	HWY. SYS.	HPMS SAMPLE	PRKG. REST.	COM/IND. ACCESS		CONTROL	COM/IND. ACCESS	PRKG. REST.	
	Collector					PRC 4 85 PEC 300 PC 4 79				
					E	NASSAWANGO COUNTRY CLUB 4 77				
	Major					4 68 PT 30°				
						4 60 PC				
	Rural				E	NASSAWANGO COUNTRY CLUB 4 45				22'I 2ML

SYSTEM: FED. AID. | FUNCT. CLASS. | HWY. SYS. | HPMS SAMPLE

FUNCT. CLASS: Rural — Major — Collector

TRAFFIC: PRK.G. REST. | COM/IND ACCESS

LINE DIAGRAM

6 55 PT

30°

6 43 PC

6 31 PT

50°

6 17 PC

5 57 PT

35°

5 48 PC

(CAMP RD)

4 98 CO 31

4 90 PT

30°

TRAFFIC: CONTROL | COM/IND ACCESS | PRK.G. REST.

PAVEMENT DATA

22 I
2 ML

SHA 51.3 - 8 Revised
4.83

MARYLAND STATE HIGHWAY ADMINISTRATION

ROAD INVENTORY SHEET

Party Chief: GD
Recorder: AH
Assistant:
Map No./Dir.: K-17 /
State Coordinates:

Road No.: Co 28
Road Name: NASSAWANGO RD
County: WORCESTER
Date: 4/20/95
Sheet No.: 5 OF 6

TRAFFIC CODES
TRAFFIC CONTROLS: STOP SIGN=SS, TRAFFIC LIGHT=T.L., FLASHING RED BALL=F.R.

TRAFFIC CODES
PARKING RESTRICTIONS: A.M. PEAK, P.M. PEAK, A.M./P.M. PEAK, NO PARKING ANYTIME=N.P., COMM/IND. ACCESS=E

SYSTEM				TRAFFIC		LINE DIAGRAM	TRAFFIC			PAVEMENT DATA
FED. AID.	FUNCT. CLASS.	HWY. SYS.	HPMS SAMPLE	PRKG. REST.	COM/IND. ACCESS		CONTROL	COM/IND. ACCESS	PRKG. REST.	
	Rural Major Collector				E	7 49 PT 7 SCOTTY RD 160° 2500 33 PC 6 92 PT 90° 6 89 2-60" CMP 6 85 PC PT 6 79 TO POCOMOKE STATE PARK 1 SR 1 6 77 60° PC 6 74				
					E	PARK MAIN. 6 60				22'I 2ML

SYSTEM				TRAFFIC		LINE DIAGRAM	TRAFFIC			PAVEMENT DATA
FED. AID.	FUNCT. CLASS.	HWY. SYS.	HPMS SAMPLE	PRK.G. REST.	COM/IND ACCESS		CONTROL	COM/IND ACCESS	PRK.G. REST.	
	Rural Major Collector					RD HOLLAR CELLAR CO RD 364 CREEK 7 83 SIGN: BEGIN STATE MAINT. RESTRICTS TO MD 364 DIVIDING MD 45° 7 54				22'E 2ML

Form 5-HPS
(Revised 1961)

MARYLAND STATE ROADS COMMISSION
PLANNING AND PROGRAMMING DIVISION

S26130

IN COOPERATION WITH
U.S. BUREAU OF PUBLIC ROADS

ROAD NO. 0028

BRIDGE SHEET

SHEET NO. 1-A

PARTY NO.

DATE 12-2-69

COUNTY Worcester

RATED CAPACITY

FOR ALL STRUCTURES HAVING A TOTAL OPENING OF MORE THAN 20 FEET AS DEFINED IN NOTE 1.

ODOMETER READING 2.10 NAME OF STREAM, RAILROAD OR HIGHWAY CROSSED ~~Nassawango Rd.~~ NASSAWANGO CREEK

NUMBER OF RAILROAD TRACKS

KIND OF CROSSING (NOTE 2) Bridge Over Stream

UNDERPASS-SIMPLE UNDERPASS-COMBINED (NOTE 3) OVERPASS BRIDGE OVER SYSTEM

DESCRIPTION

NUMBER OF SPANS	LENGTH EACH SPAN (NOTE 4)	TYPE (NOTE 5)
8	(7) 14.0' - (1) 14.5'	Girder

TOTAL LENGTH-ON LINE OF ROAD OVER-ALL (NOTE 6) 113.0'

MATERIAL

SUBSTRUCTURE Creosoted Timber SUPERSTRUCTURE Creosoted Timber

, FLOOR Wood

CLEARANCES

ROADWAY (NOTE 7) 19.0' SIDEWALK WIDTHS: RIGHT None LEFT None

SURFACE OF ROAD TO STREAM BED 14.0' FOR OVERPASSES, SHOW DISTANCES TO TOP OF RAIL OR SURFACE OF LOWER ROAD. (NOTE 8)

SURFACE OF ROAD TO BOTTOM PORTAL (MINIMUM OVERHEAD CLEARANCE

CLEAR DISTANCE OF OPENING ABOVE STREAM BED 12' (WATERWAYS ONLY)

POSTED LOAD LIMITS BRIDGE NO. 20 CONSTRUCTION DATE 11-17-69

GENERAL CONDITION OF BRIDGE: CHECK IF GOOD, FAIR, OR POOR, DESCRIBE DEFECTS IF SERIOUS.

	GOOD X	FAIR	POOR
SUPERSTRUCTURE	Good		
FLOOR	Good		
SUBSTRUCTURE	Good		

PAINT BADLY CORRODED OR RUSTED

TYPE OF PROTECTION FOR DRAWBRIDGES (NOTE9)

(NOTES ON REVERSE SIDE)

S26130

Notes:

1. In agreement with Federal-aid standards, a bridge is defined as a structure including supports erected over a depression or an obstruction, as water, highway, or railway, and having a track or passageway for carrying traffic or other moving loads, and having a length measured along the center of roadway of more than 20 feet between undercoping of abutments or spring lines of arches, or extreme ends of openings for multiple boxes and pipes, where the clear distance between openings is less than half of the smaller contiguous opening.

2. Show kind of crossing by checking descriptive item applicable. For multiple-span bridges give complete information on each span including approach spans. Indicate on leg sheet the odometer reading, position, and angle of skew of structure with respect to center line of road and by ar w the direction of stream flow.

3. Give information on the span over the highway only.

4. For span length use center to center of bearings, otherwise the clear opening. Skew bridges will be measured along center line of road. See Note 1.

5. Show general type such as: Trestle, Truss, Girder, I-Beam, Rigid Frame, Arch, Slab, Suspension, or Covered Bridge. See illustrations attached. Describe draw spans by classifications listed in Article X, Section 2 of Manual.

6. The length of a bridge structure is the over-all length measured along the line of survey stationing back to back of back-walls of abutments, if present, otherwise end to end of bridge floor, but in no case less than the total clear opening of the structure.

7. Give minimum lateral clearance. Where traffic lanes are separated by bridge numbers, show clearance width of each lane separately. Special conditions should be explained by notes.

8. In case of overhead bracing or arch construction, measurement shall be made to the lowest point above the road surface.

9. Use classification listed on RR crossing sheets. Form 4 HPS.

Remarks: _____

A rearrangement of the form similar to that shown on the attachment may be used to provide space for coding.

Form 6 HPS (Rev. 1961)

1256-132

ROAD INVENTORY SHEET

Party Chief F. SETTANI
Recorder T. LANDON
Chainman

T. LANDON
T. JONES
VERIFIED
4/22/17

Road No. Co. 29
Name (SPENCER RD)
Sheet No. 10F1
Date 11-5-65
County WORCESTER

	ROAD	END	
NW ↑		066	↑
	H	054	
	F	049	
			18'F
	F 500'	015	30'CW
	NASSAWANGO Co.	000 ROAD 28	↓

Form 6 HPS (Rev. 1961) 1252-128 89-113

ROAD INVENTORY SHEET

T. LANDON
F. RHODES
VERIFIED
4/22/77

Party Chief F. SUTTON
Recorder T. LANDON
Chainman

Road No. CO. 38
Name PENNEWELL RD
Sheet No. 1 OF 2
Date 11-9-65
County WORCESTER

1PT 60° PC	~~H~~	1	61	
	~~F-H ARRW~~	1	48	
		1	42	PT 70° ~~40°~~ PC
		1	36	
	F 700'	1	16	
		1	15	2-36" CMP
		1	05	H 600' 16' F
		1	00	X 30' CW
	H	0	83	
		0	73	F
				18' I (91-16)
NW ↑	F	0	62	
		0	60	
		0	45	H
		0	19	F 16' I
		0	11	60" CMP
				~~16' F~~
	H	0	05	~~30' CW~~
	NASSAWANGO CO.	000	ROAD 28	

Form 6 HPS (Rev. 1961)

ROAD INVENTORY SHEET

Party Chief F. SETTAN
Recorder T. LONDON
Chainman

Road No. CO. 30
Name
Sheet No. 2 OF 2
Date 11-9-65
County WORCESTER

SHA 51.3-8
11-15-72

STATE HIGHWAY ADMINISTRATION OF MARYLAND

T. LANDON
F. RHODES
VERIFIED 4/25/77

ROAD INVENTORY SHEET

Party Chief OFF INV. (E. DAVIS)
Recorder
Helper

Map No. G24

AS PER C.T.C.

Road No. Co 31
Road Name (CAMP RD.)
Sheet No. 1 OF 1
Date 9-5-74 REV. 12-10-76
County WORCESTER
State Coordinates 1238 - 116

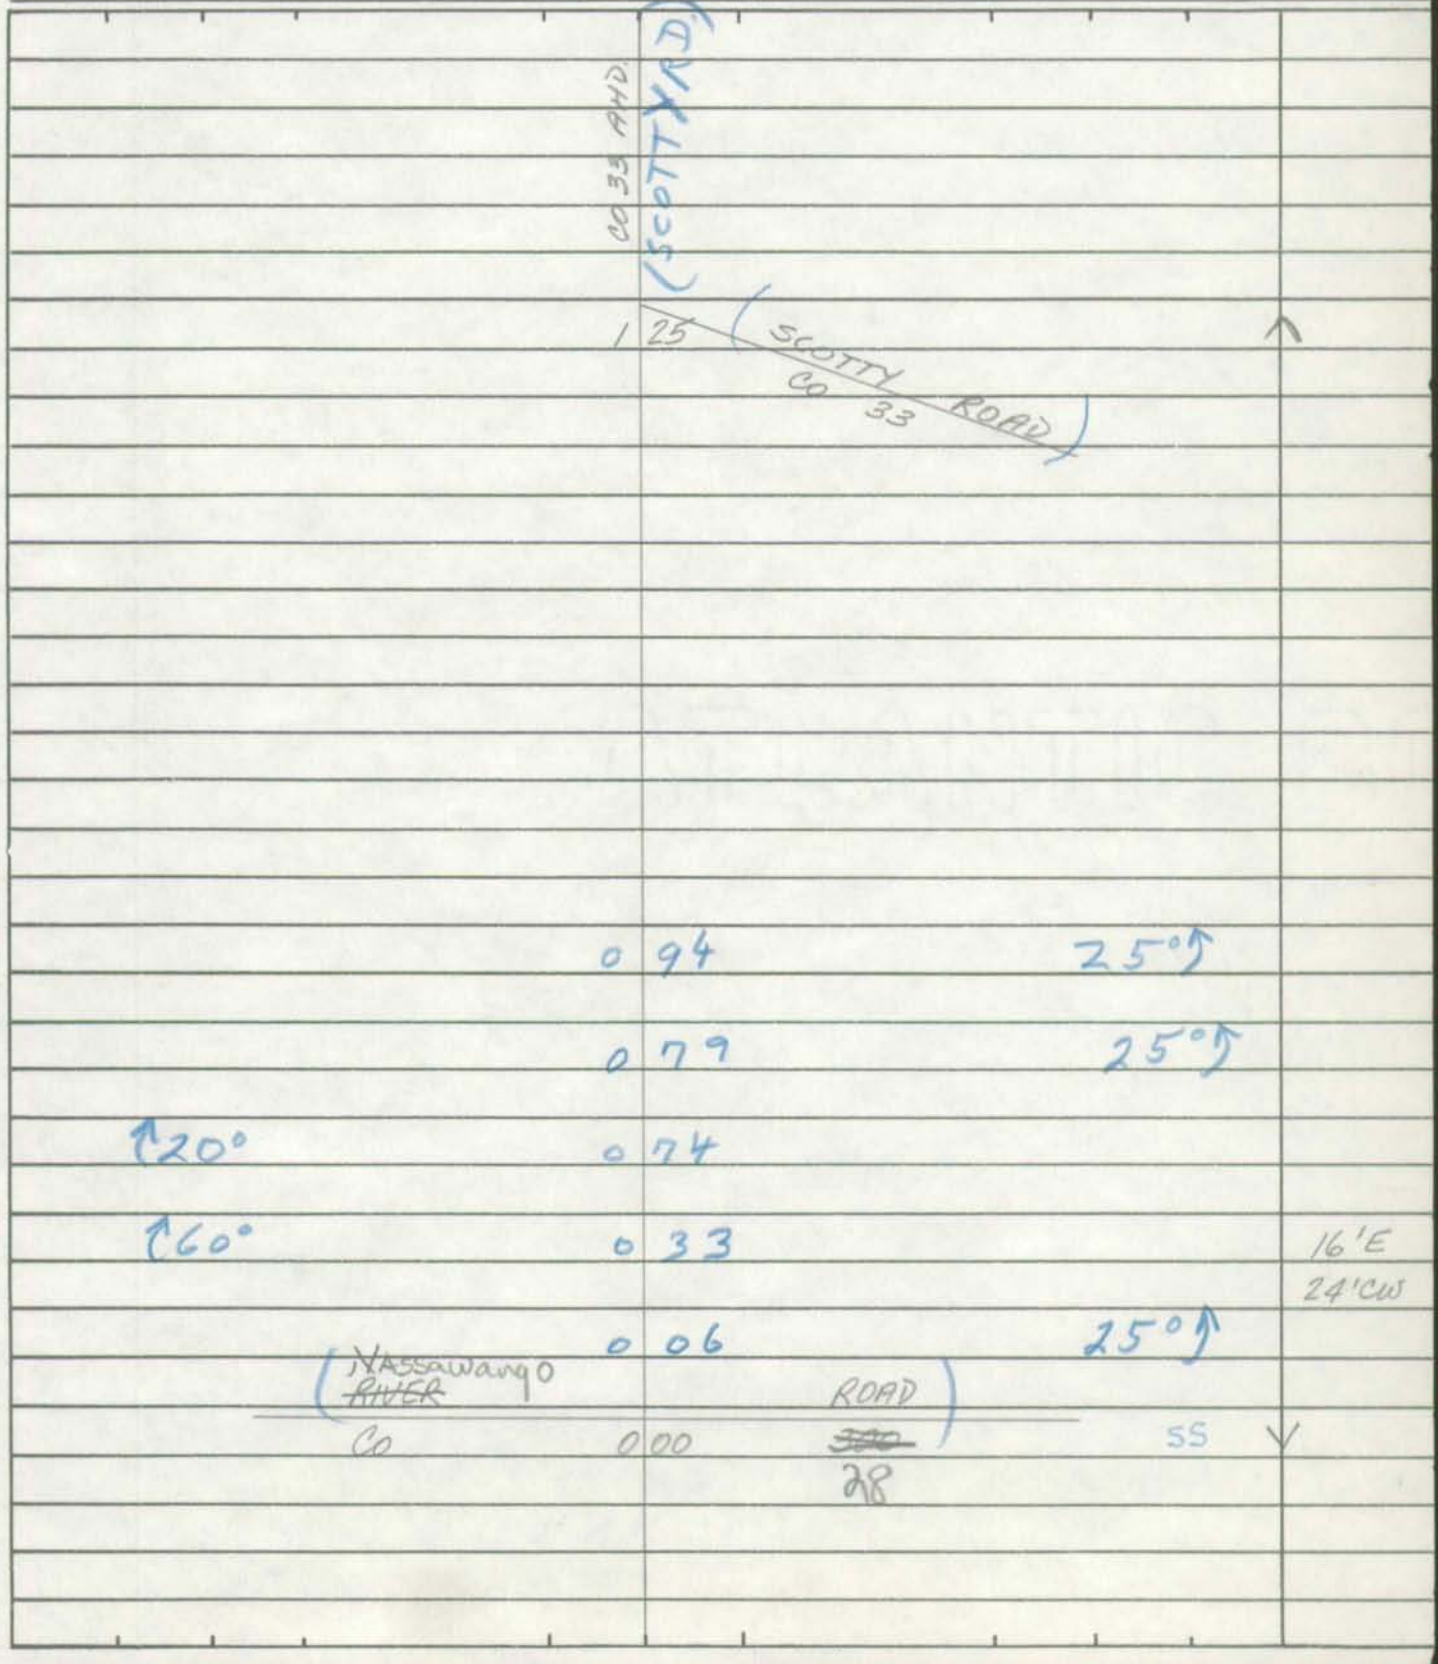

SHA 51.3-8
11-15-72

ROAD INVENTORY SHEET

Road No. _____
Road Name _____
Sheet No. _____
Date _____
County _____
State Coordinates _____

SHA 51.3-8
11-15-72

STATE HIGHWAY ADMINISTRATION OF MARYLAND

ROAD INVENTORY SHEET

Party Chief _____
Recorder K. Hess
Helper _____

Map No. _____ VER 4-21-77

Road No. Co 32
Road Name BLADES RD
Sheet No. 1 of 1
Date 11-18-65 (REVISED 10-7-77)
County WORCESTER
State Coordinates 1241-106

89-104

POCOMOKE RIVER

N

H
0.30
ROAD 0 80 END

0 77 30° ↰

0 65 20° ↰ ~~16'~~ 18' F

↱20° 0 56

↱15° 0 38

SB WORCESTER US N.B. 0 00 113 HWY

SHA 51.3-8
11-15-72

ROAD INVENTORY SHEET

Road No. _____
Road Name _____
Sheet No. _____
Date _____
County _____
State Coordinates _____

AS PER C.T.C.

VERIFIED-4/25/77

SHA 51.3 - 8 Revised 4.83

MARYLAND STATE HIGHWAY ADMINISTRATION

ROAD INVENTORY SHEET

Party Chief OFF INV. (ED DAVIS)
Recorder Rewritten (JEL) 1/20/92
Assistant
Map No./Dir. GH24/ SW
State Coordinates 1244-132

Road No. CO 33
Road Name (Scotty RD)
County Worchester
Date 11-9-65 Rev. 12-10-76
Sheet No. 1 OF 5

TRAFFIC CODES
TRAFFIC CONTROLS: STOP SIGN=SS, TRAFFIC LIGHT=T.L., FLASHING RED BALL=F.R.

TRAFFIC CODES
PARKING RESTRICTIONS: A.M. PEAK, P.M. PEAK, A.M./P.M. PEAK, NO PARKING ANYTIME=N.P., COMM/IND. ACCESS=E

SYSTEM				TRAFFIC		LINE DIAGRAM	TRAFFIC			PAVEMENT DATA
FED. AID.	FUNCT CLASS.	HWY. SYS.	HPMS SAMPLE	PRK.G. REST.	COM/IND. ACCESS		CONTROL	COM/IND. ACCESS	PRK.G. REST.	
						PT 1 21				
						30°				
						PC 1 16				
										18' F
										30' CLW
						0 95 25°			X	
						0 80 38°				
						0 65 12" CMP				
						PVT. RD 8' D 0 55				
						0 13 20°				
										16' F
										30' CLW
						(CREEK RD) CO 0 00 30 2				
K	K					20°			V	

NON FIA
RURAL LOCAL

SYSTEM				TRAFFIC		LINE DIAGRAM	TRAFFIC				PAVEMENT DATA
FED. AID.	FUNCT. CLASS.	HWY. SYS.	HPMS SAMPLE	PRKG. REST.	COM/IND ACCESS		CONTROL	COM/IND ACCESS	PRKG. REST.		
						↑20° 2 48 36" CMP					16' F 26' CW
						2 36 30°↑				X	
						2 04 24" CMP					
						1 86 15°↑					
						1 72 18" CMP					
						PT 1 68 40° PC 1 57					
						1 51 PT 30°					18' F 30' CW
						1 41 18" CMP PC					

NON EIA RURAL LOCAL

SHA 51.3 - 8 Revised
4.83

MARYLAND STATE HIGHWAY ADMINISTRATION

ROAD INVENTORY SHEET

Party Chief _____
Recorder _____
Assistant _____
Map No./Dir. GH24 / SW
State Coordinates 1244 - 132

Road No. CO 33
Road Name (Scotty RD)
County Worchester
Date _____
Sheet No. 3 OF 5

TRAFFIC CODES

TRAFFIC CONTROLS: STOP SIGN=SS, TRAFFIC LIGHT=T.L., FLASHING RED BALL=F.R.

TRAFFIC CODES

PARKING RESTRICTIONS: A.M. PEAK, P.M. PEAK, A.M./P.M. PEAK, NO PARKING ANYTIME=N.P., COMM/IND. ACCESS=E

NON FIA
RURAL LOCAL

SYSTEM				TRAFFIC		LINE DIAGRAM	TRAFFIC			PAVEMENT DATA
FED. AID.	FUNCT CLASS.	HWY. SYS.	HPMS SAMPLE	PRKG. REST.	COM/IND. ACCESS		CONTROL	COM/IND. ACCESS	PRKG. REST.	
						3 54 20° ↑				
						3 36 FT ↖				
						(Corner House Rd) 70° ↗				(91-14)
						3 32 CO 35 ↗				18' I
										~~16' F~~
										24' CW
						(Camp RD)				
						↑80° CO 31 3 16				X
						2 91 20° ↑				
						2 63 HT				
										16' F
										26' CW
						↑20° 2 53 HT				

SYSTEM: FED. AID. | FUNCT. CLASS. | HWY. SYS. | HPMS SAMPLE
TRAFFIC: PRKG. REST. | COM/IND ACCESS

LINE DIAGRAM

TRAFFIC: CONTROL | COM/IND ACCESS | PRKG. REST.

PAVEMENT DATA

NON FIA
RURAL LOCAL

(Oak Hall RD)

4 89 CO 37

T 20° 4 82

4 57 20° T

16'F
24'CW

T 30° 4 39

4 31 X

PT
50°
PC 4 10

T 20° 4 05 PVT CEM

3 84 18" CP

3 79 PT

700

3 76 PC

(91-14)
18'I
~~16'E~~
24'CW

SHA 51.3 - 8 Revised
4.83

MARYLAND STATE HIGHWAY ADMINISTRATION

ROAD INVENTORY SHEET

Party Chief _____
Recorder _____
Assistant _____
Map No./Dir. GH24/SW
State Coordinates 1244 - 132

Road No. CO 33
Road Name (Scotty RD)
County Worchester
Date _____
Sheet No. 5 OF 5

TRAFFIC CODES
TRAFFIC CONTROLS: STOP SIGN=SS, TRAFFIC LIGHT=T.L., FLASHING RED BALL=F.R.

TRAFFIC CODES
PARKING RESTRICTIONS: A.M. PEAK, P.M. PEAK, A.M./P.M. PEAK, NO PARKING ANYTIME=N.P., COMM/IND. ACCESS=E

SYSTEM				TRAFFIC		LINE DIAGRAM	TRAFFIC			PAVEMENT DATA
FED. AID.	FUNCT. CLASS.	HWY. SYS.	HPMS SAMPLE	PRK.G. REST.	COM/IND. ACCESS		CONTROL	COM/IND. ACCESS	PRK.G. REST.	
						ROAD N				
						PT NASSAWANGO CO 5 27				
						30°				
						PC 5 11				
						5 08 PT				
						5 00 80°				16' F
						4 92 PC				24' CW

NON FIA Rural Local

SYSTEM				TRAFFIC		LINE DIAGRAM	TRAFFIC				PAVEMENT DATA
FED. AID.	FUNCT. CLASS.	HWY. SYS.	HPMS SAMPLE	PRKG. REST.	COM/IND ACCESS		CONTROL	COM/IND ACCESS	PRKG. REST.		

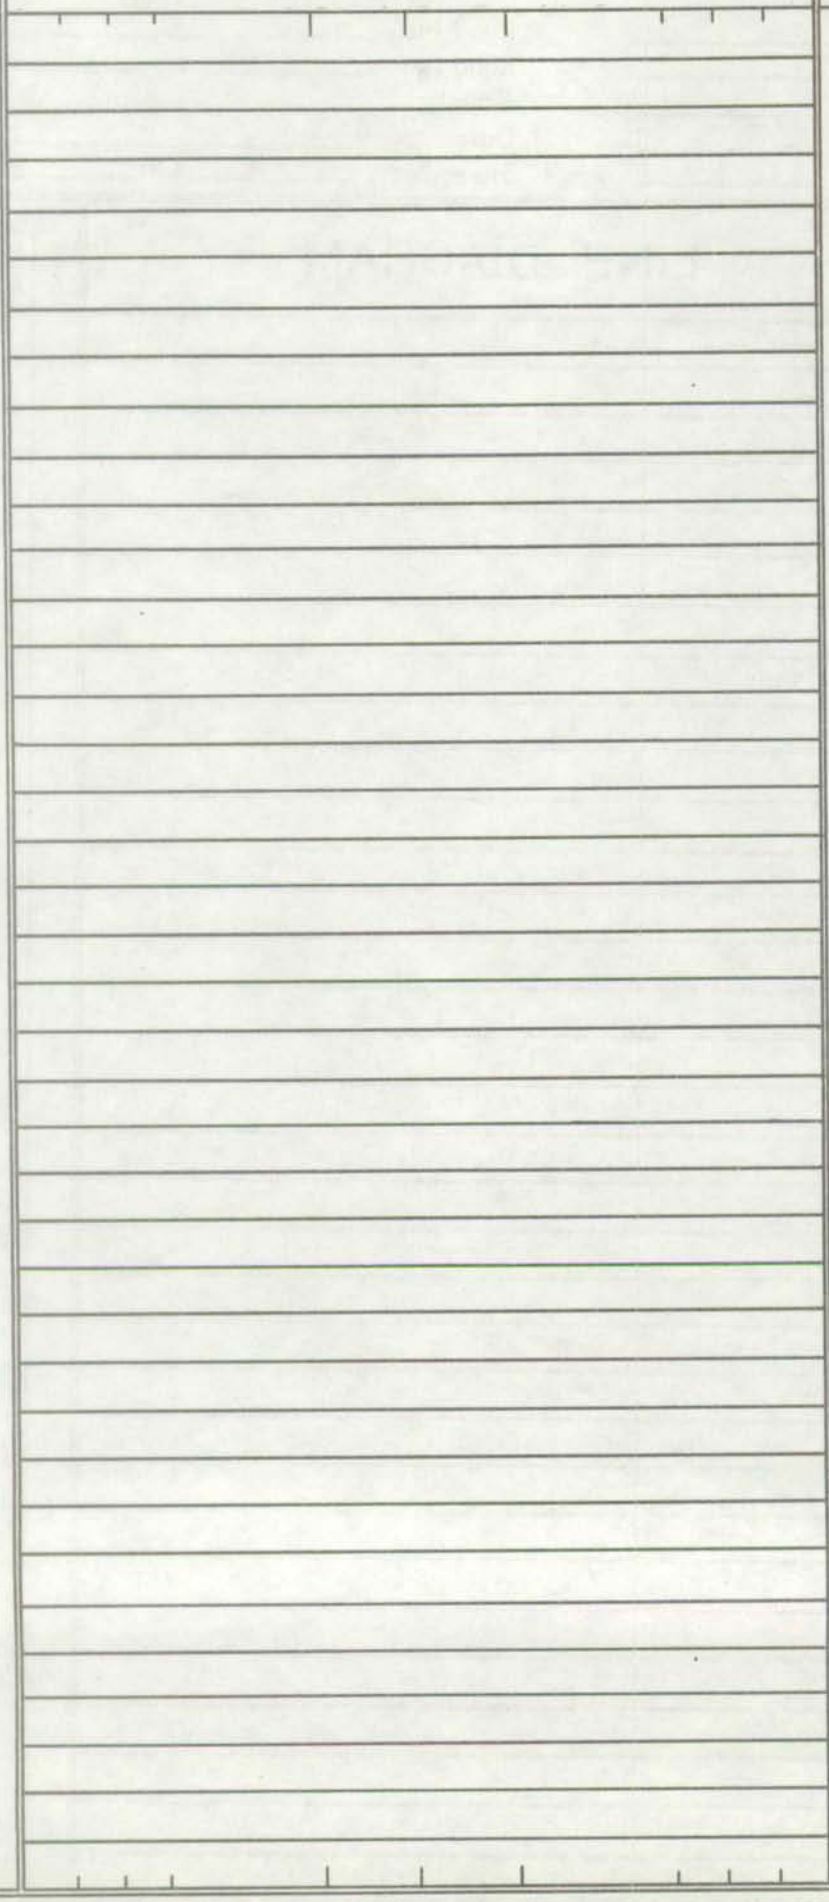

SHA 51.3-8
11-15-72

STATE HIGHWAY ADMINISTRATION OF MARYLAND

BB84-5+6
RM 2-13-85 T. LANDON / F. RHOADES VERIFIED 4/29/77

ROAD INVENTORY SHEET

Party Chief _____
Recorder _____
Helper C. MARTIN

Road No. CO 34
Road Name RED HOUSE RD
Sheet No. 1 OF 1
Date 9-5-74
County WORCESTER
State Coordinates 1249-137

94-2
1-11-95
GD/TM

Map No. GH 24

CREEK RD CO 342 RED HOUSE RD CO 34 18

# W00210 NASSAWANGO 22' wood w-w	1	24	CREEK SEE BR SH 1-A	
	1	17		82-7
PENNEWELL RD CO 30	1	15		~~20'I~~ ~~30'W~~
H	1	10		~~2 ML~~
	0	90		
	0	85	F 600'	
	0	82	H	
	0	71	HALL	
	0	70	CHURCH CEM	18'I 30'CW
	0	65	H	2 ML ~~16'G~~
	0	62	H	~~30'W~~
SW ↑ F 400'	0	56		~~12'G~~
	0	50		~~20'I~~
H	0	43	12" CMP	~~30'W~~
	0	25		
H	0	18		20'I ~~16'G~~ 30'CW 2 ML
~~#~~	~~0~~	~~12~~		
SNOW HILL RD MD	0	00	12 SS	

SHA 51.3-8
11-15-72

ROAD INVENTORY SHEET

Road No. _____
Road Name _____
Sheet No. _____
Date _____
County _____
State Coordinates _____

Form 5-HPS (Revised 1961) MARYLAND STATE ROADS COMMISSION PLANNING AND PROGRAMMING DIVISION S26130

IN COOPERATION WITH
U. S. BUREAU OF PUBLIC ROADS

ROAD NO. Co. 34

BRIDGE SHEET

SHEET NO. 1-A

PARTY NO.

DATE 11-9-65

COUNTY DORCHESTER

RATED CAPACITY

FOR ALL STRUCTURES HAVING A TOTAL OPENING OF MORE THAN 20 FEET AS DEFINED IN NOTE 1.

ODOMETER READING 1.24 NAME OF ~~STREAM~~, RAILROAD OR HIGHWAY CROSSED NASSAWANGO CREEK

NUMBER OF RAILROAD TRACKS

KIND OF CROSSING (NOTE 2)

UNDERPASS-SIMPLE UNDERPASS-COMBINED (NOTE 3) OVERPASS BRIDGE OVER SYSTEM

DESCRIPTION

NUMBER OF SPANS	LENGTH EACH SPAN (NOTE 4)	TYPE (NOTE 5)
4	14'	WOOD PILE

TOTAL LENGTH-ON LINE OF ROAD OVER-ALL (NOTE 6) 56'

MATERIAL
SUBSTRUCTURE WOOD SUPERSTRUCTURE WOOD
FLOOR WOOD

CLEARANCES
ROADWAY (NOTE 7) 13' SIDEWALK WIDTHS: RIGHT LEFT

SURFACE OF ROAD TO STREAM BED 5' FOR OVERPASSES, SHOW DISTANCES TO TOP OF RAIL OR SURFACE OF LOWER ROAD. (NOTE 8)
SURFACE OF ROAD TO BOTTOM PORTAL 2' (MINIMUM OVERHEAD CLEARANCE
CLEAR DISTANCE OF OPENING ABOVE STREAM BED 3' (WATERWAYS ONLY)
POSTED LOAD LIMITS BRIDGE NO. 210 CONSTRUCTION DATE

GENERAL CONDITION OF BRIDGE: CHECK IF GOOD, FAIR, OR POOR, DESCRIBE DEFECTS IF SERIOUS.

	GOOD	FAIR	POOR
SUPERSTRUCTURE	✓		
FLOOR	✓		
SUBSTRUCTURE	✓		

PAINT BADLY CORRODED OR RUSTED

TYPE OF PROTECTION FOR DRAWBRIDGES (NOTE 9)

(NOTES ON REVERSE SIDE)

S26130

Notes:

1. In agreement with Federal-aid standards, a bridge is defined as a structure including supports erected over a depression or an obstruction, as water, highway, or railway, and having a track or passageway for carrying traffic or other moving loads, and having a length measured along the center of roadway of more than 20 feet between undercoping of abutments or spring lines of arches, or extreme ends of openings for multiple boxes and pipes, where the clear distance between openings is less than half of the smaller contiguous opening.

2. Show kind of crossing by checking descriptive item applicable. For multiple-span bridges give complete information on each span including approach spans. Indicate on leg sheet the odometer reading, position, and angle of skew of structure with respect to center line of road and by arrow the direction of stream flow.

3. Give information on the span over the highway only.

4. For span length use center to center of bearings, otherwise the clear opening. Skew bridges will be measured along center line of road. See Note 1.

5. Show general type such as: Trestle, Truss, Girder, I-Beam, Rigid Frame, Arch, Slab, Suspension, or Covered Bridge. See illustrations attached. Describe draw spans by classifications listed in Article X, Section 2 of Manual.

6. The length of a bridge structure is the over-all length measured along the line of survey stationing back to back of back-walls of abutments, if present, otherwise end to end of bridge floor, but in no case less than the total clear opening of the structure.

7. Give minimum lateral clearance. Where traffic lanes are separated by bridge numbers, show clearance width of each lane separately. Special conditions should be explained by notes.

8. In case of overhead bracing or arch construction, measurement shall be made to the lowest point above the road surface.

9. Use classification listed on RR crossing sheet. Form 4 HPS.

Remarks: _____

A rearrangement of the form similar to that shown on the attachment may be used to provide space for coding.

Form 6 HPS (Rev. 1961) 1234-121

ROAD INVENTORY SHEET

Party Chief F. SETTAR
Recorder T. LANDON
Chainman

T. LANDON
F. RHODES
VERIFIED
4/25/77

Road No. Co. 35
Name (CORNER HOUSE RD)
Sheet No. 1 OF 1
Date 11-5-65
County WORCESTER

(SAND		ROAD)	
CO.	2 24	36	
	1 91		DR.
(25°	1 75		
(~~30°~~ 50°	1 50		
	1 33		PT 30° PC
N	1 29		
	0 85		12" CMP
	0 03		PT 70° PC
	0 03		16' E 24' CW
(SCOTT		ROAD)	
CO.	0 00	33	

SHA 51.3-8
11-15-72

STATE HIGHWAY ADMINISTRATION OF MARYLAND

ROAD INVENTORY SHEET

Party Chief _____
Recorder K. HESS
Helper _____

Map No. _____ VER 4-25-77

Road No. Co 36
Road Name ~~SAND RD~~
Sheet No. 1 of 3
Date 11-10-65 (REVISED 10-7-77)
County WORCESTER
State Coordinates 1220 - 130

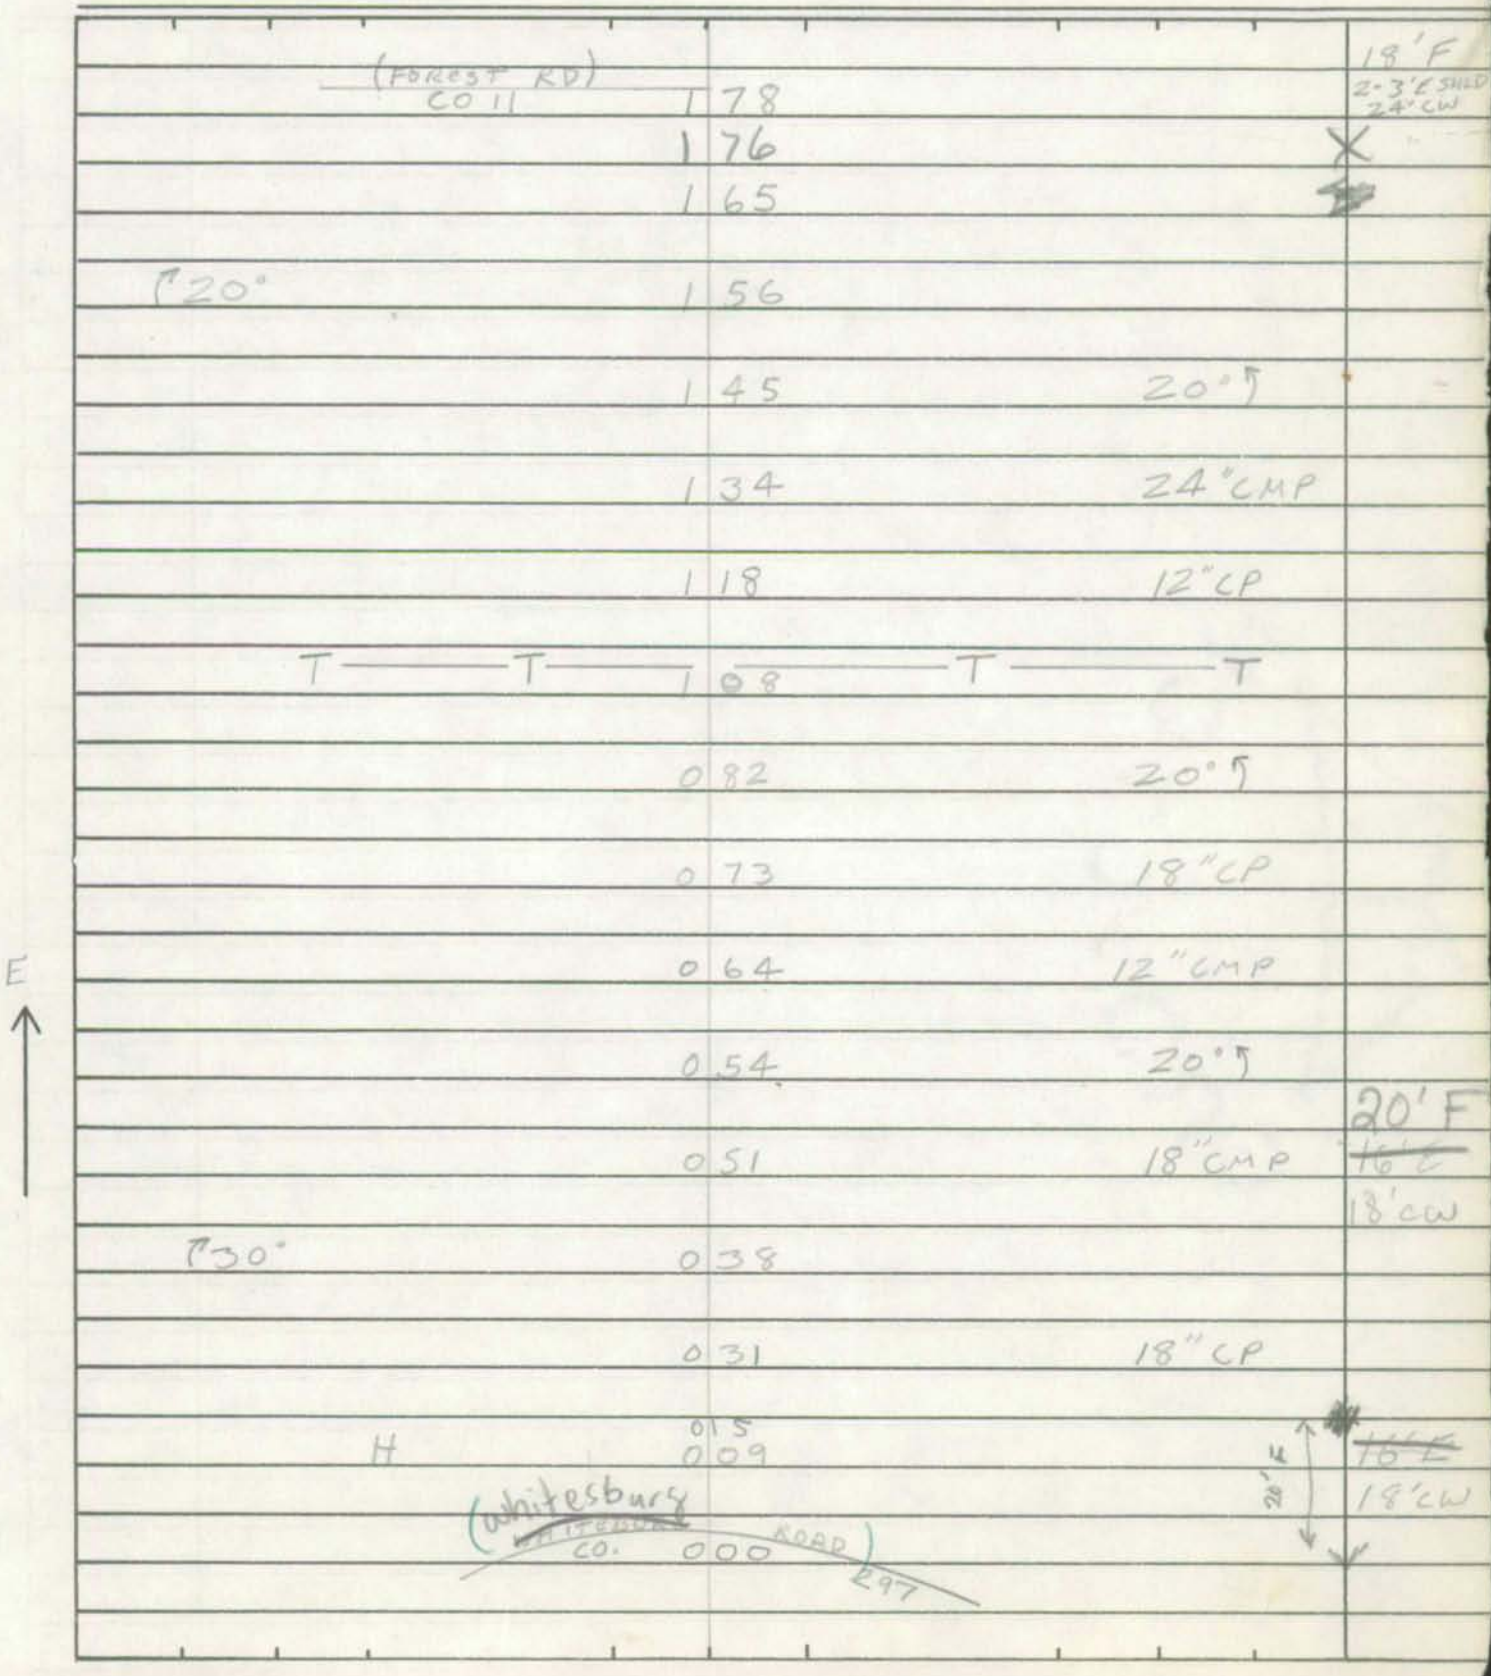

SHA 51.3-8
11-15-72

ROAD INVENTORY SHEET

Road No. Co 36
Road Name
Sheet No. 2 of 3
Date
County WORCESTER
State Coordinates

↑20°	4 08		
	4 02	20° ↰	
↑30°	3 85		
↑20°	3 46		16'F
			20'CW
	3 26		*
	3 21	PT ↑ 60° PC	
	3 13		
	2 78	15° ↰	
↑30°	2 60		
	2 56	DR	
	2 53	PT ↑ 30° PC	
	2 48		
	2 17	20° ↰	
↑20°	2 08		
↑ PT 35° PC	1 97		
	1 93		
	1 83 (CORNER HOUSE ROAD) CO 35	20° ↰	
			SAME

SHA 51.3-8
11-15-72

STATE HIGHWAY ADMINISTRATION OF MARYLAND

ROAD INVENTORY SHEET

Party Chief _____
Recorder K. HESS
Helper _____

Map No. _____

Road No. Co 36
Road Name (SAND RD)
Sheet No. 3 of 3
Date _____
County WORCESTER
State Coordinates _____

87-3

	(CROSSROADS RD) CO 34 / (CREEK RD) CO 302	
	5 05	
	4 97	30° ↰
↑ 30°	4 90	
	4 83	25° ↰
↑ PT	4 66	
30°		
PC	4 62	
(MILLVILLE RD) CO 13	4 38	

18'I

SAME

SHA 51.3-8
11-15-72

ROAD INVENTORY SHEET

Road No. _____
Road Name _____
Sheet No. _____
Date _____
County _____
State Coordinates _____

Form 6 HPS (Rev. 1961) 1224-114

ROAD INVENTORY SHEET

Party Chief F. SETTAN
Recorder T. LANDON
Chainman

T. LANDON
F. RHODES
VERIFIED
4/22/77

Road No. Co. 37
Name OAK HALL RD
Sheet No. 1 OF 2
Date 11-10-65
County WORCESTER

PT	1 65		20'E
~~30~~ 70°			30'CW
PC	1 63		X
	1 44		12"CP 20'↑
T — T	1 26 T — T		
PT	1 19		
~~35~~ 80°			
PC	1 14		
	0 98	PT	
		75° ~~70°~~	~~14'E~~
	0 92	PC	~~18'CW~~
			16'E
	0 76		X 20'CW
125° 48"CMP	0 74	~~WPC L18 X W15 XD 9'~~	
	0 61	H	
~~FILL DEAD~~	~~0 54~~		
	0 50	H	
11 800'	0 47		18'I (91-10)
	0 46	24"CMP	
E ↑	0 41		X
	0 35	12"CP	
	0 31	H	
			16'F
	0 22	12"CP	24'CW
WHITEBURG ROAD #297 Co.	0 0		↓

Form 6 HPS (Rev. 1961)

ROAD INVENTORY SHEET

Party Chief F. SEITAN
Recorder T. LANDON
Chainman

Road No. CO. 37
Name
Sheet No. 2 OF 2
Date 11-10-65
County WORCESTER

SHA 51.3-8
11-15-72

STATE HIGHWAY ADMINISTRATION OF MARYLAND

ROAD INVENTORY SHEET

Party Chief _____
Recorder K. HESS
Helper _____

Map No. _____ VER 4-22-77

Road No. Co 38
Road Name (FLEMMING MILL RD)
Sheet No. 1 of 1
Date 11-10-65 (REVISED 10-7-77)
County WORCESTER
State Coordinates 1217 - 123

E ↑

(WHITESBURG ROAD)
CO 078 297

F 600' 066

043 18" CP

031 18" CP 18'F
2-5'E SHLD
40' R/W

(FLEMMING MILL RD)
CO. 41

000

SHA 51.3-8
11-15-72

ROAD INVENTORY SHEET

Road No. _____
Road Name _____
Sheet No. _____
Date _____
County _____
State Coordinates _____

SHA 51.3 - 8 Revised
4.83

FCR 95

MARYLAND STATE HIGHWAY ADMINISTRATION

ROAD INVENTORY SHEET

Party Chief: GD
Recorder: AH
Assistant:
Map No./Dir.: L-17 / S
State Coordinates: 1203 - 108

Road No.: Co 39
Road Name: WHITESBURG RD
County: WORCHESTER
Date: 4/25/95
Sheet No.: 1 OF 1

TRAFFIC CODES
TRAFFIC CONTROLS: STOP SIGN=SS, TRAFFIC LIGHT=T.L., FLASHING RED BALL=F.R.

TRAFFIC CODES
PARKING RESTRICTIONS: A.M. PEAK, P.M. PEAK, A.M./P.M. PEAK, NO PARKING ANYTIME=N.P., COMM/IND. ACCESS=E

SYSTEM				TRAFFIC		LINE DIAGRAM	TRAFFIC			PAVEMENT DATA
FED. AID.	FUNCT. CLASS.	HWY. SYS.	HPMS SAMPLE	PRKG. REST.	COM/IND. ACCESS		CONTROL	COM/IND. ACCESS	PRKG. REST.	
	Rural Minor Collector					RD MC MASTER 376 CO CREEK RD) 364 (DIVIDING 025 MD	SS			18 I 2 ML
						(WHITESBURG RD) CO 000 297	SS			

SYSTEM				TRAFFIC		LINE DIAGRAM	TRAFFIC			PAVEMENT DATA
FED. AID.	FUNCT. CLASS.	HWY. SYS.	HPMS SAMPLE	PK.G. REST.	COM/IND ACCESS		CONTROL	COM/IND ACCESS	PK.G. REST.	

Form 6 HPS (Rev. 1961) 1223-105

ROAD INVENTORY SHEET

T. LANDON
F. RHODES
VERIFIED
4/22/77

Party Chief F. SETTIAN
Recorder T. LANDON
Chainman

Road No. Co. 40
Name (McMASTER RD)
Sheet No. 1 OF 1
Date 11-12-65
County WORCESTER
88-259

POCOMOKE		RIVER	
	ROAD	END	
	1	26	
HT	1	24	F
HT	1	05	
	1	00	12" CMP
	0	95	12" CP
NE	0	88	12" CP
45° ~~50°~~ (McMASTER RD)	0	85	88-259 20' F
60° Co. 346	0	28	~~16' E~~ 20' CW
MD. DIVIDING			
	0	00	CREEK RD 364

Form 6 HPS (Rev. 1961) 1221-104

ROAD INVENTORY SHEET

FLEMMING MILL RD

Party Chief F. SULLIVAN
Recorder T. LANDON
Chainman

T. LANDON
F. RHODES
VERIFIED
4/22/77

Road No. CO. A1
Name ~~FLEMING MILL RD~~
Sheet No. 1 OF 2
Date 11-10-65
County WORCESTER

	H	2 68	F	
		2 64	24" CMP	
↑20°		2 55		
		2 48	18" CMP	
	H	2 03		
		1 86	12" CP	
		1 80	H	
		1 70	F	
	F (VAC)	1 46		
		1 34	72" CMP	
↑30°	F	1 26		
		1 06	H	
		0 98	PT	
			30°	
		0 96	18" CMP	
N				
↑		0 94	PC	
↑15°		0 64	18" CP	
				18" F
↑20°		~~0 57~~ 0 49		28' CW
		0 40	15° ↑	
	M 600' DIVIDING MD.	0 00	CREEK AD 364	

Form 6 HPS (Rev. 1961)

ROAD INVENTORY SHEET

Party Chief F. SETTAN
Recorder T. LYNDON
Chairman

Road No. Co. 41
Name
Sheet No. 2 OF 2
Date 11-10-65
County WORCESTER

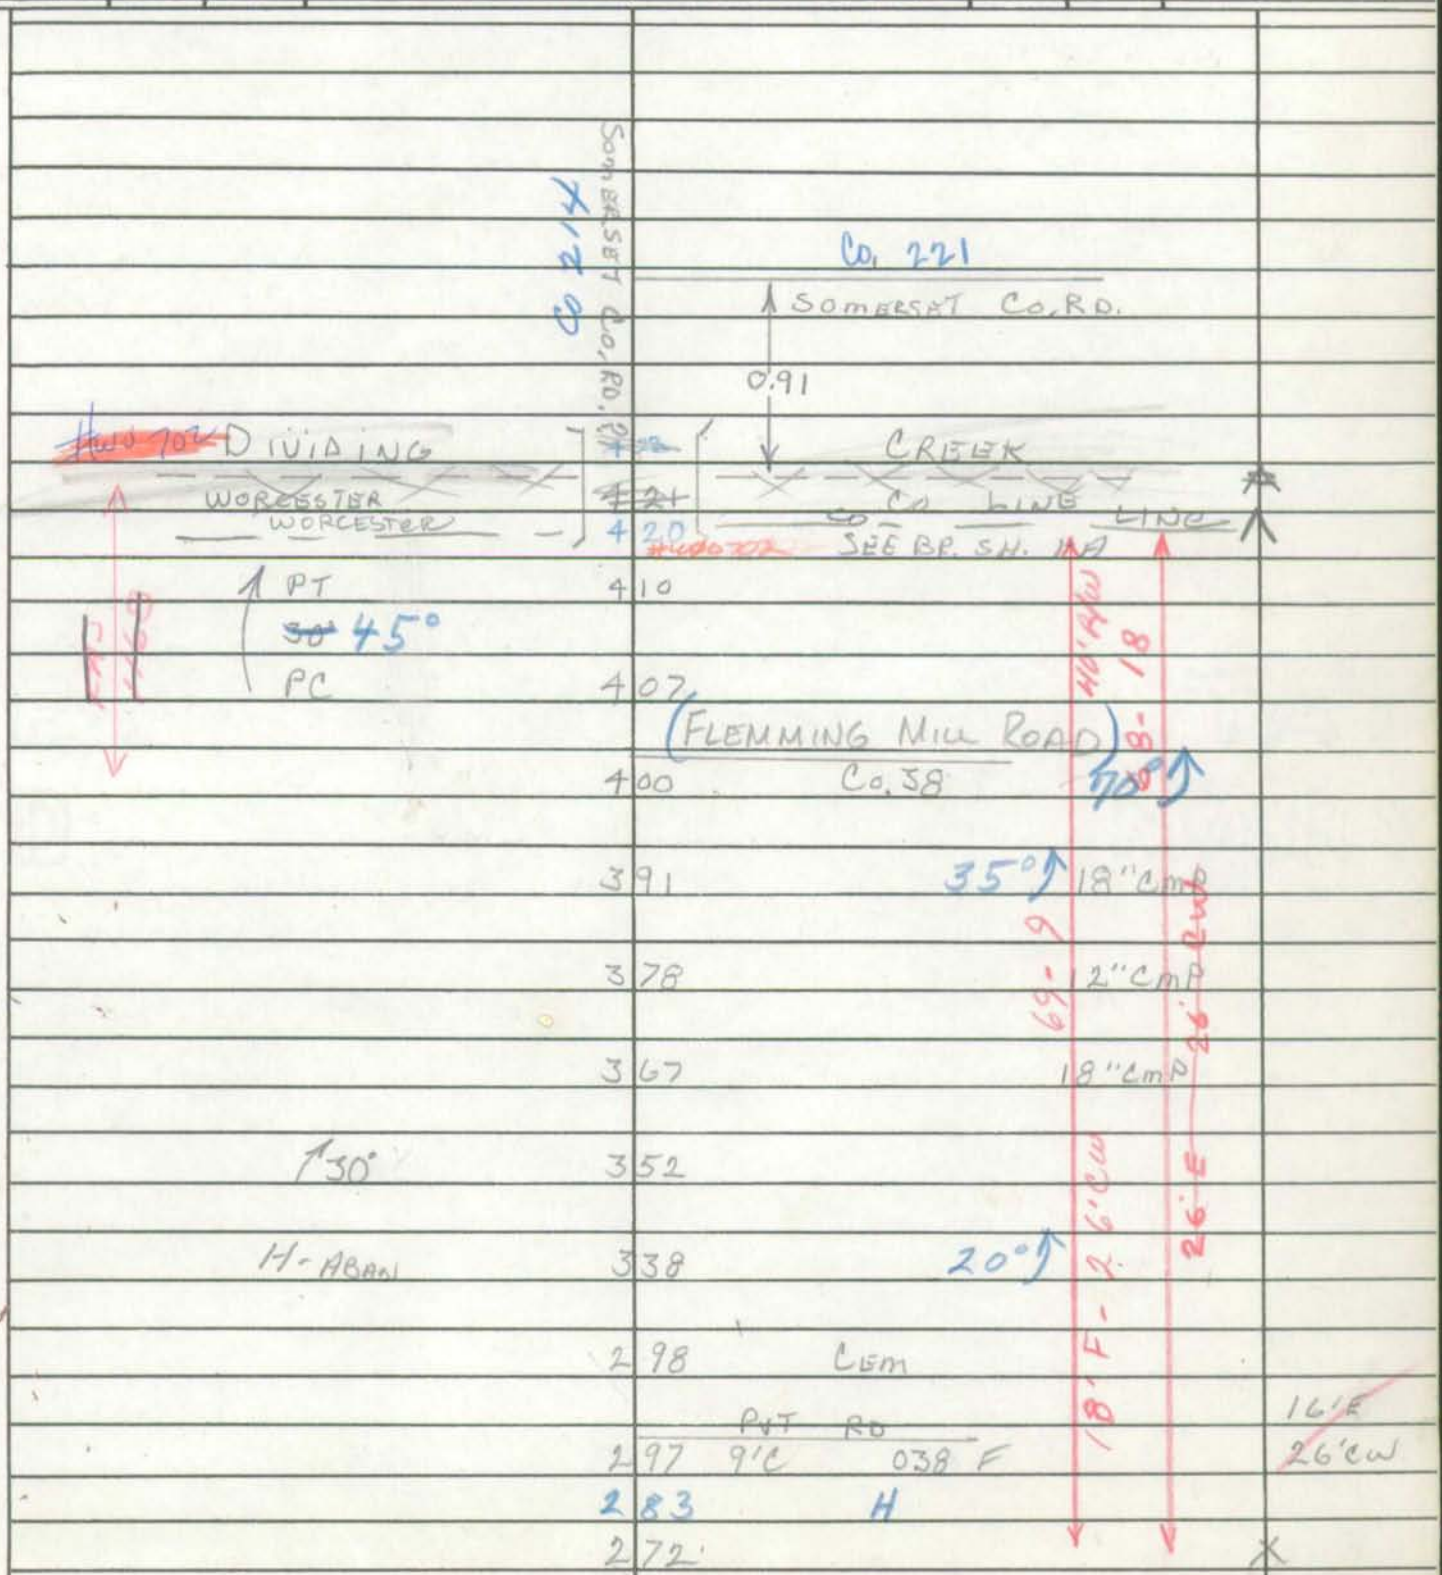

Form 5-HPS
(Revised 1961)

MARYLAND STATE ROADS COMMISSION
PLANNING AND PROGRAMMING DIVISION

526130

IN COOPERATION WITH
U.S. BUREAU OF PUBLIC ROADS

Field Creek
2-5-71

BRIDGE SHEET

ROAD NO. 41

SHEET NO. 1-A

PARTY NO.

DATE 12-7-70

COUNTY Worcester

RATED CAPACITY

FOR ALL STRUCTURES HAVING A TOTAL OPENING OF MORE THAN 20 FEET AS DEFINED IN NOTE 1.

ODOMETER READING 4.21 NAME OF (STREAM), RAILROAD OR HIGHWAY

CROSSED Dividing Creek

NUMBER OF RAILROAD TRACKS

KIND OF CROSSING (NOTE 2) Bridge Over Stream

UNDERPASS-SIMPLE UNDERPASS-COMBINED (NOTE 3) OVERPASS BRIDGE OVER SYSTEM

DESCRIPTION

NUMBER OF SPANS	LENGTH EACH SPAN (NOTE 4)	TYPE (NOTE 5)
6	14'-2"	Girder

TOTAL LENGTH-ON LINE OF ROAD OVER-ALL (NOTE 6) 85'-1"

MATERIAL

SUBSTRUCTURE Creosoted Timber SUPERSTRUCTURE Creosoted Timber

FLOOR WOOD

CLEARANCES

ROADWAY (NOTE 7) 17'Wood c-c SIDEWALK WIDTHS: RIGHT None LEFT None

SURFACE OF ROAD TO STREAM BED 18'-8" FOR OVERPASSES, SHOW DISTANCES TO TOP OF RAIL OR SURFACE OF LOWER ROAD. (NOTE 8)

SURFACE OF ROAD TO BOTTOM PORTAL (MINIMUM OVERHEAD CLEARANCE

CLEAR DISTANCE OF OPENING ABOVE STREAM BED 10 (WATERWAYS ONLY)

POSTED LOAD LIMITS BRIDGE NO. 102 CONSTRUCTION DATE 12-1-70

GENERAL CONDITION OF BRIDGE: CHECK IF GOOD, FAIR, OR POOR, DESCRIBE DEFECTS IF SERIOUS.

	GOOD	FAIR	POOR
	X		

SUPERSTRUCTURE Good

FLOOR Good

SUBSTRUCTURE Good

PAINT

TYPE OF PROTECTION FOR DRAWBRIDGES (NOTE 9)

SHA 51.3-8
11-15-72

STATE HIGHWAY ADMINISTRATION OF MARYLAND

ROAD INVENTORY SHEET

Party Chief _____
Recorder _____
Helper _____

Map No. _____

Road No. Co 42
Road Name _____
Sheet No. _____
Date _____
County WORCESTER
State Coordinates _____

UNASSIGNED

Now ABAN.

VER 4-22-77

SHA 51.3-8
11-15-72

ROAD INVENTORY SHEET

Road No. _____
Road Name _____
Sheet No. _____
Date _____
County _____
State Coordinates _____

SHA 51.3 - 8 Revised
4.83

MARYLAND STATE HIGHWAY ADMINISTRATION

79-1, 2
89-8
96-1 MU
GW/KS
1-14-96

Pocomoke City

ROAD INVENTORY SHEET

Party Chief C. Martin
Recorder Rewritten (JEL) 2-1-91
Assistant
Map No./Dir. GH 24/SW
State Coordinates 1209 - 88

Road No. Co 43
Road Name Unionville Rd.
County Worcester
Date 9-5-74
Sheet No. 1 OF 3

TRAFFIC CODES
TRAFFIC CONTROLS: STOP SIGN=SS, TRAFFIC LIGHT=T.L., FLASHING RED BALL=F.R.

TRAFFIC CODES
PARKING RESTRICTIONS: A.M. PEAK, P.M. PEAK, A.M./P.M. PEAK, NO PARKING ANYTIME=N.P., COMM/IND. ACCESS=E

SYSTEM				TRAFFIC		Pocomoke City LINE DIAGRAM	TRAFFIC			PAVEMENT DATA
FED. AID.	FUNCT CLASS.	HWY. SYS.	HPMS SAMPLE	PKG. REST.	COM/IND. ACCESS		CONTROL	COM/IND. ACCESS	PKG. REST.	
						(Riverview Park Dr.)				
						0 63 CO 44				
						0 38 24" CMP				
						T 30° 0 29				
						0 25 DR				
						0 05 END CEM.				
						0 01 Beg CEM				22' I
						CO 48				24' CW
						0 00 William St.				2 ML
						Clarke St MU 0.60 (Pocomoke City)				

Non Fed Rural Local

LINE DIAGRAM

SYSTEM				TRAFFIC		TRAFFIC				
FED. AID.	FUNCT. CLASS.	HWY. SYS.	HPMS SAMPLE	PRKG. REST.	COM/IND ACCESS	CONTROL	COM/IND ACCESS	PRKG. REST.	LINE DIAGRAM	PAVEMENT DATA
									SAND Pit Rd CO 47	
									1 29	
									Sand Pit Rd CO 46	
									↑40° 1 27	
										20' I
										24' CW
									Cypress Rd	
									CO 45 1 20	X
									1 19 Church-Ext Cem.	
									1 16 Beg. Cem	
									1 05 HT	
									Cropper Ct	
									1 04 CO 351	
									0 83 PVT Rd.	22' I
										24' CW
										2 ML

NON FIA
Rural Local

SHA 51.3 - 8 Revised
4.83

MARYLAND STATE HIGHWAY ADMINISTRATION

ROAD INVENTORY SHEET

Party Chief C. Martin
Recorder Revr. Hen (DEL) 2-4-91
Assistant
Map No./Dir. GH 24 SW
State Coordinates 1204 - 88

Road No. CO 43
Road Name Unionville Rd
County Worcester
Date 4-5-74
Sheet No. 3 OF 3

TRAFFIC CODES
TRAFFIC CONTROLS: STOP SIGN=SS, TRAFFIC LIGHT=T.L., FLASHING RED BALL=F.R.

TRAFFIC CODES
PARKING RESTRICTIONS: A.M. PEAK, P.M. PEAK, A.M./P.M. PEAK, NO PARKING ANYTIME=N.P., COMM/IND. ACCESS=E

SYSTEM				TRAFFIC		LINE DIAGRAM	TRAFFIC			PAVEMENT DATA
FED. AID.	FUNCT CLASS.	HWY. SYS.	HPMS SAMPLE	PRKG. REST.	COM/IND. ACCESS		CONTROL	COM/IND. ACCESS	PRKG. REST.	
						POCOMOKE RIVER				
						Road end				
AA						PVT Rd. 201			↑	
						PT				
						1 716				16' F
										20' CW
					E	30° quarry 1 75			X	
						PC 1 73			X	
						PT				
						1 316				
						30°				
						1 33 PC				20' I
										24' CW
NON FA Rural Local										

SYSTEM				TRAFFIC		LINE DIAGRAM	TRAFFIC				PAVEMENT DATA
FED. AID.	FUNCT. CLASS.	HWY. SYS.	HPMS SAMPLE	PRK.G. REST.	COM/IND ACCESS		CONTROL	COM/IND ACCESS	PRK.G. REST.		

Form 6 HPS (Rev. 1961) 1207-86

ROAD INVENTORY SHEET

Party Chief F. SETTHN
Recorder T. LANDON
Chainman

T. LANDON
F. RHODES
VERIFIED
4/27/77

Road No. CO 44
Name RIVERVIEW PARK DRIVE
Sheet No. 1 OF 1
Date 11-11-65
County WORCESTER

ROAD END

0 44

9 S.C.

0 34

PT 90°

0 31

N

0 30

PC

16'F
24'CW

0 10

20° 18"CP

120°

UNIONVILLE 0 04 ROAD

CO. 0 00 43

POCOMOKE RIVER

Form 6 HPS (Rev. 1961) 1203-86

ROAD INVENTORY SHEET

Cypress Rd (69-7)

Party Chief F. SETTON
Recorder T. LANDON
Chainman

T. LANDON
F. RHODES
VERIFIED
4/29/77

Road No. Co. 45
Name ~~(UNIONVILLE CENTER RD)~~
Sheet No. 1 OF 2
Date 11-11-65
County WORCESTER

H	1	25	
	1	21	F 800'
	1	16	18" CMP
15°	1	00	24" CMP
H	0	50	
H	0	48	HT
	0	44	
H	0	40	5 H
H	0	39	
	0	35	
H-ABAN	0	31	
F 700'	0	27	
	0	23	3 H
	0	20	
H	0	13	
H	0	08	20 I
H	0	05	~~HT~~
H	0	03	H ~~24'00~~
UNIONVILLE ~~RD~~		~~HOOPER ROAD~~ Unionville RD	~~2-34"SHLD~~
CO. ~~43~~	0	00 ~~CO 43~~ 43	2 ML

80-3
81-9 NT

Form 6 HPS (Rev. 1961)

ROAD INVENTORY SHEET

Party Chief F. SOTTAN
Recorder T. LANDON
Chairman

Road No. CO. 45
Name
Sheet No. 2 OF 2
Date 11-11-65
County WORCESTER

RD 371

CEDAR HALL MD

156

154

144

PT
30°
PC

138

H

128

F 800'

SAME

SHA 51.3-8
11-15-72

STATE HIGHWAY ADMINISTRATION OF MARYLAND

ROAD INVENTORY SHEET SAND PIT Rd (89-6)

Party Chief _____
Recorder K. HESS
Helper _____

Map No. _____ VER 4-27-77

Road No. Co 46
Road Name ~~PIT RD~~
Sheet No. 1 of 1
Date 11-11-65 (REVISED 10-7-77)
County WORCESTER
State Coordinates 1202.86

		ROAD 054 END	
H	051		
	041	18" CP	
H	030		
H	023		
H	019		
HT	016		
H	013		
H	010		
H	008		
H	001		16'F 20'CW
Unionville ~~TOWN~~ CO	000	ROAD ~~END~~ 43	

SHA 51.3-8
11-15-72

ROAD INVENTORY SHEET

Road No. _____
Road Name _____
Sheet No. _____
Date _____
County _____
State Coordinates _____

Form 6 HPS (Rev. 1961) 1202-86

ROAD INVENTORY SHEET

Party Chief F. SUTTON
Recorder T. LANDON
Chainman

T. LANDON
F. RHODES
VERIFIED
4/27/77

Road No. CO. 47
Name SAND PIT RD
Sheet No. 1 OF 1
Date 11-11-65
County WORCESTER

H (ABAN.)

ROAD END

0	36		
0	31		12" CP
0	18		12" CP
0	15	H	
0	12	H	
0	09		12" CP
0	07	H	
0	05	H	
0	03	H	14'0 / 20'CW
0	00		

67-12 20'CW
24-66 20'CW
16'E 16'E

Unionville ~~YOUNG~~ CO. 43 RD. ~~303~~ 43 CO

N

Form 6 HPS (Rev. 1961) 1209-87

96-1 GO) KS 1-14-97

ROAD INVENTORY SHEET

T. LANDON
F. RHODES
VERIFIED 4/27/77

Party Chief F. SETTIN
Recorder T. LANDON
Chainman

Road No. Co. 48
Name WILLIAMS STREET
Sheet No. 1 OF 1
Date 11-11-65
County WORCESTER

L-17

POCOMOKE CITY

Form 6 HPS (Rev. 1961) 1210-87

ROAD INVENTORY SHEET

MU 0390

Party Chief F. SETTAN
Recorder T. LANDON
Chainman

T. LANDON
F. RHODES
VERIFIED
4/27/77

Road No. Co. 49
Name Mt. MICHAEL AVE
Sheet No. 1 OF 1
Date 11-11-65
County WORCESTER

POCOMOKE CITY

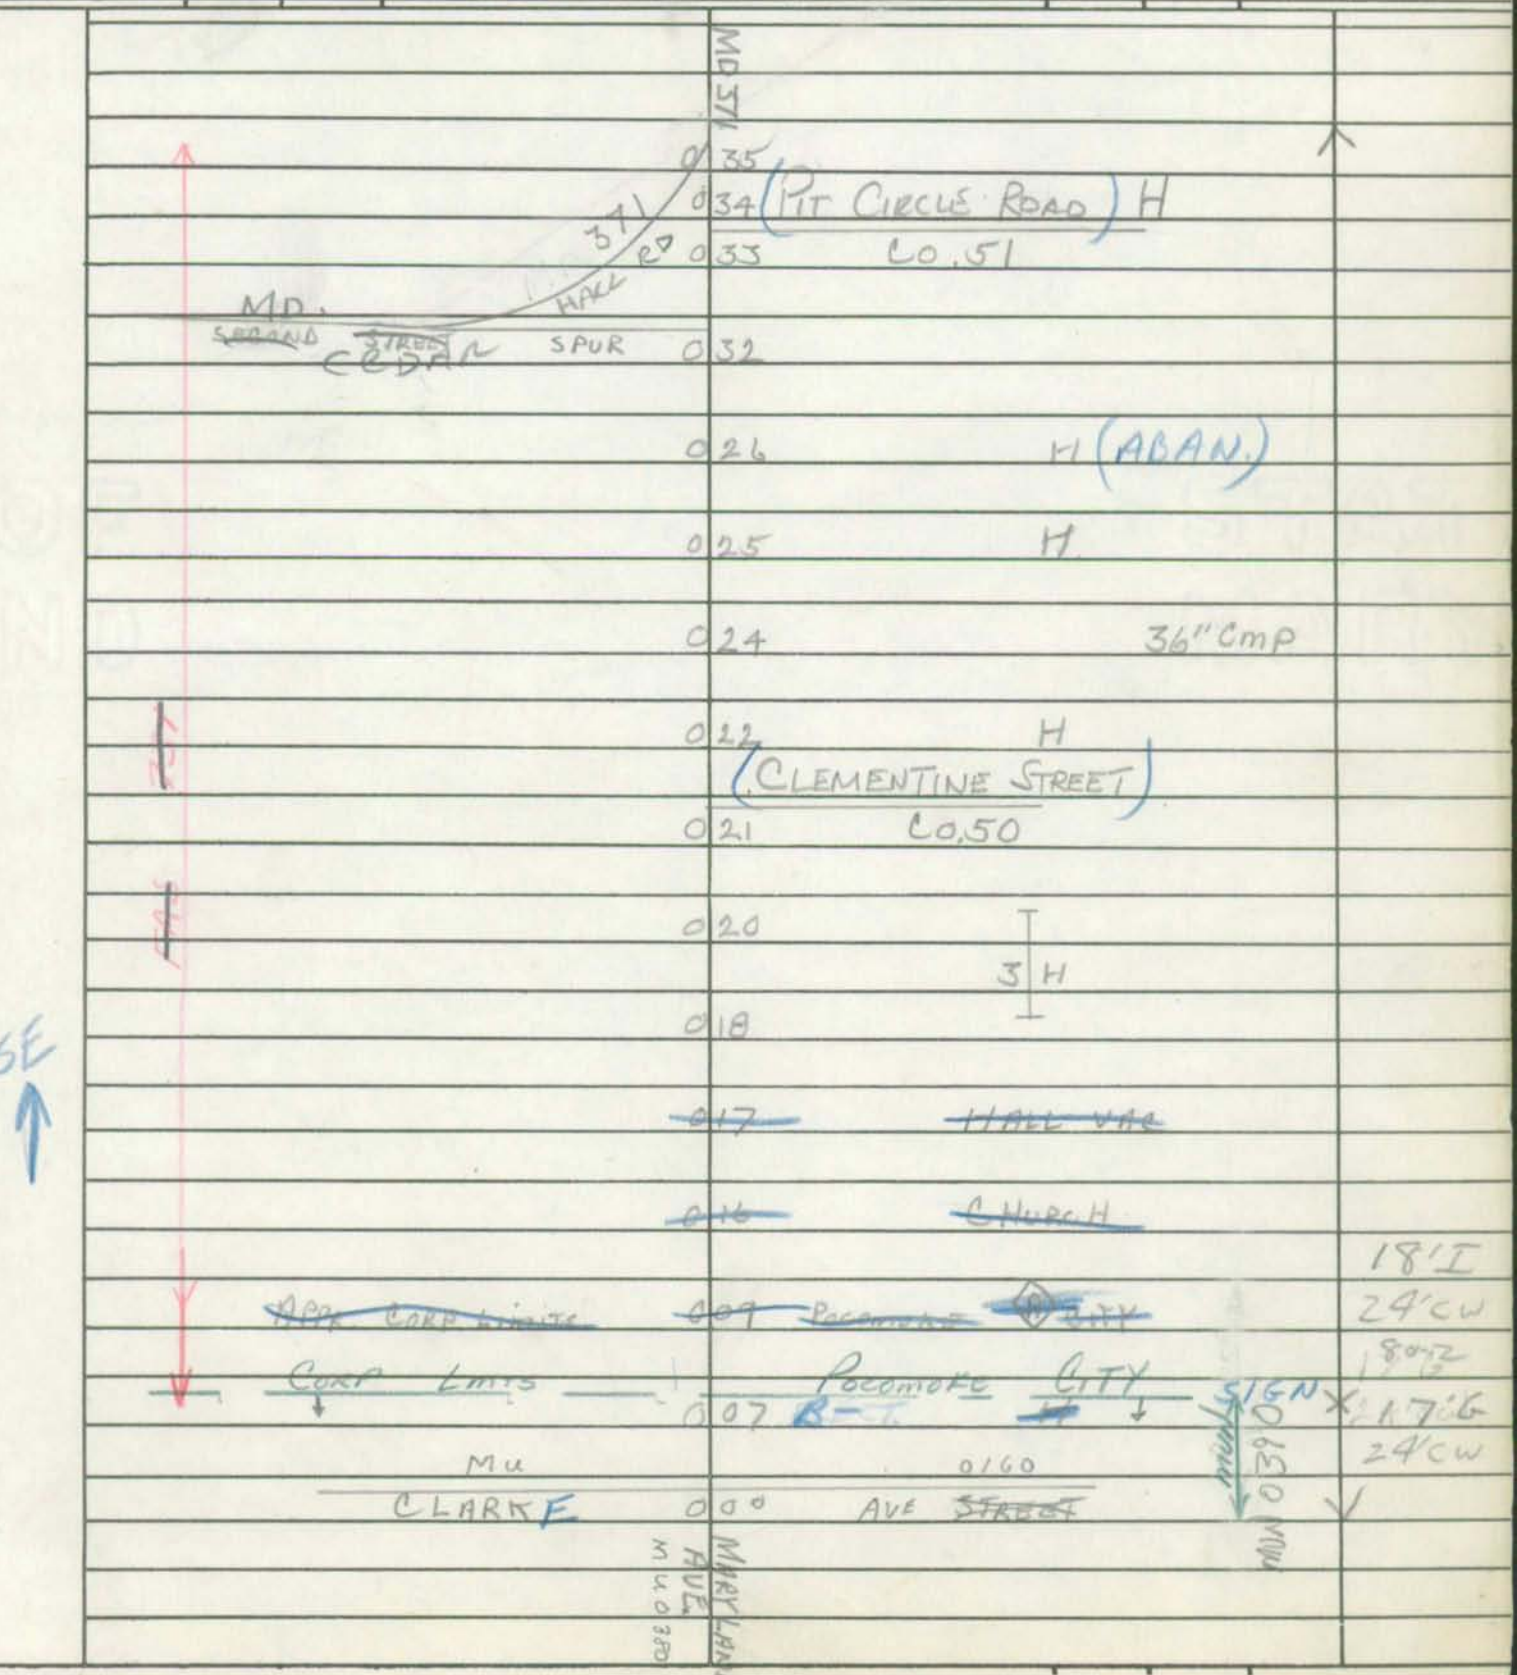

Form 6 HPS (Rev. 1961)

12/10-87

ROAD INVENTORY SHEET

Party Chief F. SETTANI
Recorder T. LANDON
Chainman

T. LANDON
F. RHODES
VERIFIED
4/27/77
Pocomoke Lit

Road No. Co. 50
Name (CLEMENTINE STREET)
Sheet No. 1 OF 1
Date 11-11-45
County WORCESTER

		ROAD	END	
SW ↑		0 10	H (ABAN.)	↑
		~~0 06~~	~~H ABAN~~	
	7 H	0 05		
		0 04	4 H	20'C
		0 02		22'CA
	Mc MICHAEL		AVENUE	
	Co.	0 00	49	↓

Form 6 HPS (Rev. 1961) 1211-97

ROAD INVENTORY SHEET

Party Chief F. SETTAN
Recorder T. LANDON
Chainman F. RHODES

VERIFIED 4/27/77
POCOMOKE CITY

Road No. Co. 51
Name (PIT CIRCLE RD)
Sheet No. 1 OF 2
Date 11-11-60
County WORCESTER

PT 90° PC		041		
	H	040		
		039		
PT 90° PC		038	18"CP	
	H (ABAN.)	035		
	H (ABAN.)	034		
	H (ABAN.)	032		
PT ~~30°~~ 45° PC	H	029		
	H	028		
		025	HT	
		023		
		020	H	
		017	H ABAN.	
		016	H	
		014	H (PIT CIRCLE ROAD)	
		013	Co. 51	16'B 24'Cul
	McMICHAEL AVENUE			
MD. 371	Co.	000	49	

SW

MD. 371

Form 6 HPS (Rev. 1961)

ROAD INVENTORY SHEET

Party Chief F. SETTAN
Recorder T. LANDON
Chainman

Road No. Co. 51
Name
Sheet No. 2 OF 2
Date 11-11-65
County WORCESTER

(PIT CIRCLE		ROAD)	
CO.	0 65	51	
PT	0 61		
90°			
PC	0 58		
H	0 57	H (ABAN.)	
H	0 52		
H	0 50		
H	0 48		
H	0 47	H	
H	0 46	H	
			SAME

Form 6 HPS (Rev. 1961)

93 MUEX#1
2-2-94
BB/TM

T. LANDON
F. RHODES
VERIFIED
4/28/77

ROAD INVENTORY SHEET

Mu 0080

Party Chief T. LANDON
Recorder W. WARFIELD
Helper

71-5 T. change
70-9 & 70-10

Road No. Co. 52
Road Name BROAD ST.
Sheet No. 1 OF 1
Date 2-5-71
County WORCESTER

1212-88

876

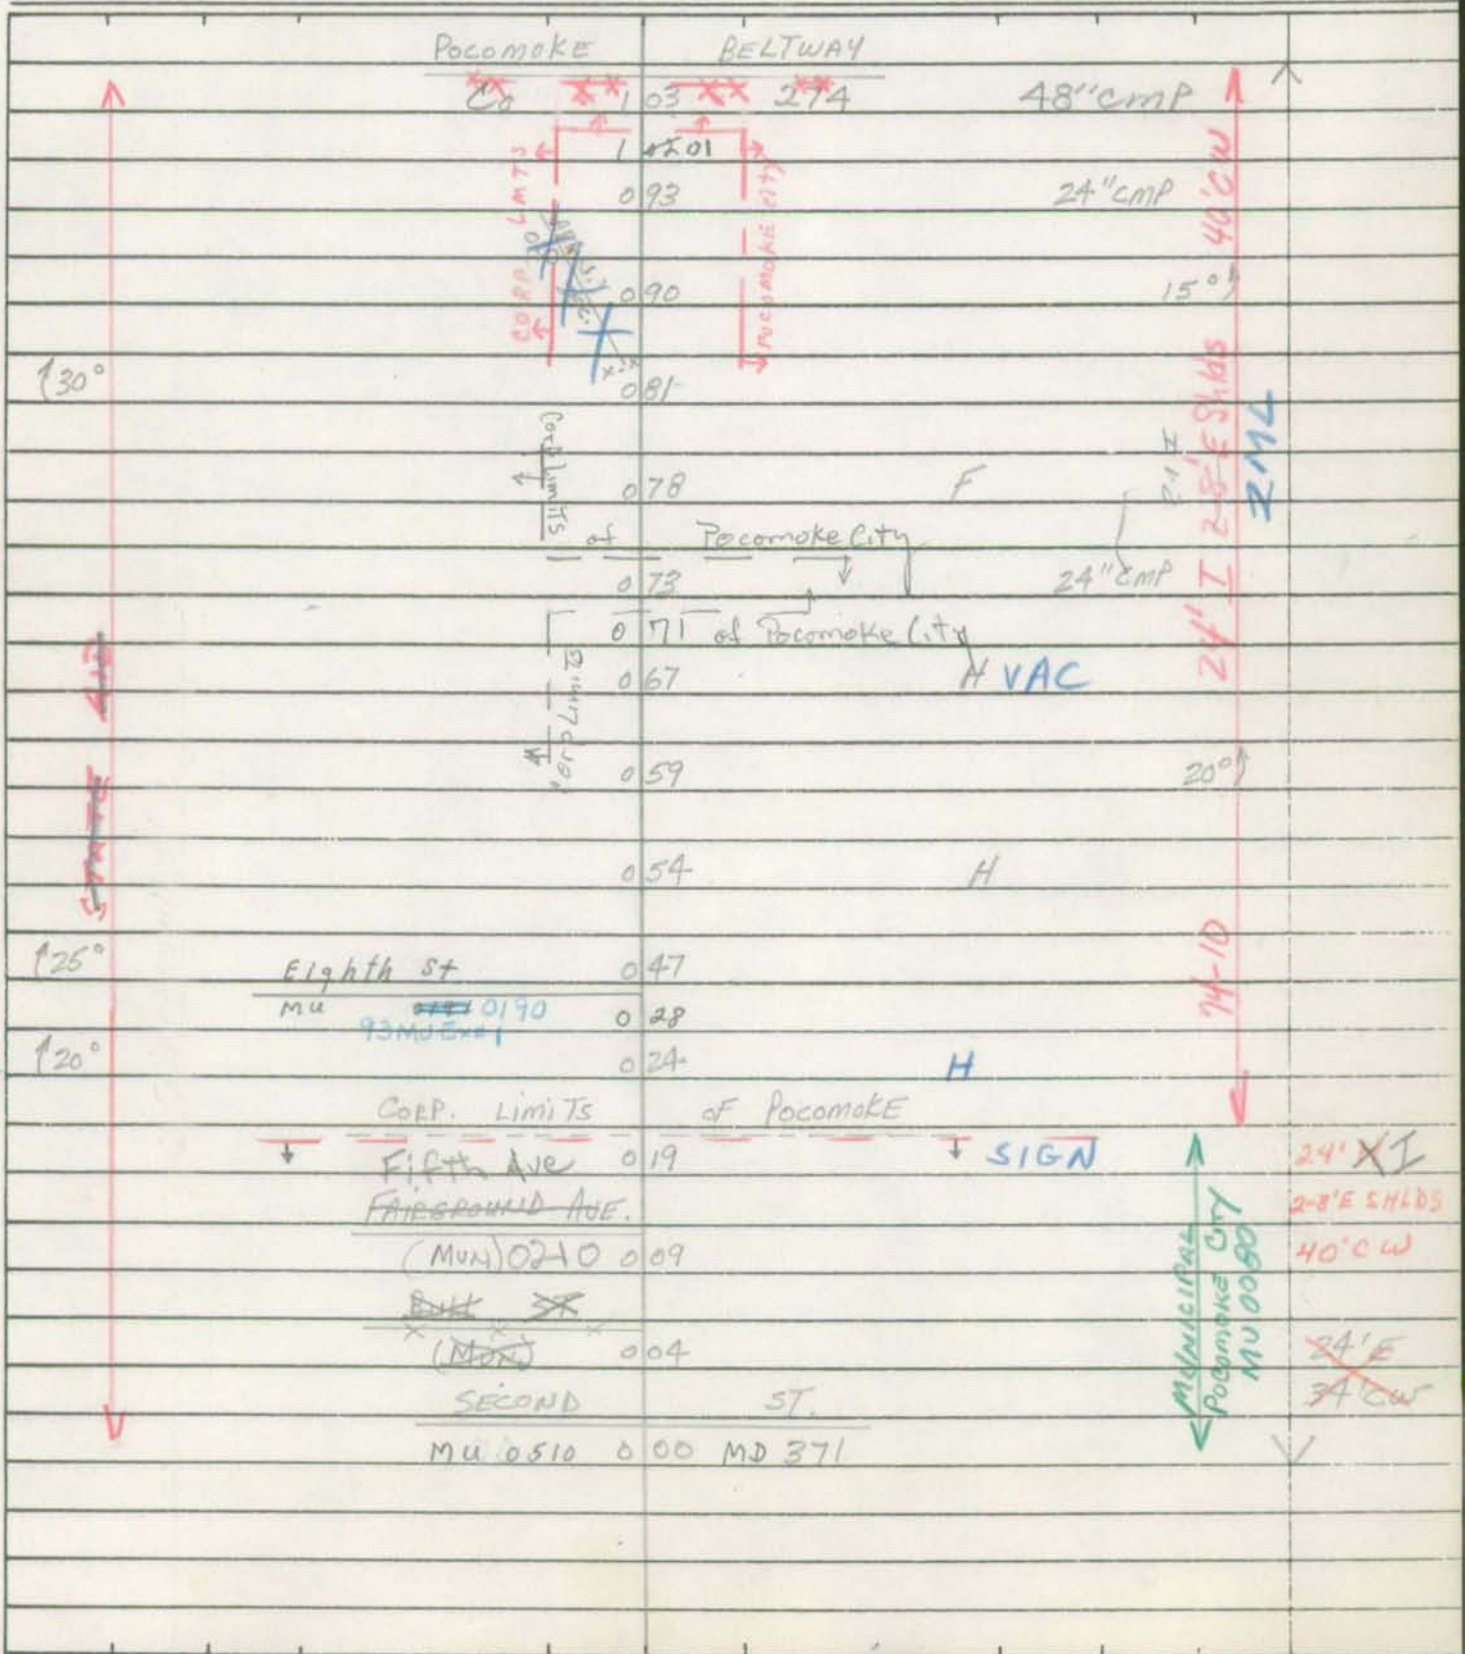

Form 6 HPS (Rev. 1961)

ROAD INVENTORY SHEET

Road No. _____
Road Name _____
Sheet No. _____
Date _____
County _____

FCR 95

SHA 51.3 - 8 Revised
4.83

MARYLAND STATE HIGHWAY ADMINISTRATION

ROAD INVENTORY SHEET

Party Chief G.D.
Recorder A.H.
Assistant
Map No./Dir. L-17 / SE
State Coordinates 1212 - 085

Road No. CO 53
Road Name DUNN SWAMP RD
County WORCHESTER
Date 4/26/95
Sheet No. 1 OF 2

TRAFFIC CODES
TRAFFIC CONTROLS: STOP SIGN=SS, TRAFFIC LIGHT=T.L., FLASHING RED BALL=F.R.

TRAFFIC CODES
PARKING RESTRICTIONS: A.M. PEAK, P.M. PEAK, A.M./P.M. PEAK, NO PARKING ANYTIME=N.P., COMM/IND. ACCESS=E

SYSTEM				TRAFFIC		LINE DIAGRAM	TRAFFIC			PAVEMENT DATA
FED. AID.	FUNCT CLASS.	HWY. SYS.	HPMS SAMPLE	PRK.G. REST.	COM/IND. ACCESS		CONTROL	COM/IND. ACCESS	PRK.G. REST.	
	K Rural Minor Collector * Rural Local					0 56 RADIO STATION		E		20'I 2ML
						(POCOMOKE BELTWAY) CO 0 45 274	SS		X	
						PT 0 41 45° PC 0 33				
						0 06 PT 30° (HALL RD) 371 0 00 PC (CEDAR RD)	SS		V	24'I 2ML

LINE DIAGRAM

SYSTEM: FED. AID.	SYSTEM: FUNCT. CLASS.	SYSTEM: HWY. SYS.	SYSTEM: HPMS SAMPLE	TRAFFIC: PRKG. REST.	TRAFFIC: COM/IND ACCESS	LINE DIAGRAM	TRAFFIC: CONTROL	TRAFFIC: COM/IND ACCESS	TRAFFIC: PRKG. REST.	PAVEMENT DATA
						(Colona Rd) 304 CO				
						(TULLS CORNER RD) CO 305				
	X					326 (NEW BRIDGE RD) CO 54			X	
	Local					139 L 8' x W 36' x D 3'				
				E	C	VFW POST 99				
	Rural				0	71 PT 35° PC				20' I 2ML
					0	66				

SHA 51.3-8
11-15-72

STATE HIGHWAY ADMINISTRATION OF MARYLAND

88-214

ROAD INVENTORY SHEET

Party Chief _____
Recorder _____
Helper C. MARTIN

Map No. GH 24

Road No. CO 54
Road Name NEW BRIDGE RD
Sheet No. 1 OF 2
Date 9-5-74
County WORCESTER
State Coordinates 1204 - 76

T. LANDON RHODES VERIFIED 4/27/77

↑20°	1 55	18" CMP	
↑20°	1 35		
~~123~~		~~H~~	
HILLMAN RD			16'F
CO 62	1 11		
#W60102			
	0 51	15°↑	X
PITTS	0 41	CREEK	
		SEE BR SH 1-A	
	0 33	PT	
		30°	
	0 29	PC	
↑20°	0 25	DR	
H.	0 22		
H (ABAN.)	0 21		
H	0 20		
H	0 18		
			88-214
H	0 05		19'I
			~~16'F~~
H	0 03		26'CW
CEDAR HALL	RD		
MD	0 00	371	

SE ↑

SHA 51.3-8
11-15-72

ROAD INVENTORY SHEET

Road No. CO 54
Road Name NEW BRIDGE RD
Sheet No. 2 OF 2
Date 9-5-74
County WORCESTER
State Coordinates

		(TULLS CORNER RD) CO 305		
(DUN SWAMP RD) CO 53	260	(COLONA RD) CO 304		
F	245			
	236	H	36" CMP	
F	231			
	227	F		
	207		18" CMP	
	205	H (ABAN.) 30°		
	202	H		
	199	H		
	194	F		
H	184			
	173			
	167	F		
H	159			SAME

Form HPS 5

STATE HIGHWAY ADMINISTRATION OF MARYLAND

IN COOPERATION WITH
FEDERAL HIGHWAY ADMINISTRATION

BRIDGE SHEET

ROAD NO. 354

SHEET NO. _____

PARTY NO. _____

DATE 12-1076

COUNTY Worcester

RATED CAPACITY _____

FOR ALL STRUCTURES HAVING A TOTAL OPENING OF MORE THAN 20 FEET AS DEFINED IN NOTE 1.

ODOMETER READING _____ NAME OF STREAM, RAILROAD OR HIGHWAY CROSSED Pitts Creek (New Bridge Road)

NUMBER OF RAILROAD TRACKS None

KIND OF CROSSING (NOTE 2) Bridge over stream.

UNDERPASS-SIMPLE UNDERPASS-COMBINED (NOTE 3) OVERPASS BRIDGE OVER SYSTEM

DESCRIPTION NUMBER OF SPANS	LENGTH EACH SPAN (NOTE 4)	TYPE (NOTE 5)
2	10'9"	Girder

TOTAL LENGTH-ON LINE OF ROAD OVER-ALL (NOTE 6) 21'6"

MATERIAL

SUBSTRUCTURE Creosoted Timber SUPERSTRUCTURE Creosoted Timber

FLOOR Wood

CLEARANCES

ROADWAY (NOTE 7) 20'1" SIDEWALK WIDTHS: RIGHT None LEFT None

SURFACE OF ROAD TO STREAM BED 5'9" FOR OVERPASSES, SHOW DISTANCES TO TOP OF RAIL OR SURFACE OF LOWER ROAD. (NOTE 8)

SURFACE OF ROAD TO BOTTOM PORTAL _____ (MINIMUM OVERHEAD CLEARANCE

CLEAR DISTANCE OF OPENING ABOVE STREAM BED 4' (WATERWAYS ONLY)

POSTED LOAD LIMITS _____ BRIDGE NO. WO 0102 CONSTRUCTION DATE _____

GENERAL CONDITION OF BRIDGE: CHECK IF GOOD, FAIR, OR POOR, DESCRIBE DEFECTS IF SERIOUS.

	GOOD	FAIR	POOR
SUPERSTRUCTURE	X		
FLOOR	X		
SUBSTRUCTURE	X		

PAINT BADLY CORRODED OR RUSTED

TYPE OF PROTECTION FOR DRAWBRIDGES _____

SHA 51.3 - 22
10-1-73

(NOTES ON REVERSE SIDE)

Form 6 HPS (Rev. 1961) 12/2-66

ROAD INVENTORY SHEET

Party Chief F. SETTON — T. LANDON
Recorder T. LANDON — F. RHODES
Chainman — VERIFIED 4/28/77

Road No. CO 55
Name (WABBAM MILL RD)
Sheet No. 1 OF 1
Date 11-15-65
County WORCESTER

COLONA
CO.
ROAD
SPUR
0.51
0.50
~~573~~ 304
0.01/16'G
0.43
12"CP
0.37
PT
30°
PC
16'F
24'CW
N
0.33
0.14
0.02
45°
MARYLAND
VIRGINIA
0.00
LINE
LINE
NO SIGN
25°
0.19
VA.
CO.
70.5

Form 6 HPS (Rev. 1961)

1203-67

ROAD INVENTORY SHEET

Party Chief F. SETTAN
Recorder T. LANDON
Chainman

T. LANDON
F. RHODES
VERIFIED
4/28/77

Road No. Co 56
Name (HALL RD)
Sheet No. 1 OF 1
Date 11-15-65
County WORCESTER

		F ↓ 0.10	
	ROAD END		
	1 10	18" CMP	↑
	~~T.L. CROWN~~ 0 69		
	0 64	18" CMP	
↑ PT 80° PC	0 55		
	0 53		
S ↑	0 42	PT 35°	
	0 39	PC	
	0 31	18" CMP	18" F 30° CW
↑ 20°	0 18		
	0 01	12" CMP	
(COLONA Co.	0 00	ROAD) 5/8 304	V

Form 6 HPS (Rev. 1961) 1201-71

ROAD INVENTORY SHEET

Party Chief F. SOTTAK
Recorder T. LANDON
Chairman

T. LANDON
F. RHODES
VERIFIED
4/27/77

Road No. Co 57
Name (CEDAR HALL WHARF RD)
Sheet No. 1 OF 1
Date 11-15-65
County WORCESTER

Unassigned
NOV 3 58
JAN

(CEDAR HALL WHARF RD)
Co. 57

1.00
0.05 MD. 371
CEDAR HALL RD
0.04 1.01 18" CMP
ROAD 304
0.00 1.05
COVA Co

SW

15' C
21' CW

89-107

SHA 51.3 - 8 Revised 4.83

MARYLAND STATE HIGHWAY ADMINISTRATION

ROAD INVENTORY SHEET

Party Chief F. SETHAN
Recorder T. LANDON
Assistant Rewritten (JEL) 4-4-91
Map No./Dir. GH 24/NE
State Coordinates 1201 - 71

Road No. CO 58
Road Name Cedar Hall Wharf Rd
County Worcester
Date 11-15-65
Sheet No. 1 OF 2

TRAFFIC CODES
TRAFFIC CONTROLS: STOP SIGN=S.S., TRAFFIC LIGHT=T.L., FLASHING RED BALL=F.R.

TRAFFIC CODES
PARKING RESTRICTIONS: A.M. PEAK, P.M. PEAK, A.M./P.M. PEAK, NO PARKING ANYTIME=N.P., COMM/IND. ACCESS=E

SYSTEM				TRAFFIC		LINE DIAGRAM	TRAFFIC			PAVEMENT DATA
FED. AID.	FUNCT. CLASS.	HWY. SYS.	HPMS SAMPLE	PRKG. REST.	COM/IND. ACCESS		CONTROL	COM/IND. ACCESS	PRKG. REST.	
						PT				
						0 39				
						35°				
						0 30 PC				
						↑30° 0 27 DR.				
						↑20° 0 16 18" CP				
						PT				
						0 12				
						35°				
						0 08 PC				
										18' I
						PVT RD 0 02				30 CW
						0 00				V
						Road End BOAT RAMP				
						POCOMOKE RIVER				
NON FIA										
Rural Local										
K K										

SYSTEM				TRAFFIC		LINE DIAGRAM	TRAFFIC			PAVEMENT DATA
FED. AID.	FUNCT. CLASS.	HWY. SYS.	HPMS SAMPLE	PRKG. REST.	COM/IND ACCESS		CONTROL	COM/IND ACCESS	PRKG. REST.	
↑	↑					(Colona Rd)			↑	
						CO 1 05 304				
						Cedarhall Rd WD 371				
						18" CMP 1 01				15' G
										21' CW
						↑30° 1 00			X	
						0 96 18" CMP				
						↑25° 0 93				
						0 81 DR. 20°↑				
						0 65 20°↑				
										18' I
										30' CW
						↑20° 0 52				

NON F/A
Rural Local

Form 6 HPS (Rev. 1961)

1200-72

ROAD INVENTORY SHEET

Party Chief F. SUTTON
Recorder T. LANDON
Chainman

T. LANDON
F. RHODES
VERIFIED
4/27/77

Road No. CO 59
Name (HICKORY POINT RD)
Sheet No. 1 OF 2
Date 11-11-65
County WORCESTER

F-H-ABAN	102	PT 30° PC	
	096		18"CMP
	083	PT 50° PC	
	081		
PT 75° PC	080		
	079		
	077		
	069	PT 30° PC	
	066		
	060		18"CMP
H-ABAN	050		
	036	F	15°
	024		18"CMP
	015		12"CP
	010		12"CP
CEDAR HALL RD MD.	000	371	

NW

16'F
24'CW

Form 6 HPS (Rev. 1961)

ROAD INVENTORY SHEET

Party Chief F. SETTAN
Recorder T. LANDON
Chainman

Road No. CO 59
Name
Sheet No. 2 OF 2
Date 11-11-65
County WORCESTER

	ROAD	END	
F 800'	1	99	
	1	93	WPC L-17' X W-16' X D-1'
↑15° ↑25°	1	99	
	1	92	
F 600'	1	61	
↑25°	1	51	2-36" CMP
	1	47	20° ↑
↑15° F 400'	1	32	
			SAME

Form 6 HPS (Rev. 1961)

1201-73

ROAD INVENTORY SHEET

Via Rd (89-9)

Party Chief F. SETJAN
Recorder T. LANDON
Chainman

T. LANDON
F. RHODES
VERIFIED
4/27/77

Road No. CO 60
Name ~~BISHOP RD~~
Sheet No. 1 OF 1
Date 11-11-65
County WORCESTER

MD.	~~XXX~~	371	
PT F	~~XXX~~ 9		
45°			
	047		
(BISHOP ROAD)			
PC HT CO ~~XXX~~	045		
PT	031	~~SCHOOL ROAD~~	
30°			
PC	029		
	026	H	
F.H. ~~XXX~~ 700'	020		
~~HARDY~~	~~012~~		
H	010	HALL (L)	
	007	371 H	16'G
			20'CW
	000		
CORAL MD			

N

SHA 51.3 - 8 Revised
4.83

MARYLAND STATE HIGHWAY ADMINISTRATION

ROAD INVENTORY SHEET

Party Chief F. Settan
Recorder T. Landon
Assistant
Map No./Dir. GH 241 W
State Coordinates 1202-75

Road No. Co 61
Road Name Bishop Rd
County Worcester
Date 11/11/85
Sheet No. 1 OF 1

TRAFFIC CODES
TRAFFIC CONTROLS: STOP SIGN=SS, TRAFFIC LIGHT=T.L., FLASHING RED BALL=F.R.

TRAFFIC CODES
PARKING RESTRICTIONS: A.M. PEAK, P.M. PEAK, A.M./P.M. PEAK, NO PARKING ANYTIME=N.P., COMM/IND. ACCESS=E

SYSTEM				TRAFFIC		LINE DIAGRAM	TRAFFIC			PAVEMENT DATA
FED. AID.	FUNCT CLASS.	HWY. SYS.	HPMS SAMPLE	PRK.G. REST.	COM/IND. ACCESS		CONTROL	COM/IND. ACCESS	PRK.G. REST.	
						Private Rd				
						Road End 078				
1	1									1
						038 12" cmp				
	Non F/A Rural Local					Via RD Co 60 (90°) 019				
										16' G 20' CW
						Cedar Hall RD MD 000 371				
V	V									V

66
47
1

SYSTEM				TRAFFIC		LINE DIAGRAM	TRAFFIC			PAVEMENT DATA
FED. AID.	FUNCT. CLASS.	HWY. SYS.	HPMS SAMPLE	PRK'G. REST.	COM/IND ACCESS		CONTROL	COM/IND ACCESS	PRK'G. REST.	

Form 6 HPS (Rev. 1961) 1208-80 87-5 ALIKS

ROAD INVENTORY SHEET

Party Chief F. SETTAN
Recorder T. LANDON
Chainman

T. LANDON
F. RHODES
VERIFIED 4/27/77

Road No. C062
Name HILLMAN RD
Sheet No. 1 OF 1
Date 11-11-65
County WORCESTER

NEW BRIDGE		ROAD	
CO.	1 39	54	↑ 15'F/
	1 26	12" CP	30'CW
	0 93		X 13'±
3-36"CMP	0 67	~~CBC L-7'XW-2'XD-3'~~	17'CW
↑40°	0 64		
F	0 47		
	0 45		* ~~12'±~~
	0 42	2-24"CMP	~~17'CW~~
	0 41	PT	
SE ↑		35° ↑	
	0 38	PC	
↑PT	0 25		
80°			12'FG
PC	0 22		24'CW
CEDAR HALL MD.	0 00	RD 371	✓

Form 6 HPS (Rev. 1961) 1219-65 87-1 ALIKS

ROAD INVENTORY SHEET

Party Chief F. SETTAN
Recorder T. LANDON
Chainman

T. LANDON
F. RHODES
VERIFIED
4/28/77

Road No. CO 63
Name (SPARROW RD)
Sheet No. 1 OF 1
Date 11-15-65
County WORCESTER

		VA. Co 707	
		VIRGINIA Co 705	
		0.95	
VIRGINIA / MARYLAND	0.45	LINE / LINE NO SIGN	
	0.35	18" CMP	
F	0.32	F	
(R/R SIGN)	0.21		
W		~~V-AND~~ ESHR	
R/R SIGN PA.		~~11~~ 330 513L / RR.	
	0.17	R/R SIGN	18'
			16'FI
	0.12	(R/R) SIGN	24'CW
SD. OCEAN	HWY	LD.	2 ML
US	0.00	13	
N. B.		LD.	
		VIRGINIA RD 780	

Form 6 HPS (Rev. 1961)

1220-68 A4/KS 57-2

ROAD INVENTORY SHEET

Party Chief F. SETTAN
Recorder T. LANDON
Chainman

T. LANDON
F. RHOLES
VERIFIED
4/28/77

Road No. Co 64
Name BUNTING RD
Sheet No. 1 OF 1
Date 11-16-65
County WORCESTER

PAYNE ~~ROAD~~ (~~CREEK~~ ROAD) SS
Co. ~~65~~ 070 CO ~~65~~ ~~67~~ 65 ↑
H 069
054 1F-11 ~~ABAN~~ (AC) 20'
041 12" CP
↑15° 040 F 600'
035 PT ↑ 30°
025 PC ↓
022 H
#W00104
~~WARRAM~~ BEAVERDAM 017 72-11 CREEK 15' G 21'W
SEE BR. SH. 1-A
NB OCEAN Hwy 40
US 006 13 *
S.B. L.B.
003 3 H 20' E
001 ~~16~~ 22' CW
Co 264 26'
~~44~~ MAKEMIE 000 AD ~~856-B~~ 12 MC
E ↑

Form 5-HPS (Revised 1961)

MARYLAND STATE ROADS COMMISSION
PLANNING AND PROGRAMMING DIVISION

S26130

IN COOPERATION WITH
U. S. BUREAU OF PUBLIC ROADS

BRIDGE SHEET

ROAD NO. Co 64

SHEET NO. 1-A

PARTY NO.

DATE 11-16-65

COUNTY DORCHESTER

RATED CAPACITY

FOR ALL STRUCTURES HAVING A TOTAL OPENING OF MORE THAN 20 FEET AS DEFINED IN NOTE 1.

ODOMETER READING 0.17 NAME OF STREAM, RAILROAD OR HIGHWAY CROSSED WAGRAM CREEK

NUMBER OF RAILROAD TRACKS

KIND OF CROSSING (NOTE 2)

UNDERPASS-SIMPLE UNDERPASS-COMBINED OVERPASS BRIDGE OVER SYSTEM (NOTE 3)

DESCRIPTION

NUMBER OF SPANS	LENGTH EACH SPAN (NOTE 4)	TYPE (NOTE 5)
3	14'	WOOD PILE

TOTAL LENGTH-ON LINE OF ROAD OVER-ALL (NOTE 6) 42'

MATERIAL

SUBSTRUCTURE WOOD SUPERSTRUCTURE WOOD

FLOOR WOOD

CLEARANCES

ROADWAY (NOTE 7) 15' SIDEWALK WIDTHS: RIGHT LEFT

SURFACE OF ROAD TO STREAM BED 5' FOR OVERPASSES, SHOW DISTANCES TO TOP OF RAIL OR SURFACE OF LOWER ROAD. (NOTE 8)

SURFACE OF ROAD TO BOTTOM PORTAL 2' (MINIMUM OVERHEAD CLEARANCE

CLEAR DISTANCE OF OPENING ABOVE STREAM BED 3' (WATERWAYS ONLY)

POSTED LOAD LIMITS BRIDGE NO. 104 CONSTRUCTION DATE

GENERAL CONDITION OF BRIDGE: CHECK IF GOOD, FAIR, OR POOR, DESCRIBE DEFECTS IF SERIOUS.

	GOOD	FAIR	POOR
SUPERSTRUCTURE	✓		
FLOOR	✓		
SUBSTRUCTURE	✓		

PAINT BADLY CORRODED OR RUSTED

TYPE OF PROTECTION FOR DRAWBRIDGES (NOTE 9)

(NOTES ON REVERSE SIDE)

S26130

Notes:

1. In agreement with Federal-aid standards, a bridge is defined as a structure including supports erected over a depression or an obstruction, as water, highway, or railway, and having a track or passageway for carrying traffic or other moving loads, and having a length measured along the center of roadway of more than 20 feet between undercoping of abutments or spring lines of arches, or extreme ends of openings for multiple boxes and pipes, where the clear distance between openings is less than half of the smaller contiguous opening.

2. Show kind of crossing by checking descriptive item applicable. For multiple-span bridges give complete information on each span including approach spans. Indicate on leg sheet the odometer reading, position, and angle of skew of structure with respect to center line of road and by arrow the direction of stream flow.

3. Give information on the span over the highway only.

4. For span length use center to center of bearings, otherwise the clear opening. Skew bridges will be measured along center line of road. See Note 1.

5. Show general type such as: Trestle, Truss, Girder, I-Beam, Rigid Frame, Arch, Slab, Suspension, or Covered Bridge. See illustrations attached. Describe draw spans by classifications listed in Article X, Section 2 of Manual.

6. The length of a bridge structure is the over-all length measured along the line of survey stationing back to back of back-walls of abutments, if present, otherwise end to end of bridge floor, but in no case less than the total clear opening of the structure.

7. Give minimum lateral clearance. Where traffic lanes are separated by bridge numbers, show clearance width of each lane separately. Special conditions should be explained by notes.

8. In case of overhead bracing or arch construction, measurement shall be made to the lowest point above the road surface.

9. Use classification listed on RR crossing sheet. Form 4 HPS.

Remarks: _____

_____

A rearrangement of the form similar to that shown on the attachment may be used to provide space for coding.

* 1.42-4.03 was part of Co 67, Critcher Rd - 89-3
4.03-4.35 was Co 306, Outten Rd - 89-4

SHA 51.3 - 8 Revised
4.83

MARYLAND STATE HIGHWAY ADMINISTRATION

ROAD INVENTORY SHEET

Party Chief C. Martin
Recorder
Assistant Rewritten 3-13-90
Map No./Dir. GH 24 / S
State Coordinates 1224-75

Road No. Co. 65
Road Name Payne RD
County Worcester
Date 9-6-74
Sheet No. 1 OF 4

TRAFFIC CODES
TRAFFIC CONTROLS: STOP SIGN=SS, TRAFFIC LIGHT=T.L., FLASHING RED BALL=F.R.

TRAFFIC CODES
PARKING RESTRICTIONS: A.M. PEAK, P.M. PEAK, A.M./P.M. PEAK, NO PARKING ANYTIME=N.P., COMM/IND. ACCESS=E

SYSTEM				TRAFFIC		LINE DIAGRAM	TRAFFIC			PAVEMENT DATA
FED. AID.	FUNCT CLASS.	HWY. SYS.	HPMS SAMPLE	PRKG. REST.	COM/IND. ACCESS		CONTROL	COM/IND. ACCESS	PRKG. REST.	
						1 31 2-48" CMP				
						1 21 25°R				
						(Johnson RD)				
						45° Co 666 1 05				
						20° 0 66				
NON F/A Rural Local						0 44 18" CMP				
						0 06 2-48" CMP				16' G
										30' CW
						Brantley RD				
✓	✓					CO 0 00 307			✓	

Co 65 2014

SYSTEM				TRAFFIC		LINE DIAGRAM	TRAFFIC			PAVEMENT DATA
FED. AID.	FUNCT. CLASS.	HWY. SYS.	HPMS SAMPLE	PRKG. REST.	COM/IND ACCESS		CONTROL	COM/IND ACCESS	PRKG. REST.	
						2 85 · 18" CP				
						↑90° 2 660				
						2 57 15°↑				
						2 34 PT				
						75°				
						2 33 PC				
						Barnes RD				
						2 25 Co 69				
						T—T—T—1 91 —T—T				
						1 80 24" CP 35°↑				
						Bunting RD				
						1 42 Co 64				
						1 38 PT				
						Migrant labor camps 1 37 45°				
						1 34 PC				16' ⊄

Non FA Rural Local

SHA 51.3 - 8 Revised
4.83

MARYLAND STATE HIGHWAY ADMINISTRATION

ROAD INVENTORY SHEET

Party Chief _____
Recorder _____
Assistant _____
Map No./Dir. 1 3
State Coordinates _____

Road No. Co 65
Road Name Payne Rd
County Worcester
Date 9/6/74
Sheet No. 3 OF 4

SYSTEM				TRAFFIC		LINE DIAGRAM			TRAFFIC			PAVEMENT DATA
FED. AID.	FUNCT CLASS.	HWY. SYS.	HPMS SAMPLE	PRKG. REST.	COM/IND. ACCESS				CONTROL	COM/IND. ACCESS	PRKG. REST.	
						↑15°	3	65				
					E	Cemetery	3	59				
					E	Cemetery	3	55				
						↑20°	3	52				
							3	43				
								20°↑				
							3	34				
								PC				
							3	29				
								12" CMP 30°				
							3	20				
								PT				
							3	04				
								12" CMP				
							2	90				16' G
								20°↑				

TRAFFIC CODES

TRAFFIC CONTROLS: STOP SIGN=SS, TRAFFIC LIGHT=T.L., FLASHING RED BALL=F.R.

TRAFFIC CODES

PARKING RESTRICTIONS: A.M. PEAK, P.M. PEAK, A.M./P.M. PEAK, NO PARKING ANYTIME=N.P., COMM/IND. ACCESS=E

NON F/A Rural Local

Co 65 4 of 4

LINE DIAGRAM

SYSTEM: FED. AID. | FUNCT. CLASS. | HWY. SYS. | HPMS SAMPLE
TRAFFIC: PRKG. REST. | COM/IND ACCESS
TRAFFIC: CONTROL | COM/IND ACCESS | PRKG. REST.
PAVEMENT DATA

NON F/A
Rural Local

VA. ↑ 725
20
13
VA Co 71 .19 mi
↓ ST/L
Virginia
Maryland 4 35 ST/L 45°
4 32
PT
30°
PC
4 29
13' F
18' CW
4 05 2-18" CMP
4 04
SPUR
Critcher Rd
85° Co 67 4 03
3 88 12" CP
3 83 18" CMP
20° 3 79
3 72 18" CMP
16' G

Form 6 HPS (Rev. 1961) 1224-70

ROAD INVENTORY SHEET

Party Chief F. SETTAN
Recorder T. LANDON
Chainman

T. LANDON
F. RHODES
VERIFIED
4/28/77

Road No. Co 66
Name (JOHNSON RD)
Sheet No. 1 OF 1
Date 11-16-65
County WORCESTER

(CRITCHER Co.	191	ROAD) 67
H	181	
~~F~~ HT	179	
	166	25° ↑
	140	12" CMP
	104	
		4 | A
	097	48" CMP
F	088	15° ↑
	081	HT
	079	F 15° ↑
↑25° ~~E-H-MAIN~~	069	HT
E ↑	061	DR
T — T	~~29~~	T — T 15° ↑
	018	PT
		50° ~~30~~
	015	PC 16'G
↑25°	006	24'CW
	003	2-24" CMP
(PAYNE Co.	000	ROAD) 65

SHA 51.3 - 8 Revised
4.83

MARYLAND STATE HIGHWAY ADMINISTRATION

ROAD INVENTORY SHEET

Party Chief C. Martin
Recorder
Assistant Rewritten 3/13/90 KJP
Map No./Dir. GH 24 / N
State Coordinates 1234-67

Road No. Co 67
Road Name Critcher Rd
County Worcester
Date 9/6/74
Sheet No. 1 OF 2

TRAFFIC CODES
TRAFFIC CONTROLS: STOP SIGN=SS, TRAFFIC LIGHT=T.L., FLASHING RED BALL=F.R.

TRAFFIC CODES
PARKING RESTRICTIONS: A.M. PEAK, P.M. PEAK, A.M./P.M. PEAK, NO PARKING ANYTIME=N.P., COMM/IND. ACCESS=E

SYSTEM				TRAFFIC		LINE DIAGRAM	TRAFFIC			PAVEMENT DATA
FED. AID.	FUNCT CLASS.	HWY. SYS.	HPMS SAMPLE	PRKG. REST.	COM/IND. ACCESS		CONTROL	COM/IND. ACCESS	PRKG. REST.	
						0.68 12" cmp				
						0.50 2-24" CMP				
						(Johnson Rd)				
						25° Co 66 0.34				
NON F/A										
Rural Local										
						0.15 PT				
						35°				
						0.11 PC				
						0.06 12" CMP				
						0.01				15' G
						Payne Spur - 0.01/16'G				21' CW
✓	✓					Co 0.00				✓
						Rd 65				

LINE DIAGRAM

SYSTEM				TRAFFIC		TRAFFIC			PAVEMENT DATA
FED. AID.	FUNCT. CLASS.	HWY. SYS.	HPMS SAMPLE	PRKG. REST.	COM/IND ACCESS	CONTROL	COM/IND ACCESS	PRKG. REST.	
↑	↑							↑	

Brantley Co

FP 307

1 54

1 53 36" CMP

1 41 12" CP

1 33 12" CP

1 25 PT 60° PC

1 22

1 20 PT 60° PC

1 17

1 09 PT 80° PC

1 00

0 90 20°

0 77 PT 30° PC

0 74

0 73 12" CP 15" C

NON F/A Rural Local

SHA 51.3-8
11-15-72

STATE HIGHWAY ADMINISTRATION OF MARYLAND

(BS-3) BB/PL 2-84

T. LANDON RHOADES VERIFIED 4/29/74

ROAD INVENTORY SHEET

Party Chief _____
Recorder _____
Helper C. MARTIN

Map No. GH 24

Road No. CO 68
Road Name BIG MILL RD
Sheet No. 1 OF 2
Date 9-9-74
County WORCESTER
State Coordinates 1254-74

88-230

	1 16	F	~~T.C.~~
	1 11	PT ↑ 50° ~~35°~~	~~X~~ 88-230
	1 01	PC	22 I 2 ML
40 BI PVT RD 10"D BI 0	0 97		
125° H	0 91		
H - ABAN	0 87		
	0 83	25° ↑	
	0 70	H	
	0 61	PT ↑ 35°	
50	0 53	PC	
H	0 47	F	
	0 27	24" CP	
30° H (ABAN)	0 25		
H	0 16		
H	0 06		
H	0 04		~~H'G~~ ~~40'CW~~ 2-WE SIDED.
SNOW HILL RD			
MD	0 00	12	✓ 2 ML

W

SHA 51.3-8
11-15-72

ROAD INVENTORY SHEET

Road No. CO 68
Road Name BIG MILL RD
Sheet No. 2 OF 2
Date 9-9-74
County WORCESTER
State Coordinates

SHEFFIELD RD

(SWAN GUT RD CO 72)

2 40	H	
2 30		
2 25		
2 19	H	
~~2 17~~	~~H~~	
2 16	H-ARAN	
2 14	H 30°	
2 12	H	16'G
2 11	H	
~~2 10~~	~~H-CORAC~~	
2 05	CHURCH CEM	
1 91	(STEEL POND RD CO 73) 25°	
1 87		
1 67	F	
1 60		
1 51		SAME
1 48	DR	
1 40		

Form 6 HPS (Rev. 1961) 1225-65

ROAD INVENTORY SHEET

Party Chief F. SETTIN
Recorder T. LANDON
Chainman

T. LANDON
F. RHODES
VERIFIED
4/28/17

Road No. C069
Name (BARNES RD)
Sheet No. 1 OF 1
Date 11-16-65
County WORCESTER

VIRGINIA — VIRGINIA C071 — Co 710

0.48

VIRGINIA — MARYLAND — LINE — LINE

0.25
0.20
0.16
0.12
0.09
0.05
0.02
0.00

(PT PRC 20°

~~PT~~ PRC
~~30°~~ 50°
PC

PT
30°
PC

NO SIGN 60°
30° PRC)

16'C
24'EW

(~~CR~~ PAYNE
Cd.

ROAD)
~~CR~~ 165

Form 6 HPS (Rev. 1961) 1241-71

ROAD INVENTORY SHEET

Party Chief F. SETTAN
Recorder T. LANDON
Chainman

T. LANDON
F. RHODES
VERIFIED
4/29/77

Road No. CO 70
Name S. PAYNE RD
Sheet No. 1 OF 1
Date 11-16-65
County WORCESTER

SHEEPHOUSE		ROAD	
Co.	072	~~075~~ 74	↑
	05A		12" CMP
	~~050~~	~~F~~	
130°	040		
	035	PT	18" CMP
		35°	
	031	PC	
	029	F	
			17' F
F	010		25' CW
MARYLAND		LINE	
VIRGINIA	000	LINE	SIGN ↓
VIRGINIA 713			

N ↑

Form 6 HPS (Rev. 1961) 1244-70

ROAD INVENTORY SHEET

Party Chief F. SETTAN
Recorder T. LANDON
Chainman

T. LANDON
F. RHODES
VERIFIED
4/29/77

Road No. CO 71
Name SILVA RD
Sheet No. 1 OF 1
Date 11-16-65
County WORCESTER

VIRGINIA		Co. 1 712	
	VIRGINIA 714	083	
VIRGINIA / MARYLAND	062	LINE / LINE SIGN	
	054	20° 18" CMP	
	045	20° 20"	17'F
	031		25'CW
	006	36" CMP	
SHEEPHOUSE / Co.	000	ROAD / ~~70~~ 74	

S

SHA 51.3 - 8 Revised
4.83

95 FCRI

MARYLAND STATE HIGHWAY ADMINISTRATION

ROAD INVENTORY SHEET

Party Chief GD
Recorder AH
Assistant
Map No./Dir. M-17 /
State Coordinates

Road No. Co 72
Road Name SWAN CUT RD
County WORCESTER
Date 4/26/95
Sheet No. 1 OF 2

TRAFFIC CODES
TRAFFIC CONTROLS: STOP SIGN=SS, TRAFFIC LIGHT=T.L., FLASHING RED BALL=F.R.

TRAFFIC CODES
PARKING RESTRICTIONS: A.M. PEAK, P.M. PEAK, A.M./P.M. PEAK, NO PARKING ANYTIME=N.P., COMM/IND. ACCESS=E

SYSTEM				TRAFFIC		LINE DIAGRAM	TRAFFIC			PAVEMENT DATA
FED. AID.	FUNCT CLASS.	HWY. SYS.	HPMS SAMPLE	PRKG. REST.	COM/IND. ACCESS		CONTROL	COM/IND. ACCESS	PRKG. REST.	
	Collector					1 39 PT 55° 1 20 PC				
						0 70				
	Minor					PT 0 62 55° PC 0 55				
	Rural					FLEMING RD (SNOW HILL RD) VA 679 0 00 . MD 12 STATE LINE RD 679 STATE LINE VA	SS			16'G 2UML

SYSTEM				TRAFFIC		LINE DIAGRAM	TRAFFIC			PAVEMENT DATA
FED. AID.	FUNCT. CLASS.	HWY. SYS.	HPMS SAMPLE	PRK.G. REST.	COM/IND ACCESS		CONTROL	COM/IND ACCESS	PRK.G. REST.	

Rural Minor Collector

(SHEEPHOUSE RD) (BIG MILL RD)

CO 74 | 171 CO 68

SS

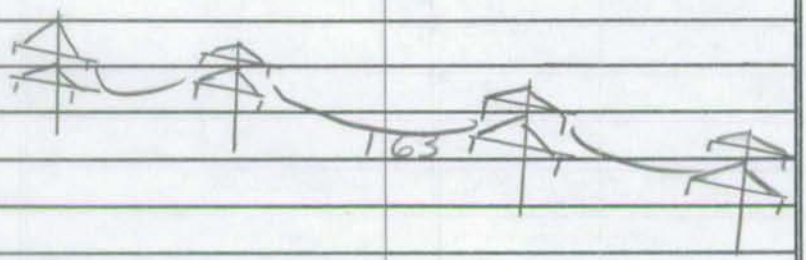

PT 156

60°

PC 151

18'I
2ML

16'G
2ML

SHA 51.3-8
11-15-72

STATE HIGHWAY ADMINISTRATION OF MARYLAND

ROAD INVENTORY SHEET

T. LANDON
F. RHODES
VERIFIED
4/29/77

Party Chief _____
Recorder _____
Helper C. MARTIN

Map No. GH 24

Road No. CO 73
Road Name (STEEL POND RD)
Sheet No. 1 OF 1
Date 9-11-74
County WORCESTER
State Coordinates 1246 - 72

	(JONES ROAD) (HOLLY SWAMP RD) CO		
	CO 78	1 50	
		1 48	2-60" CMP SQUASH 20°
	120°	1 38	
	120°	1 28	
	PT	0 85	
	30°		
	PC H	0 79	
		0 78	
		0 77	PT 45°
		0 73	PC
		0 71	2 - 18" CMP
	H	0 66	
	H	0 49	
	H	0 45	
	900' - F.H. - ABAN	0 19	
		0 17	F
		0 00	(BIG MILL ROAD) CO 68

16'I 30'CW

16'G 30'CW

SHA 51.3-8
11-15-72

ROAD INVENTORY SHEET

Road No. _____
Road Name _____
Sheet No. _____
Date _____
County _____
State Coordinates _____

FCR95

SHA 51.3 - 8 Revised
4.83

MARYLAND STATE HIGHWAY ADMINISTRATION

ROAD INVENTORY SHEET

Party Chief GD
Recorder AH
Assistant
Map No./Dir. M-17 / W
State Coordinates 1245 - 70

Road No. Co 74
Road Name SHEEPHOUSE RD
County WORCHESTER
Date 4/26/95
Sheet No. 1 OF 4

B6-11
B5-4
B4-4

TRAFFIC CODES
TRAFFIC CONTROLS: STOP SIGN=SS, TRAFFIC LIGHT=T.L., FLASHING RED BALL=F.R.

TRAFFIC CODES
PARKING RESTRICTIONS: A.M. PEAK, P.M. PEAK, A.M./P.M. PEAK, NO PARKING ANYTIME=N.P., COMM/IND. ACCESS=E

SYSTEM				TRAFFIC		LINE DIAGRAM	TRAFFIC			PAVEMENT DATA
FED. AID.	FUNCT CLASS.	HWY. SYS.	HPMS SAMPLE	PRKG. REST.	COM/IND. ACCESS		CONTROL	COM/IND. ACCESS	PRKG. REST.	
						0 47 PT				
						40°				
						0 39 PC				20' I
										2 ML
						SILVA RD				
	Collector					CO 71 0.20			X	
						PT 0 16 ACC. TO POND				
						30°				
						PC 0 11				
						BIG MILL 2 LANE D				
						SWAN CUT 0 07 CBC 18' X 18' S. POND				
						PT 0 05				
						30°				
	Minor					PC 0 01				18' I
										2 ML
						SWAN CUT RD				
	Rural					CO 72 0 00			✓	
						BIG MILL RD 0 68 CO				

LINE DIAGRAM

SYSTEM: FED. AID. | FUNCT. CLASS. | HWY. SYS. | HPMS SAMPLE
TRAFFIC: PRKG. REST. | COM/IND ACCESS
TRAFFIC: CONTROL | COM/IND ACCESS | PRKG. REST.
PAVEMENT DATA

* Rural Local
Collector
Minor
Rural

↑ BRANTLEY RD
90° Co 307 2 10

PC 248

1 75 30°

1 26 CH & CEM E

↑ PT 1100
80°
PC 0 90

PAYNE RD
Co 70 084

20'I
2ML

SHA 51.3 - 8 Revised
4.83

MARYLAND STATE HIGHWAY ADMINISTRATION

ROAD INVENTORY SHEET

Party Chief GD
Recorder AH
Assistant
Map No./Dir. L-17 /
State Coordinates

Road No. Co 74
Road Name SHEEPHOUSE RD
County WORCESTER
Date 4/26/95
Sheet No. 3 OF 4

SYSTEM: FED. AID. | FUNCT. CLASS. | HWY. SYS. | HPMS SAMPLE
TRAFFIC: PRKG. REST. | COM/IND. ACCESS

LINE DIAGRAM

FUNCT. CLASS: Local / Rural

3 | 56 — PT
50
3 | 52 — PC

AYDELOTTE RD
CO 75 3 | 20

2 | 51 — 48" CMP

PT
45°
PC
2 | 47
2 | 40

2 | 33 — PT
JONES RD
2 | 29 CO 78 70
2 | 20 — PC

TRAFFIC: CONTROL | COM/IND. ACCESS | PRKG. REST.

PAVEMENT DATA
20'I
2ML

TRAFFIC CODES
TRAFFIC CONTROLS: STOP SIGN=SS, TRAFFIC LIGHT=T.L., FLASHING RED BALL=F.R.

TRAFFIC CODES
PARKING RESTRICTIONS: A.M. PEAK, P.M. PEAK, A.M./P.M. PEAK, NO PARKING ANYTIME=N.P., COMM/IND. ACCESS=E

SYSTEM				TRAFFIC		LINE DIAGRAM	TRAFFIC				PAVEMENT DATA
FED. AID.	FUNCT. CLASS.	HWY. SYS.	HPMS SAMPLE	PRK.G. REST.	COM/IND ACCESS		CONTROL	COM/IND ACCESS	PRK.G. REST.		
	↑ Rural Local				E	OCEAN HWY U.S. 6 27 13	55			↑	
						6 22					
						BUCK CO HARBOR RD 0 47 310					
						OVER HEAD R.L. 4 37					
						E. PETTIT RD PVT RD 4 28					
						4 08 PT					
						BOSTON RD 4 05 CO 77 30					
						4 02 PC					20'I 2ML

Form 6 HPS (Rev. 1961)

1234-78

ROAD INVENTORY SHEET

Party Chief F. SETTAN — T. LANDON
Recorder T. LANDON — F. RHOLES
Chainman

VERIFIED 4/29/77

Road No. CO 75
Name ~~X~~ AYDELOTTE RD ~~X~~
Sheet No. 1 OF 1
Date 11-16-65
County WORCESTER

BRANTLEY		ROAD		
CO.	132	~~08~~ 307		↑ 17'C 30'CW
	110	F		
	074	18" CP	X	
SW ↑	071	18" CP		
	056	F		
				15'C
H - ABAN	004			21'CW
(SHEEPHOUSE		ROAD)		
CO.	000	74		↓

SHA 51.3-8
11-15-72

STATE HIGHWAY ADMINISTRATION OF MARYLAND

ST RI
5/19/99
SS/GF

T. LANDON
F. RHODES
VERIFIED
4/21/77

ROAD INVENTORY SHEET

Party Chief _____
Recorder _____
Helper C. MARTIN

Road No. CO 76
Road Name GROTON RD
Sheet No. 1 OF 1
Date 9-13-74
County WORCESTER
State Coordinates 1218-93

83-2
2/9/84
FR-NS

Map No. GH 24

T. LANDON
F. RHODES
1/24/75
REVISED

RD

BUCK HARBOR CO 310

STOCKTON RD

↑ MD CORP 0.85 LMTS 366 POCOMOKE CITY ↑

0.03
0.40

Jenkins La. ~~0.55~~ ~~H~~

MU 0325 0.64

0.53 H

F 0.50 H

H 0.43 H

0.40 H

COUNTY GARAGE 0.39

82-2
18' I
24' C-W

0.35 H

0.32

0.24

HWY 113

WORCESTER U.S.

SE

0.19 H

0.17 H

H 0.16

H 0.14

H 0.10

H 0.08

CARTER BYRD RD.

CO. RD. 611

RD 113

BY-PASS

OLD US MD

0.00 359

CARTER RD. 611

18' I
~~18' C~~
24' CW

SHA 51.3-8
11-15-72

ROAD INVENTORY SHEET

Road No. _____
Road Name _____
Sheet No. _____
Date _____
County _____
State Coordinates _____

Form 6 HPS (Rev. 1961)

1232-89

ROAD INVENTORY SHEET

PARTY CHIEF Frederick Settan
RECORDER Thomas Landon
CHAINMAN

T. LANDON
F. RHODES
VERIFIED
REVISED 1-4-77

ROAD NO. Co 77
NAME BOSTON RD
SHEET NO. 1 OF 2
DATE 1-23-67
COUNTY WORCESTER

↑30° H	1	43	
	1	34	DR 40°↑
↑20°	1	14	F
↑20° H	1	06	
	0	82	
	0	76	PT ↑ 35°
	0	72	PC)
F (ABAN)	0	48	
H (RODDEN	0	37	RD)
Co.	0	35	~~73~~ 309
F	0	21	
END CEM	0	11	
	0	10	END CEM
	0	08	BEG CEM
S ↑ BEG CEM	0	07	16'C 24'CW
	0	03	X
~~30~~ 80°	0	02	20'I 40'CW
STOCKTON MD.	0	00	ND 366

WD 32-9-120

BYRD RD 8 Co.

Form 6 HPS (Rev. 1961)

ROAD INVENTORY SHEET

PARTY CHIEF Frederick Settan
RECORDER Thomas Landon
CHAINMAN

ROAD NO. Co 77
NAME
SHEET NO. 2 OF 2
DATE 1-23-67
COUNTY WORCESTER

SHEEP HOUSE		ROAD	
Co.	176	74	
F	172		
	156	F	
			SAME

Form 6 HPS (Rev. 1961) 1238-76

ROAD INVENTORY SHEET

Party Chief F. SETTAN
Recorder T. LANDON
Chainman

T. LANDON
F. RHODES
VERIFIED
4/29/77

Road No. CO 78
Name JONES RD
Sheet No. 1 OF 2
Date 11-16-65
County WORCESTER

30° F-H-ABAN	1 34	
	1 07	25°
	0 98	PT 30°
	0 96	18" CMP
	0 95	PC
H	0 85	
	0 83	24" CMP
	0 72	F
F	0 60	
H	0 48	F (ABAN.)
F 500'	0 44	
T 80° F 1000'	0 29	12" CP
	0 18	40° 2-36" CMP
PT 30°	0 12	
PC	0 07	
	0 05	12" CP 25° 16' F 24' CW
(SHEEP HOUSE CO.	0 00	ROAD)

N

Form 6 HPS (Rev. 1961)

L

ROAD INVENTORY SHEET

Party Chief F. SETTON
Recorder T. LANDON
Chainman

Road No. Co 78
Name
Sheet No. 2 OF 2
Date 11-16-65
County WORCESTER

Form 6 HPS (Rev. 1961) 1244-81

ROAD INVENTORY SHEET

Party Chief F. SETTAN
Recorder T. LANDON
Chainman

T. LANDON
F. RHOUES
VERIFIED
4/29/77

Road No. Co 79
Name LITTLE MILL RD
Sheet No. 1 OF 2
Date 11-16-65
County WORCESTER

↑70°	2 02		
	1 99	F 500'	
	1 42	F	
			16'C
F	1 36		30'CW
	1 28	24" CMP	X
	1 16	F-500'	
H-~~ABAN~~ (VAC)	0 98		
	0 79	PT	
		30°	
	0 76	F 700'	
	0 72	PC 36" CMP	
F	0 45		
	0 41	18" CMP	
F ↑	~~0 37~~	~~H ABAN~~	
F	0 27		
	0 19	CHURCH CEM ABAN.	
			15'C
	0 01	36" CMP	30'CW
(HOLLY SWAMP		ROAD)	
CO.	0 00	~~TS~~ 308	V

Form 6 HPS (Rev. 1961)

L

ROAD INVENTORY SHEET

Party Chief F. SETTAN
Recorder T. LANDON
Chainman

Road No. Co 79
Name
Sheet No. 2 OF 2
Date 11-16-65
County WORCESTER

STOCKTON		RD	
MD.	259	366	↑
	249		12" CMP
F	242	H	
H	240	B-NURSING HOME	PT 45°
	237	H	
	234		36" CMP
	230	PC	
	227	F	
			SAME

SHA 51.3-8
11-15-72

STATE HIGHWAY ADMINISTRATION OF MARYLAND

(85-6 & 7) GB/AL 1-22-80

ROAD INVENTORY SHEET

Party Chief _____
Recorder _____
Helper C. MARTIN

Map No. GM 24

Road No. CO 80
Road Name LAMBERTSON RD
Sheet No. 1 OF 2
Date 9-13-74
County WORCESTER
State Coordinates 123 1 - 98

L. LANDON RHODES VERIFIED 4/21/77

			16' I
	1 31		83-6
PT 30° PC HT	1 28		X
	1 26		
	1 02	(BROMLEY RD) 25°	
F	0 91	CO 82	
H	0 89		
	0 79	H	
	0 62	12" CMP	
F	0 55	HT	
HT	0 42	F 600'	
	0 40	PT	
H	0 38	30°	
	0 31	PC	
PT 35° PC	0 26		
	0 19		16' FI 20' CW 2 ML
	0 04		X 20' I 2-4' I SHLDS 32' CW
WORCESTER US 50	0 00	HWY 113	✓

5 ↑

SHA 51.3-8
11-15-72

ROAD INVENTORY SHEET

Road No. CO 80
Road Name LAMBERTSON RD
Sheet No. 2 of 3
Date 9-13-74
County WORCESTER
State Coordinates

SWAMP RD 308

HOLLY CO

STOCKTON RD

MD 171 366 S.S. ~~H'G~~ 19'I 20' CW

163 *

H 154 20°↑

same

SHA 51.3-8
11-15-72

STATE HIGHWAY ADMINISTRATION OF MARYLAND

99 CO Ext #1
3-800
GD/EF

ROAD INVENTORY SHEET

T. LANDON
F. RHODES
VERIFIED
4/21/77

Party Chief _____
Recorder _____
Helper C. MARTIN

Map No. GH 24 T.L ANDON F. RHODES 1/24/75 REVISED

Road No. CO 81
Road Name BYRD RD
Sheet No. 1 OF 2
Date 9-16-74
County WORCESTER
State Coordinates 1232-89

	196	2-24"CMP	
F	191	PT	
		45° ~~30°~~	
	184	F 600'	
	182	PC	
	~~157~~	~~H-ABAN~~	
		BROMLEY ROAD	
	147	CO 82	
30°	128		
F	117		16'F
PT H 500'	113		30'CW
30°			
PC	108		X
	105	2-24" CMP	15'F
NW	098	20°	24'CW
	086		X
15°	085	18" CP	
	076		
	063	12" CP	
20°	057	12" CP	18'F
	041		
STOCKTON	011	30°	24'CW
MD	000	RD 366	
EASTON RD			
CO 77			

SHA 51.3-8
11-15-72

ROAD INVENTORY SHEET

Road No. CO 81
Road Name BYRD RD
Sheet No. 2 OF 2
Date 9-16-74
County WORCESTER
State Coordinates

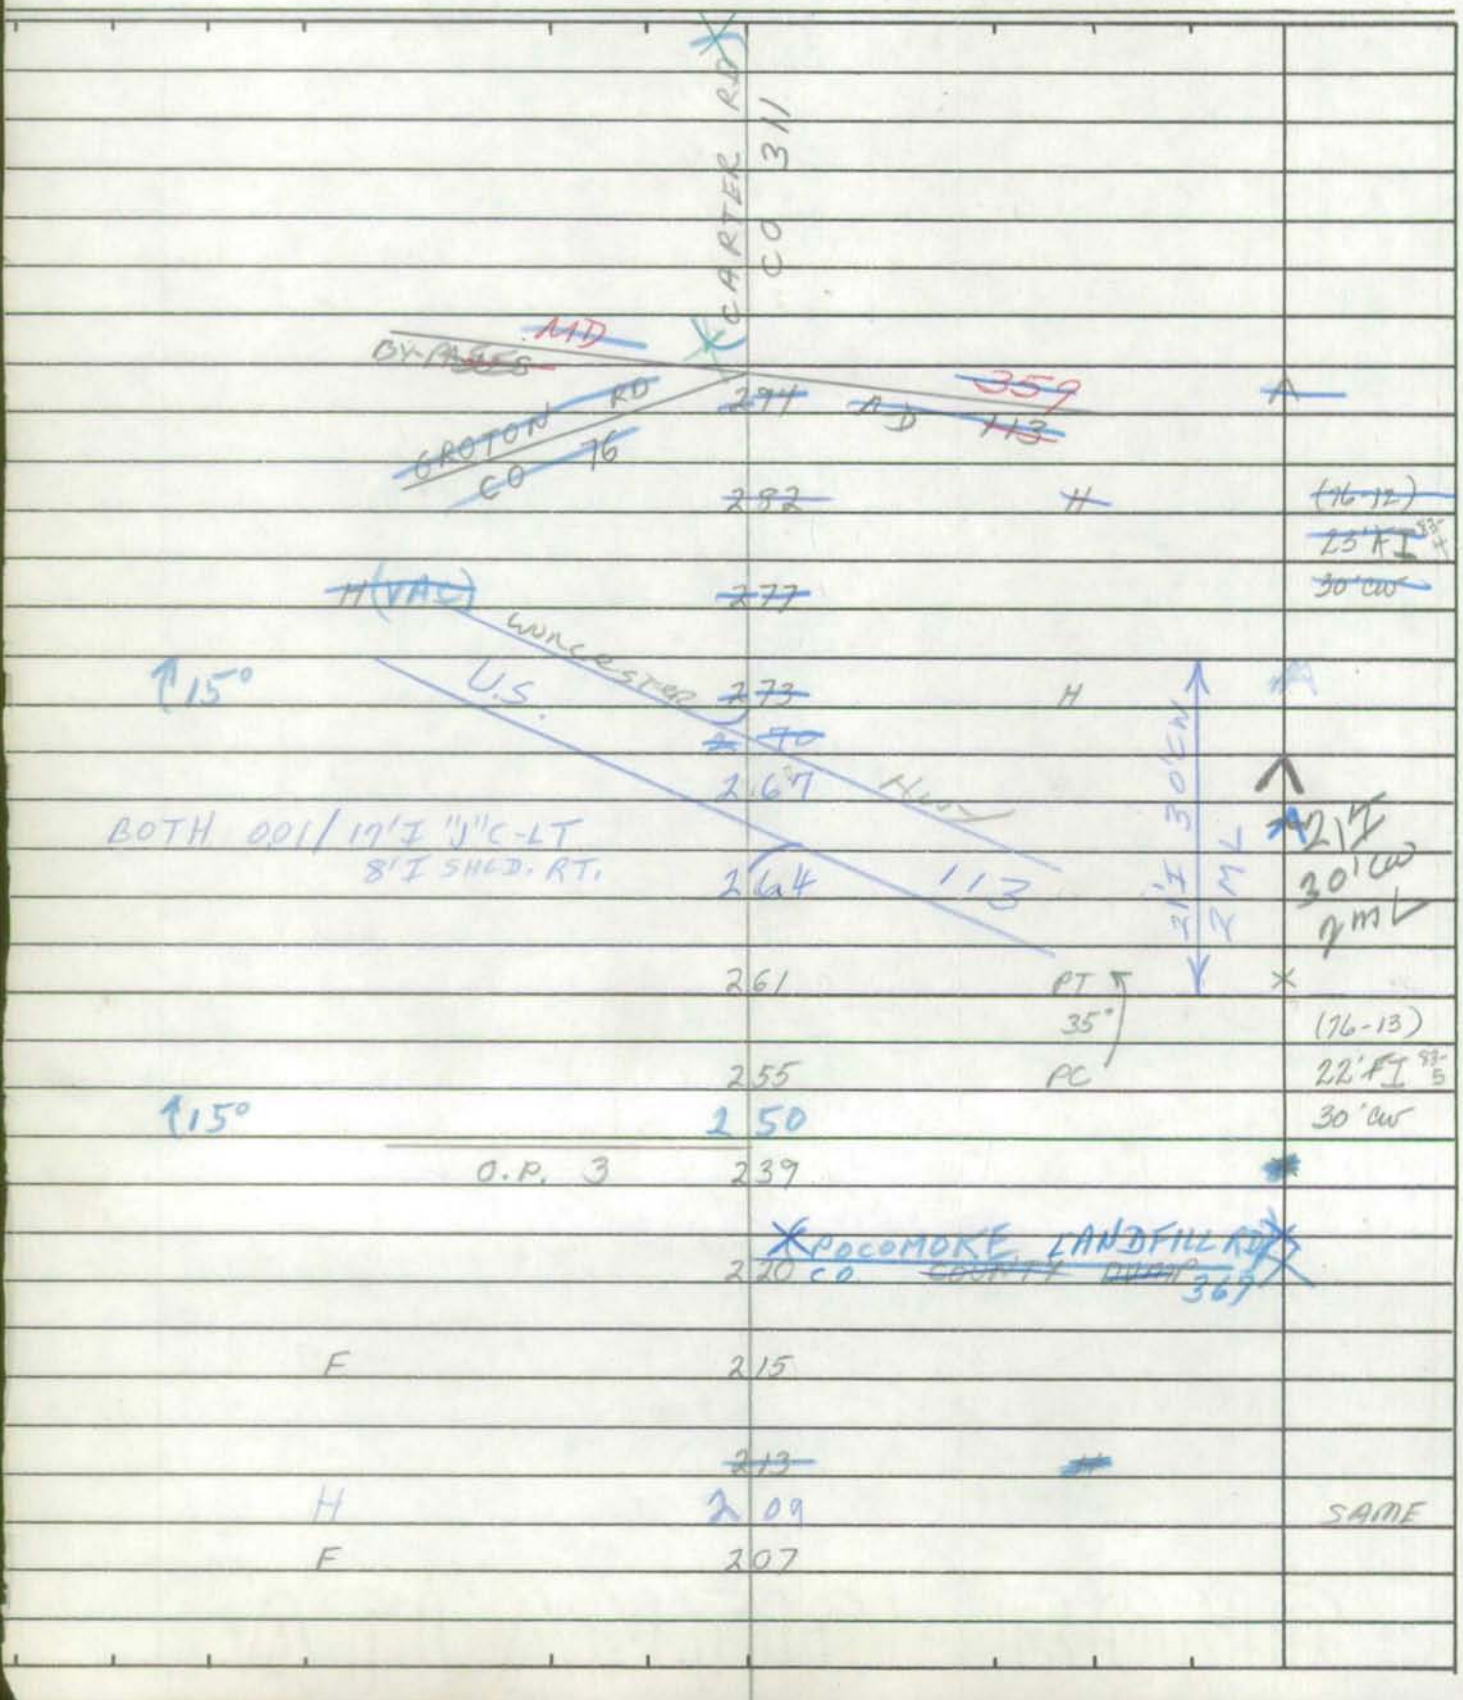

SHA 51.3-8
11-15-72

STATE HIGHWAY ADMINISTRATION OF MARYLAND

ROAD INVENTORY SHEET

Party Chief _____
Recorder K. HESS
Helper _____

Map No. _____ VER 4-21-77

Road No. Co 82
Road Name (BROMLEY RD)
Sheet No. 1 of 2
Date 11-12-65 (REVISED 10-7-77)
County WORCESTER
State Coordinates 1225-91

HT	1 33		
	1 18	24" CMP	
	1 13	3-60" CMP	
	1 02	15° ↰	
	0 83	12" CP	
T — T	0 77	T — PT R T	
	0 75	70° 24" CMP	
	0 73	PC	
	0 65	12" CP	
↗ PT	0 57		
70°			
PC	0 55		
	0 32	12" CP	
↑ 30°	0 24	2-36" CMP	
	0 07	PT ↖	
		30°	18' F
	0 02	PC	24' CW
BYRD RD CO	0 00 ROAD 81		

NE ↑

SHA 51.3-8
11-15-72

ROAD INVENTORY SHEET

Road No. Co 82
Road Name
Sheet No. 2 of 2
Date
County WORCESTER
State Coordinates

LAMBERTSON CO	172	ROAD 80 ^
		18'F
HT	142	30'CW
F 700'	140	X
		SAME

Form 6 HPS (Rev. 1961) 1256-73

8C-12 BB
2-18-87 TM (85-2) BB/A 1-22-86

ROAD INVENTORY SHEET

Party Chief F. SETTAN
Recorder T. LANDON
Chainman

T. LANDON
F. RHODES
VERIFIED 5/2/77

Road No. CO 83
Name (RABBIT KNOW RD)
Sheet No. 1 OF 1
Date 11-18-85
County WORCESTER

		ROAD 84	
GREENBACKVILLE C.O.	1 43		↑
125°	1 18		
	0 84	F	~~H-G~~
H	0 72		
	0 68	PT	*
		60° ~~45~~	
	0 66	H	
	0 65	PC	
	0 59	18" CMP	
SE ↑	0 46		
120° 120° F H	0 36		
F-H-ABAN 800'	0 18		
	0 14		
	0 10	18" CMP	
			~~H~~ 18 BI
	0 04	H	28' CW
H SNOW MD.	0 02	HILL RD	
	0 00	12	↓

Form 6 HPS (Rev. 1961) 1262-70

ROAD INVENTORY SHEET

(85-1) BDM 1-22-86 86-13 GB 2-18-87 TM

Party Chief F. SETTAN
Recorder T. LANDON
Chainman

T. LANDON
F. RHODES
VERIFIED
5/2/77

Road No. Co 84
Name GREENBACKVILLE RD
Sheet No. 1 OF 3
Date 11-18-65
County WORCESTER

H	1	55		
	1	53	H	
	1	50	24" CMP	
F	1	45		
H	1	34	I	
			PVT RD 0	
	1	32	GL 14'D 0	
			F	
F	1	23		
	1	20	F	
F	1	06		
	1	04	H	22' I
	0	92	24" CMP	40' CW
UNION FRANKLIN CITY CEM.	0	75		~~20' I~~
120° (RABBIT KNOB RD) CO. 83	0	64		~~40' CW~~
	0	59	18" CMP	
125°	0	44		
	0	41		~~2 SIGNS~~
				~~18' F~~
H	0	15		~~50 CW~~
				~~2 ML~~
MARYLAND / VIRGINIA	000	LINE / VA. CO. 3001		SIGN
		VA. CO. 3002		

N

Form 6 HPS (Rev. 1961)

L

ROAD INVENTORY SHEET

Party Chief F. SETTAN
Recorder T. HANDAN
Chainman

Road No. CO 84
Name
Sheet No. 2 OF 3
Date 11-18-65
County WORCESTER

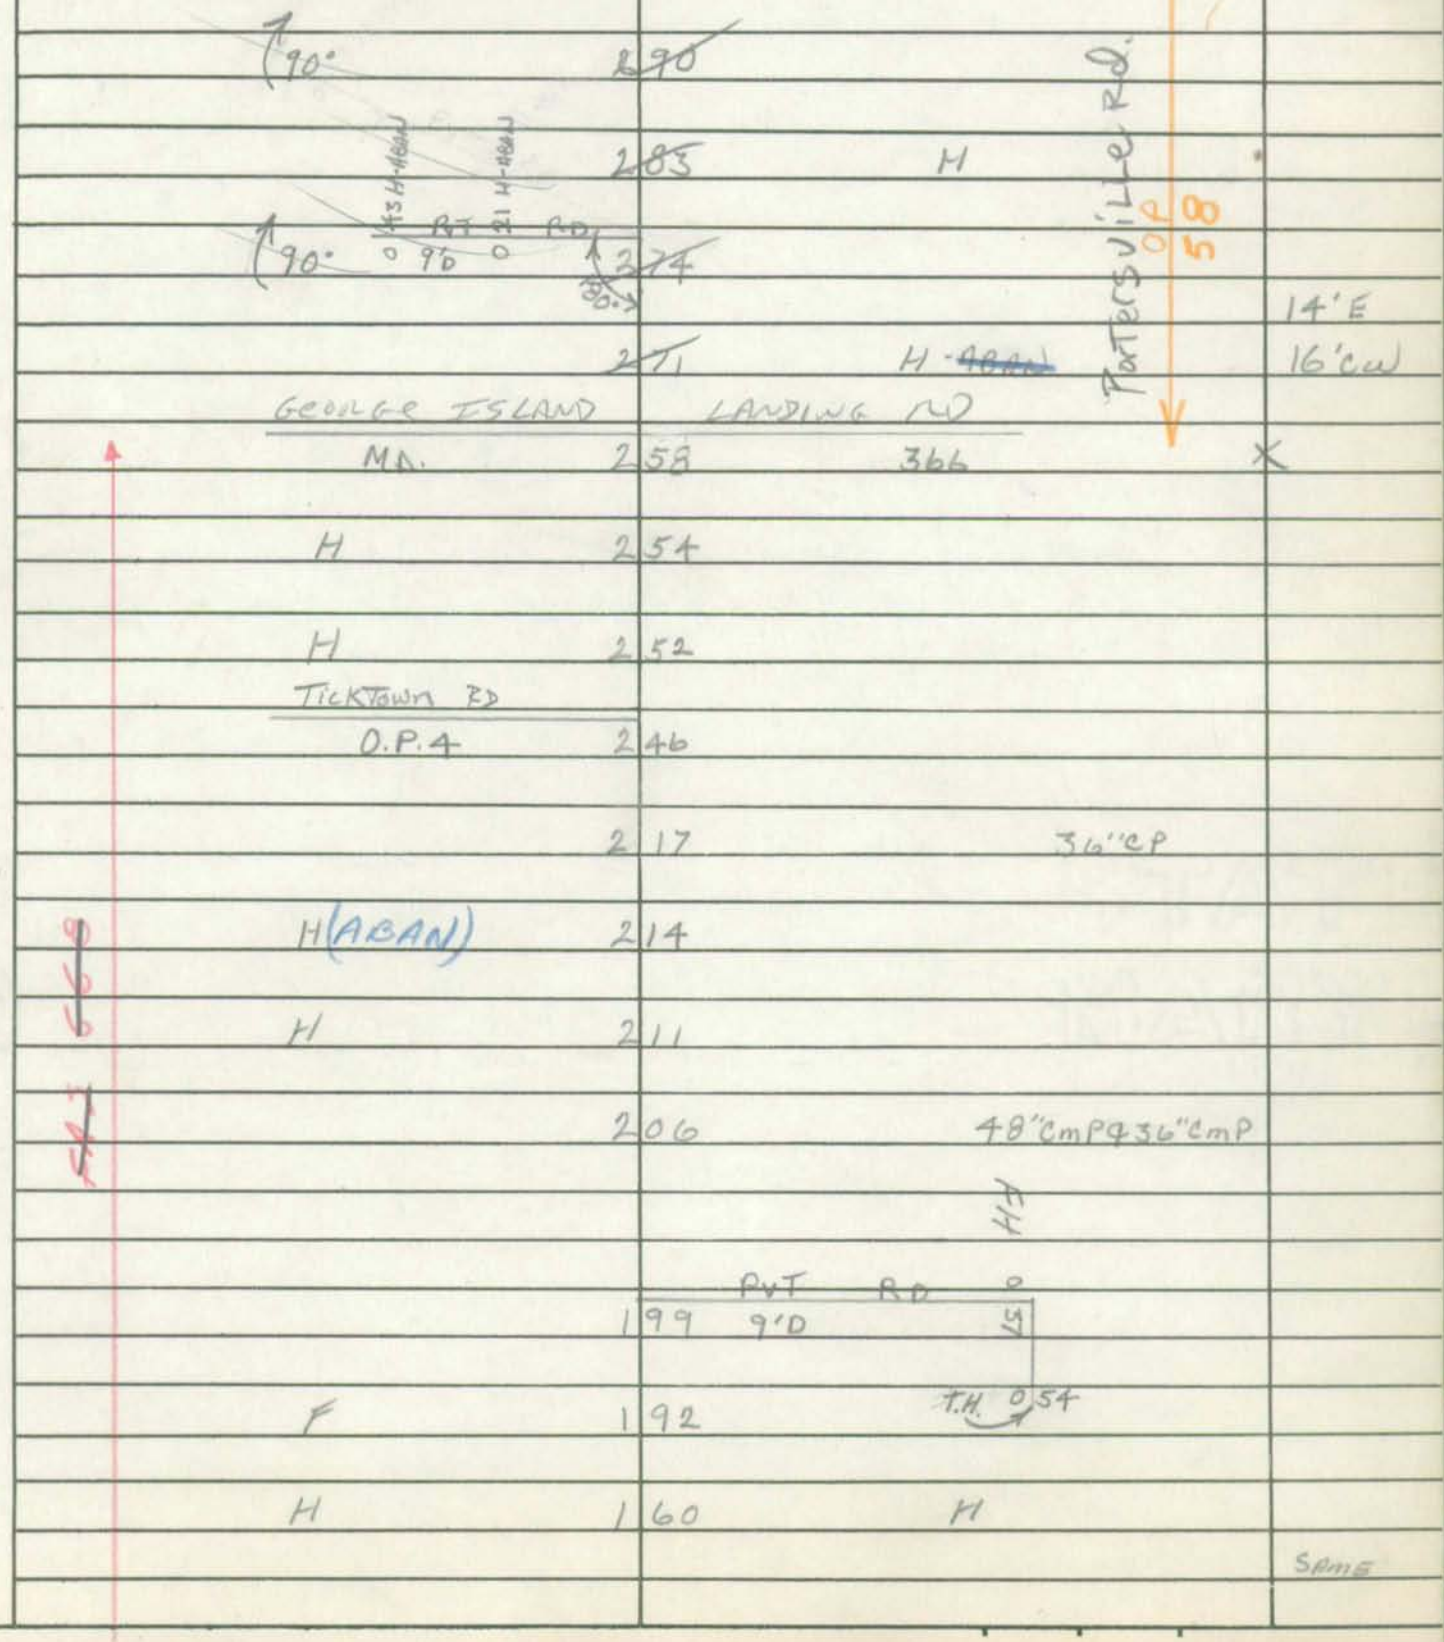

Form 6 HPS (Rev. 1961)

ROAD INVENTORY SHEET

Party Chief F. SETTAN
Recorder T. LANDON
Chainman

Road No. C084
Name
Sheet No. 30F3
Date 11-18-65
County WORCESTER

MD.	~~307~~	366		
	~~295~~	H		
	~~293~~	H		
H	~~291~~			


SHIRLEY

SHA 51.3 - 8 Revised
4.83

MARYLAND STATE HIGHWAY ADMINISTRATION

ROAD INVENTORY SHEET

69-16
NA/CH

89-1

Party Chief F Sellam
Recorder F. Landen
Assistant rewritten 1/9/90 JB
Map No./Dir. 6H24/ N
State Coordinates 1238-97

Road No. CO 85
Road Name Kleej Grange RD
County Worcester
Date 11-18-65
Sheet No. 1 OF 2

TRAFFIC CODES

TRAFFIC CONTROLS: STOP SIGN=SS, TRAFFIC LIGHT=T.L., FLASHING RED BALL=F.R.

TRAFFIC CODES

PARKING RESTRICTIONS: A.M. PEAK, P.M. PEAK, A.M./P.M. PEAK, NO PARKING ANYTIME=N.P., COMM/IND. ACCESS=E

SYSTEM				TRAFFIC		LINE DIAGRAM	TRAFFIC			PAVEMENT DATA
FED. AID.	FUNCT CLASS.	HWY. SYS.	HPMS SAMPLE	PRKG. REST.	COM/IND. ACCESS		CONTROL	COM/IND. ACCESS	PRKG. REST.	
						1 01 12" cmp				
						0 89 20°				
						0 71 36" cmp				
						0 63 20°				
						25° 0 53				
						25° 0 41				
						0 21 PT 30°				
						0 12 PC				16' 6
										26' CW
NON	FA					KLEJ GRANGE RD 0 00				
RURAL	LOCAL					0 70 PI				
						0 03				

Co 85 Pg 2 of 2

SYSTEM: FED. AID. | FUNCT. CLASS. | HWY. SYS. | HPMS SAMPLE
TRAFFIC: PRK.G. REST. | COM/IND ACCESS

LINE DIAGRAM

TRAFFIC: CONTROL | COM/IND ACCESS | PRK.G. REST.

PAVEMENT DATA

NON FA
RURAL LOCAL

Bethedan — Church RD
CO 2 42 87

1 98 30° ↱

17'6
26' CW

Johnson Neck RD
(90° CO 86 1 76

#WP0804
Jones 1 70 Ditch
See Br. 64. 1-A

1 66 20° ↱

1 46 18" Cmp

1 46 PT
35° ↱
1 42 PC

15° 1 24 2-36" Cmp

1 14 15° ↱

Form HPS 5

STATE HIGHWAY ADMINISTRATION OF MARYLAND

IN COOPERATION WITH
FEDERAL HIGHWAY ADMINISTRATION

BRIDGE SHEET

ROAD NO. 385

SHEET NO. _____

PARTY NO. _____

DATE 12-1-76

COUNTY Worcester

RATED CAPACITY _____

FOR ALL STRUCTURES HAVING A TOTAL OPENING OF MORE THAN 20 FEET AS DEFINED IN NOTE 1.

ODOMETER READING 1.70 NAME OF STREAM, RAILROAD OR HIGHWAY CROSSED Jones Ditch (Klej Grange Road)

NUMBER OF RAILROAD TRACKS None

KIND OF CROSSING (NOTE 2) Bridge over stream.

UNDERPASS-SIMPLE UNDERPASS-COMBINED (NOTE 3) OVERPASS BRIDGE OVER SYSTEM

DESCRIPTION

NUMBER OF SPANS	LENGTH EACH SPAN (NOTE 4)	TYPE (NOTE 5)
2	14'0"	Girder

TOTAL LENGTH-ON LINE OF ROAD OVER-ALL (NOTE 6) 28'0"

MATERIAL

SUBSTRUCTURE Creosoted Timber SUPERSTRUCTURE Creosoted Timber

FLOOR Wood

CLEARANCES

ROADWAY (NOTE 7) 19'1" SIDEWALK WIDTHS: RIGHT None LEFT None

SURFACE OF ROAD TO STREAM BED 6'3" FOR OVERPASSES, SHOW DISTANCES TO TOP OF RAIL OR SURFACE OF LOWER ROAD. (NOTE 8)

SURFACE OF ROAD TO BOTTOM PORTAL 4' (MINIMUM OVERHEAD CLEARANCE

CLEAR DISTANCE OF OPENING ABOVE STREAM BED _____ (WATERWAYS ONLY)

POSTED LOAD LIMITS _____ BRIDGE NO. WO 0804 CONSTRUCTION DATE _____

GENERAL CONDITION OF BRIDGE: CHECK IF GOOD, FAIR, OR POOR, DESCRIBE DEFECTS IF SERIOUS.

	GOOD	FAIR	POOR
SUPERSTRUCTURE	X		
FLOOR	X		
SUBSTRUCTURE	X		

PAINT BADLY CORRODED OR RUSTED

TYPE OF PROTECTION FOR DRAWBRIDGES _____

SHA 51.3 - 22
10-1-73

(NOTES ON REVERSE SIDE)

Notes:

1. In agreement with Federal-aid standards, a bridge is defined as a structure including supports erected over a depression or an obstruction, as water, highway, or railway, and having a track or passageway for carrying traffic or other moving loads, and having a length measured along the center of roadway of more than 20 feet between undercoping of abutments or spring lines of arches, or extreme ends of openings for multiple boxes and pipes, where the clear distance between openings is less than half of the smaller contiguous opening.

2. Show kind of crossing by checking descriptive item applicable. For multiple-span bridges give complete information on each span including approach spans. Indicate on leg sheet the odometer reading, position, and angle of skew of structure with respect to center line of road and by arrow the direction of stream flow.

3. Give information on the span over the highway only.

4. For span length use center to center of bearings, otherwise the clear opening. Skew bridges will be measured along center line of road. (See note 1.)

5. Show general type such as: Trestle, Truss, Girder, I-Beam, Rigid Frame, Arch, Slab, Suspension, or Covered Bridge.

6. The length of a bridge structure is the over-all length measured along the line of survey stationing back to back of back-walls of abutments, if present, otherwise end to end of bridge floor, but in no case less than the total clear opening of the structure.

7. Give minimum lateral clearance. Where traffic lanes are separated by bridge members, show clearance width of each lane separately. Special conditions should be explained by notes.

8. In case of overhead bracing or arch construction, measurement shall be made to the lowest point above the road surface.

Remarks: _____

_____

SHA 51.3 - 8 Revised
4.83

MARYLAND STATE HIGHWAY ADMINISTRATION

DCR
4-21-77

ROAD INVENTORY SHEET

89-1

Party Chief _____
Recorder K Hess
Assistant rewritten 1-9-90
Map No./Dir. 6 24 / SW
State Coordinates 1245 -100

Road No. CO 86
Road Name Johnson Neck RD
County Worcester
Date 11-18-65 (revised 10-7-77)
Sheet No. 1 OF 2

SYSTEM				TRAFFIC		LINE DIAGRAM	TRAFFIC			PAVEMENT DATA
FED. AID.	FUNCT CLASS.	HWY. SYS.	HPMS SAMPLE	PRK.G. REST.	COM/IND. ACCESS		CONTROL	COM/IND. ACCESS	PRK.G. REST.	
						1 17 2-36" cmp			X	20'6 30' cw
						0 68 Pvt. Cem			X	
						0 45 15° →				
						0 39 12" cmp				
						↑ 20° 0 28				
						0 16 12" cmp				
						0 08 12" cmp				17'6 26' cw
						Klej Grange 60 0 00			✓	
						8 P 5 0				
NON FA										
RURAL LOCAL										
K	K									

TRAFFIC CODES
TRAFFIC CONTROLS: STOP SIGN=SS, TRAFFIC LIGHT=T.L., FLASHING RED BALL=F.R.

TRAFFIC CODES
PARKING RESTRICTIONS: A.M. PEAK, P.M. PEAK, A.M./P.M. PEAK, NO PARKING ANYTIME=N.P., COMM/IND. ACCESS=E

LINE DIAGRAM

SYSTEM				TRAFFIC		TRAFFIC			PAVEMENT DATA
FED. AID.	FUNCT. CLASS.	HWY. SYS.	HPMS SAMPLE	PRK.G. REST.	COM/IND ACCESS	CONTROL	COM/IND ACCESS	PRK.G. REST.	
NON FA	Rural Local								20'I 2-4'I SH10 32' CW

SB LA

US 126 113

NB LA

SHA 51.3-8
11-15-72

STATE HIGHWAY ADMINISTRATION OF MARYLAND

(85-8) BB/AL 1-22-86

ROAD INVENTORY SHEET

F. LANDON RHODES VERIFIED 4/21/77

Party Chief _____
Recorder _____
Helper C. MARTIN

Map No. GH 24

Road No. CO 87
Road Name BETHEDEN CHURCH RD
Sheet No. 1 OF 2
Date 9-16-74
County WORCESTER
State Coordinates 1243-106

		KLES ERANGE RD ~~JOHNSON NECK RD~~	
	1 36	CO ~~86~~ 85	
F	1 33		
	1 24	PT ↑ 30°	
	1 19	PC	
	~~107~~		
↑ 20°	0 87		
	0 72	36" CMP	
	0 57	H	
	0 41	H 36" CMP	
	0 35	END CEM	
S	0 33	BEG CEM	
3 H	0 23		
H BETHEDEN CT	0 10		
CO 292	0 08		17'I 24'CW 2 ML
PVT CEM	~~000~~ 005		
	0 03		X 22'I 2-4 I SHLDS 34'CW
US	0 00	113	√ 2 ML

SHA 51.3-8
11-15-72

ROAD INVENTORY SHEET

Road No. CO 87
Road Name RETHEDEN CHURCH RD
Sheet No. 2 OF 2
Date 9-16-74
County WORCESTER
State Coordinates

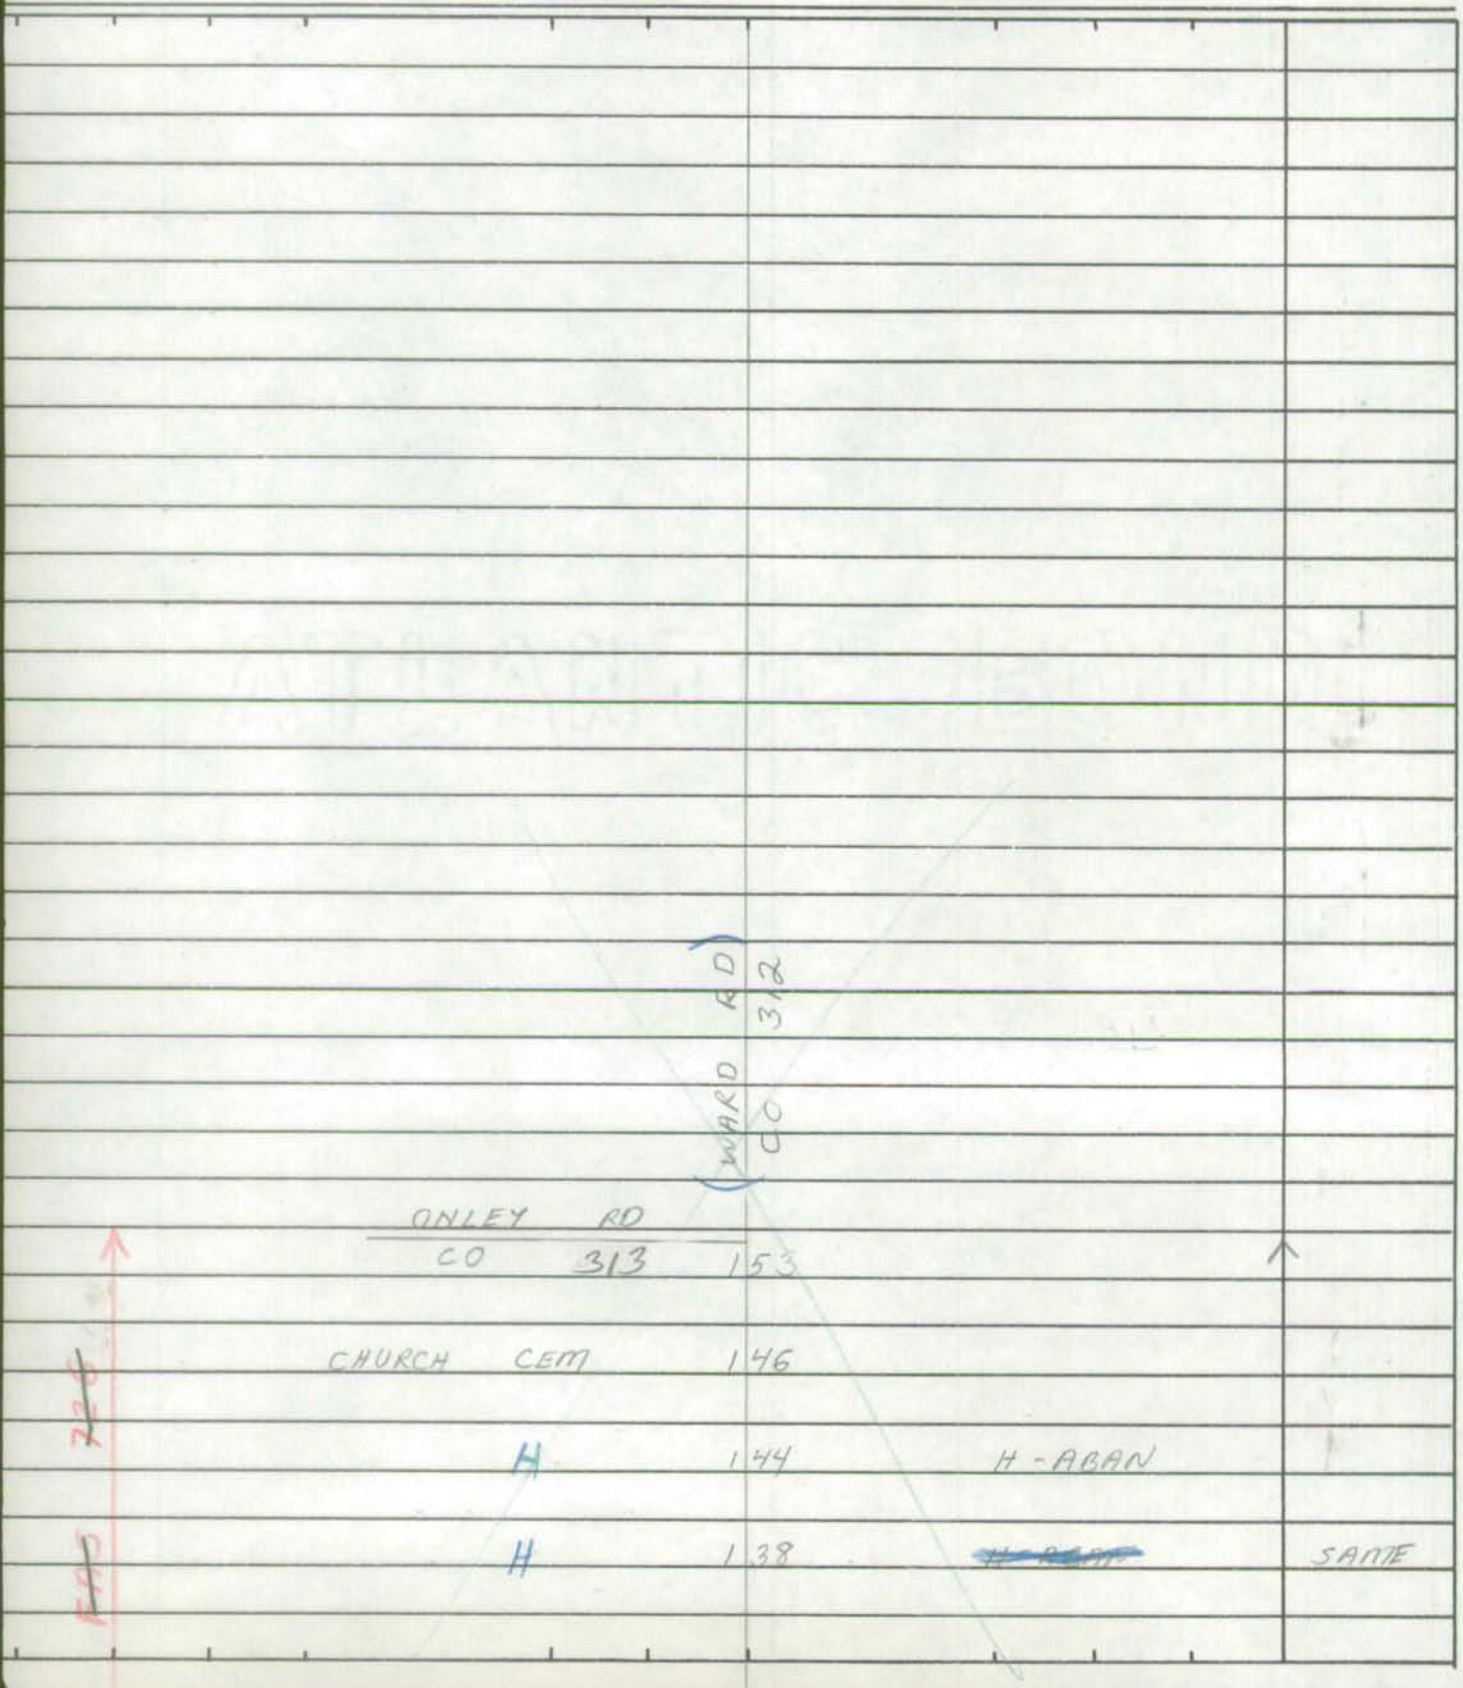

SHA 51.3 - 8 Revised
4.83

MARYLAND STATE HIGHWAY ADMINISTRATION

FCR 95

ROAD INVENTORY SHEET

Party Chief G.D.
Recorder A.H.
Assistant
Map No./Dir. L-18 / SW
State Coordinates 1273-106

Road No. CO 88
Road Name BOXIRON RD
County WORCHESTER
Date 4/25/95
Sheet No. 1 OF 1

TRAFFIC CODES
TRAFFIC CONTROLS: STOP SIGN=SS, TRAFFIC LIGHT=T.L., FLASHING RED BALL=F.R.

TRAFFIC CODES
PARKING RESTRICTIONS: A.M. PEAK, P.M. PEAK, A.M./P.M. PEAK, NO PARKING ANYTIME=N.P., COMM/IND. ACCESS=E

SYSTEM				TRAFFIC		LINE DIAGRAM		TRAFFIC			PAVEMENT DATA
FED. AID.	FUNCT. CLASS.	HWY. SYS.	HPMS SAMPLE	PRKG. REST.	COM/IND. ACCESS			CONTROL	COM/IND. ACCESS	PRKG. REST.	
	Collector					RD	0				
						TAYLOR LANDING RD	2 33				
						CO SPUR 03/16'E					
							2 29				
						PT	0 38				
						BAYVIEW RD					
						CO 95	0 36				
						30°					
	Minor					PC	0 35				16'G
											2UML
						(TRUITTS LANDING RD					
	K					CO	0 00 94	SS			

SYSTEM				TRAFFIC		LINE DIAGRAM	TRAFFIC				PAVEMENT DATA
FED. AID.	FUNCT. CLASS.	HWY. SYS.	HPMS SAMPLE	PK.G. REST.	COM/IND ACCESS		CONTROL	COM/IND ACCESS	PK.G. REST.		

Form 6 HPS (Rev. 1961) 1252-69

ROAD INVENTORY SHEET

Party Chief F. SETTANI T. LANDON
Recorder T. LANDON F. RHODES
Chainman VERIFIED 4/21/77

Road No. Co 89
Name BIRD HILL RD
Sheet No. 1 OF 2
Date 11-19-65
County WORCESTER

	1 42	PC
PT	1 40	
~~30°~~ 50° ~~Co 289~~ ~~Dispersion Rd~~	1 36	
PC PVT 7-7	1 33	
H	1 31	
	1 15	20°
PT	1 05	
30°		
PC	1 01	
	0 82	H
	0 76	25° 24" CMP
H	0 63	
	0 59	12" CP
	0 52	F
F-800'	0 49	
NE 120°	0 30	F
		16'G
	0 05	H 26'CW
WARD CO.	0 03	RD ~~80~~ 312
		20'I
	0 02	18" CP 40'CW
MD	0 00	366

Form 6 HPS (Rev. 1961)

ROAD INVENTORY SHEET

Party Chief F. SETTAN
Recorder T. LANDON
Chainman

Road No. Co 89
Name
Sheet No. 2 OF 2
Date 11-19-65
County WORCESTER

89-140

ONLEY		ROAD		
Co.	2	74	~~89~~ 313	
H	2	72	H	
H	2	70	H	
	2	46	12" CP	18' I
H	2	36		
	2	34	12" CMP	
H	2	28		
	2	24		
H	2	23	PT ~~30°~~	
	2	22	F 45°	
	2	19	PC	
PT ~~30°~~ 45°	2	10		
PC F	2	05		(91-4)
	2	02	18" CMP	18' I
	1	84	F	
	1	74		
H	1	61		16' G
	1	46	PT 18" CMP	
			70° ~~50°~~	SAME

SHA 51.3-8
11-15-72

STATE HIGHWAY ADMINISTRATION OF MARYLAND

ROAD INVENTORY SHEET

Party Chief _____
Recorder _____
Helper _____

Map No. _____

Road No. _____
Road Name _____
Sheet No. _____
Date _____
County _____
State Coordinates _____

Co 90

UNASSIGNED

(NOW OP 338)

(12-13-76)

AS PER TAB VERIFICATION

BY COUNTY ENGR.

SHA 51.3-8
11-15-72

ROAD INVENTORY SHEET

Road No. _____
Road Name _____
Sheet No. _____
Date _____
County _____
State Coordinates _____

SHA 51.3-8
11-15-72

STATE HIGHWAY ADMINISTRATION OF MARYLAND

11/1

ROAD INVENTORY SHEET

T. LANDON
F. RHOLES
VERIFIED 4/20/77

Party Chief _____
Recorder _____
Helper C. MARTIN

Map No. GH 24

Road No. CO 91
Road Name BOXIRON RD
Sheet No. 1 OF 2
Date 9-16-74
County WORCESTER
State Coordinates 1263-99

GIRDLETREE

0 30 H

3 H

0 27

0 23

(PINE STREET)

OP 338 ~~CO~~ ~~90~~ 0 22

0 20 H

0 18 H

0 16 H

3 H

0 12

0 11 H

0 09 H

W

H 0 06

0 05 H 83-12 22'I ~~20'F~~ 30'CW ZML

0 03 H (LANDING RD 93)

0 00 (TAYLORS CO)

SHA 51.3-8
11-15-72

ROAD INVENTORY SHEET

Road No. CO 91
Road Name BOXIRON RD
Sheet No. 2 OF 2
Date 9-16-74
County WORCESTER
State Coordinates

DUKES RD
CO 314

MD 0 31 12

SAME

Form 6 HPS (Rev. 1961) 91-19 AT 90-7

ROAD INVENTORY SHEET

Party Chief F. SETTAN
Recorder T. LANDON
Chairman

T. LANDON
F. RHODES
VERIFIED
4/15/17

Road No. Co 92
Name WHITON CROSSING RD
Sheet No. 1 OF 2
Date 12-15-65
County WORCESTER

96-14 87-20

	1 35	PC	
H	1 21		
PT 90° PC	1 17		
	1 08		
	0 98	20° ↑	
#W00403 POCOMOKE	0 75	RIVER SEE BR. GN 1-A	19'I ~~16'C~~ 22CW
↑15°	0 55		
	0 51	PT 40° PC	
	0 44		
↑15° H	0 41		
	0 35	12" CMP	
	0 32	H 20° ↑	
↑35° H	0 26		
14 I PVT 12'D 08 RD 0 I	0 25		
	0 11	12" CMP	18'I ~~16'C~~ 22'CW
	0 04	H	
WICOMICO CO MD.	0 00	WORCESTER CO 354	

E ↑

Form 6 HPS (Rev. 1961)

ROAD INVENTORY SHEET

Party Chief F. SETTAN
Recorder T. LANDON
Chainman

Road No. Co 92
Name
Sheet No. 2 of 2
Date 12-15-65
County WORCESTER

Form HPS 5

STATE HIGHWAY ADMINISTRATION OF MARYLAND

IN COOPERATION WITH
FEDERAL HIGHWAY ADMINISTRATION

BRIDGE SHEET

ROAD NO. 092

SHEET NO. 1-A

73-14
RECONSTRUCTION OF EXISTING BRIDGE

PARTY NO. _____

DATE 11/30/73

COUNTY Worcester

RATED CAPACITY _____

FOR ALL STRUCTURES HAVING A TOTAL OPENING OF MORE THAN 20 FEET AS DEFINED IN NOTE 1.

ODOMETER READING 0.75 NAME OF STREAM, RAILROAD OR HIGHWAY CROSSED Pocomoke River

NUMBER OF RAILROAD TRACKS _____

KIND OF CROSSING (NOTE 2) Bridge Over Stream

UNDERPASS-SIMPLE UNDERPASS-COMBINED (NOTE 3) OVERPASS BRIDGE OVER SYSTEM

DESCRIPTION

NUMBER OF SPANS	LENGTH EACH SPAN (NOTE 4)	TYPE (NOTE 5)
6	17'-5", 16'-9", 16'-5", 17'-5" 16'-3", 17'-1"	Girder

TOTAL LENGTH-ON LINE OF ROAD OVER-ALL (NOTE 6) 101'

MATERIAL

SUBSTRUCTURE Creosoted Timber SUPERSTRUCTURE Creosoted Timber

FLOOR WOOD

CLEARANCES

ROADWAY (NOTE 7) 20' SIDEWALK WIDTHS: RIGHT None LEFT None

SURFACE OF ROAD TO STREAM BED 14'-0" FOR OVERPASSES, SHOW DISTANCES TO TOP OF RAIL OR SURFACE OF LOWER ROAD. (NOTE 8)

SURFACE OF ROAD TO BOTTOM PORTAL _____ (MINIMUM OVERHEAD CLEARANCE

CLEAR DISTANCE OF OPENING ABOVE STREAM BED 12' (WATERWAYS ONLY)

POSTED LOAD LIMITS _____ BRIDGE NO. 403 CONSTRUCTION DATE _____

GENERAL CONDITION OF BRIDGE: CHECK IF GOOD, FAIR, OR POOR, DESCRIBE DEFECTS IF SERIOUS.

	GOOD X	FAIR	POOR
SUPERSTRUCTURE	Good		
FLOOR	Good		
SUBSTRUCTURE	Good		

PAINT BADLY CORRODED OR RUSTED

TYPE OF PROTECTION FOR DRAWBRIDGES _____

SHA 51.3 - 22
10-1-73

(NOTES ON REVERSE SIDE)

Notes:

1. In agreement with Federal-aid standards, a bridge is defined as a structure including supports erected over a depression or an obstruction, as water, highway, or railway, and having a track or passageway for carrying traffic or other moving loads, and having a length measured along the center of roadway of more than 20 feet between undercoping of abutments or spring lines of arches, or extreme ends of openings for multiple boxes and pipes, where the clear distance between openings is less than half of the smaller contiguous opening.

2. Show kind of crossing by checking descriptive item applicable. For multiple-span bridges give complete information on each span including approach spans. Indicate on leg sheet the odometer reading, position, and angle of skew of structure with respect to center line of road and by arrow the direction of stream flow.

3. Give information on the span over the highway only.

4. For span length use center to center of bearings, otherwise the clear opening. Skew bridges will be measured along center line of road. (See note 1.)

5. Show general type such as: Trestle, Truss, Girder, I-Beam, Rigid Frame, Arch, Slab, Suspension, or Covered Bridge.

6. The length of a bridge structure is the over-all length measured along the line of survey stationing back to back of back-walls of abutments, if present, otherwise end to end of bridge floor, but in no case less than the total clear opening of the structure.

7. Give minimum lateral clearance. Where traffic lanes are separated by bridge members, show clearance width of each lane separately. Special conditions should be explained by notes.

8. In case of overhead bracing or arch construction, measurement shall be made to the lowest point above the road surface.

Remarks: _____

_____

SHA 51.3 - 8 Revised 4.83

FCR 95

MARYLAND STATE HIGHWAY ADMINISTRATION

ROAD INVENTORY SHEET Op 59

Party Chief GD
Recorder AH
Assistant
Map No./Dir. L-17 / E
State Coordinates 1251 - 99

Road No. Co 93
Road Name TAYLOR LANDING RD
County WORCESTER
Date 4/25/95
Sheet No. 1 OF 3

TRAFFIC CODES
TRAFFIC CONTROLS: STOP SIGN=S.S., TRAFFIC LIGHT=T.L., FLASHING RED BALL=F.R.

TRAFFIC CODES
PARKING RESTRICTIONS: A.M. PEAK, P.M. PEAK, A.M./P.M. PEAK, NO PARKING ANYTIME=N.P., COMM/IND. ACCESS=E

SYSTEM FED. AID.	SYSTEM FUNCT. CLASS.	SYSTEM HWY. SYS.	SYSTEM HPMS SAMPLE	TRAFFIC PRK.G. REST.	TRAFFIC COM/IND. ACCESS	LINE DIAGRAM	TRAFFIC CONTROL	TRAFFIC COM/IND. ACCESS	TRAFFIC PRK.G. REST.	PAVEMENT DATA
						PD 0 34				
						91 0 26 30°				
						(BOYDTON CO) LITTLE EGYPT RD				
						0 21 PVT RD				
					E	CHURCH & CEM. 0 18				
						ANE ST				
	Minor Collector					OP 338 0 11				
						0 03 I-R				
						0 02 GIRDLETREE P.O.		E		
						0 01				20' I
										2 ML
						(SNOW HILL RD)				
	K					MD 0 00 12	SS		V	
						RD				
						ONLEY 33 9				

SYSTEM				TRAFFIC		LINE DIAGRAM	TRAFFIC			PAVEMENT DATA
FED. AID.	FUNCT. CLASS.	HWY. SYS.	HPMS SAMPLE	PRKG. REST.	COM/IND ACCESS		CONTROL	COM/IND ACCESS	PRKG. REST.	
	Rural Minor Collector * Rural Local					1 93 WILDLIFE MANAGEMENT AREA		E		
						PT 1 57				
						1 52 02/14 I BAYVIEW CO RD 95 30°				
						1 49				
						PC 1 48				
						085 2-36" CMP				
						PT 0 46				
						03/16E SPUR BOYIRON CO RD 880 ES 0 44				
						PC 0 38				20' I 2 ML

SHA 51.3 - 8 Revised
4.83

MARYLAND STATE HIGHWAY ADMINISTRATION

ROAD INVENTORY SHEET

Party Chief GD
Recorder AH
Assistant
Map No./Dir. L-18 /
State Coordinates

Road No. Co 93
Road Name TAYLOR LANDING RD
County WORCESTER
Date 4/05/95
Sheet No. 3 OF 3

SYSTEM: FED. AID. | FUNCT. CLASS. | HWY. SYS. | HPMS SAMPLE
TRAFFIC: PRK.G. REST. | COM/IND. ACCESS

LINE DIAGRAM

ENT TO SEAFOOD PLUS

ROAD — END

2	60			
2	51	30°	OP	14'6 2UML
2	48			
2	45	30°		20'I 2UML
2	38	35°		20'I 2ML

Local
Rural

PARKING AREA & BOAT LAUNCH

TRAFFIC: CONTROL | COM/IND. ACCESS | PRKG. REST.

PAVEMENT DATA

TRAFFIC CODES
TRAFFIC CONTROLS: STOP SIGN=S.S., TRAFFIC LIGHT=T.L., FLASHING RED BALL=F.R.

TRAFFIC CODES
PARKING RESTRICTIONS: A.M. PEAK, P.M. PEAK, A.M./P.M. PEAK, NO PARKING ANYTIME=N.P., COMM/IND. ACCESS=E

SYSTEM				TRAFFIC		LINE DIAGRAM	TRAFFIC			PAVEMENT DATA
FED. AID.	FUNCT. CLASS.	HWY. SYS.	HPMS SAMPLE	PR/G. REST.	COM/IND ACCESS		CONTROL	COM/IND ACCESS	PR/G. REST.	

Form 6 HPS (Rev. 1961)

ROAD INVENTORY SHEET

Party Chief F. SETTAN
Recorder T. LANDON
Chainman

T. LANDON
F. RHODES
12/77 VERIFIED
4/20/77

Road No. Co 94
Name (TRUITS LANDING RD)
Sheet No. 1 OF 1
Date 12-7-65
County WORCESTER

		CHERRIX Co. Road 315	
	2 37		
	2 30	20° ↑	
↑ PT	2 20	12.1 CP	
35°			
P.C	2 15		
HT	2 10		
F	2 08		
↑15°	1 99		
	1 94	80° ↑	
	1 89		
↑90°			
HT (BOXIRON ROAD) Co. 88	1 59		16'G
	1 36		26'CW
		(BOXIRON ROAD) Co. 96	
	1 26		× 16'E
	~~0 00~~		~~14'E~~
~~↑10°~~			18'CW
	0 35		× 14'E
	0 00		↓ 18'CW
	ROAD END		

NW ↑

BROCKTON/TON BAY

Form 6 HPS (Rev. 1961)

BAYVIEW RD. ✓

ROAD INVENTORY SHEET

Party Chief F. SETTAN
Recorder T. LANDON
Chainman

1762-097
T. LANDON
F. RHODES
VERIFIED
4/21/77

Road No. ~~C095~~
Name ~~HODSON RD~~
Sheet No. 1 OF 2
Date 12-7-65
County WORCESTER

	1 46	PC	
↑15°	1 27	~~E-H-ABND~~	
	1 16		20°↑
	1 10	~~E~~ H-~~ABND~~	
	1 01	~~E~~ H-~~ABND~~	
	0 95	H	15°↑
	0 89		18"CP
	0 85	F 700'	
	0 61	PT	36"CMP
		35°	
	0 57	PC	
↑20°	0 36	F 1000'	
	0 31		12"CP
H	0 16	PT	
		30°	
	0 13	PC	
	0 05		12"CP
0.02/12'G →	0 02	ROAD	16'G
		93	22'CW
	0 00		

NE ↑

TAYLOR LANDING CO.

Form 6 HPS (Rev. 1961)

ROAD INVENTORY SHEET

Party Chief F. SEFTON
Recorder J. LANDON
Chainman

T. LANDON
F. RHODES
VERIFIED
77

Road No. C095
Name
Sheet No. 2 OF 2
Date 12-7-65
County WORCESTER

	(BOXIRON	ROAD)	
	Co.	203	88
		184	12" CP
		175	30° ↑
		168	24" CMP
	PT	167	
	35°		
	PC	162	
		150	PT
			30°
			SAME

SHA 51.3 - 8 Revised
4.83

MARYLAND STATE HIGHWAY ADMINISTRATION

FCR 95

ROAD INVENTORY SHEET

Party Chief G.D.
Recorder A.H.
Assistant
Map No./Dir. L-18 / NE
State Coordinates 1273 - 106

Road No. Co 96
Road Name BOXIRON RD
County WORCHESTER
Date 4 / 25 / 95
Sheet No. 1 OF 1

TRAFFIC CODES
TRAFFIC CONTROLS: STOP SIGN=SS, TRAFFIC LIGHT=T.L., FLASHING RED BALL=F.R.

TRAFFIC CODES
PARKING RESTRICTIONS: A.M. PEAK, P.M. PEAK, A.M./P.M. PEAK, NO PARKING ANYTIME=N.P., COMM/IND. ACCESS=E

SYSTEM				TRAFFIC		LINE DIAGRAM	TRAFFIC			PAVEMENT DATA
FED. AID.	FUNCT. CLASS.	HWY. SYS.	HPMS SAMPLE	PRKG. REST.	COM/IND. ACCESS		CONTROL	COM/IND. ACCESS	PRKG. REST.	
						CHERRIX RD				
	↑					Co 042 315	SS		↑	
	Collector									
	Minor									16G
										2UML
	↓					(TRUITTS LANDING RD)				
						Co 000 94			↓	

SYSTEM				TRAFFIC		LINE DIAGRAM	TRAFFIC				PAVEMENT DATA
FED. AID.	FUNCT. CLASS.	HWY. SYS.	HPMS SAMPLE	PRK.G. REST.	COM/IND ACCESS		CONTROL	COM/IND ACCESS	PRK.G. REST.		

SHA 51.3-8
11-15-72

STATE HIGHWAY ADMINISTRATION OF MARYLAND

ROAD INVENTORY SHEET

Party Chief _____
Recorder _____
Helper C. MARTIN

Map No. GH 24

Road No. CO 97
Road Name CASTLE HILL RD
Sheet No. 1 OF 2
Date 9-17-74
County WORCESTER
State Coordinates 1257-123

T. LANDON
F. RHULEN
VERIFIED 4/20/77
88-252
879

	117	PT ↑ 30°	
	112	PC	
	103	H	
~~F.H. - RIGHT~~	093	H 18" CMP 25° ↑	20'I
↑ 30°	087	H	~~18'G~~
	076	18" CMP 20° ↑	30'CW
	061	24" CMP	~~2ML~~
PT ↑ 35°	056		
PC	051		
US			20'I
	050	~~HT~~ 113	30'CW
	~~044~~ 045		2ML
~~F~~			~~88-252~~
	023	F	
	011	TRAILER PARK 6 HT	
	008	H	
			20'I
	005	H	~~18'G~~
~~MD~~	~~394~~		~~30'CW~~
~~US~~ US	000	~~113~~ 113 Bu	

SE ↑

SHA 51.3-8
11-15-72

ROAD INVENTORY SHEET

Road No. CO 97
Road Name CASTLE HILL RD
Sheet No. 2 OF 3
Date 9-17-74
County WORCESTER
State Coordinates

89-108

CHERRIX RD 315 CO

MD 2 28 12

PT 35° PC 2 13

2 08

20'I

2 01 36" CMP

H 1 95

F 1 87

H 1 72

CHURCH - 1 70

1 68

H (ABAN.) 1 65 30°↑

H 1 60

1 50 12" CP

PT 65° PC 1 43

1 38 18'E 30 CW

1 33 PT 80° PC

1 28 SAME

Form 6 HPS (Rev. 1961) 1277-108

ROAD INVENTORY SHEET

Party Chief F. SETTAN — T. LANDON
Recorder T. LANDON — F. RHODES
Chainman — VERIFIED 4/20/77

Road No. Co 98
Name (BOXIRON CREEK RD)
Sheet No. 1 OF 1
Date 12-7-65
County WORCESTER

BOXIRON		CREEK	
	ROAD	END	
~~H ROAD~~	0	71	
	0	68	DR
	0	64	H (NAC)
H (NAC)	0	55	
	0	52	DR
FLOOD ~~1~~ 80°	0	46	
SE ↑	0	41	12" CP
	0	19	H — 16' E
	0	14	HT — ~~13' E~~
	0	07	12" CP — 16' CW
(~~Boxiron~~ Cherrix Co'	0	00	ROAD) 315 ~~98~~ 98 ~~96~~

SHA 51.3-8
11-15-72

STATE HIGHWAY ADMINISTRATION OF MARYLAND

ROAD INVENTORY SHEET

Party Chief _____
Recorder K. HESS
Helper _____

Map No. _____ VER 4-20-77

Road No. Co 99
Road Name AYRES LANE RD
Sheet No. 1 of 2
Date 9-17-64 (REVISED 10-7-77)
County WORCESTER
State Coordinates 1267-117

H	2	25	F 500'	
	1	97	2-18" CMP	
H	1	78		
F	1	68	F	
H	1	64		
H	1	56		
H	1	44		
F	1	32	F	
F	1	22	HT	
	1	17	H	
F 600'	1	10		83-16 18' I 30' CW 2ML
	0	99	18" CMP X	
	0	61	12" CMP	
H (ABAN)	0	36	F	82-A 22' I 18' G
	0	05	12" CMP	30' CW 2ML
MD	0	00	12	

SE ↑

SHA 51.3-8
11-15-72

ROAD INVENTORY SHEET

Road No. Co 99
Road Name
Sheet No. 2 of 2
Date
County WORCESTER
State Coordinates

(SCOTTS LANDING RD)

PAW PAW CREEK RD

2 89

(Cherrix ~~BOZMAN~~ ROAD)

2 88 ~~CO 96~~ CO 315

2 75 H

2 68 H

2 48 H

2 41 F

F 800' 2 34

SAME

SHA 51.3 - 8 Revised 4.83

FCR95

MARYLAND STATE HIGHWAY ADMINISTRATION

ROAD INVENTORY SHEET

Party Chief G.D.
Recorder A.H.
Assistant
Map No./Dir. L-18 / NE
State Coordinates 1277 - 110

Road No. CO 100
Road Name PAW PAW CREEK RD
County WORCHESTER
Date 4/25/95
Sheet No. 1 OF 3

TRAFFIC CODES
TRAFFIC CONTROLS: STOP SIGN=SS, TRAFFIC LIGHT=T.L., FLASHING RED BALL=F.R.

TRAFFIC CODES
PARKING RESTRICTIONS: A.M. PEAK, P.M. PEAK, A.M./P.M. PEAK, NO PARKING ANYTIME=N.P., COMM/IND. ACCESS=E

SYSTEM				TRAFFIC		LINE DIAGRAM	TRAFFIC			PAVEMENT DATA
FED. AID.	FUNCT CLASS.	HWY. SYS.	HPMS SAMPLE	PRKG. REST.	COM/IND. ACCESS		CONTROL	COM/IND. ACCESS	PRKG. REST.	
	Rural Minor Collector					PT 0 97 300 PC 0 92 BAYSIDE RD 0 30 CO 101 0 28 0 06 PT SCOTTS LANDING RD 30 316 0 01 PC SCOTTS LANDING CO 0 00 AYRES LANE RD CO			X	18' F 2 UML 18' I 2 ML

LINE DIAGRAM

SYSTEM: FED. AID. | FUNCT. CLASS. | HWY. SYS. | HPMS SAMPLE
TRAFFIC: PRKG. REST. | COM/IND ACCESS
TRAFFIC: CONTROL | COM/IND ACCESS | PRKG. REST.
PAVEMENT DATA

Rural — Collector — Minor

PT
30°
PC
2 | 13

2 | 19

1 | 97
30°

30°
1 | 83

1 | 62
PT
35°
1 | 54
PC

McCABES CORNER RD
CO 109 1 | 53

STAGG RD
1 | 47 CO 102

PT
30°
PC
1 | 34

1 | 77

18' F
2 UML

SHA 51.3 - 8 Revised
4.83

MARYLAND STATE HIGHWAY ADMINISTRATION

ROAD INVENTORY SHEET

Party Chief: GD
Recorder: AH
Assistant:
Map No./Dir.: L 18 /
State Coordinates:

Road No.: CO 180
Road Name: PAW PAW CREEK RD
County: WORCESTER
Date: 4/25/93
Sheet No.: 3 OF 3

TRAFFIC CODES
TRAFFIC CONTROLS: STOP SIGN=SS, TRAFFIC LIGHT=T.L., FLASHING RED BALL=F.R.

TRAFFIC CODES
PARKING RESTRICTIONS: A.M. PEAK, P.M. PEAK, A.M./P.M. PEAK, NO PARKING ANYTIME=N.P., COMM/IND. ACCESS=E

SYSTEM: FED. AID.	SYSTEM: FUNCT CLASS.	SYSTEM: HWY. SYS.	SYSTEM: HPMS SAMPLE	TRAFFIC: PRKG. REST.	TRAFFIC: COM/IND. ACCESS	LINE DIAGRAM	TRAFFIC: CONTROL	TRAFFIC: COM/IND. ACCESS	TRAFFIC: PRKG. REST.	PAVEMENT DATA
						TAYLOR RD 317				
						(PUBLIC LOG. RD.)				
	A					MD 3 35 365	SS			
						3 24 36" CMP				
						SPENCE CHURCH RD				
	Collector					CO 110 3 17				
						PT 2 77				
						50°				
	Minor					PC 2 67				
						2 56 PT				
						2 43 2-36"CMP 45°				18'F
	Rural					3 39 PC				2 UML

SYSTEM				TRAFFIC		LINE DIAGRAM	TRAFFIC				PAVEMENT DATA
FED. AID.	FUNCT. CLASS.	HWY. SYS.	HPMS SAMPLE	PRK.G. REST.	COM/IND ACCESS		CONTROL	COM/IND ACCESS	PRK.G. REST.		

Form 6 HPS (Rev. 1961) M92-120

ROAD INVENTORY SHEET

Party Chief F. SEETAN
Recorder I. LANDON
Chainman

Snow Hill Landfill

I. LANDON
F. RHODES
VERIFIED
4/20/77

71-15 New Bridge

Road No. Co 101
Name BAYSIDE RD
Sheet No. 1 OF 3
Date 12-8-65
County WORCESTER

Revised 3-1-72

88-229

see new Inv

WRITTEN 03-07-01	0	45	PVT RD 12'D	
SS/AQ Imp # 00900				
F 700'	0	44		
PVT RD				
16'F	0	31		
				88-229
H	0	30	30° X	22'I
	0	25		
	0	22		2mL
#W00203				
PAW PAW	0	20	CREEK X	
			SEE BR SHT 1-A	
(Island View RD)	0	18		
OP. 12	0	15	H	
			COSTEN ROAD THIRD ST.	20'I
H	0	14	Co. 107	83-18
H	0	11		2mL
	0	10	H	
H	0	08		
(Island View RD)				
O.P. 11	0	07		
H	0	06	H	
	0	05	FIRST ST. (67-9) Co. 270	16'G
	0	04	H	2 FCW
MD.	0	00	365	

SW

SHA 51.3 - 8 Revised
4.83

00-9CO
SS/AQ
02-07-01

MARYLAND STATE HIGHWAY ADMINISTRATION

ROAD INVENTORY SHEET

Party Chief S. Snyder
Recorder A. QUATTROCHI
Assistant
Map No./Dir. L18 / S
State Coordinates 1292-116

Road No. CO 101
Road Name BAYSIDE RD
County WORCESTER
Date 03-07-01
Sheet No. 1 OF 5

TRAFFIC CODES

TRAFFIC CONTROLS: STOP SIGN-SS, TRAFFIC LIGHT-T.L., FLASHING RED BALL-F.R.

PARKING RESTRICTIONS: A.M. PEAK, P.M. PEAK, A.M./P.M. PEAK, NO PARKING ANYTIME-N.P., COMM/IND. ACCESS-I

SYSTEM				TRAFFIC		LINE DIAGRAM	TRAFFIC			PAVEMENT DATA
	FUNCT CLASS	HWY SYS	HPMS SAMPLE	PREG. REST.	COM/IND ACCESS		CONTROL	COM/IND ACCESS	PREG. REST.	
						(ISLAND VIEW RD)				
						OP 12 0 15				
						THIRD ST				
						0 14 CO 107				
						(ISLAND VIEW RD)				
						OP 11 0 07				
						FIRST ST				
						0 05 CO 270				
										20'I
						PUBLIC LANDING RD				2ML
						MD 0 00 365				✓

COUNTY WORCESTER ROAD NO. C0101 PAGE 2 OF 5

SYSTEM				TRAFFIC		TRAFFIC			LINE DIAGRAM	PAVEMENT DATA
FUNCT CLASS	HWY SYS	HPMS SAMPLE		PREG REST	OWNING ACCESS	CHNG	OWNING ACCESS	PREG. REST.		
									0.58 JCT RT 10 I ERR	
									CARRIE BACK RD	
									C0 755 (00-9C0) 0.57 JCT RT 10 I ACC	
									0.55	
									0.45 PVT RD	
									PVT RD 0.31	
									0.30 30°	
										22'I
										2mL
									0.22 WN0203	X
									PAWPAW 0.20 CREEK	
									0.18	
										20'I
										2mL

SHA 51.3 - 8 Revised
4.83

MARYLAND STATE HIGHWAY ADMINISTRATION

ROAD INVENTORY SHEET

Party Chief S.Snyder
Recorder A. QUATTROCHI
Assistant
Map No./Dir. 418 /5
State Coordinates

Road No. CO 101
Road Name BAYSIDE RD
County WORCESTER
Date 03-07-01
Sheet No. 3 OF 5

TRAFFIC CODES

TRAFFIC CONTROLS: STOP SIGN-SS, TRAFFIC LIGHT=T.L., FLASHING RED BALL=F.R.

TRAFFIC CODES

PARKING RESTRICTIONS: A.M. PEAK, P.M. PEAK, A.M./P.M. PEAK, NO PARKING ANYTIME-N.P., COMM/IND. ACCESS=E

SYSTEM				TRAFFIC		LINE DIAGRAM			TRAFFIC			PAVEMENT DATA
	FUNCT CLASS	HWY SYS	NHS SAMPLE	PREG. REST.	COMM/IND ACCESS				CONTROL	COMM/IND ACCESS	PREG. REST.	
							STAGG ROAD					
						1	61 CO 102					
					E	BOATS & MARINE SUPPLY	1	35				
						STAGG	1	32	WO 0202 CREEK			
							1	20			X	17'G 2 ML
												22'C 2ML

SYSTEM: FUNCT CLASS | HWY SYS | NHS | SAMPLE
TRAFFIC: PROG. DEST. | OWNING ACCESS

LINE DIAGRAM

TRAFFIC: CRITICAL | COMMUNITY ACCESS | PROG. DEST.

PAVEMENT DATA

PVT RD

2 76

PT / PVT 2 74

PT 2 56

80° 2 50 48" CMP

PC 2 46

FIGGS LANDING RD

CO 108 1 97

17'G

amc

SHA 51.3 - 8 Revised
4.83

MARYLAND STATE HIGHWAY ADMINISTRATION

ROAD INVENTORY SHEET

Party Chief S. Snyder
Recorder A. QUATTROCHI
Assistant
Map No./Dir. 418 / S
State Coordinates

Road No. C0101
Road Name BAYSIDE RD
County WORCESTER
Date 03-07-01
Sheet No. 5 OF 5

SYSTEM				TRAFFIC		LINE DIAGRAM	TRAFFIC			PAVEMENT DATA
	FUNCT CLASS	HWY. SYS	HPMS SAMPLE	REG. REST.	COMM/IND ACCESS		CONTROL	COMM/IND ACCESS	REG. REST.	
						PAWPAW CREEK RD				
						CO 369 100				
										17'6
										2mL

TRAFFIC CODES

TRAFFIC CONTROLS: STOP SIGN-SS, TRAFFIC LIGHT=T.L., FLASHING RED BALL=F.R.

TRAFFIC CODES

PARKING RESTRICTIONS: A.M. PEAK, P.M. PEAK, A.M./P.M. PEAK, NO PARKING ANYTIME-N.P., COMM/IND. ACCESS=I

COUNTY _____ ROAD NO. _____ PAGE ___ OF ___

SYSTEM				TRAFFIC		LINE DIAGRAM	TRAFFIC			PAVEMENT DATA
FUNCT CLASS	HWY SYS	NHS	STATE SAMPLE	PREG. REST.	COM/IND ACCESS		S. CHARGE	COM/IND ACCESS	PREG. REST.	

Form 5-HPS
(Revised 1971)

STATE HIGHWAY ADMINISTRATION OF MARYLAND
PLANNING AND PROGRAMMING DIVISION S26130

IN COOPERATION WITH
FEDERAL HIGHWAY ADMINISTRATION

BRIDGE SHEET

ROAD NO. 101

SHEET NO. _____

PARTY NO. _____

DATE 11-30-71

71-15

COUNTY Worcester

RATED CAPACITY _____

FOR ALL STRUCTURES HAVING A TOTAL OPENING OF MORE THAN 20 FEET AS DEFINED IN NOTE 1.

ODOMETER READING 0.20 NAME OF STREAM, RAILROAD OR HIGHWAY CROSSED Paw Paw Creek

NUMBER OF RAILROAD TRACKS _____

KIND OF CROSSING (NOTE 2) Bridge Over Stream

UNDERPASS-SIMPLE UNDERPASS-COMBINED (NOTE 3) OVERPASS BRIDGE OVER SYSTEM

DESCRIPTION

NUMBER OF SPANS	LENGTH EACH SPAN (NOTE 4)	TYPE (NOTE 5)
16	12'-2" Each	Girder

TOTAL LENGTH-ON LINE OF ROAD OVER-ALL (NOTE 6) 194' - 8"

MATERIAL

SUBSTRUCTURE Creosoted Timber SUPERSTRUCTURE Creosoted Timber

FLOOR Wood

CLEARANCES

ROADWAY (NOTE 7) 20' SIDEWALK WIDTHS: RIGHT None LEFT None

SURFACE OF ROAD TO STREAM BED 7' - 5" FOR OVERPASSES, SHOW DISTANCES TO TOP OF RAIL OR SURFACE OF LOWER ROAD. (NOTE 8)

SURFACE OF ROAD TO BOTTOM PORTAL _____ (MINIMUM OVERHEAD CLEARANCE

CLEAR DISTANCE OF OPENING ABOVE STREAM BED 5' (WATERWAYS ONLY)

POSTED LOAD LIMITS _____ BRIDGE NO. 203 CONSTRUCTION DATE 11-30-71

GENERAL CONDITION OF BRIDGE: CHECK IF GOOD, FAIR, OR POOR, DESCRIBE DEFECTS IF SERIOUS.

	GOOD X	FAIR	POOR
SUPERSTRUCTURE	Good		
FLOOR	Good		
SUBSTRUCTURE	Good		

PAINT BADLY CORRODED OR RUSTED

TYPE OF PROTECTION FOR DRAWBRIDGES (NOTE 9) _____

(NOTES ON REVERSE SIDE)

S26130

Notes:

1. In agreement with Federal-aid standards, a bridge is defined as a structure including supports erected over a depression or an obstruction, as water, highway, or railway, and having a track or passageway for carrying traffic or other moving loads, and having a length measured along the center of roadway of more than 20 feet between undercoping of abutments or spring lines of arches, or extreme ends of openings for multiple boxes and pipes, where the clear distance between openings is less than half of the smaller contiguous opening.

2. Show kind of crossing by checking descriptive item applicable. For multiple-span bridges give complete information on each span including approach spans. Indicate on leg sheet the odometer reading, position, and angle of skew of structure with respect to center line of road and by arrow the direction of stream flow.

3. Give information on the span over the highway only.

4. For span length use center to center of bearings, otherwise the clear opening. Skew bridges will be measured along center line of road. See Note 1.

5. Show general type such as: Trestle, Truss, Girder, I-Beam, Rigid Frame, Arch, Slab, Suspension, or Covered Bridge. See illustrations attached. Describe draw spans by classifications listed in Article X, Section 2 of Manual.

6. The length of a bridge structure is the over-all length measured along the line of survey stationing back to back of back-walls of abutments, if present, otherwise end to end of bridge floor, but in no case less than the total clear opening of the structure.

7. Give minimum lateral clearance. Where traffic lanes are separated by bridge numbers, show clearance width of each lane separately. Special conditions should be explained by notes.

8. In case of overhead bracing or arch construction, measurement shall be made to the lowest point above the road surface.

9. Use classification listed on RR crossing sheets. Form 4 HPS.

Remarks: _____

A rearrangement of the form similar to that shown on the attachment may be used to provide space for coding.

Form 5-HPS (Revised 1961) MARYLAND STATE ROADS COMMISSION PLANNING AND PROGRAMMING DIVISION S26130

IN COOPERATION WITH
U. S. BUREAU OF PUBLIC ROADS

BRIDGE SHEET

ROAD NO. C0101

SHEET NO. 1-B

PARTY NO.

DATE 12-8-65

COUNTY DORCHESTER

RATED CAPACITY

FOR ALL STRUCTURES HAVING A TOTAL OPENING OF MORE THAN 20 FEET AS DEFINED IN NOTE 1.

ODOMETER READING 1.32 NAME OF STREAM, RAILROAD OR HIGHWAY CROSSED STAGG CREEK

NUMBER OF RAILROAD TRACKS

KIND OF CROSSING (NOTE 2)

UNDERPASS-SIMPLE UNDERPASS-COMBINED (NOTE 3) OVERPASS BRIDGE OVER SYSTEM

DESCRIPTION

NUMBER OF SPANS	LENGTH EACH SPAN (NOTE 4)	TYPE (NOTE 5)
4	14	WOOD - PILE

TOTAL LENGTH-ON LINE OF ROAD OVER-ALL (NOTE 6) 56'

MATERIAL

SUBSTRUCTURE WOOD SUPERSTRUCTURE WOOD

FLOOR WOOD

CLEARANCES

ROADWAY (NOTE 7) 15 SIDEWALK WIDTHS: RIGHT LEFT

SURFACE OF ROAD TO STREAM BED 5' FOR OVERPASSES, SHOW DISTANCES TO TOP OF RAIL OR SURFACE OF LOWER ROAD. (NOTE 8)

SURFACE OF ROAD TO BOTTOM PORTAL 2' (MINIMUM OVERHEAD CLEARANCE

CLEAR DISTANCE OF OPENING ABOVE STREAM BED 3' (WATERWAYS ONLY)

POSTED LOAD LIMITS BRIDGE NO. 207 CONSTRUCTION DATE

GENERAL CONDITION OF BRIDGE: CHECK IF GOOD, FAIR, OR POOR, DESCRIBE DEFECTS IF SERIOUS.

	GOOD	FAIR	POOR
SUPERSTRUCTURE	✓		
FLOOR	✓		
SUBSTRUCTURE	✓		

PAINT BADLY CORRODED OR RUSTED

TYPE OF PROTECTION FOR DRAWBRIDGES (NOTE 9)

(NOTES ON REVERSE SIDE)

S26130

Notes:

1. In agreement with Federal-Aid standards, a bridge is defined as a structure including supports erected over a depression or an obstruction, as water, highway, or railway, and having a track or passageway for carrying traffic or other moving loads, and having a length measured along the center of roadway of more than 20 feet between undercoping of abutments or spring lines of arches, or extreme ends of openings for multiple boxes and pipes, where the clear distance between openings is less than half of the smaller contiguous opening.

2. Show kind of crossing by checking descriptive item applicable. For multiple-span bridges give complete information on each span including approach spans. Indicate on leg sheet the odometer reading, position, and angle of skew of structure with respect to center line of road and by arrow the direction of stream flow.

3. Give information on the span over the highway only.

4. For span length use center to center of bearings, otherwise the clear opening. Skew bridges will be measured along center line of road. See Note 1.

5. Show general type such as: Trestle, Truss, Girder, I-Beam, Rigid Frame, Arch, Slab, Suspension, or Covered Bridge. See illustrations attached. Describe draw spans by classifications listed in Article X, Section 2 of Manual.

6. The length of a bridge structure is the over-all length measured along the line of survey stationing back to back of back-walls of abutments, if present, otherwise end to end of bridge floor, but in no case less than the total clear opening of the structure.

7. Give minimum lateral clearance. Where traffic lanes are separated by bridge numbers, show clearance width of each lane separately. Special conditions should be explained by notes.

8. In case of overhead bracing or arch construction, measurement shall be made to the lowest point above the road surface.

9. Use classification listed on RR crossing sheet. Form 4 HPS.

Remarks: _____

A rearrangement of the form similar to that shown on the attachment may be used to provide space for coding.

90-9

SHA 51.3 - 8 Revised
4.83

MARYLAND STATE HIGHWAY ADMINISTRATION

ROAD INVENTORY SHEET

Party Chief F. SETHAN
Recorder J. LANDON
Assistant ~~R.W. HEN~~ (12-21-90) JEL
Map No./Dir. GH21/SE
State Coordinates 283-115

Road No. CO 102
Road Name Stagg Rd.
County Worcester
Date 12-7-65
Sheet No. 1 OF 2

TRAFFIC CODES
TRAFFIC CONTROLS: STOP SIGN=SS, TRAFFIC LIGHT=T.L., FLASHING RED BALL=F.R.

TRAFFIC CODES
PARKING RESTRICTIONS: A.M. PEAK, P.M. PEAK, A.M./P.M. PEAK, NO PARKING ANYTIME=N.P., COMM/IND. ACCESS=E

SYSTEM				TRAFFIC		LINE DIAGRAM	TRAFFIC			PAVEMENT DATA
FED. AID.	FUNCT CLASS.	HWY. SYS.	HPMS SAMPLE	PRKG. REST.	COM/IND. ACCESS		CONTROL	COM/IND. ACCESS	PRKG. REST.	
										16' F
										24' CW
						0.50				X
						0.43 36" CMP				
										18' I
										24' CW
						0.35 15°J				
						0.30				X
						0.20 20°J				X (91-8)
										20' I
										~~16' F~~
										24' CW
						PAW PAW Creek Road				
						CO 0.00 100				

NON FIA
Rural Local

SYSTEM				TRAFFIC		LINE DIAGRAM	TRAFFIC			PAVEMENT DATA
FED. AID.	FUNCT. CLASS.	HWY. SYS.	HPMS SAMPLE	PRK'G. REST.	COM/IND ACCESS		CONTROL	COM/IND ACCESS	PRK'G. REST.	
						Bayside Road				
						Co 135 101				
										(41-9)
										20' I
										~~16' F~~
						093 18" CMP				24' CW
						080 12" CP				
						071				
						060				X

NOV F/A Rural Local

Form 6 HPS (Rev. 1961)

ROAD INVENTORY SHEET

Party Chief F. SETTAN
Recorder T. LANDON
Chainman

SNOW HILL LANDING
T. LANDON
F. RHODES
VERIFIED
PUBLIC 4/20/67

Road No. Co 103
Name (PUBLIC LANDING WHARF RD)
Sheet No. 1 OF 1
Date 12-8-65
County WORCESTER

8/11

	ROAD END		
	027		
B-SEAFOOD H	025		
	022	H	
	021	H	
H	018	B-REST (SEASONAL)	
	017	4 S.C.	
H	013		
H	011	H	
(OUTTEN ROAD) Co. 104	009		18'I 16'B 22'CW
	005	END PARKING AREA	
H	003		
MD. 365	000	BEG. PARKING AREA	

NE

CHINCOTEAGUE BAY

Form 6 HPS (Rev. 1961)

ROAD INVENTORY SHEET

Party Chief F. SETTAN
Recorder T. LANDON
Chainman

T. LANDON
F. RHODES
VERIFIED
4/20/77.
PUBLIC LANDING

Road No. Co 104
Name (CUTTEN RD)
Sheet No. 1 OF 1
Date 12-8-45
County WORCESTER

MD.	0	20	365	↑
	0	16	12" CP	
	0	12	PT 90°	↑
	0	10	H PC	↑
NW ↑	0	08	H	
	0	07	H·75'·H	
	~~0~~	~~01~~	~~H~~	14'F 20'CW
(PUBLIC LANDING WHARF		ROAD		
CO.	0	00	103	↓

Form 6 HPS (Rev. 1961)

1274-178

ROAD INVENTORY SHEET

Party Chief F. SETTAN
Recorder T. LANDON
Chainman

T. LANDON
F. RHODES
VERIFIED
4/15/77

Road No. Co 105
Name SANDYFIELD RD
Sheet No. 1 OF 1
Date 12-16-65
County WORCESTER

02-10 A/T

(NINE PIN BRANCH Co.	1 60	ROAD) 131	↑
	1 52		12" CP
↑15° H	1 20		
	0 90	H	
	0 80	PT	
		~~30~~	
	0 74	F 50°	
	0 67	PC	
#W00404			
S ↑ NINEPIN	0 61	BRANCH SEE BR. SH. 1-A	16'G 26'CW
MD	0 00	374	✓

Form HPS 5

STATE HIGHWAY ADMINISTRATION OF MARYLAND

IN COOPERATION WITH
FEDERAL HIGHWAY ADMINISTRATION

BRIDGE SHEET

ROAD NO. 3105

SHEET NO. 1-A

PARTY NO. _____

DATE 12/21/81

COUNTY WORCESTER

RATED CAPACITY 18 Tons (Inventory)

FOR ALL STRUCTURES HAVING A TOTAL OPENING OF MORE THAN 20 FEET AS DEFINED IN NOTE 1.

ODOMETER READING 0.61 NAME OF STREAM, RAILROAD OR HIGHWAY CROSSED Ninepin Branch (Sandyfield Road)

NUMBER OF RAILROAD TRACKS _____

KIND OF CROSSING (NOTE 2) Bridge over Stream

UNDERPASS-SIMPLE UNDERPASS-COMBINED (NOTE 3) OVERPASS BRIDGE OVER SYSTEM

DESCRIPTION

NUMBER OF SPANS	LENGTH EACH SPAN (NOTE 4)	TYPE (NOTE 5)
2	11'0", 11'0", 11'0"	Timber

TOTAL LENGTH-ON LINE OF ROAD OVER-ALL (NOTE 6) 33'0"

MATERIAL

SUBSTRUCTURE Creosoted Timber SUPERSTRUCTURE Creosoted Timber

FLOOR

CLEARANCES

ROADWAY (NOTE 7) 20.0' SIDEWALK WIDTHS: RIGHT LEFT

SURFACE OF ROAD TO STREAM BED 13'0" FOR OVERPASSES, SHOW DISTANCES TO TOP OF RAIL OR SURFACE OF LOWER ROAD. (NOTE 8)

SURFACE OF ROAD TO BOTTOM PORTAL _____ (MINIMUM OVERHEAD CLEARANCE

CLEAR DISTANCE OF OPENING ABOVE STREAM BED _____ (WATERWAYS ONLY)

POSTED LOAD LIMITS _____ BRIDGE NO. WO-0404 CONSTRUCTION DATE 9/81

GENERAL CONDITION OF BRIDGE: CHECK IF GOOD, FAIR, OR POOR, DESCRIBE DEFECTS IF SERIOUS.

	GOOD	FAIR	POOR
SUPERSTRUCTURE	Good		
FLOOR	Good		
SUBSTRUCTURE	Good		

PAINT BADLY CORRODED OR RUSTED

TYPE OF PROTECTION FOR DRAWBRIDGES _____

SHA 51.3 - 22
10-1-73

(NOTES ON REVERSE SIDE)

Notes:

1. In agreement with Federal-aid standards, a bridge is defined as a structure including supports erected over a depression or an obstruction, as water, highway, or railway, and having a track or passageway for carrying traffic or other moving loads, and having a length measured along the center of roadway of more than 20 feet between undercoping of abutments or spring lines of arches, or extreme ends of openings for multiple boxes and pipes, where the clear distance between openings is less than half of the smaller contiguous opening.

2. Show kind of crossing by checking descriptive item applicable. For multiple-span bridges give complete information on each span including approach spans. Indicate on leg sheet the odometer reading, position, and angle of skew of structure with respect to center line of road and by arrow the direction of stream flow.

3. Give information on the span over the highway only.

4. For span length use center to center of bearings, otherwise the clear opening. Skew bridges will be measured along center line of road. (See note 1.)

5. Show general type such as: Trestle, Truss, Girder, I-Beam, Rigid Frame, Arch, Slab, Suspension, or Covered Bridge.

6. The length of a bridge structure is the over-all length measured along the line of survey stationing back to back of back-walls of abutments, if present, otherwise end to end of bridge floor, but in no case less than the total clear opening of the structure.

7. Give minimum lateral clearance. Where traffic lanes are separated by bridge members, show clearance width of each lane separately. Special conditions should be explained by notes.

8. In case of overhead bracing or arch construction, measurement shall be made to the lowest point above the road surface.

Remarks: _____

_____

SHA 51.3 - 8 Revised
4.83

MARYLAND STATE HIGHWAY ADMINISTRATION

ROAD INVENTORY SHEET

Party Chief _____
Recorder _____
Assistant _____
Map No./Dir. 1
State Coordinates _____

Road No. Co 106
Road Name (LEE RD)
County Worcester
Date _____
Sheet No. 1 OF 1

SYSTEM				TRAFFIC		LINE DIAGRAM	TRAFFIC			PAVEMENT DATA
FED. AID.	FUNCT CLASS.	HWY. SYS.	HPMS SAMPLE	PRK.G. REST.	COM/IND. ACCESS		CONTROL	COM/IND. ACCESS	PRK.G. REST.	
						Unassigned Now All OP 441 93-6 CO				

TRAFFIC CODES

TRAFFIC CONTROLS: STOP SIGN=SS, TRAFFIC LIGHT=T.L., FLASHING RED BALL=F.R.

TRAFFIC CODES

PARKING RESTRICTIONS: A.M. PEAK, P.M. PEAK, A.M./P.M. PEAK, NO PARKING ANYTIME=N.P., COMM/IND. ACCESS=E

SYSTEM				TRAFFIC		LINE DIAGRAM	TRAFFIC			PAVEMENT DATA
FED. AID.	FUNCT. CLASS.	HWY. SYS.	HPMS SAMPLE	PRKG. REST.	COM/IND ACCESS		CONTROL	COM/IND ACCESS	PRKG. REST.	

Form 6 HPS (Rev. 1961)

ROAD INVENTORY SHEET

THIRD 57

Party Chief F. SETTAN
Recorder T. LANDON
Chainman

T 129 - 179 T. LANDON SNOW HILL T. RHODES VERIFIED 4/29/77 PUBLIC LANDING

Road No. Co 107
Name ~~COSTEN RD~~
Sheet No. 1 OF 1
Date 12-8-65
County WORCESTER

71-12 Name/ch

	ROAD	END	
H	011		
	009	12" CP	
NW ↑ H	008		
S.C	006		16'F 20'CW
S.C.	005	H	
BAYSIDE		ROAD	
Co.	000	101	

Form 6 HPS (Rev. 1961)

1288-111

ROAD INVENTORY SHEET

Party Chief F. SETTAN
Recorder T. LANDON
Chainman

T. LANDON
F. RHOUES
VERIFIED 4/20/77

83-25
2/9/84
FR+NS

Road No. CO 108
Name FIGGS LANDING RD
Sheet No. 1 OF 1
Date 12-8-65
County WORCESTER

Form 6 HPS (Rev. 1961) 1282-116

ROAD INVENTORY SHEET

Party Chief F. SETTANI T. LANDON
Recorder T. LANDON F. RHODES
Chainman VERIFIED 4/29/77

Road No. Co 109
Name McCABES CORNER RD
Sheet No. 1 OF 2
Date 12-8-65
County WORCESTER

	2	11	25° ↑ 18" CMP
F	2	07	
	1	99	18" CP
H	1	87	
↑200°	1	72	
PT	1	39	
30°			
PC	1	35	
F 600'	1	30	
	1	18	PT
			40°
			PC
↑25°	1	13	
	1	09	
	0	99	15° ↑
F 700'	0	78	
↑20°	0	64	F
	0	57	PT
			35°
NW ↑	0	53	PC
			18' F
↑30°	0	31	24" CMP 28' CW
H PAW PAW CREEK			ROAD
CO.	0	00	100 ↓

SHA 51.3 - 8 Revised
4.83

MARYLAND STATE HIGHWAY ADMINISTRATION

ROAD INVENTORY SHEET

Party Chief _____
Recorder _____
Assistant rewritten 1/8/90 JB
Map No./Dir. /
State Coordinates _____

Road No. CO 109
Road Name McCABES Corner RD
County _____
Date 12-8-65
Sheet No. 2 OF 2

89-112

TRAFFIC CODES

TRAFFIC CONTROLS: STOP SIGN=SS, TRAFFIC LIGHT=T.L., FLASHING RED BALL=F.R.

TRAFFIC CODES

PARKING RESTRICTIONS: A.M. PEAK, P.M. PEAK, A.M./P.M. PEAK, NO PARKING ANYTIME=N.P., COMM/IND. ACCESS=E

SYSTEM				TRAFFIC		LINE DIAGRAM	TRAFFIC			PAVEMENT DATA
FED. AID.	FUNCT CLASS.	HWY. SYS.	HPMS SAMPLE	PRK.G. REST.	COM/IND. ACCESS		CONTROL	COM/IND. ACCESS	PRK.G. REST.	
						MO				
						290				
						365				
						45° 258				
						282 18" CP				
										19' I
						273 PT 30° PC				
						268				
						20° 247				
						240				
						15° 231				18' F 28' CW
						224 15°				
						15° 220				

SYSTEM				TRAFFIC		LINE DIAGRAM	TRAFFIC			PAVEMENT DATA
FED. AID.	FUNCT. CLASS.	HWY. SYS.	HPMS SAMPLE	PRK'G. REST.	COM/IND ACCESS		CONTROL	COM/IND ACCESS	PRK'G. REST.	

SHA 51.3-8
11-15-72

STATE HIGHWAY ADMINISTRATION OF MARYLAND

ROAD INVENTORY SHEET

Party Chief I. LANDON
Recorder F. RHODE
Helper _____

Map No. _____

Road No. CO. 110
Road Name SPENCE CHURCH RD.
Sheet No. 1 OF 1
Date 4/19/77
County WORCESTER.
State Coordinates 1285-124 88-277

SE ↑

PAW PAW CO.	0	27	CREEK RD. 100 ↑
CHURCH + CEM.	0	14	~~18'F~~ ~~24'CW~~
	0	11	~~88-277~~ 18'I
	0	01	75°↑ ~~16'F~~ 22'CW
MD.	000	365	↓

SHA 51.3-8
11-15-72

ROAD INVENTORY SHEET

Road No. _____
Road Name _____
Sheet No. _____
Date _____
County _____
State Coordinates _____

Form 6 HPS (Rev. 1961) 1277-127

ROAD INVENTORY SHEET

Party Chief F. SETTAN
Recorder T. LANDON
Chainman

T. LANDON
F. RHODES
VERIFIED
4/19/77

Road No. Co 111
Name SCOTLAND RD
Sheet No. 1 OF 2
Date 12-8-65
County WORCESTER

88-216

	1	14	PT	
			40°	
	1	10	PC	
↑20°	0	97		
	0	69	H	
				16' G
↑15°	0	63	2-24" CMP	22' CW
(DOUBLE BRIDGES RD.) CO. 114	0	42	HALL	X
H	0	41	CHURCH (DOUBLE BRIDGES ROAD)	
	0	35	CO. 117	
	0	31	H	
6 H	0	28	H	
	0	20		
H	0	14		
	0	11	H	
H	0	08		
NF ↑				88-216
H	0	04	365	18' I
				~~18' G~~
H	0	03		26' CW
	0	00		Y
(MT WESLEY (RD) CO. 116 MD)				

Form 6 HPS (Rev. 1961)

L

ROAD INVENTORY SHEET

Party Chief F. SETTAN
Recorder T. LANDON
Chainman

Road No. CO 111
Name
Sheet No. 2 OF 2
Date 12-8-65
County WORCESTER

(TAYLOR		ROAD)	
CO.	2	64	~~DOG~~ 317 ↑
	2	56	36" CMP
	2	45	12" CP
H	2	42	
	2	32	F
PT	1	95	
~~35°~~ 65°			
PC	1	93	
	1	92	PT
			70°
	1	88	PC
	1	60	18" CMP
PT	1	41	
60°			
PC	1	36	
			SAME

SHA 51.3 - 8 Revised
4.83

MARYLAND STATE HIGHWAY ADMINISTRATION

FCR 95

ROAD INVENTORY SHEET

Party Chief G.D.
Recorder A.H.
Assistant
Map No./Dir. K-18 / W
State Coordinates 1274 - 142

Road No. Co 112
Road Name CEDARTOWN RD
County WORCHESTER
Date 4/25/95
Sheet No. 1 OF 2

84-7

TRAFFIC CODES
TRAFFIC CONTROLS: STOP SIGN=S.S., TRAFFIC LIGHT=T.L., FLASHING RED BALL=F.R.

TRAFFIC CODES
PARKING RESTRICTIONS: A.M. PEAK, P.M. PEAK, A.M./P.M. PEAK, NO PARKING ANYTIME=N.P., COMM/IND. ACCESS=E

SYSTEM				TRAFFIC		LINE DIAGRAM	TRAFFIC			PAVEMENT DATA
FED. AID.	FUNCT CLASS.	HWY. SYS.	HPMS SAMPLE	PARKG. REST.	COM/IND. ACCESS		CONTROL	COM/IND. ACCESS	PARKG. REST.	
	Rural Local					DOUBLE BRIDGES RD				
						CO PT 114 2 82				
						30°				
						PC 2 46				
						2 35 PT				
						30°				
						2 10 PC				
						BASKETSWITCH RD				
						1 22 CO 113				
										22'I
										2ML
	Rural Minor Collector *					TAYLOR RD				
						CO 317 0 93	55		*	
										18'6
										2UML
	Rural Local *					0 00 SIGN: END COUNTY MAINT.			✓	
						Road end				

LINE DIAGRAM

SYSTEM				TRAFFIC			TRAFFIC				PAVEMENT DATA
FED. AID.	FUNCT. CLASS.	HWY. SYS.	HPMS SAMPLE	PRKG. REST.	COM/IND ACCESS		CONTROL	COM/IND ACCESS	PRKG. REST.		
	Rural Local							E			

(WORCESTER		HWY)
US	4 06	113
(R/R)	3 72	
	3 76	# MDDE 531 849 L
	3 73	
	3 66	36" CMP
	3 60	(R/R)

22'I
0 ML

SHA 51.3 - 8 Revised
4.83

FCR 95

MARYLAND STATE HIGHWAY ADMINISTRATION

ROAD INVENTORY SHEET

Party Chief: G. DAVIS
Recorder: A. HATTEN
Assistant:
Map No./Dir.: K-18 / NE
State Coordinates: 1287 - 137

Road No.: CO 113
Road Name: BASKET SWITCH RD
County: TALBOT
Date: 4/25/95
Sheet No.: 1 OF 3

88-220
87-220
84-8

TRAFFIC CODES
TRAFFIC CONTROLS: STOP SIGN=SS, TRAFFIC LIGHT=T.L., FLASHING RED BALL=F.R.

PARKING RESTRICTIONS: A.M. PEAK, P.M. PEAK, A.M./P.M. PEAK, NO PARKING ANYTIME=N.P., COMM/IND. ACCESS=E

SYSTEM: FED. AID.	SYSTEM: FUNCT CLASS.	SYSTEM: HWY. SYS.	SYSTEM: HPMS SAMPLE	TRAFFIC: PRKG. REST.	TRAFFIC: COM/IND. ACCESS	LINE DIAGRAM	TRAFFIC: CONTROL	TRAFFIC: COM/IND. ACCESS	TRAFFIC: PRKG. REST.	PAVEMENT DATA
						1 23 48" CMP				
	Collector					0 85 PT				
						60°				
						0 71 PC				
						HARMON LOG RD				
						0 67 GO TO				
	Minor					0 4C PT				
						30°				
						0 36 PC				
	Rural									16' I
										2 ML
						CEDARTOWN RD				
	↓					CO 0 00 112	55			↓

LINE DIAGRAM

SYSTEM: FED. AID. | FUNCT. CLASS. | HWY. SYS. | HPMS SAMPLE

FUNCT. CLASS: Rural Minor Collector

TRAFFIC: PRKG. REST. | COM/IND ACCESS

TRAFFIC: CONTROL | COM/IND ACCESS | PRKG. REST.

PAVEMENT DATA

PT
35°
PC

3 03

2 95

2 88 30°

2 74 30°

PT
45°
PC

2 38

2 18

2 10 PT
30°

2 64 PC

16' I
2 ML

SHA 51.3 - 8 Revised
4.83

MARYLAND STATE HIGHWAY ADMINISTRATION

ROAD INVENTORY SHEET

Party Chief: GD
Recorder: AH
Assistant:
Map No./Dir.: K-18 /
State Coordinates:

Road No.: Co 113
Road Name: BASKET SWITCH RD
County: WORCESTER
Date: 4/25/95
Sheet No.: 3 OF 3

TRAFFIC CODES
TRAFFIC CONTROLS: STOP SIGN=SS, TRAFFIC LIGHT=T.L., FLASHING RED BALL=F.R.

TRAFFIC CODES
PARKING RESTRICTIONS: A.M. PEAK, P.M. PEAK, A.M./P.M. PEAK, NO PARKING ANYTIME=N.P., COMM/IND. ACCESS=E

SYSTEM: FED. AID.	SYSTEM: FUNCT CLASS.	SYSTEM: HWY. SYS.	SYSTEM: HPMS SAMPLE	TRAFFIC: PRK.G. REST.	TRAFFIC: COM/IND. ACCESS	LINE DIAGRAM	TRAFFIC: CONTROL	TRAFFIC: COM/IND. ACCESS	TRAFFIC: PRK.G. REST.	PAVEMENT DATA
	↑					(WORCESTER HWY)				↑
						US 3 59 113				
						PT 3 57				
						45°				
						PC 3 55				
						CROSSBUCKS #MDPE 5318524				
						3 53 CROSSBUCKS				
						(NEWARK RD)				
						3 48 Co 319 30°				
						3 38 36" CMP				
						3 37 RXR				16'1
										0 ML
						3 30° 30°				
	Rural Minor Collector									

SYSTEM				TRAFFIC		LINE DIAGRAM	TRAFFIC				PAVEMENT DATA
FED. AID.	FUNCT. CLASS.	HWY. SYS.	HPMS SAMPLE	PRK'G. REST.	COM/IND ACCESS		CONTROL	COM/IND ACCESS	PRK'G. REST.		

Form 6 HPS (Rev. 1961) 1280-140

ROAD INVENTORY SHEET

Party Chief F. SETTAN
Recorder T. LANDON
Chairman

T. LANDON
F. RHODES
VERIFIED
4/19/77

Road No. Co 114
Name (DOUBLE BRIDGES RD)
Sheet No. 1 OF 2
Date 12-9-65
County WORCESTER

184	PC	
183	F	16'F 22'CW
176	~~+ 25°~~	X
168	WPC (L-17' X W-15' X D-4')	
#W00205 CAMPGROUND		
167	BRANCH PT 35° SEE BR SH 1-A	11'F 20'CW
166		X
165	PC	
153		
111		18" CMP
074	25° ↑	
065	PT 30° PC	
062		
060		DR.
053	PT 30° PC	14'E 20'CW
049		
037	ROAD	
000	112	

↑ 25° ↑ 15° ↑ 20°

↑ 20° CEDARTOWN Co.

S ↑

Form 6 HPS (Rev. 1961)

ROAD INVENTORY SHEET

Party Chief F. SETTAN
Recorder T. LANDON
Chainman

Road No. C0114
Name
Sheet No. 2 OF 2
Date 12-9-65
County WORCESTER

(SCOTLAND		ROAD)	
	Co.	III	
	2 42		
	2 32	3 ~~HT~~	
	2 22	H	
	2 09	H	
	2 01	H	
	1 97	H	
	1 94	H	
	1 92	H	
	1 90	H	
	1 87	PT	
		30°	SAME

Form 5-HPS (Revised 1961)

MARYLAND STATE ROADS COMMISSION
PLANNING AND PROGRAMMING DIVISION

S26130

IN COOPERATION WITH
U. S. BUREAU OF PUBLIC ROADS

BRIDGE SHEET

ROAD NO. Co 114

SHEET NO. 1-A

PARTY NO. _____

DATE 12-9-65

COUNTY DORCHESTER

RATED CAPACITY _____

FOR ALL STRUCTURES HAVING A TOTAL OPENING OF MORE THAN 20 FEET AS DEFINED IN NOTE 1.

ODOMETER READING 1.67 NAME OF STREAM, RAILROAD OR HIGHWAY CROSSED CAMPGROUND BRANCH

NUMBER OF RAILROAD TRACKS _____

KIND OF CROSSING (NOTE 2) _____

UNDERPASS-SIMPLE UNDERPASS-COMBINED (NOTE 3) OVERPASS BRIDGE OVER SYSTEM

DESCRIPTION

NUMBER OF SPANS	LENGTH EACH SPAN (NOTE 4)	TYPE (NOTE 5)
2	12'	WOOD-PILE

TOTAL LENGTH-ON LINE OF ROAD OVER-ALL (NOTE 6) 24'

MATERIAL

SUBSTRUCTURE WOOD SUPERSTRUCTURE WOOD

FLOOR WOOD

CLEARANCES

ROADWAY (NOTE 7) 15' SIDEWALK WIDTHS: RIGHT LEFT

SURFACE OF ROAD TO STREAM BED 5' FOR OVERPASSES, SHOW DISTANCES TO TOP OF RAIL OR SURFACE OF LOWER ROAD. (NOTE 8)

SURFACE OF ROAD TO BOTTOM PORTAL 2' (MINIMUM OVERHEAD CLEARANCE

CLEAR DISTANCE OF OPENING ABOVE STREAM BED 3' (WATERWAYS ONLY)

POSTED LOAD LIMITS _____ BRIDGE NO. 205 CONSTRUCTION DATE _____

GENERAL CONDITION OF BRIDGE: CHECK IF GOOD, FAIR, OR POOR, DESCRIBE DEFECTS IF SERIOUS.

	GOOD	FAIR	POOR
SUPERSTRUCTURE	✓		
FLOOR			
SUBSTRUCTURE	✓		

PAINT BADLY CORRODED OR RUSTED

TYPE OF PROTECTION FOR DRAINBRIDGES (NOTE 9) _____

(NOTES ON REVERSE SIDE)

S26130

Notes:

1. In agreement with Federal-aid standards, a bridge is defined as a structure including supports erected over a depression or an obstruction, as water, highway, or railway, and having a track or passageway for carrying traffic or other moving loads, and having a length measured along the center of roadway of more than 20 feet between undercoping of abutments or spring lines of arches, or extreme ends of openings for multiple boxes and pipes, where the clear distance between openings is less than half of the smaller contiguous opening.

2. Show kind of crossing by checking descriptive item applicable. For multiple-span bridges give complete information on each span including approach spans. Indicate on leg sheet the odometer reading, position, and angle of skew of structure with respect to center line of road and by arrow the direction of stream flow.

3. Give information on the span over the highway only.

4. For span length use center to center of bearings, otherwise the clear opening. Skew bridges will be measured along center line of road. See Note 1.

5. Show general type such as: Trestle, Truss, Girder, I-Beam, Rigid Frame, Arch, Slab, Suspension, or Covered Bridge. See illustrations attached. Describe draw spans by classifications listed in Article X, Section 2 of Manual.

6. The length of a bridge structure is the over-all length measured along the line of survey stationing back to back of back-walls of abutments, if present, otherwise end to end of bridge floor, but in no case less than the total clear opening of the structure.

7. Give minimum lateral clearance. Where traffic lanes are separated by bridge numbers, show clearance width of each lane separately. Special conditions should be explained by notes.

8. In case of overhead bracing or arch construction, measurement shall be made to the lowest point above the road surface.

9. Use classification listed on RR crossing sheet. Form 4 HPS.

Remarks: _____

A rearrangement of the form similar to that shown on the attachment may be used to provide space for coding.

SHA 51.3 - 8 Revised
4.83

MARYLAND STATE HIGHWAY ADMINISTRATION

ROAD INVENTORY SHEET

89-105
89-17

Party Chief F. Setton
Recorder J LANDON
Assistant (written 1/10/89 JR)
Map No./Dir. GH 24 / S
State Coordinates 1265 - 1741

Road No. CO 115
Road Name Brick Kiln Rd
County Worcester
Date 12-8-65
Sheet No. 1 OF 2

TRAFFIC CODES
TRAFFIC CONTROLS: STOP SIGN=SS, TRAFFIC LIGHT=T.L., FLASHING RED BALL=F.R.

TRAFFIC CODES
PARKING RESTRICTIONS: A.M. PEAK, P.M. PEAK, A.M./P.M. PEAK, NO PARKING ANYTIME=N.P., COMM/IND. ACCESS=E

SYSTEM				TRAFFIC		LINE DIAGRAM	TRAFFIC			PAVEMENT DATA
FED. AID.	FUNCT CLASS.	HWY. SYS.	HPMS SAMPLE	PRKG. REST.	COM/IND. ACCESS		CONTROL	COM/IND. ACCESS	PRKG. REST.	
	NON F/H Rural Local					0+37 89 15°				18' F
						0+57			X	
						PATTYS 0+71 1+89 CREEK			X	16' E 20' CW
						#40-0208				14' F 20' CW
						0+5608			X	
						(Worcester U.S. 0+4800 Hwy) 113			✓	20' I 30' CW 2 ML
						Worcester Co 66 T				20' I 30' 60 2 ML
						T——T—1/40—T——T			X	
						1/16 15°				18' I 26' 60 (83-15?)
						church 0+19				

~~3 of 3~~ 2072

SYSTEM				TRAFFIC		LINE DIAGRAM	TRAFFIC			PAVEMENT DATA
FED. AID.	FUNCT. CLASS.	HWY. SYS.	HPMS SAMPLE	PRKG. REST.	COM/IND ACCESS		CONTROL	COM/IND ACCESS	PRKG. REST.	

Form HPS 5

STATE HIGHWAY ADMINISTRATION OF MARYLAND

IN COOPERATION WITH
FEDERAL HIGHWAY ADMINISTRATION

BRIDGE SHEET

ROAD NO. 3115
SHEET NO. 1A
PARTY NO. _____
DATE 12/21/81
COUNTY WORCESTER

RATED CAPACITY 17 Tons (Inventory)

FOR ALL STRUCTURES HAVING A TOTAL OPENING OF MORE THAN 20 FEET AS DEFINED IN NOTE 1.

ODOMETER READING 1.89 NAME OF STREAM, RAILROAD OR HIGHWAY CROSSED Patty's Branch (Brick Kiln Road)

NUMBER OF RAILROAD TRACKS _____
KIND OF CROSSING (NOTE 2) Bridge over Stream

UNDERPASS-SIMPLE UNDERPASS-COMBINED (NOTE 3) OVERPASS BRIDGE OVER SYSTEM

DESCRIPTION

NUMBER OF SPANS	LENGTH EACH SPAN (NOTE 4)	TYPE (NOTE 5)
2	15'0", 14'0"	Timber

TOTAL LENGTH-ON LINE OF ROAD OVER-ALL (NOTE 6) 29'0"

MATERIAL

SUBSTRUCTURE Creosoted Timber SUPERSTRUCTURE Creosoted Timber

FLOOR

CLEARANCES

ROADWAY (NOTE 7) 15'8" SIDEWALK WIDTHS: RIGHT LEFT

SURFACE OF ROAD TO STREAM BED 10'0" FOR OVERPASSES, SHOW DISTANCES TO TOP OF RAIL OR SURFACE OF LOWER ROAD. (NOTE 8)

SURFACE OF ROAD TO BOTTOM PORTAL _____ (MINIMUM OVERHEAD CLEARANCE

CLEAR DISTANCE OF OPENING ABOVE STREAM BED _____ (WATERWAYS ONLY)

POSTED LOAD LIMITS _____ BRIDGE NO. WO-0208 CONSTRUCTION DATE 8/81

GENERAL CONDITION OF BRIDGE: CHECK IF GOOD, FAIR, OR POOR, DESCRIBE DEFECTS IF SERIOUS.

	GOOD	FAIR	POOR
SUPERSTRUCTURE	Good		
FLOOR	Good		
SUBSTRUCTURE	Good		
PAINT			BADLY CORRODED OR RUSTED

TYPE OF PROTECTION FOR DRAWBRIDGES _____

SHA 51.3 - 22
10-1-73

(NOTES ON REVERSE SIDE)

Notes:

1. In agreement with Federal-aid standards, a bridge is defined as a structure including supports erected over a depression or an obstruction, as water, highway, or railway, and having a track or passageway for carrying traffic or other moving loads, and having a length measured along the center of roadway of more than 20 feet between undercoping of abutments or spring lines of arches, or extreme ends of openings for multiple boxes and pipes, where the clear distance between openings is less than half of the smaller contiguous opening.

2. Show kind of crossing by checking descriptive item applicable. For multiple-span bridges give complete information on each span including approach spans. Indicate on leg sheet the odometer reading, position, and angle of skew of structure with respect to center line of road and by arrow the direction of stream flow.

3. Give information on the span over the highway only.

4. For span length use center to center of bearings, otherwise the clear opening. Skew bridges will be measured along center line of road. (See note 1.)

5. Show general type such as: Trestle, Truss, Girder, I-Beam, Rigid Frame, Arch, Slab, Suspension, or Covered Bridge.

6. The length of a bridge structure is the over-all length measured along the line of survey stationing back to back of back-walls of abutments, if present, otherwise end to end of bridge floor, but in no case less than the total clear opening of the structure.

7. Give minimum lateral clearance. Where traffic lanes are separated by bridge members, show clearance width of each lane separately. Special conditions should be explained by notes.

8. In case of overhead bracing or arch construction, measurement shall be made to the lowest point above the road surface.

Remarks: _____

_____

Form 6 HPS (Rev. 1961)

ROAD INVENTORY SHEET

Party Chief F. SETTAN
Recorder T. LANDON
Chainman

1275 - 127
T. LANDON
F. RHODES
VERIFIED
4/19/77

Road No. CO 116
Name (MT. WESLEY RD)
Sheet No. 1 OF 1
Date 12-8-65
County WORCESTER

SCOTLAND ROAD
CO. 111

345

0 29

N

END CEM 0 23

NE

BEG CEM 0 17

16'F
22'CW

PT 45°
PC

H 0 07

345

0 02

0 00

MD

Form 6 HPS (Rev. 1961)

ROAD INVENTORY SHEET

Party Chief F. SETTAN
Recorder T. LANDON
Chainman

1278-127
T. LANDON
F. RHODES
VERIFIED
4/19/77

Road No. Co 117
Name (DOUBLE BRIDGES RD
Sheet No. 10F1
Date 12-9-65
County WORCESTER

88-215

S ↑	1110		
		026	↑
		365	
	H	014	88-215
			18'I
		010	12"CP ~~18'I~~ 28'OW
	(SCOTLAND	ROAD)	
	Co.	060 111	↓

SHA 51.3-8
11-15-72

STATE HIGHWAY ADMINISTRATION OF MARYLAND

ROAD INVENTORY SHEET

Party Chief _____
Recorder _____
Helper C. MARTIN

Map No. GH 24

Road No. CO 118
Road Name WALLACE ~~LANE~~ DR
Sheet No. 1 OF 1
Date 9-17-74
County WORCESTER
State Coordinates 1265 - 133

4/19/77 VERIFIED

HALLETT HEIGHTS

DR
3 18
STAFFFEE
CO

NW

PT
180°
7 H
PC

125°

0 15
0 12
0 07
0 03
0 00

3 H

20'F
30'CW

~~US 113~~ US
SNOW HILL Market

113 Bu ~~113~~ ~~394~~
ST.

SHA 51.3-8
11-15-72

ROAD INVENTORY SHEET

Road No. _____
Road Name _____
Sheet No. _____
Date _____
County _____
State Coordinates _____

85-35 BB AL

SHA 51.3 - 8 Revised 4.83

MARYLAND STATE HIGHWAY ADMINISTRATION

ROAD INVENTORY SHEET

Party Chief F. SETIAN
Recorder T LANDON
Assistant REWRITTEN 1-5-89 JE
Map No./Dir. GH 24 / SE
State Coordinates 1268 - 165

Road No. CO 119
Road Name TIMMONS RD
County WORCESTER
Date 12-9-65
Sheet No. 1 OF 1

89 - 111
88-227

TRAFFIC CODES
TRAFFIC CONTROLS: STOP SIGN=SS, TRAFFIC LIGHT=T.L., FLASHING RED BALL=F.R.

TRAFFIC CODES
PARKING RESTRICTIONS: A.M. PEAK, P.M. PEAK, A.M./P.M. PEAK, NO PARKING ANYTIME=N.P., COMM/IND. ACCESS=E

SYSTEM				TRAFFIC		LINE DIAGRAM	TRAFFIC			PAVEMENT DATA
FED. AID.	FUNCT CLASS.	HWY. SYS.	HPMS SAMPLE	PRK.G. REST.	COM/IND. ACCESS		CONTROL	COM/IND. ACCESS	PRK.G. REST.	
						ROAD 1 11 END				
						PT 0 70				
						35°				
						PC 0 64				
						0 42 80°				
						BLAKE RD 399 CO				
						0 22				20'F 22 c-w
						MDDE 0 21 531 848 E				
						0 18 (RXR)				~~18'F~~
						0 05				88-227 22'I
						US 0 00 113				

SYSTEM				TRAFFIC		LINE DIAGRAM	TRAFFIC				PAVEMENT DATA
FED. AID.	FUNCT. CLASS.	HWY. SYS.	HPMS SAMPLE	PRKG. REST.	COM/IND ACCESS		CONTROL	COM/IND ACCESS	PRKG. REST.		

Form 6 HPS (Rev. 1961)

1277 148

86-4 BB
2-18-87 TM

ROAD INVENTORY SHEET

Party Chief F. SETTAN
Recorder T. LANDON
Chainman

T. LANDON
F. RHODES
VERIFIED 4/15/77

BB 4-9
RM 2-18-85

Road No. CO 120
Name FIVE MILE BRANCH RD.
Sheet No. 1 OF 2
Date 12-15-65
County WORCESTER

	PT	1 52	
	~~50~~		
	45° F 800'	1 51	
	PC	1 48	
	PVT. RD		
	F 0.26 12'D	1 37	~~TBG~~
	#W0401		~~22'CW~~
	COONFOOT	093	BRANCH 15°
			SEE BR. SH. 1-A
	PVT RD		
	15° F 0.29 10'D	085	
		062	PT
			30°
		059	F
		052	PC
		045	18" CP
N		025	M
			20'T
	F	014	~~14'~~
			~~X-H-S~~
		009	36" CMP 22'CW
	US	000	113

Form 6 HPS (Rev. 1961)

ROAD INVENTORY SHEET

Party Chief F. SETTAN
Recorder T. LANDAU
Chainman

Road No. Co 120
Name
Sheet No. 2 OF 2
Date 12-15-65
County WORCESTER

(QUEPONCA ROAD)

Co. 2 82 123

~~2 69~~ (91-23) 18' I

PT 2 39 ~~16~~ 22' CW

60° 63 PI 43 R
45° 0 0 10'0 2 37

PC 2 36

2 16

F 2 12

1 83 PT 18' I

45° F700'

1 82 ~~16~~ 22' CW

1 81 PC

1 68

1 57 18" CMP

SAME

Form HPS 5

STATE HIGHWAY ADMINISTRATION OF MARYLAND

IN COOPERATION WITH
FEDERAL HIGHWAY ADMINISTRATION

BRIDGE SHEET

ROAD NO. 0120

73-15

RECONSTRUCTION OF EXISTING BRIDGE

SHEET NO. _____

PARTY NO. _____

DATE 11/30/73

COUNTY Worcester

RATED CAPACITY _____

FOR ALL STRUCTURES HAVING A TOTAL OPENING OF MORE THAN 20 FEET AS DEFINED IN NOTE 1.

ODOMETER READING 0.93 NAME OF STREAM, RAILROAD OR HIGHWAY CROSSED ~~Five Mile Branch~~ COONFOOT BRANCH

NUMBER OF RAILROAD TRACKS _____

KIND OF CROSSING (NOTE 2) Bridge Over Stream

UNDERPASS-SIMPLE UNDERPASS-COMBINED (NOTE 3) OVERPASS BRIDGE OVER SYSTEM

DESCRIPTION

NUMBER OF SPANS	LENGTH EACH SPAN (NOTE 4)	TYPE (NOTE 5)
3	11.0', 11.0', 11.0'	Girder

TOTAL LENGTH-ON LINE OF ROAD OVER-ALL (NOTE 6) 34.0'

MATERIAL

SUBSTRUCTURE Creosoted Timber SUPERSTRUCTURE Creosoted Timber

FLOOR WOOD

CLEARANCES

ROADWAY (NOTE 7) 20' SIDEWALK WIDTHS: RIGHT None LEFT None

SURFACE OF ROAD TO STREAM BED 9'-3" FOR OVERPASSES, SHOW DISTANCES TO TOP OF RAIL OR SURFACE OF LOWER ROAD. (NOTE 8)

SURFACE OF ROAD TO BOTTOM PORTAL _____ (MINIMUM OVERHEAD CLEARANCE

CLEAR DISTANCE OF OPENING ABOVE STREAM BED 7' (WATERWAYS ONLY)

POSTED LOAD LIMITS _____ BRIDGE NO. 401 CONSTRUCTION DATE _____

GENERAL CONDITION OF BRIDGE: CHECK IF GOOD, FAIR, OR POOR, DESCRIBE DEFECTS IF SERIOUS.

	GOOD X	FAIR	POOR
SUPERSTRUCTURE	Good		
FLOOR	Good		
SUBSTRUCTURE	Good		

PAINT BADLY CORRODED OR RUSTED

TYPE OF PROTECTION FOR DRAWBRIDGES _____

SHA 51.3 - 22
10-1-73

(NOTES ON REVERSE SIDE)

Notes:

1. In agreement with Federal-aid standards, a bridge is defined as a structure including supports erected over a depression or an obstruction, as water, highway, or railway, and having a track or passageway for carrying traffic or other moving loads, and having a length measured along the center of roadway of more than 20 feet between undercoping of abutments or spring lines of arches, or extreme ends of openings for multiple boxes and pipes, where the clear distance between openings is less than half of the smaller contiguous opening.

2. Show kind of crossing by checking descriptive item applicable. For multiple-span bridges give complete information on each span including approach spans. Indicate on leg sheet the odometer reading, position, and angle of skew of structure with respect to center line of road and by arrow the direction of stream flow.

3. Give information on the span over the highway only.

4. For span length use center to center of bearings, otherwise the clear opening. Skew bridges will be measured along center line of road. (See note 1.)

5. Show general type such as: Trestle, Truss, Girder, I-Beam, Rigid Frame, Arch, Slab, Suspension, or Covered Bridge.

6. The length of a bridge structure is the over-all length measured along the line of survey stationing back to back of back-walls of abutments, if present, otherwise end to end of bridge floor, but in no case less than the total clear opening of the structure.

7. Give minimum lateral clearance. Where traffic lanes are separated by bridge members, show clearance width of each lane separately. Special conditions should be explained by notes.

8. In case of overhead bracing or arch construction, measurement shall be made to the lowest point above the road surface.

Remarks: _____

_____

Form 6 HPS (Rev. 1961)

X

4

ROAD INVENTORY SHEET

Party Chief F. SETTAN
Recorder T. LANDON
Chainman

ROAD 139
T. LANDON
F. RHODES
VERIFIED
4/19/77

Road No. Co 121
Name (HARMON LANDING RD)
Sheet No. 1 OF 1
Date 12-9-65
County WORCESTER

CHINCOTEAGUE BAY

	ROAD	END	
H 500'	1 93	← 011 → H	
↑ 15°	1 42		20° ↑
	1 30		
F	1 35		
	0 57		DR
	0 51		15° ↑
↑ PT	0 47		
30°			
PC	0 42		
E ↑	0 34	PT ↑	
		30°	
	0 29	PC	
			16' F
S H ↑ 15°	0 15	~~US 113~~	DR. 22' CW
BASKET SWITCH	0 07	~~ROAD~~ RD.	30° ↑
Co.	0 00	113	

SHA 51.3-8
11-15-72

STATE HIGHWAY ADMINISTRATION OF MARYLAND

ROAD INVENTORY SHEET

Newark RD (89-27)

Party Chief _____
Recorder _____
Helper C. MARTIN

Map No. GH 24

Road No. CO 122
Road Name ~~(BOWEN RD)~~
Sheet No. 1 OF 1
Date 9-17-74
County WORCESTER
State Coordinates 1285 - 15X

4/18

87-51

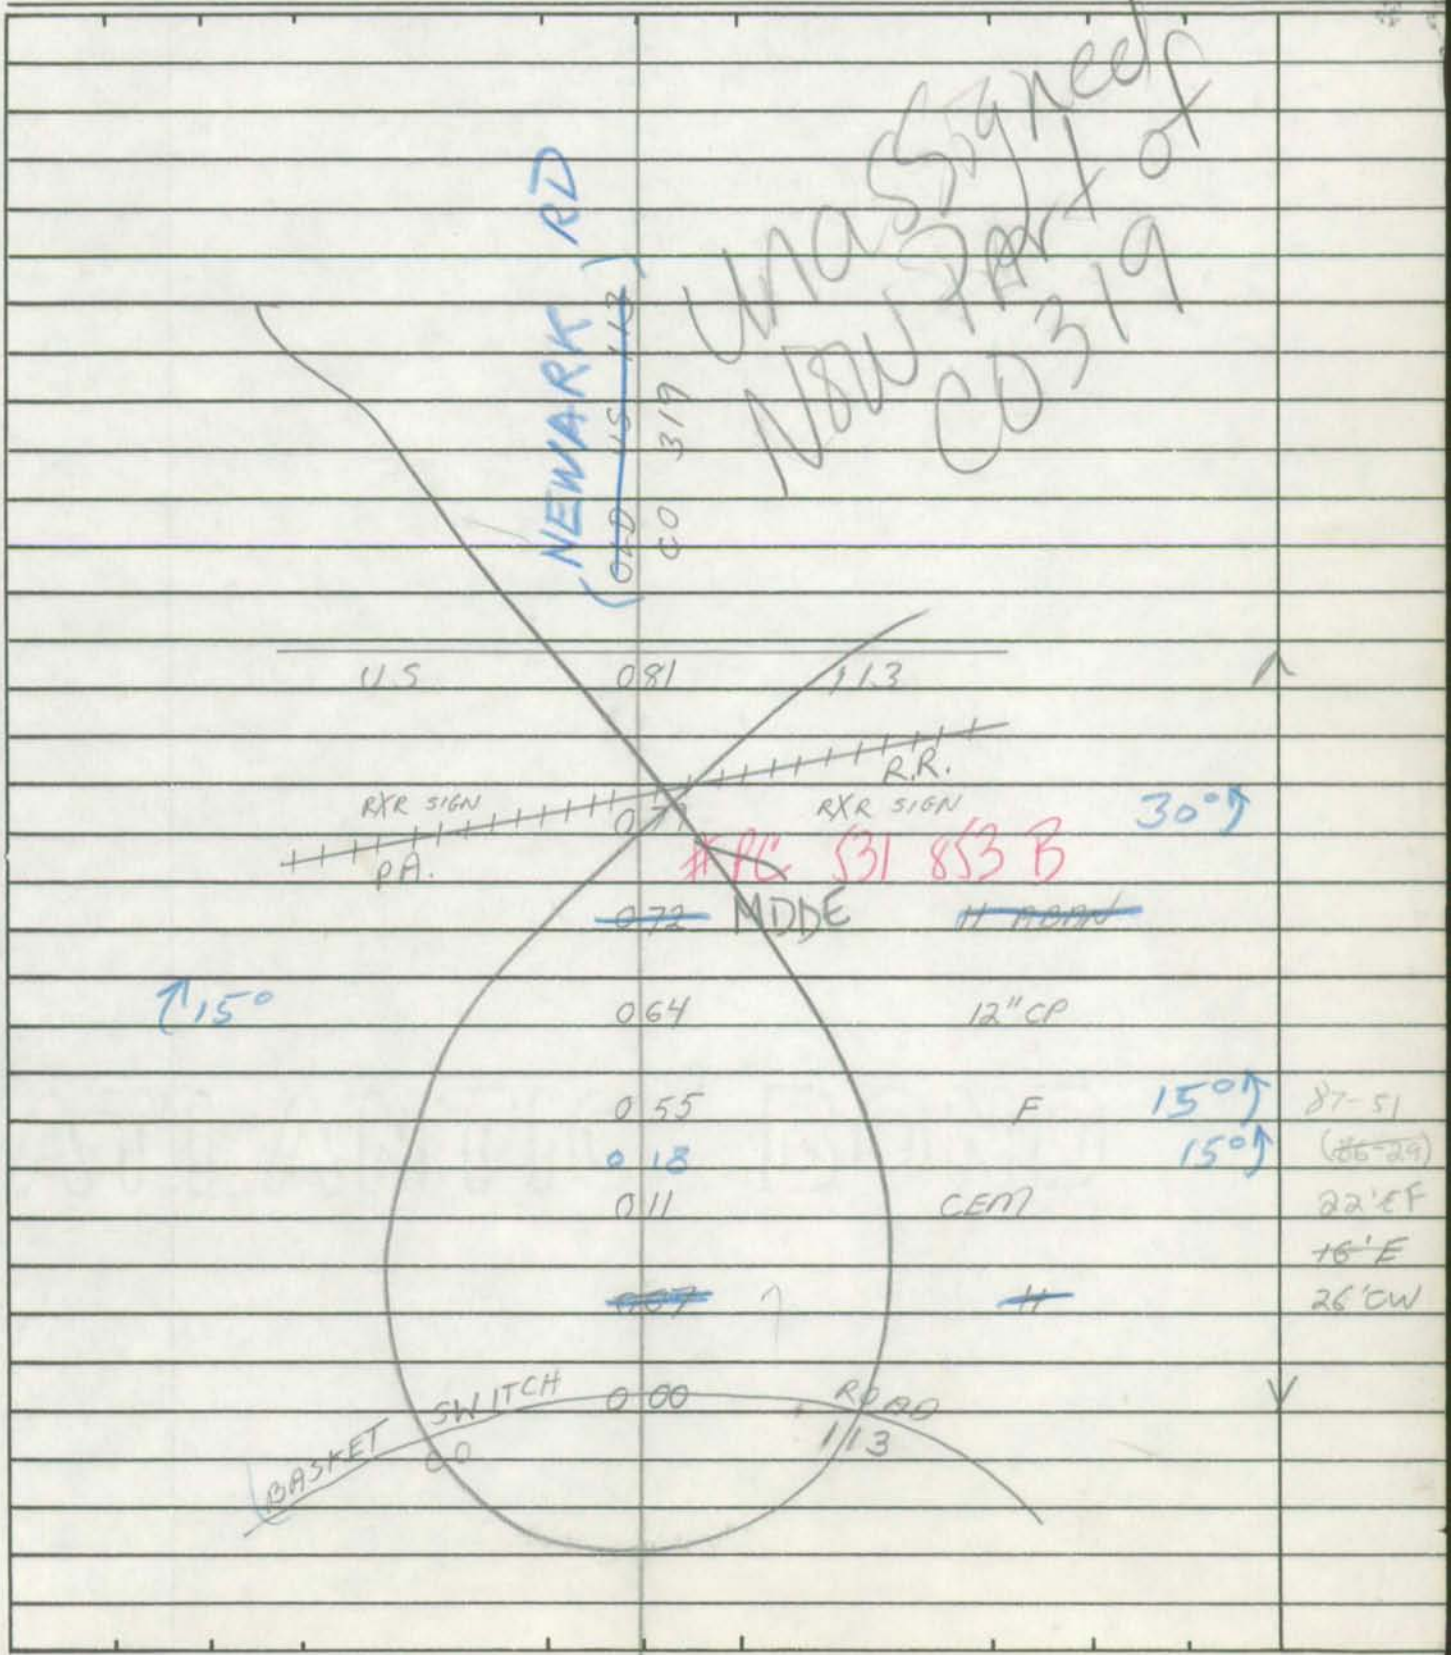

SHA 51.3-8
11-15-72

ROAD INVENTORY SHEET

Road No. _____
Road Name _____
Sheet No. _____
Date _____
County _____
State Coordinates _____

Form 6 HPS (Rev. 1961)

(85-14) BB/AL 1-23-86

73-11 CO. 2-2-94 BB/TM

ROAD INVENTORY SHEET

Party Chief F. SUTTAN
Recorder T. LANDON
Chainman

1288-157
T. LANDON
F. RHODES
VERIFIED
4/15/77

89-178
AT

Road No. CO 123
Name (QUEPONCO RD)
Sheet No. 1 OF 3
Date 12-15-45
County WORCESTER

↑20° F	2	85	
FIVE MILE BRANCH RD.			
CO. 120	2	78	
F 700'	2	57	
	2	52	H
PVT RD 0 / 12'D 36 H	2	26	
	1	98	48" CMP
↑15° HT	1	96	
	1	92	HT
↑15° H	1	71	24" CP
51 / 0 PVT RD / 12'D	1	52	
	1	35	12" CP
↑20° F 400'	1	34	
NW ↑			
	1	26	F 800'
	1	14	*
~~H 150' H~~	0	96	H
(NEWARK	0	82	RD.) 2-18" CMP
~~(OLD US 113)~~			~~THRU NEWARK~~
CO.	0	00	~~113~~ 31 SS

~~(80')~~
~~20'I~~
~~18'C~~
~~30'LW~~
20'I
~~18'C~~
~~30'CW~~
~~1-3'SHLD~~
2 ML

Form 6 HPS (Rev. 1961)

ROAD INVENTORY SHEET

Party Chief F. SETTAN
Recorder T. LANDAN
Chainman

Road No. C0123
Name
Sheet No. 2 OF 3
Date 12-15-65
County WORCESTER

(LT 22)

	377	H	
	372	PT 40°	
	359	PC F400'	X 20'I 2 ML
#W00402			
OLD MILL	356	BRANCH SEE BR. SH. 1-A	
			20'F 2 UML
PT 50° PC	354		
	352		X
	350		
PT 30° PC F1000'	347		
	333		
	327	18" CMP	
H	325		
	313	H	20'
	305	PT 30°	
	303	F 900'	
	300	H PC	20'I 2 ML
	287	18" CMP	

Form 6 HPS (Rev. 1961)

L

ROAD INVENTORY SHEET

Party Chief F. SETTAN
Recorder T. LANDON
Chainman

Road No. CO 123
Name
Sheet No. 3 OF 3
Date 12-15-65
County WORCHESTER

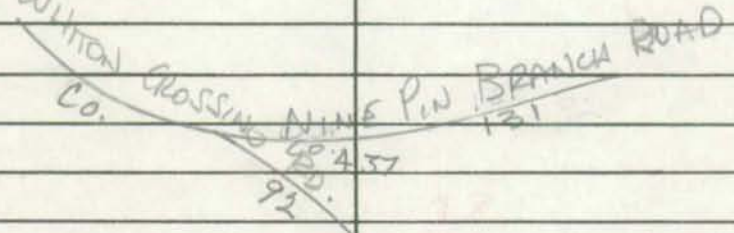

20' I
(91+22)
2 ML
STAND

Form 5-HPS
(Revised 1961)

MARYLAND STATE ROADS COMMISSION
PLANNING AND PROGRAMMING DIVISION

S26130

IN COOPERATION WITH
U.S. BUREAU OF PUBLIC ROADS

ROAD NO. C0123

BRIDGE SHEET

SHEET NO. 1-A

PARTY NO. _____

DATE 12-2-69

COUNTY Worcester

RATED CAPACITY _____

FOR ALL STRUCTURES HAVING A TOTAL OPENING OF MORE THAN 20 FEET AS DEFINED IN NOTE 1.

ODOMETER READING 3.56 NAME OF STREAM, RAILROAD OR HIGHWAY CROSSED ~~Queponco Rd.~~ OLD MILL BRANCH

NUMBER OF RAILROAD TRACKS _____

KIND OF CROSSING (NOTE 2) Bridge Over Stream

UNDERPASS-SIMPLE UNDERPASS-COMBINED (NOTE 3) OVERPASS BRIDGE OVER SYSTEM

DESCRIPTION

NUMBER OF SPANS	LENGTH EACH SPAN (NOTE 4)	TYPE (NOTE 5)
3	13.7' - 13.8' - 14.3'	Girder

TOTAL LENGTH-ON LINE OF ROAD OVER-ALL (NOTE 6) 43.5'

MATERIAL
SUBSTRUCTURE Creosoted Timber SUPERSTRUCTURE Creosoted Timber
FLOOR Wood.

CLEARANCES
ROADWAY (NOTE 7) 17.0' SIDEWALK WIDTHS: RIGHT None LEFT None
SURFACE OF ROAD TO STREAM BED 11.0' FOR OVERPASSES, SHOW DISTANCES TO TOP OF RAIL OR SURFACE OF LOWER ROAD. (NOTE 8)
SURFACE OF ROAD TO BOTTOM PORTAL _____ (MINIMUM OVERHEAD CLEARANCE
CLEAR DISTANCE OF OPENING ABOVE STREAM BED 9' (WATERWAYS ONLY)
POSTED LOAD LIMITS _____ BRIDGE NO. 102 CONSTRUCTION DATE 11-20-69

GENERAL CONDITION OF BRIDGE: CHECK IF GOOD, FAIR, OR POOR, DESCRIBE DEFECTS IF SERIOUS.

	GOOD X	FAIR	POOR
SUPERSTRUCTURE	Good		
FLOOR	Good		
SUBSTRUCTURE	Good		

PAINT BADLY CORRODED OR RUSTED

TYPE OF PROTECTION FOR DRAWBRIDGES (NOTE9) _____

(NOTES ON REVERSE SIDE)

S26130

Notes:

1. In agreement with Federal-aid standards, a bridge is defined as a structure including supports erected over a depression or an obstruction, as water, highway, or railway, and having a track or passageway for carrying traffic or other moving loads, and having a length measured along the center of roadway of more than 20 feet between undercoping of abutments or spring lines of arches, or extreme ends of openings for multiple boxes and pipes, where the clear distance between openings is less than half of the smaller contiguous opening.

2. Show kind of crossing by checking descriptive item applicable. For multiple-span bridges give complete information on each span including approach spans. Indicate on leg sheet the odometer reading, position, and angle of skew of structure with respect to center line of road and by ar w the direction of stream flow.

3. Give information on the span over the highway only.

4. For span length use center to center of bearings, otherwise the clear opening. Skew bridges will be measured along center line of road. See Note 1.

5. Show general type such as: Trestle, Truss, Girder, I-Beam, Rigid Frame, Arch, Slab, Suspension, or Covered Bridge. See illustrations attached. Describe draw spans by classifications listed in Article X, Section 2 of Manual.

6. The length of a bridge structure is the over-all length measured along the line of survey stationing back to back of back-walls of abutments, if present, otherwise end to end of bridge floor, but in no case less than the total clear opening of the structure.

7. Give minimum lateral clearance. Where traffic lanes are separated by bridge numbers, show clearance width of each lane separately. Special conditions should be explained by notes.

8. In case of overhead bracing or arch construction, measurement shall be made to the lowest point above the road surface.

9. Use classification listed on RR crossing sheets. Form 4 HPS.

Remarks: _____

A rearrangement of the form similar to that shown on the attachment may be used to provide space for coding.

SHA 51.3-8
11-15-72

STATE HIGHWAY ADMINISTRATION OF MARYLAND

ROAD INVENTORY SHEET

T. LANDON
F. RHODES
VERIFIED 4/19/77

Party Chief _____
Recorder _____
Helper C. MARTIN

Map No. GH 24

Road No. CO 124
Road Name PATEY WOODS RD
Sheet No. 1 OF 4
Date 10-1-74
County WORCESTER
State Coordinates 1291 - 157

H	0 28		
H 100' H	0 26		
H	0 25		
	0 23	F	
H	0 20		
H	0 18		
~~H(VAC)~~	0 16	24" CMP	
(RXR)	0 14		
B- ~~VAC~~ OFFICE	0 13		
	0 11	MDDE B-CANNERY #PC 531 857)	
1 MAIN & 1 SIDE	0 10	TRACK	
		(MILL STREET)	
	0 09	CO 126	
RXR SIGN	0 08	B- GAS & GROC	
H	0 06		
			16' G
NEWARK	0 05	RD. B-FEED (VAC)	24' CW
(~~OLD~~	0 03	~~US~~ 113) (RXR)	
CO	0 00	319	

NW ↑

SHA 51.3-8
11-15-72

ROAD INVENTORY SHEET

Road No. CO 124
Road Name PATEY WOODS RD
Sheet No. 2 OF 4
Date 10-1-74
County WORCESTER
State Coordinates

	1 85	12" CMP	
	1 75	12" CP	
↑20°	1 67	20°↑	
	1 50		
	1 42	12" CP 20°↑	
	1 16	12" CP	
↑PT	1 13		
30°			
PC	1 08		
			~~20'F~~
	1 00	12" CP	~~22' CM~~
↑15°	0 91		
	0 81	20°↑	
	0 68	20°↑	
H-ABAN	0 49		#
	0 46	H 20°↑	
SCHOOL ABAN	0 45	H	
	0 41	H	
↑25° H	0 39	~~H ABAN~~	
HALL (VAC)	0 37		
= CHURCH	0 35		
= PVT RD			
0 9'B	0 34		
H	0 33		SAME

SHA 51.3-8
11-15-72

STATE HIGHWAY ADMINISTRATION OF MARYLAND

ROAD INVENTORY SHEET

Party Chief _____
Recorder _____
Helper C. MARTIN

Map No. GH 24

Road No. CO 124
Road Name (PATEY WOODS RD)
Sheet No. 3 OF 4
Date 10-1-74
County WORCESTER
State Coordinates _____

↑PT 80° PC	327		
	323		
	319	PT ↑ 50° ~~35°~~	
	316	PC	
	304	18" CMP	~~18" F~~ ~~2 SE~~ ~~SE 100~~
	292		
	286	RD HT	
F	284	HT	
	278	132 30° ↑	
		BETHARDS CO	
		180° 60° ~~70°~~ ↑	
	272		
H	257		
F	250		
↑20° H	240		
	223	18" CMP	
↑30°	220		
OLD MILL	205	BRANCH SEE BR SH. 1-A	SAME

SHA 51.3-8
11-15-72

ROAD INVENTORY SHEET

Road No. CO 124
Road Name PATEY WOODS RD
Sheet No. 4 OF 4
Date 10-1-74
County WORCESTER
State Coordinates

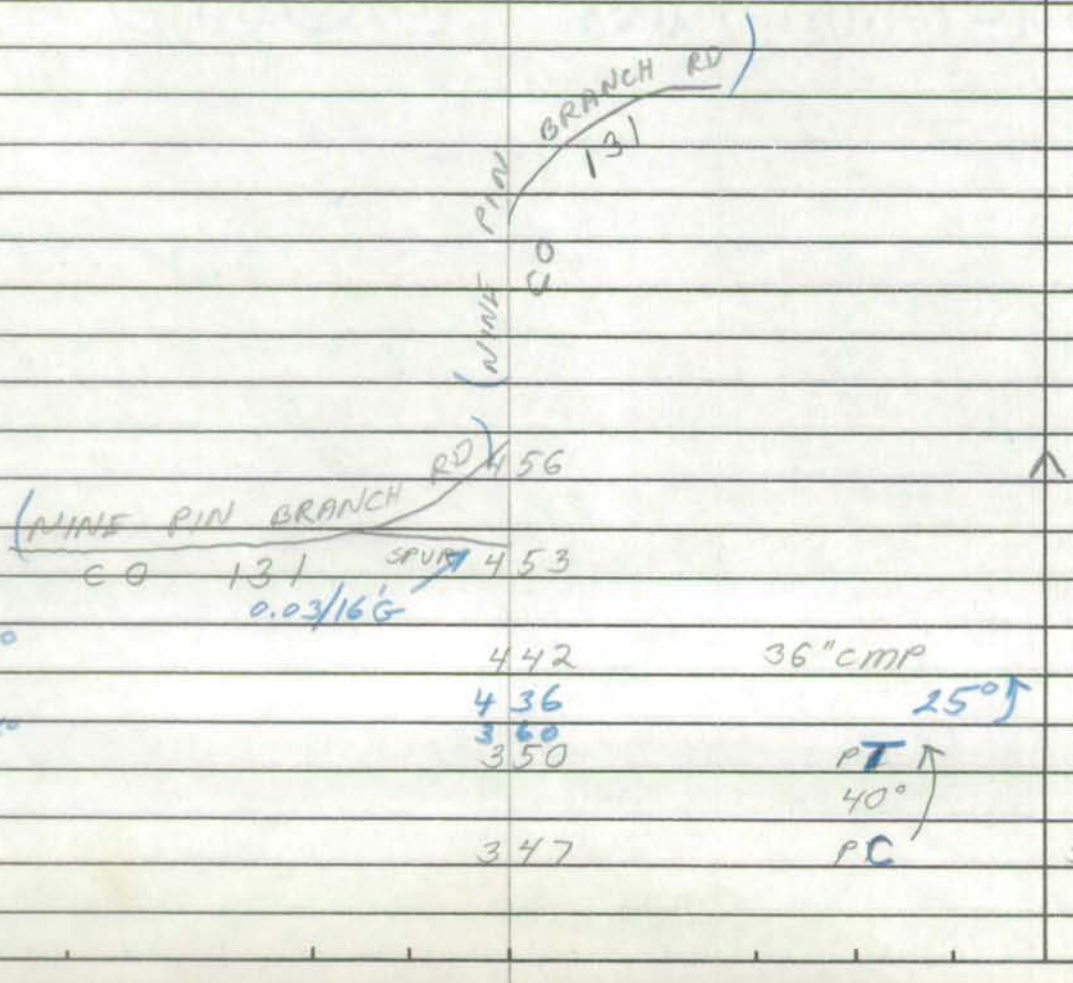

Form 5-HPS
(Revised 1971)

STATE HIGHWAY ADMINISTRATION OF MARYLAND
PLANNING AND PROGRAMMING DIVISION S26130
IN COOPERATION WITH
FEDERAL HIGHWAY ADMINISTRATION

BRIDGE SHEET

ROAD NO. 124
SHEET NO. _____
71-14 PARTY NO. _____
DATE 11-30-71
COUNTY _____

RATED CAPACITY _____

FOR ALL STRUCTURES HAVING A TOTAL OPENING OF MORE THAN 20 FEET AS DEFINED IN NOTE 1.

ODOMETER READING 2.05 NAME OF STREAM, RAILROAD OR HIGHWAY CROSSED Old Mill Branch

NUMBER OF RAILROAD TRACKS _____
KIND OF CROSSING (NOTE 2) Bridge Over Stream

UNDERPASS-SIMPLE UNDERPASS-COMBINED (NOTE 3) OVERPASS BRIDGE OVER SYSTEM

DESCRIPTION

NUMBER OF SPANS	LENGTH EACH SPAN (NOTE 4)	TYPE (NOTE 5)
2	9' - 3" Each	Girder

TOTAL LENGTH-ON LINE OF ROAD OVER-ALL (NOTE 6) 21'

MATERIAL
SUBSTRUCTURE Creosoted Timber SUPERSTRUCTURE Creosoted Timber
FLOOR WOOD

CLEARANCES
ROADWAY (NOTE 7) 18' SIDEWALK WIDTHS: RIGHT None LEFT None
SURFACE OF ROAD TO STREAM BED 4' - 2" FOR OVERPASSES, SHOW DISTANCES TO TOP OF RAIL OR SURFACE OF LOWER ROAD. (NOTE 8)
SURFACE OF ROAD TO BOTTOM PORTAL _____ (MINIMUM OVERHEAD CLEARANCE
CLEAR DISTANCE OF OPENING ABOVE STREAM BED 3' (WATERWAYS ONLY)
POSTED LOAD LIMITS _____ BRIDGE NO. _____ CONSTRUCTION DATE 12-18-70

GENERAL CONDITION OF BRIDGE: CHECK IF GOOD, FAIR, OR POOR, DESCRIBE DEFECTS IF SERIOUS.

	GOOD X	FAIR	POOR
SUPERSTRUCTURE	Good		
FLOOR	Good		
SUBSTRUCTURE	Good		

PAINT BADLY CORRODED OR RUSTED
TYPE OF PROTECTION FOR DRAWBRIDGES (NOTE 9) _____

(NOTES ON REVERSE SIDE)

S26130

Notes:

1. In agreement with Federal-aid standards, a bridge is defined as a structure including supports erected over a depression or an obstruction, as water, highway, or railway, and having a track or passageway for carrying traffic or other moving loads, and having a length measured along the center of roadway of more than 20 feet between undercoping of abutments or spring lines of arches, or extreme ends of openings for multiple boxes and pipes, where the clear distance between openings is less than half of the smaller contiguous opening.

2. Show kind of crossing by checking descriptive item applicable. For multiple-span bridges give complete information on each span including approach spans. Indicate on leg sheet the odometer reading, position, and angle of skew of structure with respect to center line of road and by arrow the direction of stream flow.

3. Give information on the span over the highway only.

4. For span length use center to center of bearings, otherwise the clear opening. Skew bridges will be measured along center line of road. See Note 1.

5. Show general type such as: Trestle, Truss, Girder, I-Beam, Rigid Frame, Arch, Slab, Suspension, or Covered Bridge. See illustrations attached. Describe draw spans by classifications listed in Article X, Section 2 of Manual.

6. The length of a bridge structure is the over-all length measured along the line of survey stationing back to back of back-walls of abutments, if present, otherwise end to end of bridge floor, but in no case less than the total clear opening of the structure.

7. Give minimum lateral clearance. Where traffic lanes are separated by bridge numbers, show clearance width of each lane separately. Special conditions should be explained by notes.

8. In case of overhead bracing or arch construction, measurement shall be made to the lowest point above the road surface.

9. Use classification listed on RR crossing sheets. Form 4 HPS.

Remarks: _____

A rearrangement of the form similar to that shown on the attachment may be used to provide space for coding.

SHA 51.3-8
11-15-72

STATE HIGHWAY ADMINISTRATION OF MARYLAND

Now conn with 6130

90-4/5 BB/TA

1-24-91

ROAD INVENTORY SHEET

(LANGMAID RD)

T. LANDON HUGHES VERIFIED 4/15/77

Party Chief _____
Recorder _____
Helper C. MARTIN

Road No. C.O. 125
Road Name ~~MARSHALL CREEK RD~~ (~~MARSHALL CREEK RD~~)
Sheet No. 1 OF ~~2~~ 3
Date 10-2-74
County WORCESTER
State Coordinates 1291-157

Map No. GH 24

79-4 FR JT 2-14-80

H	0.36	5 H	22' I ~~15' J~~
	0.33		~~2-3' GSHLD~~ 2 ML ~~2 R CW~~ (79-4)
US	0.30	113	SS ~~S~~
H	0.25		
H	0.23	H	78-7
↑ 15°	0.22	H	
H	0.18		
	0.16	18" CMP	
	0.14		
SE ↑ 6 H	0.10	H	
	0.06	H	22' I ~~20' J~~ 2 R CW
	0.04	H	2 ML ~~15' J~~
NEWARK	0.02	RD. H	~~2-3'G SHLDS~~ ~~2 R CW~~
(~~OLD~~ CO	0.00	~~US~~ 113 319	SS V

SHA 51.3-8
11-15-72

(LANDMARK Rd)

ROAD INVENTORY SHEET

Road No. CO 125
Road Name ~~MARSHALL CREEK RD~~
Sheet No. 2 OF 2 & 3
Date 10-2-74
County WORCESTER
State Coordinates

PT
40°
PC

1 08
1 03

PT
70°
PC

0 67
0 63

0 60

PT
30°
PC

20'I
2mL

(Marshall ~~Road~~ Creek ~~Bridge~~ CO 129 RD)

0 51
0 50
0 48
0 41

H

15°

SAME

SHA 51.3 - 8 Revised
4.83

MARYLAND STATE HIGHWAY ADMINISTRATION

ROAD INVENTORY SHEET

90-4,5

Party Chief BB
Recorder TM
Assistant
Map No./Dir. /
State Coordinates

Road No. CO 125
Road Name (LANGMAID RD)
County WORCESTER
Date 1-24-91
Sheet No. 3 OF 3

SYSTEM				TRAFFIC		LINE DIAGRAM	TRAFFIC			PAVEMENT DATA
FED. AID.	FUNCT CLASS.	HWY. SYS.	HPMS SAMPLE	PRKG. REST.	COM/IND. ACCESS		CONTROL	COM/IND. ACCESS	PRKG. REST.	
						ROAD 3 GATE 32 END				14'F
										2 ML
						2 94			X	
										16'I
										2 ML
						2 70			X	
						(BOWDEN RD) CO 320				
						/ 63				
										18'I
										2 ML
						/ 30			X	
						/ 16 PT 70° PC				
						/ 09				

TRAFFIC CODES

TRAFFIC CONTROLS: STOP SIGN=SS, TRAFFIC LIGHT=T.L., FLASHING RED BALL=F.R.

TRAFFIC CODES

PARKING RESTRICTIONS: A.M. PEAK, P.M. PEAK, A.M./P.M. PEAK, NO PARKING ANYTIME=N.P., COMM/IND. ACCESS=E

SYSTEM				TRAFFIC		LINE DIAGRAM	TRAFFIC			PAVEMENT DATA
FED. AID.	FUNCT. CLASS.	HWY. SYS.	HPMS SAMPLE	PRK.G. REST.	COM/IND ACCESS		CONTROL	COM/IND ACCESS	PRK.G. REST.	

Form 6 HPS (Rev. 1961)

X

ROAD INVENTORY SHEET

Party Chief F. SETTAN
Recorder T. LANDON
Chainman

1291-157

T. LANDON
F. RHODES
VERIFIED
4/15/77

Road No. CO 126
Name (MILL STREET)
Sheet No. 1 OF 1
Date 12-9-65
County WORCESTER

		(PATEY WOODS ROAD)		
	Co.	017	124	
NW ↑		013	PT 90°	
		009	B-~~FEED~~ PC	
				16'F 22'CW
	(NEWARK	003	RD 4	
	~~OLD US 13~~		~~THRU NEWARK~~	
	Co.	000	~~132~~ 319	

SHA 51.3-8
11-15-72

STATE HIGHWAY ADMINISTRATION OF MARYLAND

90-35 AMT 89-32 1-24-91 BB/TM

ROAD INVENTORY SHEET

TINDLEY RD.

Party Chief J. LANDON
Recorder E. RHODES
Helper _____

Map No. _____

Road No. CO. 127
Road Name ~~LABOR CAMP RD.~~
Sheet No. 1 OF 1
Date 4/15/77
County WORCESTER
State Coordinates 1295-161

ROAD END.

0 61

0 58 H

0 53 H

12'F
2 UML

H 0 52

(RXR) 0 50 BUCKEYE RD

(RXR) H 0 47 OD 4/5 77-32 1600'

3 H

0 44

~~Acorn RD~~ ~~CO~~ 1090 0 43

MODE

~~R 531595~~ PA. 0 42 NO SIGNS RR

NW

~~0 38~~ (RXR)

0 37 H

0 33 MULBERRY RD.
~~WILLIAMS CHURCH RD~~
~~(COLORED CHURCH RD.)~~

0 32 ~~CO~~ (RXR) 670

0 27

0 12 H

NEWARK 0 04 15°↑ 16'F
~~OLD U.S.~~ RD. 22'CW
CO. 113

0 00 319 SS

SHA 51.3-8
11-15-72

ROAD INVENTORY SHEET

Road No. _____
Road Name _____
Sheet No. _____
Date _____
County _____
State Coordinates _____

* was Colored Church Rd - (89-28)

SHA 51.3 - 8 Revised
4.83

MARYLAND STATE HIGHWAY ADMINISTRATION

ROAD INVENTORY SHEET

Party Chief F Setton
Recorder I. London
Assistant Rewritten 3-14-90
Map No./Dir. GH 24 / N
State Coordinates 1297-161

Road No. CO 128
Road Name Williams Church RD
County Worcester
Date 12-9-65
Sheet No. 1 OF 1

TRAFFIC CODES
TRAFFIC CONTROLS: STOP SIGN=SS, TRAFFIC LIGHT=T.L., FLASHING RED BALL=F.R.

PARKING RESTRICTIONS: A.M. PEAK, P.M. PEAK, A.M./P.M. PEAK, NO PARKING ANYTIME=N.P., COMM/IND. ACCESS=E

SYSTEM				TRAFFIC		LINE DIAGRAM	TRAFFIC			PAVEMENT DATA
FED. AID.	FUNCT CLASS.	HWY. SYS.	HPMS SAMPLE	PRK.G. REST.	COM/IND. ACCESS		CONTROL	COM/IND. ACCESS	PRK.G. REST.	
						Mulberry Church RD CO 670				
						0 64				
						0 61 Church		E		
						0 60 90°				
						0 27 35°				
						Newark CO 0 00				16' F 22' CW 2 UML
						3.19				

NON F/A
Rural Local

SYSTEM				TRAFFIC		LINE DIAGRAM	TRAFFIC			PAVEMENT DATA
FED. AID.	FUNCT. CLASS.	HWY. SYS.	HPMS SAMPLE	PRKG. REST.	COM/IND ACCESS		CONTROL	COM/IND ACCESS	PRKG. REST.	

Form 6 HPS (Rev. 1961)

1293-154

ROAD INVENTORY SHEET

Marshall Creek Rd (89-126)

Party Chief F. SETTAN T. LANDON
Recorder T. LANDON F. RHODES
Chainman

89-126 VERIFIED 4/15/77

Road No. Co 129
Name ~~MASON LANDING RD~~
Sheet No. 1 OF 2
Date 12-9-65
County WORCESTER

	119	PT 90° PC	12" CP
↑25°	111		
	103	HT	
	102		
F	099		
	093	H	
H	074		
	071		12" CMP
	068	H	16' F
	063	HT	
PT 90°	060		
H	057		
PC	056		
	052		20°↑ X
	048	PT 35° PC	
	044		
	023		12" CP
E ↑ 25°	014		12" CP
			16' ~~XT~~ 22' CW
H (LANGMAID) (MARSHALL CREEK RD)	008	(R.A.)	
	003	~~LANGMAID ROAD~~	
Co. ~~125~~	000	CO ~~125~~ ~~130~~ 129	

Form 6 HPS (Rev. 1961)

ROAD INVENTORY SHEET

Party Chief F. SETTAN
Recorder T. LANDON
Chainman

Road No. Co. 129
Name
Sheet No. 2 OF 2
Date 12-9-65
County WORCESTER

		BOATRAMP		
	ROAD	END		
CREEK	1	80	↑	13'F
↑40°	1	71		18'CW
	1	58	30°↑ X	
	1	40	F	
H	1	45		
H	1	44	H	
	1	41		
	1	36	12" CP	
↑25°	1	33	F (ABAN.)	
				SAME

SHA 51.3-8
11-15-72

STATE HIGHWAY ADMINISTRATION OF MARYLAND

87-23-24
AL/KS

ROAD INVENTORY SHEET

Party Chief _____
Recorder _____
Helper C. MARTIN

Map No. GH 24

Road No. CO 130
Road Name LANGMAID RD
Sheet No. 1 OF 3
Date 10-2-74
County WORCESTER
State Coordinates 1293 - 154

4/15/77 VERIFIED

LABEL RHC'S

88-228

0.73 18"CMP
0.66 UNASSIGNED
0.64 NOW Combined
0.62 H w/ Co 125 70° PT
0.59 90-415' PC
0.58 BB/1.86 "CMP
0.53 ~~10"I~~ ~~2"CM~~ ~~2"ML~~
0.45 H 20° PT * 2-4-41
0.39 H
0.37 12"CP
0.30 F
0.17 SE 18'I 2ML
0.13 PT 70° PC X 20'I 2ML ~~16'I~~ ~~2'CM~~
0.10 PT 30° PC
0.05 H Marshall Creek ~~Manokin~~ CO 129 RD
0.01 ~~2'CM~~
0.00 MARSHALL CREEK RD CO 125

SHA 51.3-8
11-15-72

ROAD INVENTORY SHEET

Road No. CO 130
Road Name LANGMAID RD
Sheet No. 2 OF 3
Date 10-2-74
County WORCESTER
State Coordinates

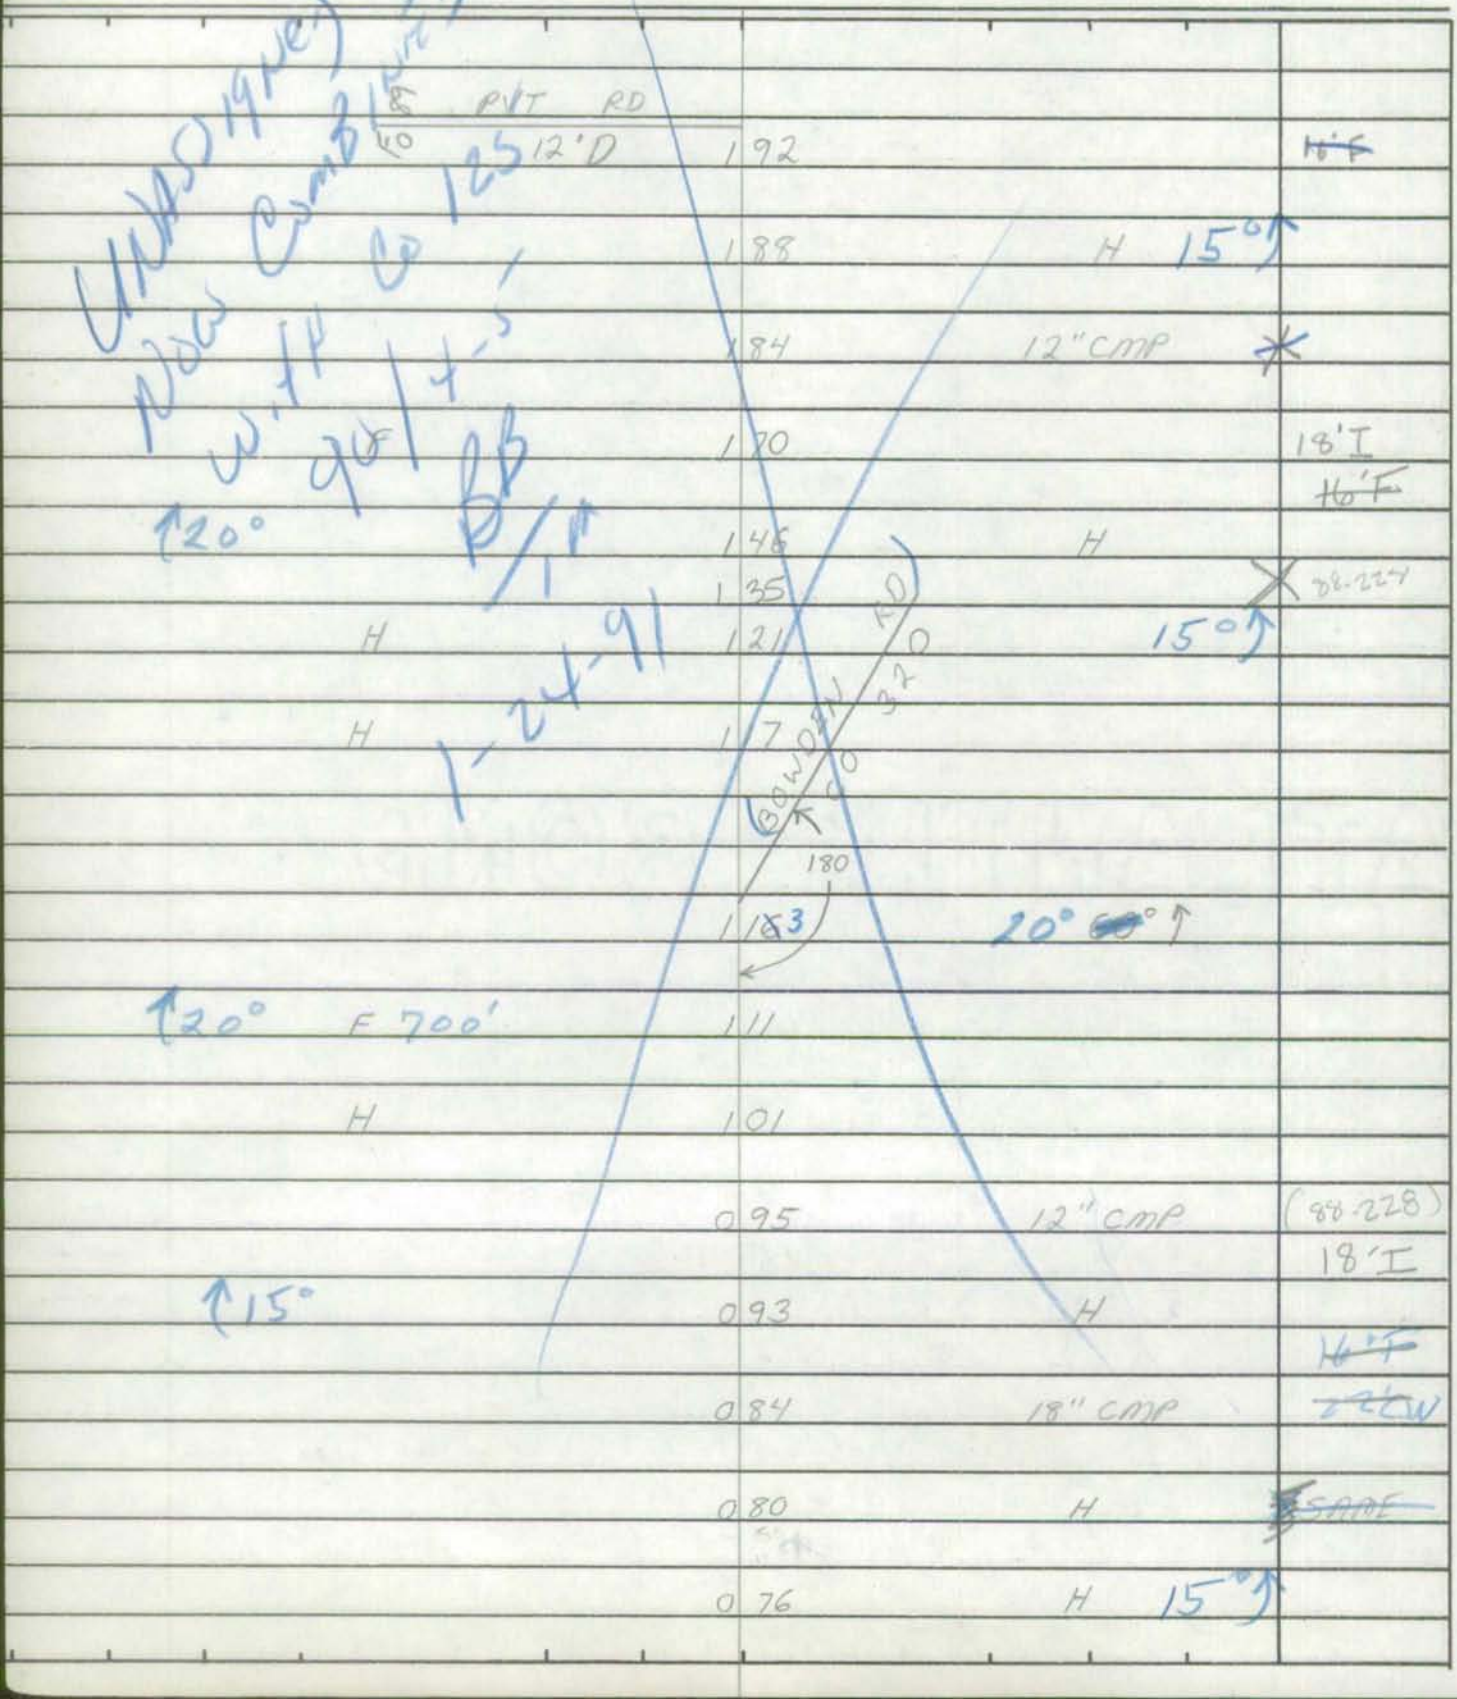

SHA 51.3-8
11-15-72

STATE HIGHWAY ADMINISTRATION OF MARYLAND

ROAD INVENTORY SHEET

T. LANDON
F. RHODES
VERIFIED
77

Party Chief _____
Recorder _____
Helper C MARTIN

Map No. GH 24

Road No. CO 130
Road Name LANGMAID RD
Sheet No. 3 OF 3
Date 10-2-74
County WORCESTER
State Coordinates _____

UNASSIGNED
NOW COMBINED
WITH CO 125
90/4-5
88/TA
1-24-91

F
ROAD END

GATE
2892
2934
2384
2250
~~2095~~
1994

14'F
20'CW
16'F
24'CW
18'I
22'CW
2ML

SHA 51.3-8
11-15-72

ROAD INVENTORY SHEET

Road No. _____
Road Name _____
Sheet No. _____
Date _____
County _____
State Coordinates _____

Form 6 HPS (Rev. 1961)

90-6

ROAD INVENTORY SHEET

Party Chief F. SETTAN
Recorder T. LANDON
Chainman

1273-169
T. LANDON
F. RHODES
VERIFIED
4/15/77

Road No. Co 131
Name NINE PIN BRANCH RD
Sheet No. 1 OF 2
Date 12-15-65
County WORCESTER

F	1	51	
PT 70° PC	1	43	
	1	38	CEM
	1	33	PT 80° PC 191 I
	1	32	(RATEL WOODS ROAD Co 1 124)
HT 003/16'G	1	28	
HT	1	25	
	1	22	12" CP
	1	15	X
F	0	87	
15° (SANDYFIELD RD.) Co 105	0	68	
	0	57	
	0	31	F 20°↑
T.H. 022 AT RD 10'D T.H. 015 T.H. 008 T.H. HOME	0	14	
NE ↑ F	0	13	(QUEPONCA ROAD Co 1 123) (91-21) 20' I
	0	03	20°↑ ~~16'~~ 26' CW 2-3' FENCE
		92 RD.	
	0	00	X
WHITON CROSSING Co			

Form 6 HPS (Rev. 1961)

94-3
1-10-95
GD/TM

ROAD INVENTORY SHEET

Party Chief F. SIETTAN
Recorder T. LANDON
Chainman

Road No. C.O 131
Name
Sheet No. 20F2
Date 12-15-65
County WORCESTER

	MD	205	374	(91-20) 20' I ~~16' G~~ 26' (W ~~23' ESHLD~~
	HT	201	F 800'	
125°		184	F	
#W00405 NINE PIN		165	72-10 BRANCH SEE BR. SH. 1-B 22.1 west W-W	X
				SAME

Form 5-HPS
(Revised 1961)

MARYLAND STATE ROADS COMMISSION
PLANNING AND PROGRAMMING DIVISION

S26130

IN COOPERATION WITH
U. S. BUREAU OF PUBLIC ROADS

BRIDGE SHEET

ROAD NO. Co. 131

SHEET NO. 1-A

PARTY NO. _____

DATE 12-15-63

COUNTY DORCHESTER ?

RATED CAPACITY _____

FOR ALL STRUCTURES HAVING A TOTAL OPENING OF MORE THAN 20 FEET AS DEFINED IN NOTE 1.

ODOMETER READING 1.65 NAME OF STREAM, RAILROAD OR HIGHWAY CROSSED NINEPIN BRANCH

NUMBER OF RAILROAD TRACKS _____
KIND OF CROSSING (NOTE 2) _____

UNDERPASS-SIMPLE UNDERPASS-COMBINED (NOTE 3) OVERPASS BRIDGE OVER SYSTEM

DESCRIPTION

NUMBER OF SPANS	LENGTH EACH SPAN (NOTE 4)	TYPE (NOTE 5)
4	14'	WOOD-PILE

TOTAL LENGTH-ON LINE OF ROAD OVER-ALL (NOTE 6) 56'

MATERIAL

SUBSTRUCTURE WOOD SUPERSTRUCTURE WOOD

FLOOR WOOD

CLEARANCES

ROADWAY (NOTE 7) 15' SIDEWALK WIDTHS: RIGHT LEFT

SURFACE OF ROAD TO STREAM BED 8' FOR OVERPASSES, SHOW DISTANCES TO TOP OF RAIL OR SURFACE OF LOWER ROAD. (NOTE 8)

SURFACE OF ROAD TO BOTTOM PORTAL 2' (MINIMUM OVERHEAD CLEARANCE

CLEAR DISTANCE OF OPENING ABOVE STREAM BED 6' (WATERWAYS ONLY)

POSTED LOAD LIMITS _____ BRIDGE NO. 405 CONSTRUCTION DATE _____

GENERAL CONDITION OF BRIDGE: CHECK IF GOOD, FAIR, OR POOR, DESCRIBE DEFECTS IF SERIOUS.

	GOOD	FAIR	POOR
SUPERSTRUCTURE	✓		
FLOOR		✓	
SUBSTRUCTURE		✓	

PAINT BADLY CORRODED OR RUSTED

TYPE OF PROTECTION FOR DRAWBRIDGES (NOTE 9) _____

(NOTES ON REVERSE SIDE)

S26130

Notes:

1. In agreement with Federal-aid standards, a bridge is defined as a structure including supports erected over a depression or an obstruction, as water, highway, or railway, and having a track or passageway for carrying traffic or other moving loads, and having a length measured along the center of roadway of more than 20 feet between undercoping of abutments or spring lines of arches, or extreme ends of openings for multiple boxes and pipes, where the clear distance between openings is less than half of the smaller contiguous opening.

2. Show kind of crossing by checking descriptive item applicable. For multiple-span bridges give complete information on each span including approach spans. Indicate on leg sheet the odometer reading, position, and angle of skew of structure with respect to center line of road and by arrow the direction of stream flow.

3. Give information on the span over the highway only.

4. For span length use center to center of bearings, otherwise the clear opening. Skew bridges will be measured along center line of road. See Note 1.

5. Show general type such as: Trestle, Truss, Girder, I-Beam, Rigid Frame, Arch, Slab, Suspension, or Covered Bridge. See illustrations attached. Describe draw spans by classifications listed in Article X, Section 2 of Manual.

6. The length of a bridge structure is the over-all length measured along the line of survey stationing back to back of back-walls of abutments, if present, otherwise end to end of bridge floor, but in no case less than the total clear opening of the structure.

7. Give minimum lateral clearance. Where traffic lanes are separated by bridge numbers, show clearance width of each lane separately. Special conditions should be explained by notes.

8. In case of overhead bracing or arch construction, measurement shall be made to the lowest point above the road surface.

9. Use classification listed on RR crossing sheet. Form 4 HPS.

Remarks: _____

A rearrangement of the form similar to that shown on the attachment may be used to provide space for coding.

SHA 51.3-8
11-15-72

STATE HIGHWAY ADMINISTRATION OF MARYLAND

ROAD INVENTORY SHEET

Party Chief _____
Recorder _____
Helper C. MARTIN

Map No. GH 24

Road No. CO 132
Road Name BETHARDS RD
Sheet No. 1 OF 2
Date 10-2-74
County WORCESTER
State Coordinates 1287-169

T. L. ROAD INVENTORY VERIFIED 4/15/77

	166	12" CMP
	155	H
	154	H 700'
	138	48" CMP
HT	136	
PT 60° PC	119	
	113	
	~~098~~	
	096	F
	074	36" CMP
PT 35° PC	071	
	067	
	061	PT 40° PC
	058	
15°	020	15°
PATEY CO	008	
	000	

18' F
30' CW

NE

WOODS RD. 124

SHA 51.3-8
11-15-72

ROAD INVENTORY SHEET

Road No. CO 132
Road Name BETHARDS RD
Sheet No. 2 OF 2
Date 10-2-74
County WORCESTER
State Coordinates

IRONSHIRE CO STATION RD / 321

228

227 F

SAME

SHA 51.3-8
11-15-72

STATE HIGHWAY ADMINISTRATION OF MARYLAND

ROAD INVENTORY SHEET

Party Chief _____
Recorder _____
Helper C. MARTIN

Map No. GH 24

Road No. CO 133
Road Name (MASON RD)
Sheet No. 1 OF 2
Date 10-2-74
County WORCESTER
State Coordinates 1314 - 163

T. LANDON
E. RHODES
VERIFIED 4/14/77
81-25

F 700'	176	H
	171	H BEAVER DAM CREEK CO 137 RD
H	170	
	165	20'I
F 500'	161	
	158	PT 30° PC
	152	
PT 35° PC	146	
	141	
20°	133 H	
	128 H	
	100 PVT	65° RD F BEAVER DAM CREEK
		18'F 30'CW
	070	
	054	F 600'
F	022	10'F 16'CW
	000	F
	ROAD END	

NW

SHA 51.3-8
11-15-72

ROAD INVENTORY SHEET

Road No. CO. 133
Road Name MASON RD
Sheet No. 2 OF 2
Date 10-2-74
County WORCESTER
State Coordinates

	CO 321 IRONSHIRE STATION RD	
US	201	113
H	198	H
	194	H
H	187	PT
H	084	35°
	178	24" CMP PC
		SAME

SHA 51.3-8
11-15-72

STATE HIGHWAY ADMINISTRATION OF MARYLAND

90 EX #2
1-24-91
BB/TM

ROAD INVENTORY SHEET

Party Chief T. LANDON
Recorder F. RHODES
Helper

Map No. GH24

Road No. CO. 134
Road Name DOWNS RD.
Sheet No. 1 OF 1
Date 4/15/77
County WORCESTER.
State Coordinates

	US	2	~~20~~ 15 113	SS ↑
		2	183	35° ~~20°~~ ↑
	F400'	1	83	F 1000'
		1	82	5 H
SW ↑		1	~~69~~ 78	
		1	39	F
	↑25°	1	22	
		1	16	F 20° ↑
		0	78	48" CMP
		0	56	48" CMP
	H	0	38	F600' 25° ↑
		0	25	IRONSHIRE ELECT. SUB-STA. 18' F ~~2 3' E SM~~
	IRONSHIRE CO.	0	00 STATION RD. 321 GATE	SS ↓ 30' CW

SHA 51.3-8
11-15-72

ROAD INVENTORY SHEET

Road No. _____
Road Name _____
Sheet No. _____
Date _____
County _____
State Coordinates _____

Form 6 HPS (Rev. 1961)

ROAD INVENTORY SHEET

Party Chief F. SETTHN
Recorder T. LANDON
Chainman

T. 19?? - 19?? LANDON
F. RHODES
VERIFIED
4/7/??

Road No. CO 135
Name TIMMONSTOWN RD
Sheet No. 1 OF 2
Date 2-15-66
County WORCESTER

99-17 A/T

↑20°	1 65	F	
	1 54	PT ↑ 60°	
	1 46	PC	
F	1 44	F 500'	
	1 27	PVT LEVEL	
	1 18	F 30° ↑	
	1 14	12" CP	
	1 03	2-36" CMP	
	1 00	36" CMP	
PT 45°	0 96		
PC	0 91		
↑15°	0 85		
	0 69	18" CMP	
	0 65	20° ↑	
	0 37	24" CMP 25° ↑	
			17' F
H-ABAN	0 05		24' CW
(LOGTOWN ROAD)		(MASSEY CROSSING ROAD)	
CO 180 ~~329~~	0 00	CO ~~180~~ 329	

Form 6 HPS (Rev. 1961)

ROAD INVENTORY SHEET

Party Chief F. SETTAN
Recorder T. LANDON
Chainman

Road No. C.O 135
Name
Sheet No. 2 OF 2
Date 2-15-66
County WORCESTER

MO	2	80	374
↑15°	2	65	
#W00308 NARROW	2	42	BRANCH SEE BR. SH. 1-A 40°↓
	2	37	
↑PT 30° PC	2	25	
	2	19	
	2	12	24" Conp B H SAME
	1	70	

Form 5-HPS
(Revised 1961)

MARYLAND STATE ROADS COMMISSION
PLANNING AND PROGRAMMING DIVISION

S26130

IN COOPERATION WITH
U.S. BUREAU OF PUBLIC ROADS

ROAD NO. Co 135

BRIDGE SHEET

SHEET NO. 1A

PARTY NO. _____

DATE 2-13-80

COUNTY Worcester

RATED CAPACITY _____

FOR ALL STRUCTURES HAVING A TOTAL OPENING OF MORE THAN 20 FEET AS DEFINED IN NOTE 1.

ODOMETER READING 2.42 NAME OF STREAM, RAILROAD OR HIGHWAY CROSSED Narrow Branch

NUMBER OF RAILROAD TRACKS _____
KIND OF CROSSING (NOTE 2) _____

UNDERPASS-SIMPLE UNDERPASS-COMBINED (NOTE 3) OVERPASS BRIDGE OVER SYSTEM

DESCRIPTION

NUMBER OF SPANS	LENGTH EACH SPAN (NOTE 4)	TYPE (NOTE 5)
2	12'	Wood Pile

TOTAL LENGTH-ON LINE OF ROAD OVER-ALL (NOTE 6) 26'

MATERIAL
SUBSTRUCTURE Wood SUPERSTRUCTURE Wood
FLOOR Wood

CLEARANCES
ROADWAY (NOTE 7) 20' Wood SIDEWALK WIDTHS: RIGHT LEFT
SURFACE OF ROAD TO STREAM BED 9' FOR OVERPASSES, SHOW DISTANCES TO TOP OF RAIL OR SURFACE OF LOWER ROAD. (NOTE 8)
SURFACE OF ROAD TO BOTTOM PORTAL _____ (MINIMUM OVERHEAD CLEARANCE
CLEAR DISTANCE OF OPENING ABOVE STREAM BED 7' (WATERWAYS ONLY)
POSTED LOAD LIMITS _____ BRIDGE NO. 308 CONSTRUCTION DATE _____

GENERAL CONDITION OF BRIDGE: CHECK IF GOOD, FAIR, OR POOR, DESCRIBE DEFECTS IF SERIOUS.

	GOOD	FAIR	POOR
SUPERSTRUCTURE	✓		
FLOOR	✓		
SUBSTRUCTURE	✓		

PAINT BADLY CORRODED OR RUSTED
TYPE OF PROTECTION FOR DRAWBRIDGES (NOTE9) _____

(NOTES ON REVERSE SIDE)

S26130

Notes:

1. In agreement with Federal-aid standards, a bridge is defined as a structure including supports erected over a depression or an obstruction, as water, highway, or railway, and having a track or passageway for carrying traffic or other moving loads, and having a length measured along the center of roadway of more than 20 feet between undercoping of abutments or spring lines of arches, or extreme ends of openings for multiple boxes and pipes, where the clear distance between openings is less than half of the smaller contiguous opening.

2. Show kind of crossing by checking descriptive item applicable. For multiple-span bridges give complete information on each span including approach spans. Indicate on leg sheet the odometer reading, position, and angle of skew of structure with respect to center line of road and by arrow the direction of stream flow.

3. Give information on the span over the highway only.

4. For span length use center to center of bearings, otherwise the clear opening. Skew bridges will be measured along center line of road. See Note 1.

5. Show general type such as: Trestle, Truss, Girder, I-Beam, Rigid Frame, Arch, Slab, Suspension, or Covered Bridge. See illustrations attached. Describe draw spans by classifications listed in Article X, Section 2 of Manual.

6. The length of a bridge structure is the over-all length measured along the line of survey stationing back to back of back-walls of abutments, if present, otherwise end to end of bridge floor, but in no case less than the total clear opening of the structure.

7. Give minimum lateral clearance. Where traffic lanes are separated by bridge numbers, show clearance width of each lane separately. Special conditions should be explained by notes.

8. In case of overhead bracing or arch construction, measurement shall be made to the lowest point above the road surface.

9. Use classification listed on RR crossing sheets. Form 4 HPS.

Remarks: _____

A rearrangement of the form similar to that shown on the attachment may be used to provide space for coding.

Form 6 HPS (Rev. 1961)

90EX#7
1-24-91
BB/TM

~~TABBED IN BOOK~~
~~OLD US ONE THIRTEEN IRONSHIRE~~

ROAD INVENTORY SHEET

Shire DR (69-48) ✓

GH 24
1306-165
T. LANDON
F. RHODES
VERIFIED
4/14/77

Party Chief F. SETTAN
Recorder T. LANDON
Chairman

Road No. Co 136
Name ~~OLD US 113 THROUGH IRONSHIRE~~
Sheet No. 1 OF 1
Date 12-16-65
County WORCESTOR

Worcester		Hwy		
US	022	113	SS ↑	20'H
		BAYS END LA. Co. 138		30'Cu
	020	OP ~~LA~~ ROT RD ~~40 Lab~~ 90EX? 90° ↑	X	
	014	CBC L-2'X W 22'X D-2' 15°		
NE ↑	003	F		
				14'G
	001	75°		20'Cu
Worcester		Hwy		
US	000	113	↓	

Form 6 HPS (Rev. 1961) 1309-168

ROAD INVENTORY SHEET

BEAVER DAM CREEK RD

Party Chief F. SETIAN
Recorder T. LANDON
Chainman

T. LANDON
F. RHODES
VERIFIED
4/14/77

Road No. Co 137
Name ~~BEAVER DAM CREEK RD~~
Sheet No. 1 OF 1
Date 12-16-65
County WORCESTER

HAYES LANDING ROAD

	Co.	1 54	139	
		0 97	H	
		0 74	30°↑	
	HT	0 60		
		0 57	F	
	F	0 45		
	H	0 34		
				16' F
	H	0 31		30' cw
		0 25 → ~~2-36" CMP WPC L 16' x W 16' x D 3'~~		
↑ 30°				
		0 18	HT	
		0 140	Orchard ~~RD~~ ~~BEAVER DAM CREEK~~ ~~EAST~~	
		0 13 Co ~~OP 13~~ 352	H 90°↑	
			ROAD 133	
				18' F
				30' cw
SE ↑		0 00		
			(MASON) 10°	

Form 6 HPS (Rev. 1961)

~~TABBED~~
~~OLD US ONE THIRTEEN IRONSHIRE~~

ROAD INVENTORY SHEET

Party Chief F. SETTAN
Recorder T. LANDON
Chairman

1307-167

T. LANDON
F. ANGELES
VERIFIED
4/14/71

Shire DR (89-48)

Road No. Co 138
Name ~~OLD US 13 THROUGH IRONSHIRE~~
Sheet No. 1 OF 2
Date 12-20-65
County WORCESTER

82-11

	0 50	H	
	0 48	B-VAC	
(IRONSHIRE STATION		ROAD)	
Co.	0 47	~~53~~ 321 → TO US 113	
	0 46	B-VAC	
H	0 45		
	0 44	H	
H	0 42	H	
↑20° F	0 34		
	0 23	12" C.P	
H(VAC)	0 18	H	
H	0 15	H	82-11 ~~20 TH~~
N ↑	~~3TH~~ 0 14		~~30'CW~~
	0 09		
↑45°	0 04		20'I 30'CW
Worcester		Hwy	
• US	0 00	113 → BERLIN	

Form 6 HPS (Rev. 1961)

X

ROAD INVENTORY SHEET

Party Chief F. SETTAN
Recorder T. LANDON
Chainman

Road No. Co 138
Name
Sheet No. 2 OF 2
Date 12-20-65
County WORCESTER

SHA 51.3 - 8 Revised
4.83

MARYLAND STATE HIGHWAY ADMINISTRATION

(92-13)
87-26
91-29

ROAD INVENTORY SHEET

Party Chief: GD
Recorder: AH
Assistant:
Map No./Dir.: GH / NW
State Coordinates: 1310-174

Road No.: Co 139
Road Name: HAYES LANDING RD
County: WORCESTER
Date: 1/13/93
Sheet No.: 1 OF 2

TRAFFIC CODES
TRAFFIC CONTROLS: STOP SIGN=SS, TRAFFIC LIGHT=T.L., FLASHING RED BALL=F.R.

TRAFFIC CODES
PARKING RESTRICTIONS: A.M. PEAK, P.M. PEAK, A.M./P.M. PEAK, NO PARKING ANYTIME=N.P., COMM/IND. ACCESS=E

SYSTEM				TRAFFIC		LINE DIAGRAM	TRAFFIC			PAVEMENT DATA
FED. AID.	FUNCT. CLASS.	HWY. SYS.	HPMS SAMPLE	PRKG. REST.	COM/IND. ACCESS		CONTROL	COM/IND. ACCESS	PRKG. REST.	
						BEAVER DAM CR RD				
						Co 137 1 07 @1.04				
						PT 0 93				
						25°				
						PC 0 86				
						0 80 PT				20'I
										2 ML
						NEWPORT 0 78 CREEK 30° SEE BR SH 1-8			X	
						#WO 302				
						0 76 PC				16'G
										2 UML
						CUL 0 00 SAC			Y	
						D E				
						NEWPORT FARMS				

NON FIA
RURAL LOCAL

SYSTEM				TRAFFIC		LINE DIAGRAM				TRAFFIC				PAVEMENT DATA
FED. AID.	FUNCT. CLASS.	HWY. SYS.	HPMS SAMPLE	PRK'G. REST.	COM/IND ACCESS					CONTROL	COM/IND ACCESS		PRK'G. REST.	
						(WORCESTER		HWY)						
						US	2	10	113	SS			/	
									@ 26.13 (LT)					
							1	93	PT					
									35°					
							1	82	PC					
						(HARRISON E			RD)					
						CO	1	63	140 @ 62					24' I 2 ML
							1	59					X	
						PT	1	57						
						30°								
						PC	1	46	PC					20' I 2 ML

NON FIA
RURAL LOCAL

Form 5-HPS (Revised 1961)

MARYLAND STATE ROADS COMMISSION
PLANNING AND PROGRAMMING DIVISION

S26130

IN COOPERATION WITH
U. S. BUREAU OF PUBLIC ROADS

ROAD NO. Co 139

BRIDGE SHEET

SHEET NO. 1-A

PARTY NO. _____

DATE 12-16-45


RATED CAPACITY _____

FOR ALL STRUCTURES HAVING A TOTAL OPENING OF MORE THAN 20 FEET AS DEFINED IN NOTE 1.

ODOMETER READING ~~1.74~~ 1.78 NAME OF STREAM, RAILROAD OR HIGHWAY CROSSED NEWPORT CREEK

NUMBER OF RAILROAD TRACKS _____
KIND OF CROSSING (NOTE 2) _____

UNDERPASS-SIMPLE UNDERPASS-COMBINED (NOTE 3) OVERPASS BRIDGE OVER SYSTEM

DESCRIPTION

NUMBER OF SPANS	LENGTH EACH SPAN (NOTE 4)	TYPE (NOTE 5)
2	14.5'	WOOD PILE

TOTAL LENGTH-ON LINE OF ROAD OVER-ALL (NOTE 6) 29'

MATERIAL
SUBSTRUCTURE WOOD SUPERSTRUCTURE WOOD
FLOOR WOOD

CLEARANCES
ROADWAY (NOTE 7) 19' SIDEWALK WIDTHS: RIGHT LEFT

SURFACE OF ROAD TO STREAM BED 5' FOR OVERPASSES, SHOW DISTANCES TO TOP OF RAIL OR SURFACE OF LOWER ROAD. (NOTE 8)
SURFACE OF ROAD TO BOTTOM PORTAL 2' (MINIMUM OVERHEAD CLEARANCE
CLEAR DISTANCE OF OPENING ABOVE STREAM BED 3' (WATERWAYS ONLY)
POSTED LOAD LIMITS _____ BRIDGE NO. 302 CONSTRUCTION DATE _____

GENERAL CONDITION OF BRIDGE: CHECK IF GOOD, FAIR, OR POOR, DESCRIBE DEFECTS IF SERIOUS.

	GOOD	FAIR	POOR
SUPERSTRUCTURE	✓		
FLOOR	✓		
SUBSTRUCTURE	✓		
PAINT			BADLY CORRODED OR RUSTED

TYPE OF PROTECTION FOR DRAWBRIDGES (NOTE 9) _____

(NOTES ON REVERSE SIDE)

S26130

Notes:

1. In agreement with Federal-aid standards, a bridge is defined as a structure including supports erected over a depression or an obstruction, as water, highway, or railway, and having a track or passageway for carrying traffic or other moving loads, and having a length measured along the center of roadway of more than 20 feet between undercoping of abutments or spring lines of arches, or extreme ends of openings for multiple boxes and pipes, where the clear distance between openings is less than half of the smaller contiguous opening.

2. Show kind of crossing by checking descriptive item applicable. For multiple-span bridges give complete information on each span including approach spans. Indicate on leg sheet the odometer reading, position, and angle of skew of structure with respect to center line of road and by arrow the direction of stream flow.

3. Give information on the span over the highway only.

4. For span length use center to center of bearings, otherwise the clear opening. Skew bridges will be measured along center line of road. See Note 1.

5. Show general type such as: Trestle, Truss, Girder, I-Beam, Rigid Frame, Arch, Slab, Suspension, or Covered Bridge. See illustrations attached. Describe draw spans by classifications listed in Article X, Section 2 of Manual.

6. The length of a bridge structure is the over-all length measured along the line of survey stationing back to back of back-walls of abutments, if present, otherwise end to end of bridge floor, but in no case less than the total clear opening of the structure.

7. Give minimum lateral clearance. Where traffic lanes are separated by bridge numbers, show clearance width of each lane separately. Special conditions should be explained by notes.

8. In case of overhead bracing or arch construction, measurement shall be made to the lowest point above the road surface.

9. Use classification listed on RR crossing sheet. Form 4 HPS.

Remarks: _____

A rearrangement of the form similar to that shown on the attachment may be used to provide space for coding.

SHA 51.3 - 8 Revised
4.83

.62 - 2.38 was CO 323

79-7
82-13

MARYLAND STATE HIGHWAY ADMINISTRATION

ROAD INVENTORY SHEET

96 CO 140 #2
GD KS
1-15-97

Party Chief C. MARTIN
Recorder Rewritten (JEL) 2-1-91
Assistant
Map No./Dir. GH 24 / NE
State Coordinates 1308 - 172

Road No. CO 140
Road Name (Harris ~~Rd~~ Rd.)
County Worcester
Date 10-3-74
Sheet No. 1 OF ~~8~~ 3

TRAFFIC CODES
TRAFFIC CONTROLS: STOP SIGN=SS, TRAFFIC LIGHT=T.L., FLASHING RED BALL=F.R.

TRAFFIC CODES
PARKING RESTRICTIONS: A.M. PEAK, P.M. PEAK, A.M./P.M. PEAK, NO PARKING ANYTIME=N.P., COMM/IND. ACCESS=E

SYSTEM FED. AID.	SYSTEM FUNCT CLASS.	SYSTEM HWY. SYS.	SYSTEM HPMS SAMPLE	TRAFFIC PRKG. REST.	TRAFFIC COM/IND. ACCESS	LINE DIAGRAM	TRAFFIC CONTROL	TRAFFIC COM/IND. ACCESS	TRAFFIC PRKG. REST.	PAVEMENT DATA
						Hayes Landing Rd				20' I
						CO 0 62 139 @1.63				X 22' CW
						0 51 12" CMP				
						0 48 25° ↑				
						↑ 20° 0 33				
	NON F/A Rural Local					↑ 15° 0 14				
						0 03 50° ↑				
						0 01 18" CMP				18' I 24' CW 2ML
✓	✓					1.5 0 00 113 @25.53 (R)				✓

SYSTEM: FED. AID. | FUNCT. CLASS. | HWY. SYS. | HPMS SAMPLE

TRAFFIC: PRKG. REST. | COM/IND ACCESS

LINE DIAGRAM

TRAFFIC: CONTROL | COM/IND ACCESS | PRKG. REST.

PAVEMENT DATA

NON FIA
Rural Local

TRAPPE Rd
CO 145
2 38
@.30

2 18 20°

15° 1 89

Germantown Rd
CO 324
1 73
Dinges Rd
CO 142
@.100
@.140

Bethel Rd
CO 141
@.46

30° 1 33

1 32 24" CMP

PT
0 82
30°

0 72 PC

20' I
22' CW
2 ML

SHA 51.3 - 8 Revised
4.83

MARYLAND STATE HIGHWAY ADMINISTRATION

(96 CO EX #2)

ROAD INVENTORY SHEET

Party Chief GD
Recorder K.S
Assistant
Map No./Dir. 1
State Coordinates

Road No. CO 140
Road Name HARRIS Rd
County WORCESTER
Date 1-15-97
Sheet No. 3 OF 3

TRAFFIC CODES
TRAFFIC CONTROLS: STOP SIGN=SS, TRAFFIC LIGHT=T.L., FLASHING RED BALL=F.R.

TRAFFIC CODES
PARKING RESTRICTIONS: A.M. PEAK, P.M. PEAK, A.M./P.M. PEAK, NO PARKING ANYTIME=N.P., COMM/IND. ACCESS=E

SYSTEM				TRAFFIC		LINE DIAGRAM	TRAFFIC			PAVEMENT DATA
FUNCT CLASS	HWY. SYS.	HPMS SAMPLE		PREG. REST.	COM/IND ACCESS		CONTROL	COM/IND ACCESS	PREG. REST.	
						(ASSATEAGUE RD)				
						MD 2 68 376 @1.67 (R)				
					E	2 64				
						TRAPPE 2 61 CREEK				
						# WO - 303				
						2 60 50°				20' I
										2 ML

COUNTY _____ ROAD NO. _____ PAGE ___ OF ____

SYSTEM				TRAFFIC		LINE DIAGRAM	TRAFFIC				PAVEMENT DATA
FUNCT. CLASS	HWY SYS.	HPMS SAMPLE		PKG. REST.	COM/IND ACCESS		CONTROL	COM/IND ACCESS	PKG. REST.		

Form 6 HPS (Rev. 1961)

P9-62
1-24-91
BB/TM

96-COR#1
GO/KS
1-15-97

ROAD INVENTORY SHEET

Bethel Rd (89-47)

Party Chief E. SETTAN
Recorder T. LANDON
Chainman

1314-178
T. LANDON
T. HODES
VERIFIED
4/14/77

Road No. Co 141
Name ~~(GERMANTOWN, HARRISON RD)~~
Sheet No. 1 of 1
Date 12-21-65
County WORCESTER

87-117

ROAD
~~140~~ ~~135~~ 140

(HARRIS~~ON~~ Co.

0 45

~~0 39 ERROR OF CW ROAD~~

0 17

5 H 0 15 H

0 12

PT H 300' 0 10
30°
PC 0+417 0 07
@.23

~~H HOUSE~~ 0 05

GERMANTOWN Co.

0 02 18'I
~~17'I~~
27'CW
2 ML

S 0 01 H

0 00

~~80~~ ROAD

~~A2~~ 324

SHA 51.3-8
11-15-72

STATE HIGHWAY ADMINISTRATION OF MARYLAND

ROAD INVENTORY SHEET

Party Chief T. LANDON
Recorder F. RHODES
Helper

Map No.

Road No. CO. 142
Road Name (DINGES RD.)
Sheet No. 1 OF 1
Date 4/14/77
County WORCESTER
State Coordinates 1318-176

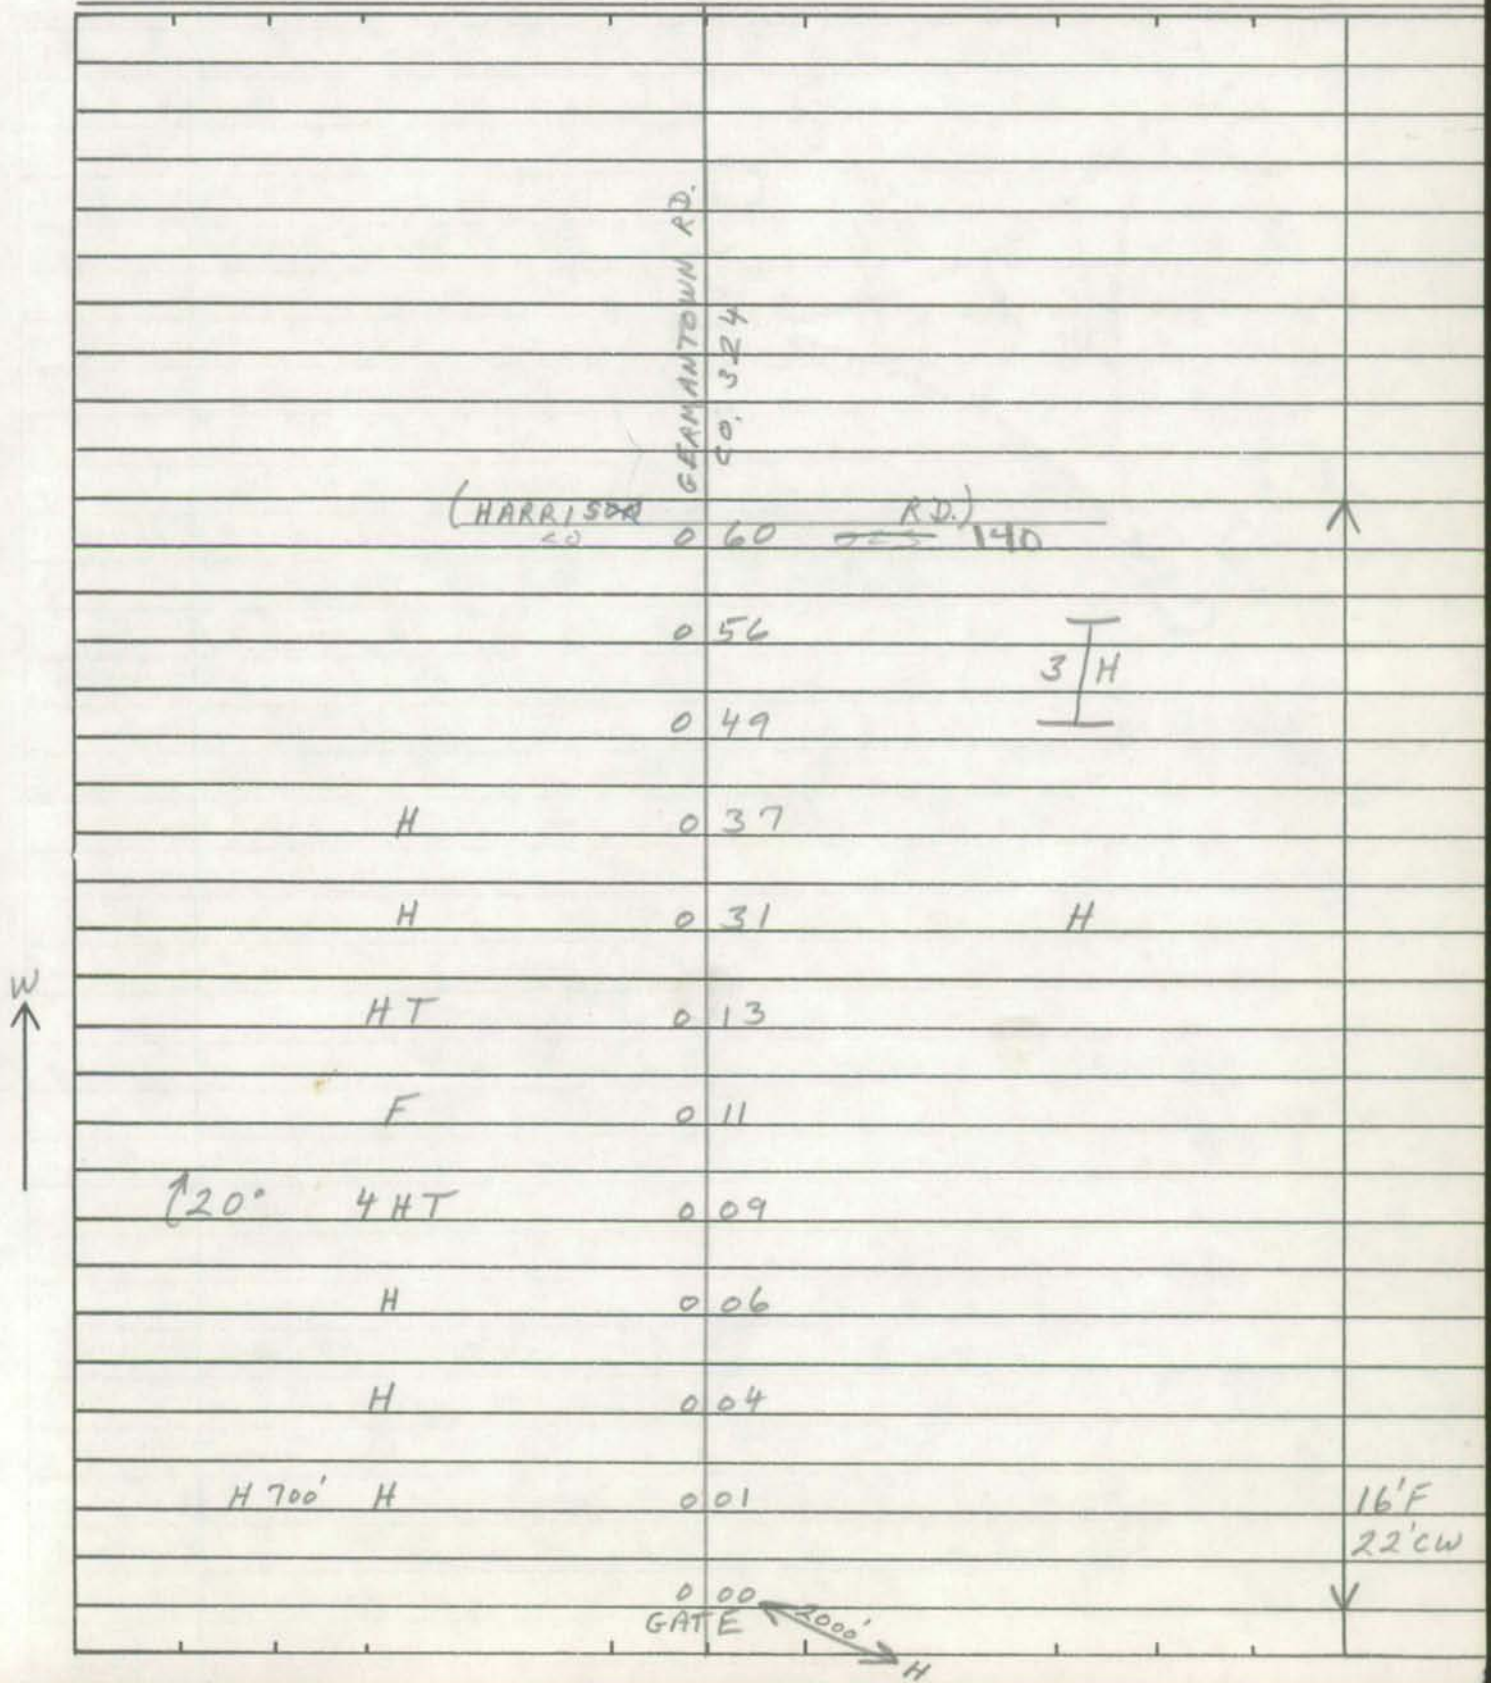

SHA 51.3-8
11-15-72

ROAD INVENTORY SHEET

Road No. _____
Road Name _____
Sheet No. _____
Date _____
County _____
State Coordinates _____

SHA 51.3-8
11-15-72

STATE HIGHWAY ADMINISTRATION OF MARYLAND

ROAD INVENTORY SHEET

Party Chief _____
Recorder _____
Helper C. MARTIN

Map No. GH 24

Road No. CO 143
Road Name TRAPPE RD
Sheet No. 1 OF 3
Date 10-3-74
County WORCESTER
State Coordinates 1318 - 80

F. VERIFIED 4/14/77

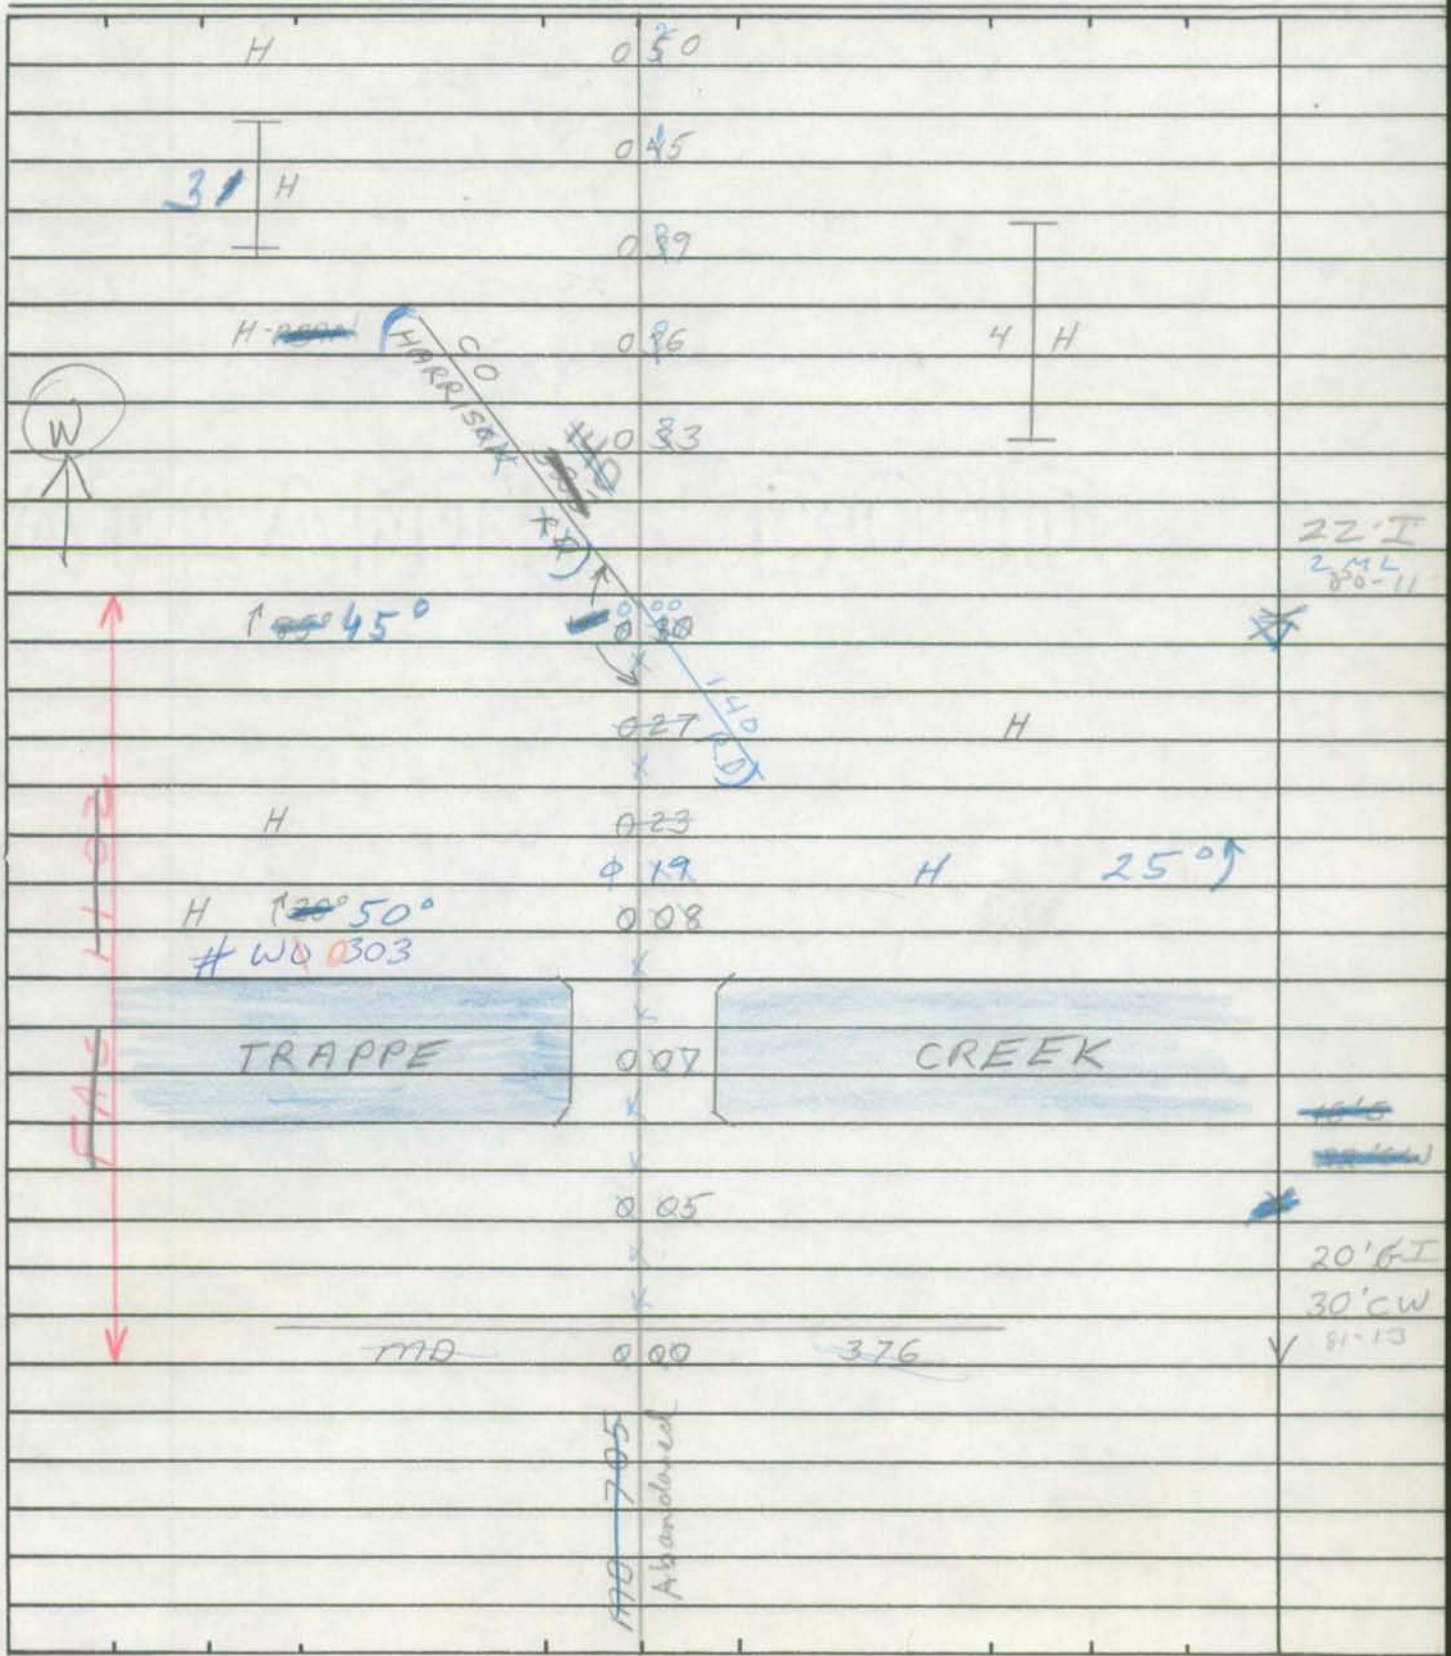

SHA 51.3-8
11-15-72

ROAD INVENTORY SHEET

Road No. CO 143
Road Name TRAPPE RD
Sheet No. 2 OF 3
Date 10-3-74
County WORCESTER
State Coordinates

H

~~SHOP RD~~

0X71 OF 15

~~0X~~ H

~~0X~~ H

0196 WOR. CO. SUC. GARAGE

~~0X~~ HALL

~~0X~~ H

Henry ~~ROAD~~

0185 ~~0X~~ ~~0X~~ CO 672

~~0X~~ H

~~0X~~ H

BASS ~~PVT RD~~ LANE

~~0X 0P 0.12 F~~ 378
@.78

0169 H

0166 H

0168 H

0189 H

(Bass La ~~PVT RD~~)

0570P ~~0.10~~ H 378
@.00

SHA 51.3-8
11-15-72

STATE HIGHWAY ADMINISTRATION OF MARYLAND

96-COORDS CO/RS 1-15-97

ROAD INVENTORY SHEET

Party Chief _____
Recorder _____
Helper C. MARTIN

Map No. GH 24

Road No. CO 143
Road Name TRAPPE RD
Sheet No. 3 OF 3
Date 10-3-74
County WORCESTER
State Coordinates _____

T. LANDIS FIELDS VERIFIED 77

GERMANTOWN (ROAD #7)
CO OX0878 ~~145~~ 324

H ~~DAS~~ H

H ~~DR2~~ H SAME

SHA 51.3-8
11-15-72

ROAD INVENTORY SHEET

Road No. _____
Road Name _____
Sheet No. _____
Date _____
County _____
State Coordinates _____

Form HPS 5

STATE HIGHWAY ADMINISTRATION OF MARYLAND

IN COOPERATION WITH
FEDERAL HIGHWAY ADMINISTRATION

BRIDGE SHEET

ROAD NO. 3143

SHEET NO. _____

PARTY NO. _____

DATE 12/21/81

COUNTY WORCESTER

RATED CAPACITY 18 Tons (Inventory)

FOR ALL STRUCTURES HAVING A TOTAL OPENING OF MORE THAN 20 FEET AS DEFINED IN NOTE 1.

ODOMETER READING 0.07 NAME OF STREAM, RAILROAD OR HIGHWAY CROSSED Trappe Creek (Trappe Road)

NUMBER OF RAILROAD TRACKS _____

KIND OF CROSSING (NOTE 2) Bridge over Stream

UNDERPASS-SIMPLE UNDERPASS-COMBINED (NOTE 3) OVERPASS BRIDGE OVER SYSTEM

DESCRIPTION

NUMBER OF SPANS	LENGTH EACH SPAN (NOTE 4)	TYPE (NOTE 5)
2	14'0", 11'0"	Timber

TOTAL LENGTH-ON LINE OF ROAD OVER-ALL (NOTE 6) 25'0"

MATERIAL

SUBSTRUCTURE Creosoted Timber SUPERSTRUCTURE Creosoted Timber

FLOOR

CLEARANCES

ROADWAY (NOTE 7) 19'6" SIDEWALK WIDTHS: RIGHT LEFT

SURFACE OF ROAD TO STREAM BED 12'0" FOR OVERPASSES, SHOW DISTANCES TO TOP OF RAIL OR SURFACE OF LOWER ROAD. (NOTE 8)

SURFACE OF ROAD TO BOTTOM PORTAL _____ (MINIMUM OVERHEAD CLEARANCE

CLEAR DISTANCE OF OPENING ABOVE STREAM BED _____ (WATERWAYS ONLY)

POSTED LOAD LIMITS _____ BRIDGE NO. WO-0303 CONSTRUCTION DATE 10/81

GENERAL CONDITION OF BRIDGE: CHECK IF GOOD, FAIR, OR POOR, DESCRIBE DEFECTS IF SERIOUS.

	GOOD	FAIR	POOR
SUPERSTRUCTURE	Good		
FLOOR	Good		
SUBSTRUCTURE	Good		

PAINT BADLY CORRODED OR RUSTED

TYPE OF PROTECTION FOR DRAWBRIDGES _____

SHA 51.3 - 22
10-1-73

(NOTES ON REVERSE SIDE)

Notes:

1. In agreement with Federal-aid standards, a bridge is defined as a structure including supports erected over a depression or an obstruction, as water, highway, or railway, and having a track or passageway for carrying traffic or other moving loads, and having a length measured along the center of roadway of more than 20 feet between undercoping of abutments or spring lines of arches, or extreme ends of openings for multiple boxes and pipes, where the clear distance between openings is less than half of the smaller contiguous opening.

2. Show kind of crossing by checking descriptive item applicable. For multiple-span bridges give complete information on each span including approach spans. Indicate on leg sheet the odometer reading, position, and angle of skew of structure with respect to center line of road and by arrow the direction of stream flow.

3. Give information on the span over the highway only.

4. For span length use center to center of bearings, otherwise the clear opening. Skew bridges will be measured along center line of road. (See note 1.)

5. Show general type such as: Trestle, Truss, Girder, I-Beam, Rigid Frame, Arch, Slab, Suspension, or Covered Bridge.

6. The length of a bridge structure is the over-all length measured along the line of survey stationing back to back of back-walls of abutments, if present, otherwise end to end of bridge floor, but in no case less than the total clear opening of the structure.

7. Give minimum lateral clearance. Where traffic lanes are separated by bridge members, show clearance width of each lane separately. Special conditions should be explained by notes.

8. In case of overhead bracing or arch construction, measurement shall be made to the lowest point above the road surface.

Remarks: _____

_____

Form 6 HPS (Rev. 1961)

91-Co Ex # 3
AL-JK
1-31-92 87-27
AL-KJ
2-3-88

ROAD INVENTORY SHEET

Party Chief F. SETTAN
Recorder T. LANDON
Chairman

T. LANDON VERIFIED 4/14/77

Road No. Co 144
Name EVANS RD
Sheet No. 10F32
Date 12-21-65
County WORCESTER

J18

89-115

	PC	2 22		
	F	2 16		
		2 08	36" CMP	
		2 04		*
	F	1 86		
	F	1 69		22' I
		1 46	24" CMP	
	CEDAR LANE RD.			
	Co. 146	1 45	HT	22' I (91-27)
	H	1 41		*
	PT	1 04		
	30°			
	PC	0 97		
		0 93	48" CMP	
	H	0 77		
N 15°	F	0 62		
		PVT 0 RD 0		78-14
		0 47 12'D		20' F
				17' F
		0 13 F(VAC)		30' CW
	IRONSHIRE STATION	ROAD		2-3' E
	Co.	0 00 321		

Form 6 HPS (Rev. 1961) *Corp limits chg from 1992 map ver. 10/17/94 JK

ROAD INVENTORY SHEET

91-Co ex #3
AL-JK
1-31-92

Party Chief F. SETTAN
Recorder T. LANDAN
Chainman

Road No. Co 144
Name
Sheet No. 2 OF 3
Date 12-21-65
County WORCESTER

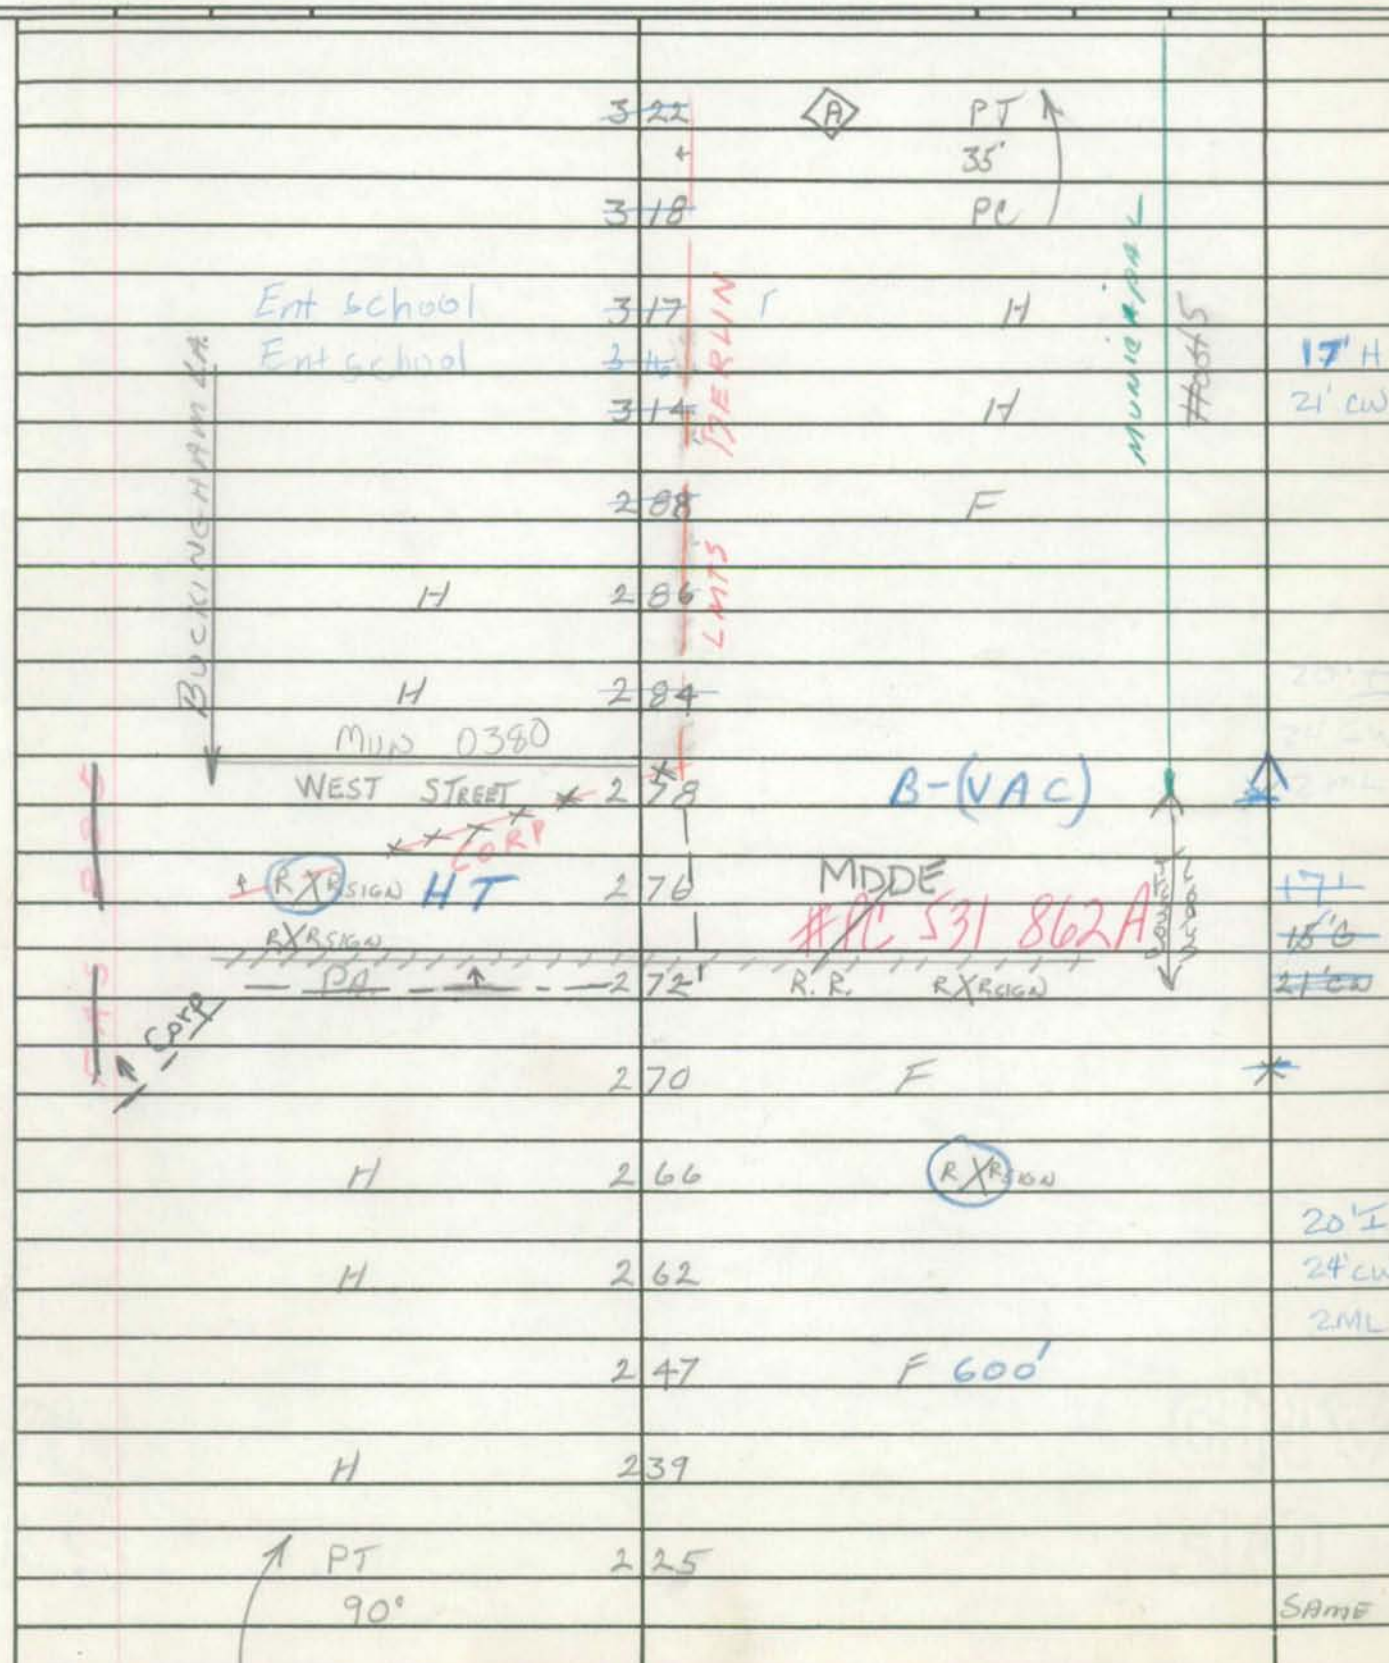

Form 6 HPS (Rev. 1961)

ROAD INVENTORY SHEET

Party Chief F. SETTAN
Recorder T. LANDIN
Chainman

Road No. Co 144
Name
Sheet No. 3 OF 3
Date 12-21-65
County WORCESTER

MD

~~3 31~~ END CEM

818

~~3 24~~ BEG CEM 50' ↑

SAME

SHA 51.3 - 8 Revised
4.83

MARYLAND STATE HIGHWAY ADMINISTRATION

ROAD INVENTORY SHEET

Party Chief _____ Road No. CO 145
Recorder _____ Road Name _____
Assistant _____ County _____
Map No./Dir. 1 Date _____
State Coordinates _____ Sheet No. _____ OF _____

SYSTEM				TRAFFIC		LINE DIAGRAM	TRAFFIC			PAVEMENT DATA
FED. AID.	FUNCT. CLASS.	HWY. SYS.	HPMS SAMPLE	PRK.G. REST.	COM/IND. ACCESS		CONTROL	COM/IND. ACCESS	PRK.G. REST.	
						UNASSIGNED NOW OP 397 (86-30)				

TRAFFIC CODES

TRAFFIC CONTROLS: STOP SIGN=S.S., TRAFFIC LIGHT=T.L., FLASHING RED BALL=F.R.

TRAFFIC CODES

PARKING RESTRICTIONS: A.M. PEAK, P.M. PEAK, A.M./P.M. PEAK, NO PARKING ANYTIME=N.P., COMM/IND. ACCESS=E

SYSTEM				TRAFFIC		LINE DIAGRAM	TRAFFIC				PAVEMENT DATA
FED. AID.	FUNCT. CLASS.	HWY. SYS.	HPMS SAMPLE	PRKG. REST.	COM/IND ACCESS		CONTROL	COM/IND ACCESS	PRKG. REST.		

Form 6 HPS (Rev. 1961)

ROAD INVENTORY SHEET

Party Chief F. SETTAN
Recorder T. LANDON
Chainman

Rev via C.T.C. 12/1/76

1291-186
T. LANDON
F. [illegible]
VERIFIED
4/14/77

89-116
82-12

Road No. C0 146
Name CEDAR LANE RD.
Sheet No. 1 OF 2
Date 12-21-65
County WORCESTER

↑15°		2	36	F 400'
		2	28	18" CMP
				AVT
		2	06	12'D 30 20 0
	F	1	97	0 38 F
	H	1	79	24' F
	H	1	61	
		1	60	X
		1	59	F (91-28) 24' I
	F ~~F~~ F 1000'	1	57	78-15 ~~24' F~~
	H	1	54	
		1	47	24" CMP 15 ↑ ~~18' F~~ 30' CW
		1	23	F 600' ~~2-3 E SH. D.~~
		1	18	X
	#WB 0307 LIBERTY TOWN	1	15	BRANCH SEE BR. SH. 1-A
		1	10	X
	F 700'	0	84	H
				89-116 82-12
SE ↑		0	70	24" CMP 22' I
	H	0	59	30' C-W
	H	0	~~59~~ 047	20° ↑ ~~18' F~~
	A H	0	~~30~~ 24	~~24' C-W~~
	F 30'	0	19 09	15° ↑ ~~24' F~~
V	MD	0	00	374 ~~30' C-W~~

Form 6 HPS (Rev. 1961)

ROAD INVENTORY SHEET

Party Chief F. SETTAN
Recorder T. LANDON
Chainman

Road No. Co 146
Name
Sheet No. 2 OF 2
Date 12-21-65
County WORCESTER

EVANS	ROAD	
Co. 2 55	144	
		SAME

Form 5-HPS (Revised 1961) MARYLAND STATE ROADS COMMISSION PLANNING AND PROGRAMMING DIVISION S26130

IN COOPERATION WITH
U. S. BUREAU OF PUBLIC ROADS

BRIDGE SHEET

ROAD NO. Co 146
SHEET NO. 1-A
PARTY NO.
DATE 12-21-65
COUNTY DORCHESTER

RATED CAPACITY

FOR ALL STRUCTURES HAVING A TOTAL OPENING OF MORE THAN 20 FEET AS DEFINED IN NOTE 1.

ODOMETER READING 1.15 NAME OF STREAM, RAILROAD OR HIGHWAY CROSSED LIBERTYTOWN BRANCH

NUMBER OF RAILROAD TRACKS
KIND OF CROSSING (NOTE 2)

UNDERPASS-SIMPLE UNDERPASS-COMBINED (NOTE 3) OVERPASS BRIDGE OVER SYSTEM

DESCRIPTION

NUMBER OF SPANS	LENGTH EACH SPAN (NOTE 4)	TYPE (NOTE 5)
2	11'	WOOD PILE
1	16'	

TOTAL LENGTH-ON LINE OF ROAD OVER-ALL (NOTE 6) 38'

MATERIAL
SUBSTRUCTURE WOOD SUPERSTRUCTURE WOOD
FLOOR WOOD

CLEARANCES
ROADWAY (NOTE 7) 19' SIDEWALK WIDTHS: RIGHT LEFT

SURFACE OF ROAD TO STREAM BED 10' FOR OVERPASSES, SHOW DISTANCES TO TOP OF RAIL OR SURFACE OF LOWER ROAD. (NOTE 8)
SURFACE OF ROAD TO BOTTOM PORTAL 2' (MINIMUM OVERHEAD CLEARANCE
CLEAR DISTANCE OF OPENING ABOVE STREAM BED 8' (WATERWAYS ONLY)
POSTED LOAD LIMITS BRIDGE NO. 307 CONSTRUCTION DATE

GENERAL CONDITION OF BRIDGE: CHECK IF GOOD, FAIR, OR POOR, DESCRIBE DEFECTS IF SERIOUS.

	GOOD	FAIR	POOR
SUPERSTRUCTURE	✓		
FLOOR	✓		
SUBSTRUCTURE		✓	

PAINT BADLY CORRODED OR RUSTED
TYPE OF PROTECTION FOR DRAWBRIDGES (NOTE 9)

(NOTES ON REVERSE SIDE)

S26130

Notes:

1. In agreement with Federal-aid standards, a bridge is defined as a structure including supports erected over a depression or an obstruction, as water, highway, or railway, and having a track or passageway for carrying traffic or other moving loads, and having a length measured along the center of roadway of more than 20 feet between undercoping of abutments or spring lines of arches, or extreme ends of openings for multiple boxes and pipes, where the clear distance between openings is less than half of the smaller contiguous opening.

2. Show kind of crossing by checking descriptive item applicable. For multiple-span bridges give complete information on each span including approach spans. Indicate on leg sheet the odometer reading, position, and angle of skew of structure with respect to center line of road and by arrow the direction of stream flow.

3. Give information on the span over the highway only.

4. For span length use center to center of bearings, otherwise the clear opening. Skew bridges will be measured along center line of road. See Note 1.

5. Show general type such as: Trestle, Truss, Girder, I-Beam, Rigid Frame, Arch, Slab, Suspension, or Covered Bridge. See illustrations attached. Describe draw spans by classifications listed in Article X, Section 2 of Manual.

6. The length of a bridge structure is the over-all length measured along the line of survey stationing back to back of back-walls of abutments, if present, otherwise end to end of bridge floor, but in no case less than the total clear opening of the structure.

7. Give minimum lateral clearance. Where traffic lanes are separated by bridge numbers, show clearance width of each lane separately. Special conditions should be explained by notes.

8. In case of overhead bracing or arch construction, measurement shall be made to the lowest point above the road surface.

9. Use classification listed on RR crossing sheet. Form 4 HPS.

Remarks: _____

A rearrangement of the form similar to that shown on the attachment may be used to provide space for coding.

SHA 51.3-8
11-15-72

STATE HIGHWAY ADMINISTRATION OF MARYLAND

88-240
88-241
2-3-89
BB, DW
92-1
GD AH
1-12-93

ROAD INVENTORY SHEET

Party Chief I. LANDON
Recorder F. RHODES
Helper

Map No. GH

Road No. CO. 147
Road Name SOUTH POINT RD.
Sheet No. 1 OF 3
Date 4/12/77
County WORCESTER
State Coordinates 1319-145

	1	87	3 H 25° ↑	
	1	76		
Newport Bay Dr CO 431	1	70	H 900'	
	1	~~58~~ 47	~~CRNELL HILL DR~~ CO. 376	
FH (ABAN.)	1	42		
PT 30° PC Heritage ~~Rd~~ CO 432	1	39		
	1	~~37~~ 35	COVE CT. CO. 375	
	1	32		
6 H	1	06	(FOX RUN)	
	1	00	CO. 373	
PT 35° PC	0	90		
	0	84	TERRAPIN POINT CO. 372	
	0	67	11 H	
	0	33	H 800' GATE	
PT 90° PC ~~WATER~~ WATER SIDE DR. CO ~~427~~ 695	0	08		
	0	05	H	
H100' H	0	04		(86-5) 22'I ~~17'G~~ 24'CW V2ML
	0	02	H	
H ROAD BOAT	0	00	END MARINA	

SINEPUXENT BAY

CHINCOTEAGUE BAY

N ↑

SHA 51.3-8
11-15-72

ROAD INVENTORY SHEET

Road No. CO. 147
Road Name SOUTH POINT RD.
Sheet No. 2 OF 3
Date 4/12/77
County WORCESTER
State Coordinates

↑20°	3	60	
PT	3	37	22'I
40°			2 ML
PC CO QUILLIN WAY (86-35) 416	3	32	
	3	23	PT X 22'I
			2-10'I SHDS
	3	Rum Point Lane 280 CO (724)	50° 2 ML
	3	16	X
	3	140 PC	
CO 415 CHANDLER DRIVE (86-34) PROP	2	93 H	
END GOLF COURSE	2	86	
	2	75	
		3 H	
	2	67	
BEG GOLF COURSE	2	55	
COUNTRY CLUB RD. CO. ~~278~~ 283	2	54 (TWIN OAKS DR) (86-30) CO 418	
			~~22'I~~
PT	2	52	
30°	2	49	
PC	2	46	
			22'I
	2	34 (BAY LANDING DR)	PT 2 ML
	2	32 (86-40) CO 419	30°
	2	28	PC
H	2	17 (South Hills Dr)	SAME
	2	02 (86-39) CO 414	

SHA 51.3-8
11-15-72

STATE HIGHWAY ADMINISTRATION OF MARYLAND

ROAD INVENTORY SHEET

Party Chief T. LANDON
Recorder F. RHODES
Helper _____

Map No. _____

Road No. CO. 147
Road Name SOUTH POINT RD.
Sheet No. 3 OF 3
Date 4/12/77
County WORCESTER
State Coordinates _____

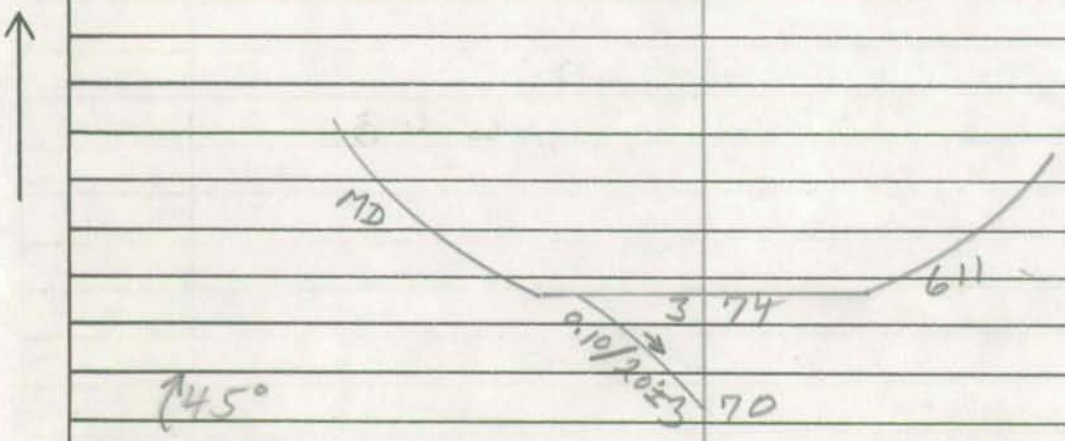

22'I
~~20'I~~
40'CW
2ML
80-8
SAME

SHA 51.3-8
11-15-72

ROAD INVENTORY SHEET

Road No. _____
Road Name _____
Sheet No. _____
Date _____
County _____
State Coordinates _____

Form 6 HPS (Rev. 1961)

1325-175

85-27 BB/AL A.T. 1-28-86

ROAD INVENTORY SHEET

Party Chief F. SETTAN
Recorder T. LANDON
Chainman

T. LANDON
T. JONES
VERIFIED 4/12/77

Road No. Co 148
Name BURBAGE RD
Sheet No. 1 OF 1
Date 12-21-65
County WORCESTER

ROAD	END		
102		F	
076		30° H	
071			
070		H	
069	PVI RD		
063			
059			
000			

PVI

PT
40°
PC

148

S

MD

376

10'E
4'CW

18'F
30'CW

SHA 51.3 - 8 Revised
4.83

MARYLAND STATE HIGHWAY ADMINISTRATION

94 MU EX #1

BERLIN

ROAD INVENTORY SHEET

MU 0120

Party Chief: G. Davis
Recorder: T. Massicot
Assistant:
Map No./Dir.: J-18 / NE
State Coordinates: 1314-184

Road No.: CO 149
Road Name: Flower St
County: Worcester
Date: 1-10-95
Sheet No.: 1 OF 4

99-2mu
98-12mu } Trimeter
98-7 CO }

TRAFFIC CODES
TRAFFIC CONTROLS: STOP SIGN=SS, TRAFFIC LIGHT=T.L., FLASHING RED BALL=F.R.

TRAFFIC CODES
PARKING RESTRICTIONS: A.M. PEAK, P.M. PEAK, A.M./P.M. PEAK, NO PARKING ANYTIME=N.P., COMM/IND. ACCESS=E

SYSTEM				TRAFFIC		LINE DIAGRAM		TRAFFIC			PAVEMENT DATA
FED. AID.	FUNCT CLASS.	HWY. SYS.	HPMS SAMPLE	PRKG. REST.	COM/IND. ACCESS			CONTROL	COM/IND. ACCESS	PRKG. REST.	
						Maple Ave					28'I
											JC-C 2 uml
						0 35 MU 0200				X	26'I
											J crb LT
											2 uml
						0 32				X	
						(Fassett St)					24'I
						OP 360	0 29				2 uml
						0 27 School			E	X	
											24'I
											J crb RT
						Showell St					2 uml
						MU 0320	0 21 School		E	X	
						0 18 2-24" CMP	0				
							2				
					E		0 16	1			23'I
								0			2 uml
						0 15				X	
					E	Henry Perk	0 13	M			
								U			
						↑30°	0 10				
					2E	To T.H.	0 06				27'I
											J crb LT
						0 02				X	
						Bay St					32'I
						Md	0 00 376		SS		JC-C 2 uml

SYSTEM: FED. AID. | FUNCT. CLASS. | HWY. SYS. | HPMS SAMPLE

TRAFFIC: PRKG. REST. | COM/IND ACCESS

LINE DIAGRAM

TRAFFIC: CONTROL | COM/IND ACCESS | PRKG. REST.

PAVEMENT DATA

T — T — T — T — T — T —

0 77

0 75 3-72" CMP

24·I

2 ML

Sign: Beg. Co. Maint. 0 73 Limits ↓Corp off Berlin ↓

AV 0 48

Railroad 0300

MU

24·I

2 UML

Schoolfield St

Branch St 0 46 MU 0310

MU 0330

28·I

J C-C

Church 0 38

2 UML

Form 6 HPS (Rev. 1961)

ROAD INVENTORY SHEET

Party Chief F. SETTAN
Recorder T. LANDON
Chainman

Road No. Co 149
Name
Sheet No. 3 ~~2~~ OF ~~3~~ 4
Date 12-22-65
County WORCESTER

	119	H	
	116	H	
	115 (MILL	H	Haven Rd)
	114 ENT. COUNTY DUMP		
↑20°	111 ~~Co~~ Co. 400 ~~383~~	H	
	109		24" CMP
Ned Purnell Lane			
Put H Drive	107		
H- ~~[illegible]~~	105		
		6 H	
H 600'	104 MONEYSUCKLE	RD	
Rose La	101 CO 681		90-26
Put 5 H Rd	099		
	098		
H	095		
H	094	H	24" I
			2 ML
	092	H	
			~~20' F~~
H (ABAN.)	091	H	~~20' CP~~
			~~2 ML~~
	088	H	
			~~Stone~~
	087		18" CMP
H	085		~~Stone~~

Form 6 HPS (Rev. 1961)

ROAD INVENTORY SHEET

Party Chief F. SETTAN
Recorder T. LANDON
Chainman

Road No. Co 149
Name
Sheet No. 4 8 OF 5 4
Date 12-22-65
County WORCESTER

(Seahawk ~~STEPHEN DECATUR HIGH SCHOOL~~ ROAD)

Mu ~~Co~~ 0305

1 58 Co 150 55 Mu

1 51 ≥ H

1 48 H

Peach Kane

1 46 Pvt ~~X~~ Rd

1 44 HT

Mu 0120

~~1 42~~

Corp Limits

1 34 of

~~1 31~~ ~~Hood~~

15°

1 29 H

1 26 H

1 25 H-300'

SHA 51.3 - 8 Revised
4.83

FCR 95

MARYLAND STATE HIGHWAY ADMINISTRATION

ROAD INVENTORY SHEET Berlin Mu 0305

Party Chief GD
Recorder AH
Assistant
Map No./Dir. J 18 / S
State Coordinates 1319 - 191

Road No. Co 150
Road Name SEAHAWK RD
County WORCESTER
Date 4/18/95
Sheet No. 1 OF 3

98-1 (mu) } Transfer
98-6 (CO) }
89-60

TRAFFIC CODES
TRAFFIC CONTROLS: STOP SIGN=SS, TRAFFIC LIGHT=T.L., FLASHING RED BALL=F.R.

TRAFFIC CODES
PARKING RESTRICTIONS: A.M. PEAK, P.M. PEAK, A.M./P.M. PEAK, NO PARKING ANYTIME=N.P., COMM/IND. ACCESS=E

SYSTEM: FED. AID.	SYSTEM: FUNCT. CLASS.	SYSTEM: HWY. SYS.	SYSTEM: HPMS SAMPLE	TRAFFIC: PRKG. REST.	TRAFFIC: COM/IND. ACCESS	LINE DIAGRAM	TRAFFIC: CONTROL	TRAFFIC: COM/IND. ACCESS	TRAFFIC: PRKG. REST.	PAVEMENT DATA
	K	Rural	Minor Collector			MARY RD'				
						Co 151 0 62				
						Limits — FLOWER of Berlin — ST				
						0 48 ~~00~~ ~~049~~ Mu 0120 @1.58				
						PT R31 0 35				
						30°				
						PC 0 28				
						0 18		E		24'I
						0 15 PKG LOT		E		2ML
				E		SHOPPING CTR 0 11			X	
						0 09 STEVEN DECATUR H.S. 03 05		E		
				E		SHOPPING CTR 0 07				55'I
						01/20I JCC 0 01				JcLT 2ML
						US 000 50	TL			
						Town Limits — of Berlin @8.38 (R)				
						MD 376 @ 0.00				

SYSTEM: FED. AID. | FUNCT. CLASS. | HWY. SYS. | HPMS SAMPLE
TRAFFIC: PK.G. REST. | COM/IND ACCESS

LINE DIAGRAM

TRAFFIC: CONTROL | COM/IND ACCESS | PK.G. REST.
PAVEMENT DATA

Rural
Minor Collector

MAPLE CT
CO 153 1 71

OAK CT
CO 152 1 63

REDWOOD LA
PVT DR 1 57

1 18 36" CMP

1 14 DT

35°

1 04 PC

30°

0 63

24' I
2 WL

SHA 51.3 - 8 Revised
4.83

MARYLAND STATE HIGHWAY ADMINISTRATION

ROAD INVENTORY SHEET

Party Chief: GD
Recorder: AH
Assistant:
Map No./Dir.: J-18 / S
State Coordinates:

Road No.: Co 150
Road Name: SEAHAWK RD
County: WORCESTER
Date: 4/18/95
Sheet No.: 3 OF 3

SYSTEM				TRAFFIC		LINE DIAGRAM	TRAFFIC			PAVEMENT DATA
FED. AID.	FUNCT. CLASS.	HWY. SYS.	HPMS SAMPLE	PRKG. REST.	COM/IND. ACCESS		CONTROL	COM/IND. ACCESS	PRKG. REST.	
	7									
	1					SINEPUXENT RD				
						CO 197 154				
										24'I
										OML
						175 36" CMP				
	Rural Minor Collector									

TRAFFIC CODES

TRAFFIC CONTROLS: STOP SIGN=SS, TRAFFIC LIGHT=T.L., FLASHING RED BALL=F.R.

TRAFFIC CODES

PARKING RESTRICTIONS: A.M. PEAK, P.M. PEAK, A.M./P.M. PEAK, NO PARKING ANYTIME=N.P., COMM/IND. ACCESS=E

SYSTEM				TRAFFIC		LINE DIAGRAM	TRAFFIC			PAVEMENT DATA
FED. AID.	FUNCT. CLASS.	HWY. SYS.	HPMS SAMPLE	PRK.G. REST.	COM/IND ACCESS		CONTROL	COM/IND ACCESS	PRK.G. REST.	