KENT COUNTY

STATE ROADS

SHA 51.3 - 8 Revised
4.83

MARYLAND STATE HIGHWAY ADMINISTRATION

SR.00
4-25-00
GD/EF

ROAD INVENTORY SHEET

95 STATE REINVENTORY TM/BB 6-5-95
95-1ST BB/AH 1-23-95
90 EX#1 90-14
1-10-91 1-10-91
BB/TM BB/TM

Party Chief: CG
Recorder: L W
Assistant: Rewritten 4-5-00 WS
Map No./Dir.: E14 D14 / E
State Coordinates:

Road No.: MD 20
Road Name: ROCK HALL AVE
County: KENT
Date: 6-8-89
Sheet No.: 1 OF 16

TRAFFIC CODES
TRAFFIC CONTROLS: STOP SIGN-SS, TRAFFIC LIGHT=T.L., FLASHING RED BALL=F.R.

TRAFFIC CODES
PARKING RESTRICTIONS: A.M. PEAK, P.M. PEAK, A.M./P.M. PEAK, NO PARKING ANYTIME=N.P., COMM/IND. ACCESS=E

SYSTEM				TRAFFIC		LINE DIAGRAM	TRAFFIC			PAVEMENT DATA
	FUNCT CLASS	HWY SYS	HPMS SAMPLE	PEDG. REST.	COM/IND. ACCESS		CONTROL	COM/IND. ACCESS	PEDG. REST.	
	K	RURAL MAJOR COLLECTOR	STATE SECONDARY		E	10' I 0038 NEW ST 0026 0020 S.L. 30MPH COLEMAN RD 0015 MU 0086 0008 Begin State Maintenance Sign 0001 BEACH RD 0017 LAWTON AVE MU 0173 0000 ROCK HALL AVE CD 155	SS			22' I 6' F SHD RT 3' F SHD LT 2 ML

COUNTY KENT ROAD NO. MD 20 PAGE 2 OF 16

SYSTEM: FUNCT CLASS — RURAL MAJOR COLLECTOR; HWY SYS — STATE SECONDARY; NHS; SAMPLE

TRAFFIC: PREG. REST.; COMMUNITY ACCESS

LINE DIAGRAM

TRAFFIC: FOREIGN; COMMUNITY ACCESS; PREG. REST.

PAVEMENT DATA

DOWNEY AVE
1 23 MU 0100
22'I
8'I SHD RT
2ML

HENRY AVE
MU 0150 1 21

1 11
22'I
6'F SHD RT
2ML

COTTAGE AVE
MU 0090 1 05

N HAWTHORNE AVE
MU 0130 0 91

S HAWTHORNE AVE
0 90 MU 0140

0 62

HAVEN CT
0 60 MU 0115
12'I

0 57
22'I
6'F SHD RT
3'F SHD LT
2ML

0 54

E
0 51

0 42 RT

E
0 40

U-TURN

SHA 51.3 - 8 Revised
4.83

MARYLAND STATE HIGHWAY ADMINISTRATION

ROAD INVENTORY SHEET

Party Chief CG
Recorder LW
Assistant REWRITTEN 4-5-00 WS
Map No./Dir. E14 D14 / E
State Coordinates

Road No. MD 20
Road Name ROCK HALL AVE / ROCK HALL RD
County KENT
Date 6-8-89
Sheet No. 3 OF 16

TRAFFIC CODES
TRAFFIC CONTROLS: STOP SIGN-SS, TRAFFIC LIGHT=T.L., FLASHING RED BALL=F.R.

TRAFFIC CODES
PARKING RESTRICTIONS: A.M. PEAK, P.M. PEAK, A.M./P.M. PEAK, NO PARKING ANYTIME=N.P., COMM/IND. ACCESS=E

SYSTEM: FUNCT CLASS	SYSTEM: HWY SYS	SYSTEM: HPMS SAMPLE	TRAFFIC: PREG. REST.	TRAFFIC: COM/IND ACCESS	LINE DIAGRAM	TRAFFIC: CONTROL	TRAFFIC: COM/IND ACCESS	TRAFFIC: PREG. REST.	PAVEMENT DATA
				E	1 46				
					WILLIAMS ST				
					MU 0200 1 45		E		
									24' I
									2-12' I SHD
RURAL MINOR ARTERIAL		200200000138		E	1 43		2E		2ML
					1 40		E		
					ATC 105				
					N MAIN ST S MAIN ST				
X					MD 1 38 445	FY			
							4' J		
					1 37				
					1 34		E		
				E	1 33				22' I
									10' I SHD RT
				J	LIBERTY ST				9' I SHD LT
RURAL MAJOR COLLECTOR					1 31 MU 0180				(41' I SHD)
									2ML
					1 29				
									22' I
									8' I SHD RT
									2ML

COUNTY KENT ROAD NO. MD 20 PAGE 4 OF 16

LINE DIAGRAM

SYSTEM: FUNCT CLASS	SYSTEM: HWY SYS (NHS)	TRAFFIC: PREG. REST.	TRAFFIC: COM/IND ACCESS	ROAD		TRAFFIC: SCHOOL	TRAFFIC: COM/IND ACCESS	TRAFFIC: PREG. REST.	PAVEMENT DATA
RURAL MINOR ARTERIAL	STATE SECONDARY			ROCK HALL RD					~~24'I ON TAPER TO 34'I~~
									~~12'I SHD RT~~
					10± RT				~~10'I SHD LT~~
									~~2 ML~~
					PC				
				CORP LIMITS OF	84 ROCK HALL				24'I
									2-10'I SHD
									2 ML
					1 69				
					1 68				
				ROCK HALL AVE					
					1 67		E		
					1 65		E		
					1 64		E		
					1 54				
					1 51				
					1 50				
					1 49				24'I
					JUDEFIND AVE 40 MPH 0160				2-12'I SHDS
					1 48 MU				2 ML

2002000000138

SHA 51.3 - 8 Revised
4.83

MARYLAND STATE HIGHWAY ADMINISTRATION

ROAD INVENTORY SHEET

Party Chief: CG
Recorder: L W
Assistant: Rewritten 4-7-00 WS
Map No./Dir.: D14 / E
State Coordinates:

Road No.: MD 20
Road Name: ROCK HALL RD
County: KENT
Date: 6-8-89
Sheet No.: 5 OF 16

TRAFFIC CODES

TRAFFIC CONTROLS: STOP SIGN-SS, TRAFFIC LIGHT=T.L., FLASHING RED BALL=F.R.

TRAFFIC CODES

PARKING RESTRICTIONS: A.M. PEAK, P.M. PEAK, A.M./P.M. PEAK, NO PARKING ANYTIME=N.P., COMM/IND. ACCESS=E

SYSTEM				TRAFFIC		LINE DIAGRAM	TRAFFIC			PAVEMENT DATA
	FUNCT CLASS	HWY. SYS	HPMS SAMPLE	PREG. REST.	COM/IND ACCESS		CONTROL	COM/IND ACCESS	PREG. REST.	
	RURAL MINOR ARTERIAL	STATE SECONDARY								

2 04
(CROSBY RD)
2 03 MD 288
BYPASS 10'I
2 01
10'I CTL
1.99
PT
1 91
60°
10'I CTL
1 89
SPUR .01 12'I
W SHARP
1 88 MD
60°
10'I CTL

24'I
2-10' I SHD
2 ML
2-13' I
2-10' I SHD
10'I (PNT MED)
2 ML
24'I
2-12' I SHD
2 ML

COUNTY KENT ROAD NO. MD 20 PAGE 6 OF 16

LINE DIAGRAM

SYSTEM: FUNCT CLASS	SYSTEM: HWY SYS	SYSTEM: NHS	SYSTEM: SAMPLE	TRAFFIC: PREG. REST.	TRAFFIC: COM/IND ACCESS	LINE DIAGRAM	TRAFFIC: CONTROL	TRAFFIC: COM/IND ACCESS	TRAFFIC: PREG. REST.	PAVEMENT DATA
RURAL MINOR ARTERIAL	STATE SECONDARY				E	3 00				24'I
										2-8'I SHD
										2 ML
						2 54 END CEM		E	X	
										24'I
						2 50 CHURCH				B'I SHD LT
										3'I SHD RT
										2 ML
						2 44		E	X	
						2 41 BEG CEM PT				
						2 37 30°		E		
						2 32 PC				
										24'I
										2-8'I SHD
										2 ML
						2 12 ~~S.L. 40 MPH~~				
					E	2 07			X	
										24'I
						2 06				2-10'I SHD
										2 ML

SHA 51.3 - 8 Revised
4.83

MARYLAND STATE HIGHWAY ADMINISTRATION

ROAD INVENTORY SHEET

Party Chief: CG
Recorder: LW
Assistant: —
Map No./Dir.: 1
State Coordinates:

Road No.: MD 20
Road Name: Rock Hall RD
County: KENT
Date: 6-8-89
Sheet No.: 7 OF 16

TRAFFIC CODES
TRAFFIC CONTROLS: STOP SIGN=SS, TRAFFIC LIGHT=T.L., FLASHING RED BALL=F.R.

TRAFFIC CODES
PARKING RESTRICTIONS: A.M. PEAK, P.M. PEAK, A.M./P.M. PEAK, NO PARKING ANYTIME=N.P., COMM/IND. ACCESS=E

SYSTEM				TRAFFIC		LINE DIAGRAM	TRAFFIC			PAVEMENT DATA
FED. AID.	FUNCT. CLASS.	HWY. SYS.	HPMS SAMPLE	PRKG. REST.	COM/IND. ACCESS		CONTROL	COM/IND. ACCESS	PRKG. REST.	
						3 64 "36" CMP				
						3 56 S.L. 50MPH				
						3 42 EDESVILLE CO (92-30 CO) PARSLEY NECK RD 100				
						3 38 LOVERS LANE RD 102 CO. (92-31)				
						FAS 1284 RURAL MINOR ARTERIAL				
						3 33				
						3 28 PT		E		
						PT				
						3 25 JOHNSON CO AVE 295				
						MARTIN WIGGER RD 104 400 CO				
						3 09 PC				
										~~28' I~~
										~~2 SHD~~
										~~2 ML~~
										*
										24 'I
										2.8 E SHD ~~RT~~
										~~6' G SHLD~~
										2ML

SYSTEM				TRAFFIC		LINE DIAGRAM	TRAFFIC			PAVEMENT DATA
FED. AID.	FUNCT. CLASS.	HWY. SYS.	HPMS SAMPLE	PRKG. REST.	COM/IND ACCESS		CONTROL	COM/IND ACCESS	PRKG. REST.	
						6 11 36" CMP				
						5 84 ~~48~~ ~~36~~" CMP D-1'				
						RD 233 (92-450) RICAUDS BR ~~LANCASTER~~				
						5 ~~90~~ 92 CO.				
										22'I
										2-9'I SHD
										2 ML
						SHIPYARD 5 40 CREEK #14001			X	
						REESES CORNER RD. CO. 98 4 88				
						4 55 48" CMP D-1'				
						4 91 SHIPYARD CO LANE 99				4 28'I
										2-8'~~S~~ I SHD
										2 ML

FAS 1284
RURAL MINOR ARTERIAL

D14
4
E14

SHA 51.3 - 8 Revised
4.83

MARYLAND STATE HIGHWAY ADMINISTRATION

ROAD INVENTORY SHEET

Party Chief: C G
Recorder: L W
Assistant: —
Map No./Dir.: 1
State Coordinates:

Road No.: MD 20
Road Name: Rock Hall RD
County: KENT
Date: 6-8-89
Sheet No.: 9 OF 16

TRAFFIC CODES
TRAFFIC CONTROLS: STOP SIGN=SS, TRAFFIC LIGHT=T.L., FLASHING RED BALL=F.R.

TRAFFIC CODES
PARKING RESTRICTIONS: A.M. PEAK, P.M. PEAK, A.M./P.M. PEAK, NO PARKING ANYTIME=N.P., COMM/IND. ACCESS=E

SYSTEM				TRAFFIC		LINE DIAGRAM	TRAFFIC			PAVEMENT DATA
FED. AID.	FUNCT. CLASS.	HWY. SYS.	HPMS SAMPLE	PRK.G. REST.	COM/IND. ACCESS		CONTROL	COM/IND. ACCESS	PRK.G. REST.	
	RURAL MINOR ARTERIAL				E	7 75 A.T.&T. MICROWAVE TOWER				
						HISTORICAL SIGN 6 87				
						6 65				
						(TOLCHESTER BEACH Rd) ~~Sandy Bottom~~ MD 21				
						6 60 SANDY BOTTOM CO. RD 79				
					E	6 58		E		
						6 56		E		
						6 53				
										22'I
										2-9'I SHD
										2 ML

LINE DIAGRAM

SYSTEM				TRAFFIC		TRAFFIC			PAVEMENT DATA
FED. AID.	FUNCT. CLASS.	HWY. SYS.	HPMS SAMPLE	PRKG. REST.	COM/IND ACCESS	CONTROL	COM/IND ACCESS	PRKG. REST.	
FAS 1284	RURAL MINOR ARTERIAL								

852 E

849 E

847 E

817 36" CMP D-4'

798

795 XX

793

789

785

MD

298

MD

298.13

ON 3 HD ETL

BYPASS, LANE ON 3 HD

22' I

2-9'ISHD

2 ML

SHA 51.3 - 8 Revised
4.83

MARYLAND STATE HIGHWAY ADMINISTRATION

ROAD INVENTORY SHEET

CHESTERTOWN RD

Party Chief C G
Recorder L W
Assistant —
Map No./Dir. 1
State Coordinates

Road No. MD 20
Road Name ROCK HALL RD
County KENT
Date 6-8-89
Sheet No. 11 OF 16

SYSTEM: FED. AID. | FUNCT. CLASS. | HWY. SYS. | HPMS SAMPLE
TRAFFIC: PRKG. REST. | COM/IND. ACCESS

LINE DIAGRAM

TRAFFIC: CONTROL | COM/IND. ACCESS | PRKG. REST.

PAVEMENT DATA

TRAFFIC CODES
TRAFFIC CONTROLS: STOP SIGN=SS, TRAFFIC LIGHT=T.L., FLASHING RED BALL=F.R.

TRAFFIC CODES
PARKING RESTRICTIONS: A.M. PEAK, P.M. PEAK, A.M./P.M. PEAK, NO PARKING ANYTIME=N.P., COMM/IND. ACCESS=E

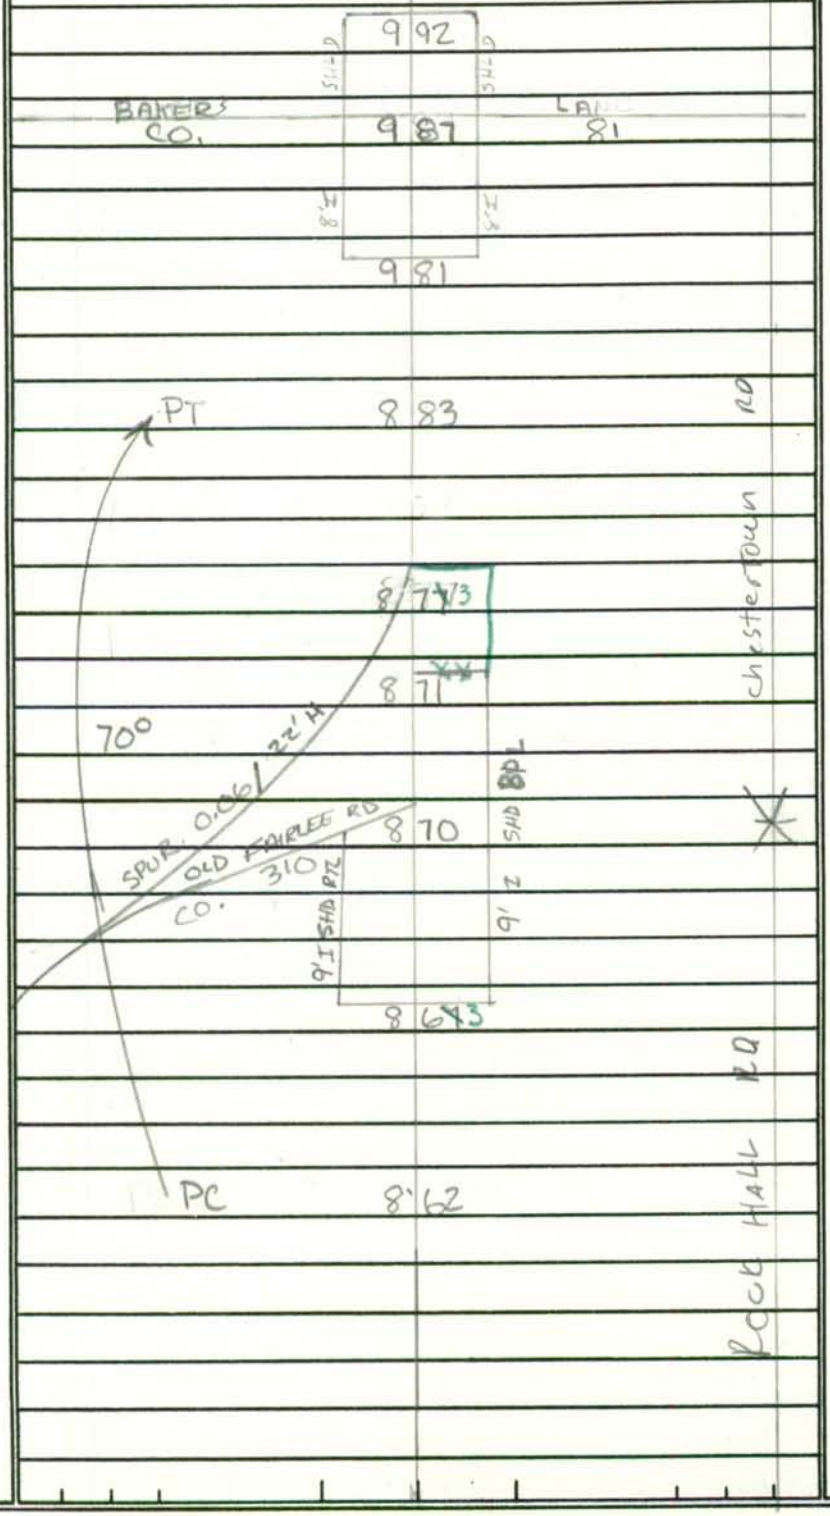

22' I
2-9½ SHD
2 ML

SYSTEM: FED. AID. | FUNCT. CLASS. | HWY. SYS. | HPMS SAMPLE
TRAFFIC: PRKG. REST. | COM/IND ACCESS

LINE DIAGRAM

TRAFFIC: CONTROL | COM/IND ACCESS | PRKG. REST.

PAVEMENT DATA

FAS 1284
RURAL MINOR ARTERIAL

1102 BELL ROSE LA. CO. 330

1096

8' I SHD

1093

STOCKTON START RD CO 75

1091

EARL NICHOLSON RD CO 74

8' I SHD

1089

1088

1059 48" CMP

1057 MT HOPE RD CO. 339

22'I
2-9'ISHD
2 ML

SHA 51.3 - 8 Revised
4.83

MARYLAND STATE HIGHWAY ADMINISTRATION

ROAD INVENTORY SHEET

Party Chief C G
Recorder C W
Assistant —
Map No./Dir. 1
State Coordinates

Road No. MD 20
Road Name (CHESTERTOWN RD)
County Kent
Date 6-8-89
Sheet No. 13 OF 16

SYSTEM: FED. AID. | FUNCT. CLASS. | HWY. SYS. | HPMS SAMPLE
TRAFFIC: PRKG. REST. | COM/IND. ACCESS

LINE DIAGRAM

TRAFFIC: CONTROL | COM/IND. ACCESS | PRKG. REST.

PAVEMENT DATA

FAS 1284
RUNAC MINOR ARTERIAL

11 68
11 61
8' I SHD
11 60
BROAD NECK RD
MD 446
8' I SHD
11 58
11 55
11 34
8' I SHD
CAMP CO RD 211
11 30

22' I
2-9 I SHD
2 ML

TRAFFIC CODES

TRAFFIC CONTROLS: STOP SIGN=SS, TRAFFIC LIGHT=T.L., FLASHING RED BALL=F.R.

TRAFFIC CODES

PARKING RESTRICTIONS: A.M. PEAK, P.M. PEAK, A.M./P.M. PEAK, NO PARKING ANYTIME=N.P., COMM/IND. ACCESS=E

SYSTEM: FED. AID. | FUNCT. CLASS. | HWY. SYS. | HPMS SAMPLE

TRAFFIC: PRKG. REST. | COM/IND ACCESS

LINE DIAGRAM

TRAFFIC: CONTROL | COM/IND ACCESS | PRKG. REST.

PAVEMENT DATA

FAS 1284

RURAL MINOR ARTERIAL

D15

D14

12 72

10'I

ORCHARD DR

CO 352

12 66

12 62

12 50 PT

EAST FORK

12 45

LANGFORD CREEK

#14002

12 39 BRIGGS MILL RD 50°

XXX CO 83

ABAN SECT. AMD 20

12 33

12 26 PC

PT 11 98

30°

PC 11 89

22'I

2-9½SHD

2 ML

SHA 51.3 - 8 Revised
4.83

MARYLAND STATE HIGHWAY ADMINISTRATION

ROAD INVENTORY SHEET

Party Chief: CG
Recorder: LW
Assistant:
Map No./Dir.: DIS / E
State Coordinates:

Road No.: MD 20
Road Name: HIGH ST
County: KENT
Date: 6-8-89
Sheet No.: 15 OF 16

TRAFFIC CODES
TRAFFIC CONTROLS: STOP SIGN=SS,
TRAFFIC LIGHT=T.L.,
FLASHING RED BALL=F.R.

TRAFFIC CODES
PARKING RESTRICTIONS: A.M. PEAK,
P.M. PEAK, A.M./P.M. PEAK, NO PARKING
ANYTIME=N.P., COMM/IND. ACCESS=E

SYSTEM				TRAFFIC		LINE DIAGRAM	TRAFFIC			PAVEMENT DATA
FED. AID.	FUNCT. CLASS.	HWY. SYS.	HPMS SAMPLE	PRK.G. REST.	COM/IND. ACCESS		CONTROL	COM/IND. ACCESS	PRK.G. REST.	
	EAS 1284							E		22'I
	RURAL MINOR ARTERIAL									2-9½SHD
										2 ML

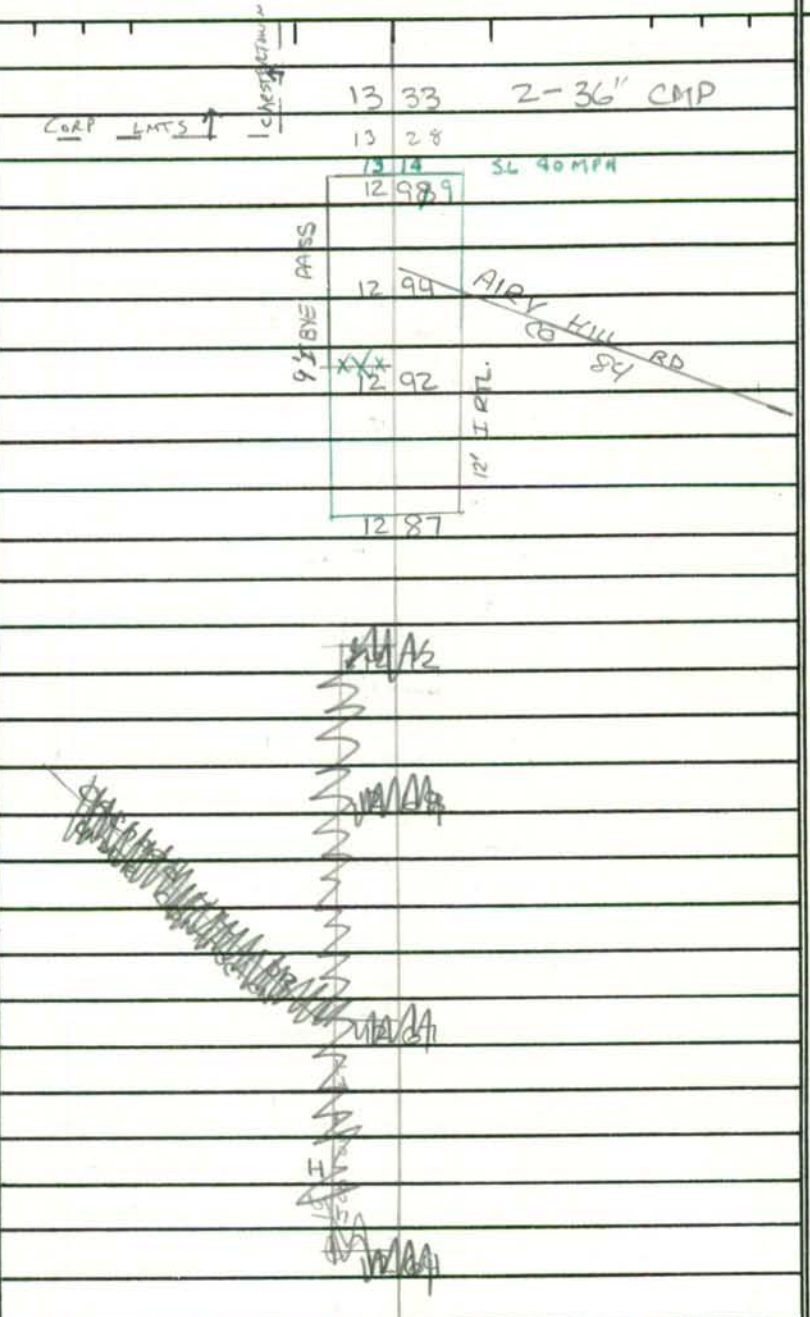

SYSTEM: FED. AID. | FUNCT. CLASS. | HWY. SYS. | HPMS SAMPLE
TRAFFIC: PRKG. REST. | COM/IND ACCESS

LINE DIAGRAM

TRAFFIC: CONTROL | COM/IND ACCESS | PRKG. REST.

PAVEMENT DATA

FAS 1284
RURAL MINOR ARTERIAL

HIGH ST
MU
0.50
MORGNEC RD
MD 291
13 74
001/18'I JGC SPUR
13 71
HIGH ST
13 63
MDOT 526-455
CHESTERTOWN
RADCLIFFE
13 61
CREEK
#14003
34'I JCB RT
(44'I JCC)
2ML
10'I RT JOB OUT
13 59
RXR
ROADWAY
13 57
10'I RT BYPASS
CHESTERTOWN RD
13 55
(FLAT LAND RD)
514
MD
13 52 43
22'I
2-9'SHD
2 ML

SHA 51.3 - 8 Revised
4.83

MARYLAND STATE HIGHWAY ADMINISTRATION

95 STATE REINVENTORY 6-2-95 TM/BB TRANSFER LETTER 6-1-97

ROAD INVENTORY SHEET

Party Chief G. G
Recorder L W
Assistant rewritten 5-26-93
Map No./Dir. D 14 / E
State Coordinates

Road No. MD 21
Road Name ~~Sandy Bottom RD~~ TOLCHESTER Beach Rd.
County KENT
Date 6-5-89
Sheet No. 1 OF 2

SR 00
4-25-00
GD/EF

TRAFFIC CODES
TRAFFIC CONTROLS: STOP SIGN=SS, TRAFFIC LIGHT=T.L., FLASHING RED BALL=F.R.

TRAFFIC CODES
PARKING RESTRICTIONS: A.M. PEAK, P.M. PEAK, A.M./P.M. PEAK, NO PARKING ANYTIME=N.P., COMM/IND. ACCESS=E

SYSTEM				TRAFFIC		LINE DIAGRAM	TRAFFIC			PAVEMENT DATA
FED. AID.	FUNCT CLASS.	HWY. SYS.	HPMS SAMPLE	PRKG. REST.	COM/IND. ACCESS		CONTROL	COM/IND. ACCESS	PRKG. REST.	
						1 67 36" cmp				
						1 25 PT				
						40°				
						1 16 PC				
						0 11 3-18" cmp				
						0 05 S.L. 50 MPH				23' I
										2 ML
						Bayshore RD (Tolchester RD)				
						CO 116 0 00 MD 445				
						TOLCHESTER Beach Rd 359				
						CO				

NON F A
Rural minor collector

SYSTEM				TRAFFIC		LINE DIAGRAM	TRAFFIC			PAVEMENT DATA
FED. AID.	FUNCT. CLASS.	HWY. SYS.	HPMS SAMPLE	PRKG. REST.	COM/IND ACCESS		CONTROL	COM/IND ACCESS	PRKG. REST.	
NON FA	Rural Minor Collector					SANDY BOTTOM RD CC 79 Rock Hall MD 2 42 RD 20 2 36 1 84 Caulks Field RD 10 76 1 83 700 1 77	SS	2E		23'I 2mn

SHA 51.3 - 8 Revised
4.83

MARYLAND STATE HIGHWAY ADMINISTRATION

ROAD INVENTORY SHEET

93-1 ST SR.00
GD. A.H 4-26-00
11-8-93 GD/LF

TABBED 90-1
1-10-91
BB/TM
95-2 ST
BB A.H
11/9/95
DS State
RE/NV.
6-8-95

89-1
BB/BB
1-30-90

TM/BB

90-2
1-10-91
BB/TM

Party Chief: C G
Recorder: LW
Assistant: —
Map No./Dir.: D15 / N-NE
State Coordinates:

Road No.: MD 213
Road Name: (MAPLE AVE)
County: KENT
Date: 6-21-89
Sheet No.: 1 OF 23

TRAFFIC CODES
TRAFFIC CONTROLS: STOP SIGN=SS, TRAFFIC LIGHT=T.L., FLASHING RED BALL=F.R.

TRAFFIC CODES
PARKING RESTRICTIONS: A.M. PEAK, P.M. PEAK, A.M./P.M. PEAK, NO PARKING ANYTIME=N.P., COMM/IND. ACCESS=E

SYSTEM				TRAFFIC		LINE DIAGRAM	TRAFFIC			PAVEMENT DATA
FED. AID.	FUNCT CLASS.	HWY. SYS.	HPMS SAMPLE	PRKG. REST.	COM/IND. ACCESS		CONTROL	COM/IND. ACCESS	PRKG. REST.	
					E	0 31				
						0 30				
				NP	E	0 29		E		36'I
										J-C-C
										2 ML
						QUEEN ST. MU 0 26 260			NP	X
								4' JS		25'I
										J-C-C
										2 ML
				4' JS		WATER ST. MU 380 0 19 MU 381				X
						0 16		X		20'I
						0 15		K5		J-C-C
						CORP LMTS — CHESTERTOWN				2 ML
						0 14				X
						0 07 END Draw Span		4' JS		4'JSIDEWALK
										24'
										~~20~~'J
						0 05 Beg Draw Span				3'NJB RT
										J-CB LT
						#14027				2 ML
FAS 1287	RURAL MINOR ARTERIAL	STATE SECONDARY				KENT CO. QUEEN ANNES CHESTER 0 00 CO RIVER LINE LINE				
						0.17 213				
						QUEEN LINE				
						(ANGLE ST.) LINE HERMAN HUG MD 0.25				
						ANTHONY RD.				
						G.A. CO. # 1				

LINE DIAGRAM

SYSTEM: FED. AID. | FUNCT. CLASS. | HWY. SYS. | HPMS SAMPLE

FAS 1287
RURAL MINOR ARTERIAL
STATE SECONDARY

TRAFFIC: PKG. REST. | COM/IND ACCESS

TRAFFIC: CONTROL | COM/IND ACCESS | PKG. REST.

PAVEMENT DATA

Kent MU ~~CIRCLE 0160~~ 0.58 ~~KENT MU~~ WEST ST. 0166

0.54

Washington Ave

0.47

RTL

8'

0.44

SPRING ST. AVE (45°) MU 340 0.43 PKG LOT.

LTL RTL

0.41

Maple Ave

0.39

LTL

TOE

0.38

CROSS MD 289 0.37 ST. MU 100

0.36 LTL RTL

0.35

0.33 CHESTERTOWN V.F.D

0.32

4' J3 V E E E TL E TL A 4' J5 E FY. NP NP E

36'I
J-C-C-
2ML

SHA 51.3 - 8 Revised
4.83

MARYLAND STATE HIGHWAY ADMINISTRATION

ROAD INVENTORY SHEET

Party Chief: CG
Recorder: LW
Assistant: —
Map No./Dir.: D-15 / N-N15
State Coordinates:

Road No.: MD 213
Road Name: (WASHINGTON AVE)
County: Kent
Date: 6-21-89
Sheet No.: 3 OF 23

TRAFFIC CODES
TRAFFIC CONTROLS: STOP SIGN=SS, TRAFFIC LIGHT=T.L., FLASHING RED BALL=F.R.

TRAFFIC CODES
PARKING RESTRICTIONS: A.M. PEAK, P.M. PEAK, A.M./P.M. PEAK, NO PARKING ANYTIME=N.P., COMM/IND. ACCESS=E

SYSTEM: FED. AID.	SYSTEM: FUNCT. CLASS.	SYSTEM: HWY. SYS.	SYSTEM: HPMS SAMPLE	TRAFFIC: PRKG. REST.	TRAFFIC: COM/IND. ACCESS	LINE DIAGRAM	TRAFFIC: CONTROL	TRAFFIC: COM/IND. ACCESS	TRAFFIC: PRKG. REST.	PAVEMENT DATA
				N/D					NP	
						WASHINGTON COLLEGE 0 84				
						0 82 Alley				
						0 80 BROWN ST. MV 10				
						HISTORICAL SIGN 0 78				
						CAMPUS MG 0 74 Ave 0040 @.17				
						0 71		E		
						0 69				
						0 66 K. CO. BD OF ED OFF BLDG.				
						0 65		E		36'I
										J-C-C
										2 ML
						0 59 S.L 25 MPH				

FAS 1287
RURAL MINOR ARTERIAL
STATE SECONDARY

4' UNDIVIDED

LINE DIAGRAM

SYSTEM: FED. AID. | FUNCT. CLASS. | HWY. SYS. | HPMS SAMPLE
TRAFFIC: PRKG. REST. | COM/IND ACCESS
TRAFFIC: CONTROL | COM/IND ACCESS | PRKG. REST.
PAVEMENT DATA

FAS 1287
RURAL MINOR ARTERIAL
STATE SECONDARY

E

1|12
1|11
1|08
1|07
1|06 S.L. 30 mph
1|05
1|03
1|00
0|99
0|97
0|93
0|91
0|89 Ped X-ING

GIBSON AVE 125
MU

PVT. (Wash COLL.) RD

12' I SLT

GREENWOOD AVE 140
MU

20°
20°

Alley ONE WAY

TH

E
2E
E
E
E
E
FL

4' JS

42' I
~~JCB-LT~~
~~2 ML~~
12' I RT
13" I LT
JC-C OUT
12' I PNT MED CLT
2 ML
36' I
J-C-C
2 ML

SHA 51.3 - 8 Revised
4.83

MARYLAND STATE HIGHWAY ADMINISTRATION

ROAD INVENTORY SHEET

Party Chief C.G
Recorder LW
Assistant Rewritten 2-2-94
Map No./Dir. /
State Coordinates

Road No. MD 213
Road Name (Washington Ave)
County Kent
Date 6-21-89
Sheet No. 5 OF 23

TRAFFIC CODES
TRAFFIC CONTROLS: STOP SIGN=SS, TRAFFIC LIGHT=T.L., FLASHING RED BALL=F.R.

TRAFFIC CODES
PARKING RESTRICTIONS: A.M. PEAK, P.M. PEAK, A.M./P.M. PEAK, NO PARKING ANYTIME=N.P., COMM/IND. ACCESS=E

SYSTEM				TRAFFIC		LINE DIAGRAM	TRAFFIC			PAVEMENT DATA
FED. AID.	FUNCT CLASS.	HWY. SYS.	HPMS SAMPLE	PRKG. REST.	COM/IND. ACCESS		CONTROL	COM/IND. ACCESS	PRKG. REST.	
					E	127		E		
						12' LT				
					E	124		E		
						12' LT Hardaway DR.				
					E	123 MLL 0145				
					E	119		E		
					E	118		E		
					E	116		2E		
					E	114		2E		12'IRT 15'ILT J'CCout
					E	113	F	E		12'I SLT painted 2ML

Has 1287 Rural minor arterial State Secondary

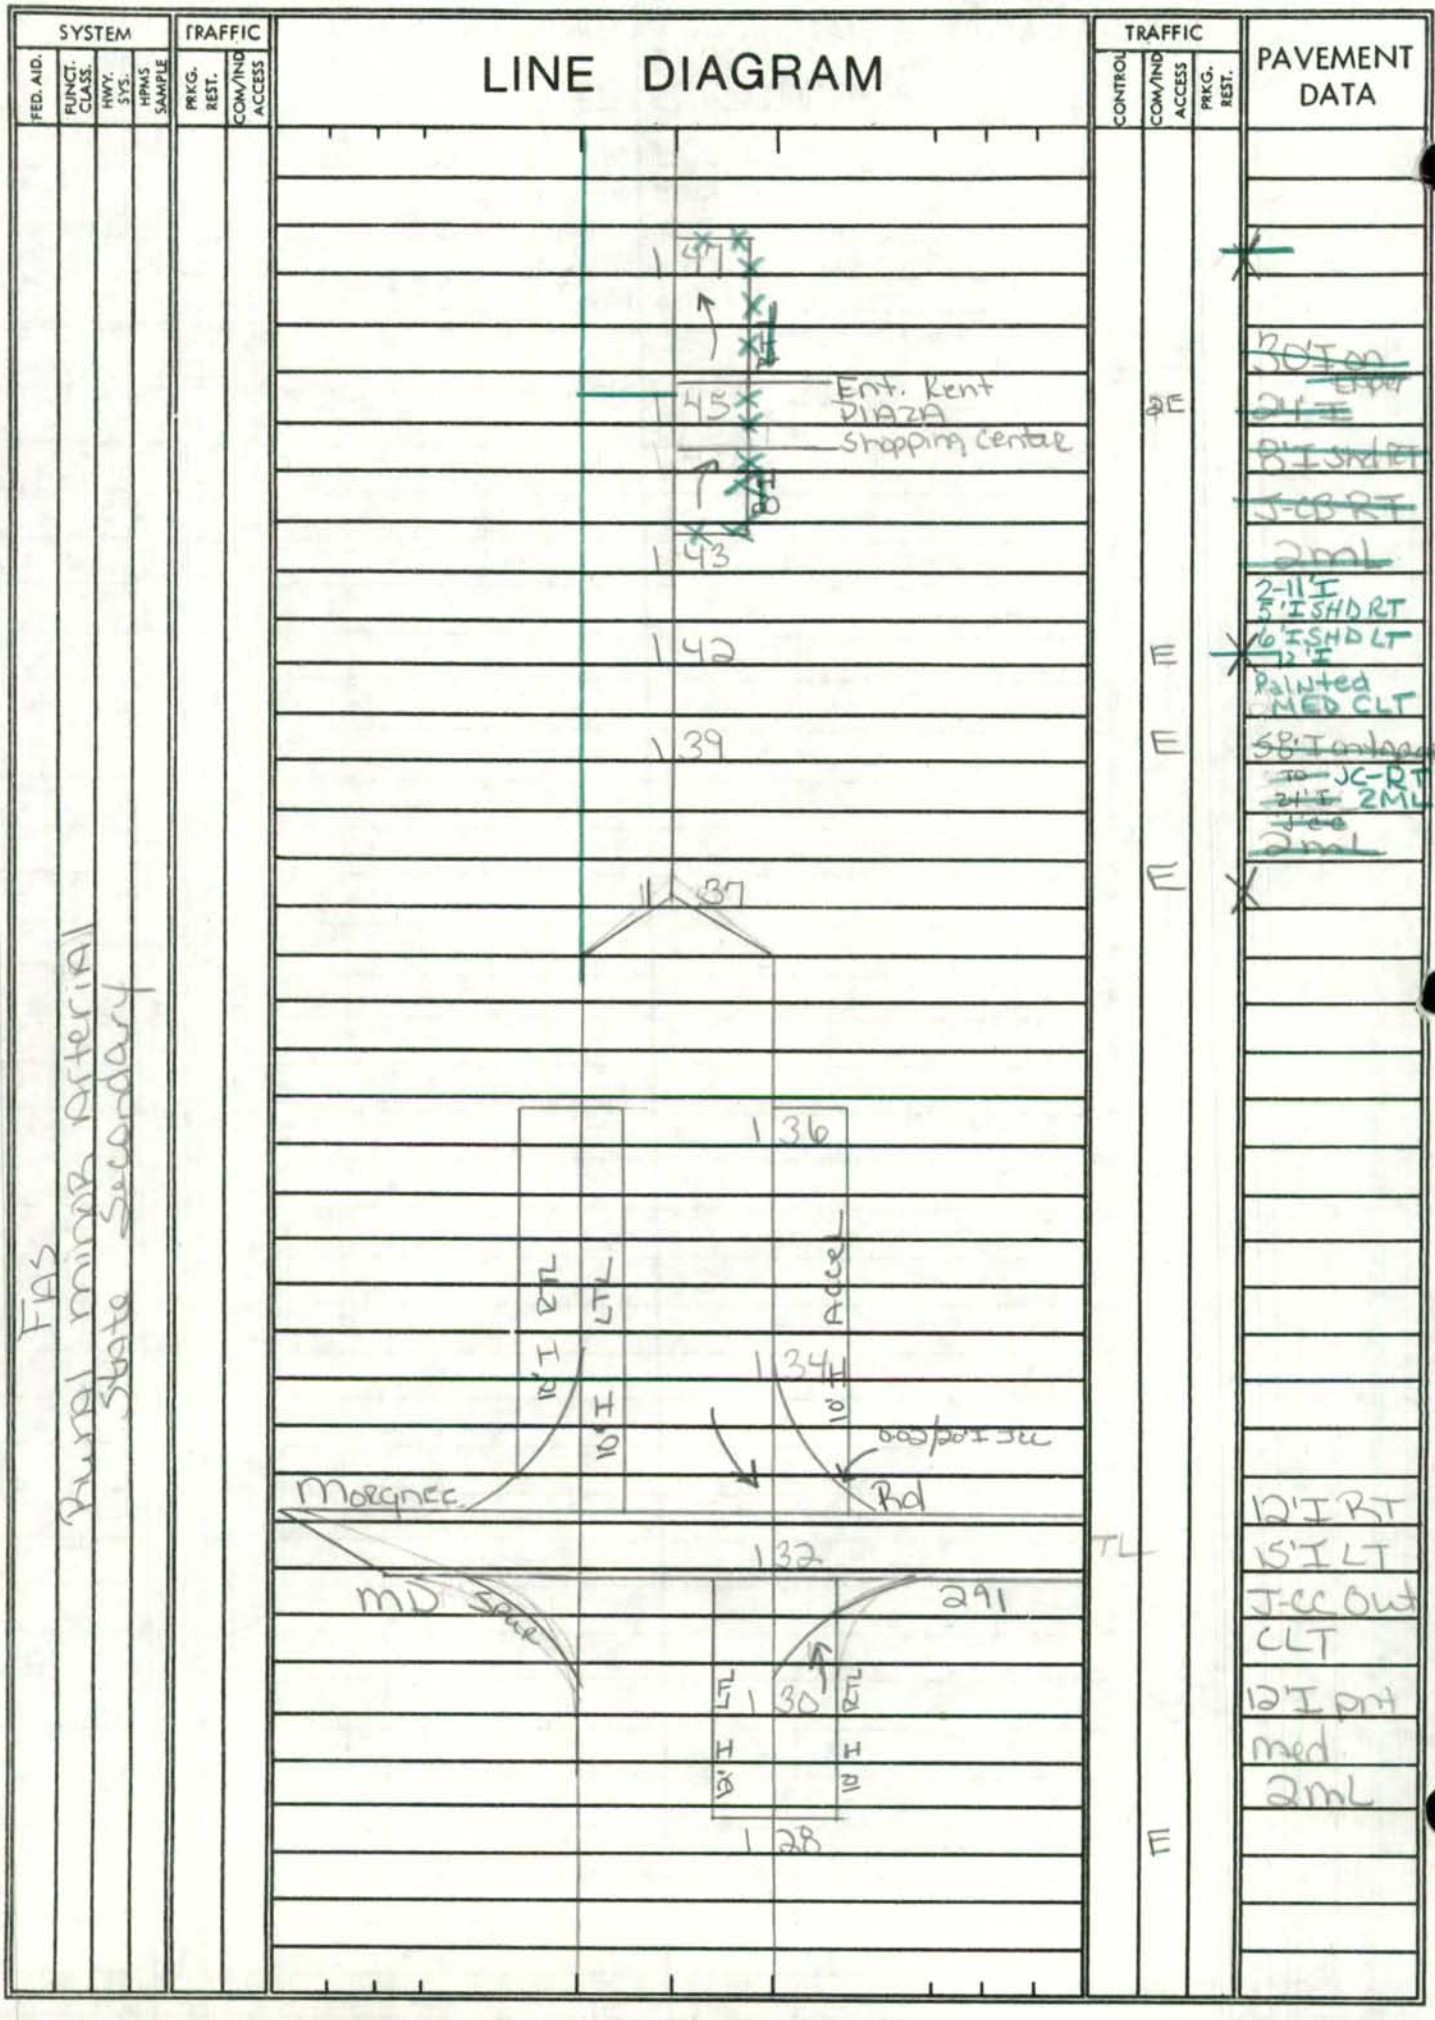
SYSTEM
FED. AID.
FUNCT. CLASS.
HWY. SYS.
HPMS SAMPLE
TRAFFIC
PRKG. REST.
COM/IND ACCESS
LINE DIAGRAM
TRAFFIC
CONTROL
COM/IND ACCESS
PRKG. REST.
PAVEMENT DATA
FAS
Rural minor arterial
State Secondary
147
145
Ent. Kent Plaza Shopping Center
143
142
139
137
136
134
132
130
128
Morgnec.
Rd
MD Spur
291
TL
E
12'I RT
15'I LT
J-CC Out
CLT
12'I Int
med
2ML

SHA 51.3 - 8 Revised
4.83

MARYLAND STATE HIGHWAY ADMINISTRATION

ROAD INVENTORY SHEET Augustine Herman Hwy

Party Chief C.G.
Recorder L.W.
Assistant
Map No./Dir. /
State Coordinates

Road No. MD 213
Road Name (Washington Ave)
County KENT
Date 6-21-89
Sheet No. 7 OF 23

TRAFFIC CODES
TRAFFIC CONTROLS: STOP SIGN=S.S., TRAFFIC LIGHT=T.L., FLASHING RED BALL=F.R.

TRAFFIC CODES
PARKING RESTRICTIONS: A.M. PEAK, P.M. PEAK, A.M./P.M. PEAK, NO PARKING ANYTIME=N.P., COMM/IND. ACCESS=E

SYSTEM				TRAFFIC		LINE DIAGRAM	TRAFFIC			PAVEMENT DATA
FED. AID.	FUNCT. CLASS.	HWY. SYS.	HPMS SAMPLE	PRKG. REST.	COM/IND. ACCESS		CONTROL	COM/IND. ACCESS	PRKG. REST.	
						PT 1+82				24'I
						ECorP 1+78 LMTS				2-10'I SHD
					E	1+76				3 ML
						30°				
						MALONE DR 0173 MU 1+70				
						PC 1+68				
										30'I
						MANOR AVE 0175 MU 1+63				2'I SHD RT
										8'I SHD LT
										3 MU
						1+58				
						1+55			E	
					E	1+53				2-11'I
										5'I SHD RT
										6'I SHD LT
										12'I PAINT
										MEDIAN CLT
						SCHEELER RD 1+52 MU 0318				24'I
										10'I SHD RT
										8'I SHD LT
						1+48			E	2 ML
										JC-RT
										2ML

FAS 1287
RURAL MINOR ARTER JAC
STATE SECONDARY

Checkpoint

4 JS

LINE DIAGRAM

SYSTEM: FED. AID. | FUNCT. CLASS. | HWY. SYS. | HPMS SAMPLE

TRAFFIC: PRKG. REST. | COM/IND ACCESS

TRAFFIC: CONTROL | COM/IND ACCESS | PRKG. REST.

PAVEMENT DATA

FAS 1287
RURAL MINOR ARTERIAL
STATE SECONDARY

E
E
E

2 25
2 22
2 20
2 15 SCHEELER AIR Field
2 12
2 09
2 05 ~~(PROP.)~~
2 04 S.L. 45MPH
SOUTHGATE DRIVE
(PROP.) SOUTHGATE
CO. 348
2 02
2 01
1 95
CHURCH
1 94
CHRISTENSEN TOWN
1 84
1 83
LMT
LMT

E
E
E

24'I
2-9'I SHDS
2ML
~~2-7'I~~
~~2-8'I SHDS~~
~~2 ML~~
24'I
2-12'I SHDS
JC-RT
2ML
24'I
2-12'I SHDS
JC-LT
2ML
2-11'I
5'I SHD RT
6'I SHD LT
12'I PAINT MED
~~2-11'I~~ CLT
~~2-10'I SHD~~
~~2 ML~~
JC-RT
2ML

SHA 51.3 - 8 Revised
4.83

MARYLAND STATE HIGHWAY ADMINISTRATION

ROAD INVENTORY SHEET

Party Chief: CG
Recorder: LW
Assistant:
Map No./Dir.: 1
State Coordinates:

Road No.: MD 213
Road Name: Augustine Herman Hwy
County: KENT
Date: 6-21-89
Sheet No.: 9 OF 23

TRAFFIC CODES
TRAFFIC CONTROLS: STOP SIGN=SS, TRAFFIC LIGHT=T.L., FLASHING RED BALL=F.R.

TRAFFIC CODES
PARKING RESTRICTIONS: A.M. PEAK, P.M. PEAK, A.M./P.M. PEAK, NO PARKING ANYTIME=N.P., COMM/IND. ACCESS=E

SYSTEM: FED. AID.	SYSTEM: FUNCT. CLASS.	SYSTEM: HWY. SYS.	SYSTEM: HPMS SAMPLE	TRAFFIC: PRKG. REST.	TRAFFIC: COM/IND. ACCESS	LINE DIAGRAM	TRAFFIC: CONTROL	TRAFFIC: COM/IND. ACCESS	TRAFFIC: PRKG. REST.	PAVEMENT DATA
X FAP 295	~~X~~					2 56				36'I
						MD 7H RTL 1297				7'I SHD LT
						0.01/16I 3'ISHD				2 ML
						2 55		X		
					E	2 54 10'H LT				
					E	2 51				
										2-12'I
					E	2 49				~~10'I SHD LT~~ ~~14'I RT~~
										~~17'I LT~~
					E	2 48				J-CB LT
										10'I PNT Med
						XXX 2 47				2 ML
								X		
						NORTHGATE DR. CO 337 2 45			X	
					E	2 43				
					E	2 30				
										24'I
					E	2 28				~~27'I~~
										2-~~8~~ 9 ISHD
										2 ML

FAS 1287
RURAL MINOR ARTERIAL
STATE SECONDARY

LINE DIAGRAM

SYSTEM: FED. AID. | FUNCT. CLASS. | HWY. SYS. | HPMS SAMPLE
TRAFFIC: PRKG. REST. | COM/IND ACCESS
TRAFFIC: CONTROL | COM/IND ACCESS | PRKG. REST.
PAVEMENT DATA

FAP 295
RURAL MINOR ARTERIAL
STATE SECONDARY

Accel on SHD

4 67 RILEYS MILL RD CO 70 PT

40°

PRC 4 39 PRC

#14026 TWIN CELL CBC

45° 4 31 2-20' 42°L W110' H8' D-8'

MD

PC 855 A 4 20

E 4 02

3 97

3 79

3 14 60" CMP D-2'

~~2 65~~

2 62 S.L. 55MPH

2 58 7'I RT

E

~~24'I~~
~~2 10' I SHD~~
~~2 ML~~
~~28'I~~
~~2-8'I SHD~~
~~2 ML~~
24'I
2-9'I SHDS
2 ML
36'I
7'I SHDRT
2 ML

SHA 51.3 - 8 Revised
4.83

MARYLAND STATE HIGHWAY ADMINISTRATION

ROAD INVENTORY SHEET

99-ST-EXI
CG HD
2/29/00

Party Chief: CG
Recorder: LW
Assistant: —
Map No./Dir.: /
State Coordinates:

Road No.: MD 213
Road Name: (Augustine Herman Hwy)
County: KENT
Date: 6-21-89
Sheet No.: 11 OF 23

TRAFFIC CODES
TRAFFIC CONTROLS: STOP SIGN=SS,
TRAFFIC LIGHT=T.L.,
FLASHING RED BALL=F.R.

TRAFFIC CODES
PARKING RESTRICTIONS: A.M. PEAK, P.M. PEAK, A.M./P.M. PEAK, NO PARKING ANYTIME=N.P., COMM/IND. ACCESS=E

SYSTEM				TRAFFIC		LINE DIAGRAM	TRAFFIC			PAVEMENT DATA
FED. AID.	FUNCT. CLASS.	HWY. SYS.	HPMS SAMPLE	PRKG. REST.	COM/IND. ACCESS		CONTROL	COM/IND. ACCESS	PRKG. REST.	
	RURAL MINOR ARTERIAL	STATE SECONDARY	EAP 295		E	5 76 PT 35° PRC 5 43 PRC ASPCA 5 38 35° 5 36 CBC, L-9'-H-5'-W-55' D-6' PC 5 08 4 81 4 79 80 4 77 XX 48" CMP squash D-2' MD 561 4 76 XX 4 72 RTL ON SHD ACCESS ONLY TO RTE ONE WAY HALF BY-PASS				24'I 2-9'ISHD 2 ML

SYSTEM: FED. AID. | FUNCT. CLASS. | HWY. SYS. | HPMS SAMPLE
TRAFFIC: PRKG. REST. | COM/IND ACCESS

LINE DIAGRAM

TRAFFIC: CONTROL | COM/IND ACCESS | PRKG. REST.

PAVEMENT DATA

FAP 295
RURAL MINOR ARTERIAL
STATE SECONDARY

PERKINS HILL RD
CO 40
6 79

6 53 PT

6 45 CHURCH

URIEVILLE COMMUNITY Lake

6 36

#14008
MORGAN Creek

45°

E EXIT PICNIC AREA 6 30

PRC 6 27 PRC

E ENT. PICNIC AREA 6 25

6 11
TO RT ~~& LT~~ ON SHD
TO ~~LT~~ ON SHD RT BY-PASS

BIGWOODS RD
CO 49
6 06

40°

~~6 01~~ 6 01
~~ACCEL LT~~ ON SHD
~~DECEL RT~~ ON SHD

5 ~~96~~ 98

PC 5 93

E

24'I
2-~~12~~ 9'ISHD
2 ML

SHA 51.3 - 8 Revised
4.83

MARYLAND STATE HIGHWAY ADMINISTRATION

ROAD INVENTORY SHEET

Party Chief: CG
Recorder: LNI
Assistant:
Map No./Dir.: /
State Coordinates:

Road No.: MD 213
Road Name: (Augustine Herman Hwy.)
County: KENT
Date: 6-21-89
Sheet No.: 13 OF 23

TRAFFIC CODES
TRAFFIC CONTROLS: STOP SIGN=SS, TRAFFIC LIGHT=T.L., FLASHING RED BALL=F.R.

TRAFFIC CODES
PARKING RESTRICTIONS: A.M. PEAK, P.M. PEAK, A.M./P.M. PEAK, NO PARKING ANYTIME=N.P., COMM/IND. ACCESS=E

SYSTEM				TRAFFIC		LINE DIAGRAM	TRAFFIC			PAVEMENT DATA
FED. AID.	FUNCT CLASS.	HWY. SYS.	HPMS SAMPLE	PRK.G. REST.	COM/IND. ACCESS		CONTROL	COM/IND. ACCESS	PRK.G. REST.	
										24'I
										2 ML
						8 68				X
						8 65 S.L. 30MPH				
						8 64 36" CMP D-3'				
						8 50 36" CMP D-3'				
						8 37 SIGN KENNEDYVILLE				
						8 32				
						8 24 S.L. 40MPH				
						8 14 60" CMP D-3'				
						7 96				
						7 43 RT TO ON SHD RT BY-PASS				
						STILL POND RD CO 395				
						7 37 RT ACC. ON SHD TO RT				
						7 30 ON SHD TO				
						X 7 29				
										24'I
										2-~~10~~ 9' ISHD
										2 ML

FAP #95
RURAL MINOR ARTERIAL
STATE SECONDARY
20213000796

SYSTEM: FED. AID. | FUNCT. CLASS. | HWY. SYS. | HPMS SAMPLE

TRAFFIC: PRKG. REST. | COM/IND ACCESS

LINE DIAGRAM

TRAFFIC: CONTROL | COM/IND ACCESS | PRKG. REST.

PAVEMENT DATA

FAP 293
RURAL MINOR ARTERIAL
STATE SECONDARY

9 04 KENNEDYVILLE ELE. School

KENNEDYVILLE SCHOOL RD
OP 175 20 9 02

~~RXR SIGN~~ ~~905~~

SIGN
RXR | RXR | Roadway ~~9 88~~ 8 88

8 95 CHURCH

8 94 MD AND DEL. R.R
2 TRACK
MDDE526438Y

8 93 FIRST CO. ~~ST~~ ROAD 129 (92-35 CO)

8 88 RXR

8 86 RXR

8 85 KENNEDYVILLE CO ~~MORNEC~~ RD 315

8 84 Kennedyville P.O.

8 77 CReamery CO ST 145

8 75

8 73

PAVEMENT DATA:
24'I
8'I SHOULDER
4'I SHOULDER
2 ML
24'I
2 ML

TRAFFIC: E | E | NP | NP | 4' | 35

SHA 51.3 - 8 Revised
4.83

MARYLAND STATE HIGHWAY ADMINISTRATION

ROAD INVENTORY SHEET

Party Chief C G
Recorder L W
Assistant —
Map No./Dir. /
State Coordinates

Road No. MD 213
Road Name (Augustine Herman Hwy)
County Kent
Date 6-21-89
Sheet No. 15 OF 23

TRAFFIC CODES
TRAFFIC CONTROLS: STOP SIGN=SS, TRAFFIC LIGHT=T.L., FLASHING RED BALL=F.R.

TRAFFIC CODES
PARKING RESTRICTIONS: A.M. PEAK, P.M. PEAK, A.M./P.M. PEAK, NO PARKING ANYTIME=N.P., COMM/IND. ACCESS=E

SYSTEM				TRAFFIC		LINE DIAGRAM	TRAFFIC			PAVEMENT DATA
FED. AID.	FUNCT. CLASS.	HWY. SYS.	HPMS SAMPLE	PRK.G. REST.	COM/IND. ACCESS		CONTROL	COM/IND. ACCESS	PRK.G. REST.	
						10 07				
						PT 10 17 36" CMP D-2'				
						MD 835 10 13				
						10 13				
						350 MD 835 10 08				
						PC 10 05				
						9 58 ~~END PVT AIR STRIP~~				
										24'I
						9 23 S.L. 55 MPH				2-9'I SHD
						9 22 ~~BEG PVT AIR STRIP~~				~~26'I~~
										~~2-8'I SHD~~
										2 ML
						9 10				X
						9 09 S.L. 40 MPH				24'I
										~~B'I SHDRT~~ 2 ML
										4'I SHD LT 2 ML

FAP 295
RURAL MINOR ARTERIAL
STATE SECONDARY

LINE DIAGRAM

SYSTEM				TRAFFIC		TRAFFIC			PAVEMENT DATA
FED. AID.	FUNCT. CLASS.	HWY. SYS.	HPMS SAMPLE	PRKG. REST.	COM/IND ACCESS	CONTROL	COM/IND ACCESS	PRKG. REST.	
							E		
							E		
									24'I
									2-9'I SHD
									26'I
									~~2-8'I SHD~~
									2 ML

FAP 295
RURAL MINOR ARTERIAL
STATE SECONDARY

PT
400
PC

11 62
11 40

SHREWSBURY CHURCH RD
CO 30
11 18

10 97
PT
30°
PC
10 88

10 37
10 35
10 33
10 31
(BROWNTOWN RD)
298
10 27 75

12'I RTL
10 8'I RTL
ON SHD
ON SHD
ON SHD
ON SHD
ACC. LN
ACC. LN
ACC. LN
ACC. LN

Hamms Meadow
MD

C 15
T
V
PI 5

SHA 51.3 - 8 Revised
4.83

MARYLAND STATE HIGHWAY ADMINISTRATION

ROAD INVENTORY SHEET

Party Chief: CG
Recorder: LW
Assistant: Rewritten 2-94 A.R.
Map No./Dir.: /
State Coordinates:

Road No.: MD 213
Road Name: (Augustine Herman Hwy)
County: Kent
Date: 6-21-89
Sheet No.: 17 OF 23

TRAFFIC CODES
TRAFFIC CONTROLS: STOP SIGN=SS, TRAFFIC LIGHT=T.L., FLASHING RED BALL=F.R.

TRAFFIC CODES
PARKING RESTRICTIONS: A.M. PEAK, P.M. PEAK, A.M./P.M. PEAK, NO PARKING ANYTIME=N.P., COMM/IND. ACCESS=E

SYSTEM				TRAFFIC		LINE DIAGRAM	TRAFFIC			PAVEMENT DATA
FED. AID.	FUNCT CLASS.	HWY. SYS.	HPMS SAMPLE	PRKG. REST.	COM/IND. ACCESS		CONTROL	COM/IND. ACCESS	PRKG. REST.	
	FAP 295	Rural minor Arterial State secondary				PT 13 36 30° 13 31 Vansants Corner Rd CR 31 PRC 13 10 PRC 13 02 36" CMP D-3' 50° 12 58 RTL 12 54 ACCEL PC Cold Locust Grove Rd CR 311 12 47 12 04 RTL ACCEL 13 Locust Grove Rd 444 Shallcross Rd CR 27 11 99 Kenthorne Park Rd MD Wheatley Rd CR 149 11 97 11 90 ACCEL 12 11 86				24' I 2-9' I Shol 2ML

SYSTEM				TRAFFIC		LINE DIAGRAM	TRAFFIC			PAVEMENT DATA
FED. AID.	FUNCT. CLASS.	HWY. SYS.	HPMS SAMPLE	PRKG. REST.	COM/IND ACCESS		CONTROL	COM/IND ACCESS	PRKG. REST.	
FAP 295	Rural Minor Arterial	State Secondary								

15 53 2-72" CP D-8'

14 8~~7~~2 PT

STARKEY FARM LANE

OP 172 14 80 30°

14 64 PC

14 35 ET 4 CHORD 1 PVC

14 30 ET 4 CHORD 1 PVC

14 24

DOVES HILL RD

42' I

JCC & H/L

WOODLAND 14 21 CREEK #140071 30°

13 72 ET 4 CHORD 1 PVC

DOVES HILL RD CO 312

13 68 ET 4 CHORD 1 PVC

13 63

24'I

2-9'I Shd

2mL

SHA 51.3 - 8 Revised
4.83

MARYLAND STATE HIGHWAY ADMINISTRATION

ROAD INVENTORY SHEET

N. MAIN ST
W. CROSS ST

Party Chief: CG
Recorder: LW
Assistant: —
Map No./Dir.: /
State Coordinates:

Road No.: MD 213
Road Name: (Augustine Herman Hwy)
County: KENT
Date: 6-21-8
Sheet No.: 19 OF 23

TRAFFIC CODES
TRAFFIC CONTROLS: STOP SIGN=SS, TRAFFIC LIGHT=T.L., FLASHING RED BALL=F.R.

TRAFFIC CODES
PARKING RESTRICTIONS: A.M. PEAK, P.M. PEAK, A.M./P.M. PEAK, NO PARKING ANYTIME=N.P., COMM/IND. ACCESS=E

SYSTEM				TRAFFIC		LINE DIAGRAM	TRAFFIC			PAVEMENT DATA
FED. AID.	FUNCT. CLASS.	HWY. SYS.	HPMS SAMPLE	PRK.G. REST.	COM/IND. ACCESS		CONTROL	COM/IND. ACCESS	PRK.G. REST.	
FAP 295	RURAL MINOR ARTERIAL	STATE SECONDARY		E	E	16 11 HISTORICAL SIGN		E		
						16 08				
						16 06		E		
						16 04				
						16 02		E		38'I
						15 94				~~40'I~~
						15 88 S.L. 25MPH				J-C-C
						CORP LMTS 15 87 ~~15 75 STR 40MPH~~				2 ML
				E	E	P.O. 15 85		E		X
						15 75 40 MPH				
						15 73 Sewage Disposal Plant				
						15 68		E		
										24'I
										2-9'I SHD
						15 58		E		~~24'I~~
										2-8'I SHD
										2 ML

W. CROSS ST
Augustine Herman Hwy

LINE DIAGRAM

SYSTEM: FED. AID. — FUNCT. CLASS. — HWY. SYS. — HPMS SAMPLE

TRAFFIC: PRKG. REST. — COM/IND ACCESS

TRAFFIC: CONTROL — COM/IND ACCESS — PRKG. REST.

PAVEMENT DATA

FAP 295 — FAP 291 — MUNICIPAL — STATE SECONDARY — MINOR ARTERIAL — STATE PRIMARY (TRAFFICWAY)

W CROSS ST

S. MAIN ST

1648

Beg CEM

1643

SEMINARY AVE MU 0030

1641

1643

1626

1624

VIRGINIA AVE MU 0040

1622

1618 GALENA P.O

1615

~~1614 GALENA V.F.D.~~

1613

E. CROSS ST 290

MD

1612

90°

90°

90°

S. MAIN ST 313

MD

NP

TL

4'

4'

E

E

E

E

X

X

X

SHA 51.3 - 8 Revised
4.83

MARYLAND STATE HIGHWAY ADMINISTRATION

ROAD INVENTORY SHEET

Party Chief: C.G
Recorder: L.W
Assistant:
Map No./Dir.: /
State Coordinates:

Road No.: MD 213 (Augustine Herman Hwy)
Road Name: (N MAIN ST)
County: KENT
Date: 6-21-89
Sheet No.: 21 OF 23

TRAFFIC CODES
TRAFFIC CONTROLS: STOP SIGN=SS, TRAFFIC LIGHT=T.L., FLASHING RED BALL=F.R.

TRAFFIC CODES
PARKING RESTRICTIONS: A.M. PEAK, P.M. PEAK, A.M./P.M. PEAK, NO PARKING ANYTIME=N.P., COMM/IND. ACCESS=E

SYSTEM				TRAFFIC		LINE DIAGRAM			TRAFFIC			PAVEMENT DATA
FED. AID.	FUNCT CLASS.	HWY. SYS.	HPMS SAMPLE	PRK.G. REST.	COM/IND. ACCESS				CONTROL	COM/IND. ACCESS	PRK.G. REST.	
						SRC Elec Counter	17 28	SRC Elec. Counter				
							17 22	PT				
								300				24'I
							17 11	PC				29'ISHDS
							16 82	S.L. 45 MPH				~~26'I~~
							16 66	S.L. 35 MPH.				~~28'ISHD~~
							16 65					2 ML
						~~PROF~~ ~~DOGWOOD DR~~	16 62	MILL CO LA.				
						CO 365	16 61	GALENA				
							16 58			E		
					E		16 57					
					E		16 51			E		
						CHURCH	16 50	CHURCH School				
												2~~4~~'I
												2-~~8~~'I SHD
						END CEM	16 49					2 ML

FAP 291
RURAL MINOR ARTERIAL
STATE PRIMARY (TRAVELWAY)

92 Coex #11 BB
3-19-93 JS

220 of 23

LINE DIAGRAM

SYSTEM: FED. AID. | FUNCT. CLASS. | HWY. SYS. | HPMS SAMPLE
TRAFFIC: PRKG. REST. | COM/IND ACCESS
TRAFFIC: CONTROL | COM/IND ACCESS | PRKG. REST.

FAP 291
RURAL MINOR ARTERIAL
STATE PRIMARY (TRAVELWAY)

			PAVEMENT DATA
E	17	76	27'I J-CB RT 8'I SHD LT 2 ML (35'I J-CC)
	17	73 FRONT CO ST 37	X
	Queen CO ST. 44 17	64	26'I 6'I SHD LT 2 ML
	HIST SIGN 17	61	X
E	17	56	24'I 2ML X 4 ~~26~~'I 2 ML
	17	47	X 5'I SHD LT
	HUYETT LANE 17	42 OP 170	24~~26~~'I 4 ~~8~~'I SHD RT ~~8~~'I SHD LT
	TOCHWOGH LANE 17	41 OP 169	2 ML
	17	40 S.L. 30 MPH	X
	Beg Cem 17	39	
	Georgetown CO Cem RD 50 17	38	24'I 2-9'I SHDS
E	17	37 SIGN: GEORGETOWN	~~26~~'I ~~2 8'I SHD~~
	17	30 ATR # 0015	2 ML

SHA 51.3 - 8 Revised
4.83

MARYLAND STATE HIGHWAY ADMINISTRATION

ROAD INVENTORY SHEET

Party Chief: C G
Recorder: L W
Assistant:
Map No./Dir.: /
State Coordinates:

Road No.: MD 213
Road Name: (Augustine Herman Hwy)
County: KENT
Date: 6-21-89
Sheet No.: 23 OF 23

TRAFFIC CODES
TRAFFIC CONTROLS: STOP SIGN=SS, TRAFFIC LIGHT=T.L., FLASHING RED BALL=F.R.

TRAFFIC CODES
PARKING RESTRICTIONS: A.M. PEAK, P.M. PEAK, A.M./P.M. PEAK, NO PARKING ANYTIME=N.P., COMM/IND. ACCESS=E

SYSTEM: FED. AID.	SYSTEM: FUNCT. CLASS.	SYSTEM: HWY. SYS.	SYSTEM: HPMS SAMPLE	TRAFFIC: PRK.G. REST.	TRAFFIC: COM/IND. ACCESS	LINE DIAGRAM	TRAFFIC: CONTROL	TRAFFIC: COM/IND. ACCESS	TRAFFIC: PRK.G. REST.	PAVEMENT DATA
						CECIL CO. 308				
						GEORGE ST.				
						0.09				
						17 94				
						17 91	TL			
						CECIL / KENT CO. / CO. — 17 87 — #14006 LINE / LINE SASSAFRAS RIVER				
						17 86 END Draw Span				
						17 85 Beg Draw Span				
						17 83	TL			27'I
										J-CB RT
										8'I SHDLT
						17 80				2 ML
										(35'I J-CC)
^	^	^								^
FAP 291	RURAL MINOR ARTERIAL	STATE PRIMARY (TRAFFICWAY)								

SYSTEM				TRAFFIC		LINE DIAGRAM	TRAFFIC			PAVEMENT DATA
FED. AID.	FUNCT. CLASS.	HWY. SYS.	HPMS SAMPLE	PRKG. REST.	COM/IND ACCESS		CONTROL	COM/IND ACCESS	PRKG. REST.	

SHA 51.3 - 8 Revised
4.83

MARYLAND STATE HIGHWAY ADMINISTRATION

ROAD INVENTORY SHEET

Party Chief _____
Recorder _____
Assistant _____
Map No./Dir. 1
State Coordinates _____

Road No. MD 213 UL (PROPOSED)
Road Name _____
County KENT
Date _____
Sheet No. 1 OF 1

SYSTEM				TRAFFIC		LINE DIAGRAM	TRAFFIC			PAVEMENT DATA
FED. AID.	FUNCT CLASS.	HWY. SYS.	HPMS SAMPLE	PRKG. REST.	COM/IND. ACCESS		CONTROL	COM/IND. ACCESS	PRKG. REST.	

FROM QUEEN ANNES CO/L
TO MD 213 @ MD 297
MILEAGE - 0.00 TO 2.20

FAP 295
PURPLE MINOR ART.

(UNASSIGNED)

NO BUILD

TRAFFIC CODES

TRAFFIC CONTROLS: STOP SIGN=SS, TRAFFIC LIGHT=T.L., FLASHING RED BALL=F.R.

TRAFFIC CODES

PARKING RESTRICTIONS: A.M. PEAK, P.M. PEAK, A.M./P.M. PEAK, NO PARKING ANYTIME=N.P., COMM/IND. ACCESS=E

SYSTEM				TRAFFIC		LINE DIAGRAM	TRAFFIC				PAVEMENT DATA
FED. AID.	FUNCT. CLASS.	HWY. SYS.	HPMS SAMPLE	PRKG. REST.	COM/IND ACCESS		CONTROL	COM/IND ACCESS	PRKG. REST.		

SHA 51.3 - 8 Revised
4.83

MARYLAND STATE HIGHWAY ADMINISTRATION

ROAD INVENTORY SHEET

195 STATE REINVENTORY
TM 188
6-2-95

SR.00
4-25-00
GD/EF

Party Chief C. G
Recorder L W
Assistant
Map No./Dir. E14 / E
State Coordinates

Road No. MD 288
Road Name (CROSBY RD)
County KENT
Date 6-8 -89
Sheet No. 1 OF 3

TRAFFIC CODES
TRAFFIC CONTROLS: STOP SIGN=SS, TRAFFIC LIGHT=T.L., FLASHING RED BALL=F.R.

TRAFFIC CODES
PARKING RESTRICTIONS: A.M. PEAK, P.M. PEAK, A.M./P.M. PEAK, NO PARKING ANYTIME=N.P., COMM/IND. ACCESS=E

SYSTEM FED. AID.	SYSTEM FUNCT. CLASS.	SYSTEM HWY. SYS.	SYSTEM HPMS SAMPLE	TRAFFIC PRK.G. REST.	TRAFFIC COM/IND. ACCESS	LINE DIAGRAM	TRAFFIC CONTROL	TRAFFIC COM/IND. ACCESS	TRAFFIC PRK.G. REST.	PAVEMENT DATA
						1 30 STINNERS NECK RD. 900' CO 106	SS			
				E		1 13				
						1 08 3-36" CMP D-1'				20' I
										2 ML
				E		CO. DUMP 0 33			X	
						PT 0 31				
						~~PT~~ 0 27 CHURCH				
						45°				
						PC 0 24				
				E		0 ~~09~~ 15				
										20'
						0 04 S.L. 40MPH				~~2~~ I
										2-3' I SHD
										2 ML
V	V					MD (Rock Hall 20) 0 00	SS			V
						20				

NON FA RURAL LOCAL

LINE DIAGRAM

SYSTEM: FED. AID.	SYSTEM: FUNCT. CLASS.	SYSTEM: HWY. SYS.	SYSTEM: HPMS SAMPLE	TRAFFIC: PRKG. REST.	TRAFFIC: COM/IND ACCESS	LINE DIAGRAM	TRAFFIC: CONTROL	TRAFFIC: COM/IND ACCESS	TRAFFIC: PRKG. REST.	PAVEMENT DATA
						2 67 36" CMP				
						PINEY NECK RD. 108 CO				
						2 59 90°	SS			
					E	2 41				
						2 33				
						EDESVILLE PINEY NECK RD. 102 CO (92-30-0)				
						2 282 SL 30 MPH				
						1 72 2-36" CMP				
						PT 1 63				
						300				
						PC 11 57				
										20'I
										2 ML
						1 50 SL 50 MPH				

NON FA
RURAL LOCAL

SHA 51.3 - 8 Revised
4.83

MARYLAND STATE HIGHWAY ADMINISTRATION

ROAD INVENTORY SHEET

Party Chief: C G
Recorder: L W
Assistant:
Map No./Dir.: E14 / E
State Coordinates:

Road No.: MD 288
Road Name: (CROSBY RD)
County: Kent
Date: 6-8-89
Sheet No.: 3 OF 3

TRAFFIC CODES
TRAFFIC CONTROLS: STOP SIGN=SS, TRAFFIC LIGHT=T.L., FLASHING RED BALL=F.R.

TRAFFIC CODES
PARKING RESTRICTIONS: A.M. PEAK, P.M. PEAK, A.M./P.M. PEAK, NO PARKING ANYTIME=N.P., COMM/IND. ACCESS=E

SYSTEM				TRAFFIC		LINE DIAGRAM	TRAFFIC			PAVEMENT DATA
FED. AID.	FUNCT. CLASS.	HWY. SYS.	HPMS SAMPLE	PRKG. REST.	COM/IND. ACCESS		CONTROL	COM/IND. ACCESS	PRKG. REST.	
	NHFA					LONG COVE				
	RURAL LOCAL					BOAT RAMP				
						ROAD 3 33 END				
						3 29 SIGN: END STATE MAINT.				
						3 24 HUDSON RD CO 304				
						3 06 Police Ave CO 328				
						MCKINLEY CO VILLE RD 118				
						PT 2 95				18'I 2 ML
						2 93				
						30°				
						PC 2 92				
						PT 2 75				
						45°				
						PC 2 70				20'I 2 ML

SYSTEM				TRAFFIC		LINE DIAGRAM	TRAFFIC			PAVEMENT DATA
FED. AID.	FUNCT. CLASS.	HWY. SYS.	HPMS SAMPLE	PRK.G. REST.	COM/IND ACCESS		CONTROL	COM/IND ACCESS	PRK.G. REST.	

SHA 51.3 - 8 Revised
4.83

MARYLAND STATE HIGHWAY ADMINISTRATION

ROAD INVENTORY SHEET QUAKER NECK RD

TRANSFER LETTER 12-1-87 8-28-85 95 ST. RI 6-5-95 TM/BB SR 00 426-00 GD/EF All Quaker Neck Rd as of 12-19-00 WS

Party Chief C G
Recorder L W
Assistant
Map No./Dir. E 14 ELB DIS / N
State Coordinates 1042 - 469

Road No. MD 289
Road Name ~~CHESTER CITY RD~~
County KENT
Date 6-16-89
Sheet No. 1 OF 8

TRAFFIC CODES
TRAFFIC CONTROLS: STOP SIGN=SS, TRAFFIC LIGHT=T.L., FLASHING RED BALL=F.R.

TRAFFIC CODES
PARKING RESTRICTIONS: A.M. PEAK, P.M. PEAK, A.M./P.M. PEAK, NO PARKING ANYTIME=N.P., COMM/IND. ACCESS=E

SYSTEM				TRAFFIC		LINE DIAGRAM	TRAFFIC			PAVEMENT DATA
FED. AID.	FUNCT. CLASS.	HWY. SYS.	HPMS SAMPLE	PRK.G. REST.	COM/IND. ACCESS		CONTROL	COM/IND. ACCESS	PRK.G. REST.	
	NON FA RURAL MINOR COLLECTOR					0 65 PT 30° PC 0 60 0 57 SL 50 MPH 0 55 0 30 PT 40° PC 0 26 PT 90° PC 0 15 0 09 0 00 SIGN: Beg. ST. MAINT. 93 RIVER RD. 92 CLIFTS CITY CO. LANDS END CO.				2-3' E SHD 20' I 2 ML

SYSTEM: FED. AID. | FUNCT. CLASS. | HWY. SYS. | HPMS SAMPLE
TRAFFIC: PRKG. REST. | COM/IND ACCESS

LINE DIAGRAM

TRAFFIC: CONTROL | COM/IND ACCESS | PRKG. REST.

PAVEMENT DATA

NON FA
RURAL MINOR COLLECTOR

PT
30°
WALNUT POINT RD
CO. 88
PC

3 18
3 17
3 11

2 62 36" CMP D-1'

2 59 PT

2 55 OLD TOWN RD.
CO. 90

90°

2 47 Johnson TOWN RD
CO 91

2 46 PC

PT
30°
PC

1 69
1 65

Providence Plantations Lane
PVT 1 47
1 13 36" CMP D-1'
COMEGYS BIGHT LANE
0 71 OP (196°43')

PAVEMENT DATA:
~~20'I~~
~~2-3' ESHD~~
~~2 ML~~
*
20'I
2 ML
2-3'E SHD

SHA 51.3 - 8 Revised
4.83

MARYLAND STATE HIGHWAY ADMINISTRATION

ROAD INVENTORY SHEET

Party Chief: C. G
Recorder: L W
Assistant:
Map No./Dir.: E 14 / N
State Coordinates: 1042 - 469

Road No.: MD 289
Road Name: (QUAKER NECK RD.)
County: Kent
Date: 6-16-89
Sheet No.: 3 OF 8

TRAFFIC CODES
TRAFFIC CONTROLS: STOP SIGN=S.S., TRAFFIC LIGHT=T.L., FLASHING RED BALL=F.R.

TRAFFIC CODES
PARKING RESTRICTIONS: A.M. PEAK, P.M. PEAK, A.M./P.M. PEAK, NO PARKING ANYTIME=N.P., COMM/IND. ACCESS=E

SYSTEM				TRAFFIC		LINE DIAGRAM	TRAFFIC			PAVEMENT DATA
FED. AID.	FUNCT. CLASS.	HWY. SYS.	HPMS SAMPLE	PRKG. REST.	COM/IND. ACCESS		CONTROL	COM/IND. ACCESS	PRKG. REST.	
						4 70 CHURCH LA. CO. 120				
						4 51 S.L. 50MPH				
						4 42 36" CMP D-1'				
					E	4 37				
						(92.45.46) 80.				2-3'ESHD
										22'I
										2 ML
X	X					80° 4 32			X	
						4 17 48" CMP D-1'				
						4 12 S.L. 30MPH				
						3 94 CHURCH AND CEM				22'I
										2-3'ESHD
										2 ML
						3 91 QUAKER NECK LDG. RD. MD 6 396 661			X	
										20'I
										2-3'E SHD
										2 ML

NON FA
RURAL MINOR COLLECTOR

FAS 1290
RURAL MAJOR COLLECTOR

SYSTEM: FED. AID. | FUNCT. CLASS. | HWY. SYS. | HPMS SAMPLE
TRAFFIC: PRKG. REST. | COM/IND ACCESS

LINE DIAGRAM

TRAFFIC: CONTROL | COM/IND ACCESS | PRKG. REST.

PAVEMENT DATA

FAS 1290
RURAL MAJOR COLLECTOR

END CEM 7 01 PT
45°
Beg CEM 6 91 PC
PT 6 81
40°
6 75 SUNBURST Ave
CO 267
PC 6 68
6 56 S.L. 40 MPH
6 53 WILKINS CO LA. 604 397
CLOVERS LANE 6 31
CO 86
6 20
37 PVT. RD.
5 11 2-36" CP D-1'
OP PVT. 33
5 03 KINGS GRANT LANE
4 88 PT
30°
4 71 PC

PAVEMENT DATA:
~~22' I~~
2-3' I SHD
2 ML
~~22' I~~
~~2-3' I SHD~~
2 ML
*
22' I
2 ML
2-3' E SHD

SHA 51.3 - 8 Revised
4.83

MARYLAND STATE HIGHWAY ADMINISTRATION

ROAD INVENTORY SHEET

Party Chief: C G
Recorder: LW
Assistant:
Map No./Dir.: D15 / N
State Coordinates: 1042 - 469

Road No.: MD 289
Road Name: QUAKER NECK RD
County: Kent
Date: 6-16-89
Sheet No.: 5 OF 8

TRAFFIC CODES
TRAFFIC CONTROLS: STOP SIGN=SS, TRAFFIC LIGHT=T.L., FLASHING RED BALL=F.R.

TRAFFIC CODES
PARKING RESTRICTIONS: A.M. PEAK, P.M. PEAK, A.M./P.M. PEAK, NO PARKING ANYTIME=N.P., COMM/IND. ACCESS=E

SYSTEM				TRAFFIC		LINE DIAGRAM	TRAFFIC			PAVEMENT DATA
FED. AID.	FUNCT. CLASS.	HWY. SYS.	HPMS SAMPLE	PRKG. REST.	COM/IND. ACCESS		CONTROL	COM/IND. ACCESS	PRKG. REST.	
	RURAL MAJOR COLLECTOR		FAS 1290		E	JOHN HANSON RD CO 85 7 59		E		22'I
						25'				2-3'ISHD
						RADCLIFFE RD ~~PEARCE~~ CO 188 ~~269~~ (92-38) 7 47				2 ML
						COLLINS AVE CO 147 7 35				
						GOLF COURSE 7 28				
						CHESTER RIVER				
					E	7 27				
						C.R.Y.&C.C. 7 25				
					E	7 21 PVT. LDG				
						COUNTRY CLUB POND 7 17 4-48" CP PT D-2' 35° PC				
						7 06				

FAS 1290
RURAL MAJOR COLLECTOR

SYSTEM: FED. AID.	SYSTEM: FUNCT. CLASS.	SYSTEM: HWY. SYS.	SYSTEM: HPMS SAMPLE	TRAFFIC: PRKG. REST.	TRAFFIC: COM/IND ACCESS	LINE DIAGRAM	TRAFFIC: CONTROL	TRAFFIC: COM/IND ACCESS	TRAFFIC: PRKG. REST.	PAVEMENT DATA
										22' I
						8 36 T.H.		E		12' I SHLDR
										3' I SHLDR
						↑ CORP LMTS OF CHESTERTOWN ↑				2 ML
						8 31		E		X JCRB AT
								35		
						8 29		E		
						8 25		E		
						8 27 MNG ARMY		E		
						8 02 #14009				
						RADCLIFFE 8 01 CREEK				
						8 00 L-120' W-30' J NJB-NJB H-5' MEAN high tide CONC, Slab w/ 3 NJB wall				
						7 95		E		
						7 92		E		
						7 90		E		
					E	7 84				
						7 70 36" CMP D-1'				
										22' I
										2-3' I SHD
										2 ML

SHA 51.3 - 8 Revised
4.83

MARYLAND STATE HIGHWAY ADMINISTRATION

ROAD INVENTORY SHEET

CROSS ST
RAILROAD AVE

96-5 ST
GA/KS
1-28-97

Party Chief: C G
Recorder: L-W
Assistant:
Map No./Dir.: D15 / N
State Coordinates: 1042 - 469

Road No.: MD 289
Road Name: QUAKER NECK RD
County: Kent
Date: 6-16-89
Sheet No.: 7 OF 8

TRAFFIC CODES
TRAFFIC CONTROLS: STOP SIGN=S.S., TRAFFIC LIGHT=T.L., FLASHING RED BALL=F.R.

TRAFFIC CODES
PARKING RESTRICTIONS: A.M. PEAK, P.M. PEAK, A.M./P.M. PEAK, NO PARKING ANYTIME=N.P., COMM/IND. ACCESS=E

SYSTEM				TRAFFIC		LINE DIAGRAM	TRAFFIC			PAVEMENT DATA
FED. AID.	FUNCT. CLASS.	HWY. SYS.	HPMS SAMPLE	PRK.G. REST.	COM/IND. ACCESS		CONTROL	COM/IND. ACCESS	PRK.G. REST.	
	RURAL MAJOR COLLECTOR					(MEMORIAL PLAZA) ← TRACK ROW # B 0210				
						8 70 MH				
						10'-1 CLT.				
						HIGH MU. 8 68 ST. 0150	TL			41' I
				4'				4'		J-C-C
				K				K		2 ML
				J		CANNON MU 8 61 ST. 0050				35' I
										J-C-C
				E		8 57 ST.		E		2 ML
						CROSS				
					E	85° 8 56		E		
						(RAILROAD AVE)				
					E	8 52		E		
				NPG		QUEEN ST. OLD MD 289			NPG	
										28' I
								4'		J-C-C
						8 44 90°		JS		
						(QUAKER NECK RD) (COLD RAILROAD AVE) MU				24' I
					E	8 41				J-CC
										2 ML
					E	8 40 Park		E		
						8 38 SL. 25 MPH				J CRB RF
										22' I
										~~2~~ 3' I SHD RT
										2 ML
										11' I SHD RT

SYSTEM: FED. AID. | FUNCT. CLASS. | HWY. SYS. | HPMS SAMPLE

TRAFFIC: PRKG. REST. | COM/IND ACCESS

LINE DIAGRAM

TRAFFIC: CONTROL | COM/IND ACCESS | PRKG. REST.

PAVEMENT DATA

FAS 1290

RURAL MAJOR COLLECTOR

CROSS ST. 100 MU

MAPLE MD — 8 83 — AVE 213

TL

LTL

8 81

10 H

E

8 80

E

CHESTERTOWN TH 8 78

8 77

E

8 76

E

4' 9' 5

8 73 K. CO. CHS.

4' K S

35'I
J-C-C
2 ML

PARK ROW MU — 0200 — 8 72

8 71 CHURCH

41'I
J-C-C
2-ML

SHA 51.3 - 8 Revised
4.83

MARYLAND STATE HIGHWAY ADMINISTRATION

ROAD INVENTORY SHEET

ST-RE-INV
BG/AL
6-9-95

SR.00
4-24-00
GD/EF

Party Chief: CG
Recorder: LW
Assistant:
Map No./Dir.: D15 / N
State Coordinates:

Road No.: MD 290
Road Name: Crumpton RD
County: KENT
Date: 6-20-89
Sheet No.: 1 OF 8

TRAFFIC CODES
TRAFFIC CONTROLS: STOP SIGN=SS, TRAFFIC LIGHT=T.L., FLASHING RED BALL=F.R.

TRAFFIC CODES
PARKING RESTRICTIONS: A.M. PEAK, P.M. PEAK, A.M./P.M. PEAK, NO PARKING ANYTIME=N.P., COMM/IND. ACCESS=E

SYSTEM				TRAFFIC		LINE DIAGRAM	TRAFFIC			PAVEMENT DATA
FED. AID.	FUNCT. CLASS.	HWY. SYS.	HPMS SAMPLE	PRK.G. REST.	COM/IND. ACCESS		CONTROL	COM/IND. ACCESS	PRK.G. REST.	
NON FA	R-MINOR COLLECTOR									20'I
						MORGNEC RD 291 MD				2 ML
						178 90°				2-2'E shd
						MORGNEC RD 291 MD				SEE MD291
MD 291						0.67 MILES SHOWN ON MD 291				
NON FA	R-MINOR COLLECTOR					90° 111 MORGNEC RD 291 MD 104 30°	SS			22'I
						0.15 SL.= 50 MPH				2-6'ISHD
						0.03 # 14013				2 ML
						CHESTER RIVER 0.00 CO. LINE				
						KENT QUEEN ANNES CO. LINE				
						0.20				
						Front St. CO. 35				

SYSTEM: FED. AID. | FUNCT. CLASS. | HWY. SYS. | HPMS SAMPLE
TRAFFIC: PRKG. REST. | COM/IND ACCESS

LINE DIAGRAM

TRAFFIC: CONTROL | COM/IND ACCESS | PRKG. REST.

PAVEMENT DATA

NON FA
RURAL MINOR COLLECTOR

5 ~~38~~ 42 XH (RXR)

5 11 36" CMP D-2'

4 44 PT

40°

4 37 PC

BOLTON RD
CO. 124 4 32

PT 4 15

30°

PC 4 07

CHESTERVILLE RD

3 11 36" CMP D-3'

sign: Chesterville 2 80

Bridge Rd

(MORGNEC RD) CHESTERVILLE ~~Millington~~ RD
1 PT CO ~~307~~ 2 76 CO. 226
MD 444

30°

2 68 sign: Chesterville

PC 2 66

CRUMPTON RD

20'I
2 ML
2-2'E shd

SHA 51.3 - 8 Revised
4.83

MARYLAND STATE HIGHWAY ADMINISTRATION

ROAD INVENTORY SHEET

Party Chief: CG
Recorder: LW
Assistant:
Map No./Dir.: /
State Coordinates:

Road No.: MD 290
Road Name: Chesterville RD
County: Kent
Date: 6-20-89
Sheet No.: 3 OF 8

TRAFFIC CODES
TRAFFIC CONTROLS: STOP SIGN=SS, TRAFFIC LIGHT=T.L., FLASHING RED BALL=F.R.

TRAFFIC CODES
PARKING RESTRICTIONS: A.M. PEAK, P.M. PEAK, A.M./P.M. PEAK, NO PARKING ANYTIME=N.P., COMM/IND. ACCESS=E

SYSTEM				TRAFFIC		LINE DIAGRAM	TRAFFIC			PAVEMENT DATA
FED. AID.	FUNCT CLASS.	HWY. SYS.	HPMS SAMPLE	PRK.G. REST.	COM/IND. ACCESS		CONTROL	COM/IND. ACCESS	PRK.G. REST.	
	NON FA RURAL MINOR COLLECTOR					6 79 36" CP -D-2'				
						END CEM 5 93				
						5 90 LAMBSON ~~HUNTINGTON~~ FOREST RD CO 15				22'I 2ML
						Beg CEM 5 89				22'ESHD
						DUCK PUDDLE RD CO 21 5 88				X
						(RXR) 5 68 3				
						RXR Roadway 5 67 1				
						MD AND DELAWARE R.R. 5 54 # MDDE526433L	FL			
						5 42 RXR				20'I 2 ML

SYSTEM				TRAFFIC		LINE DIAGRAM	TRAFFIC			PAVEMENT DATA
FED. AID.	FUNCT. CLASS.	HWY. SYS.	HPMS SAMPLE	PRKG. REST.	COM/IND ACCESS		CONTROL	COM/IND ACCESS	PRKG. REST.	
NON FA	RURAL MINOR COLLECTOR									

MD 313A

313A

(MASSEY MD)

MD

(MASSEY MD)

Galena (RD) 313 A 90°

MD

7 24

0.02/14'I → 4'I shd RT

0.01 ← 14'I 12'I shd RT

0.72 MILES = 24 SHOWN ON MD 313

7 23

MD 313

IRELAND CO 698 CORNER RD 313

SS

S

SEE MD313

A

24'I

2-10'I SHD

2 ML

X

2-8'I

2 ML

2-2 ESHD

SHA 51.3 - 8 Revised
4.83

MARYLAND STATE HIGHWAY ADMINISTRATION

ROAD INVENTORY SHEET

92-3 STATE
3-4-93
BB/JS

Party Chief: CG
Recorder: LW
Assistant:
Map No./Dir.: 1
State Coordinates:

Road No.: MD 290
Road Name: E CROSS ST / GALENA SASSAFRAS RD
County: KENT
Date: 6-20-89
Sheet No.: 5 OF 8

TRAFFIC CODES
TRAFFIC CONTROLS: STOP SIGN=SS, TRAFFIC LIGHT=T.L., FLASHING RED BALL=F.R.

TRAFFIC CODES
PARKING RESTRICTIONS: A.M. PEAK, P.M. PEAK, A.M./P.M. PEAK, NO PARKING ANYTIME=N.P., COMM/IND. ACCESS=E

SYSTEM				TRAFFIC		LINE DIAGRAM	TRAFFIC			PAVEMENT DATA
FED. AID.	FUNCT. CLASS.	HWY. SYS.	HPMS SAMPLE	PRKG. REST.	COM/IND. ACCESS		CONTROL	COM/IND. ACCESS	PRKG. REST.	
					E	GALENA VFD 8 29	F1			24'I
										2-10'I SHDS
										JCRB-LT
						8 26			X	2 ML
					E	8 24				
						GALENA CLASSIFIED RD				
					E	8 22				
					E	CURB LMTS 8 21 OF GALENA X				
						8 16 SL = 40 MPH				24I
										2-10' I SHD
						JARMAN AVE. MU 0010 8 13			X	2 ML
						8 05			X	36'I
										J-CB LT
										10' I SHD RT
						PHELPS AVE MU 0020 8 03			X	2 ML
						E CROSS ST				
						802				31'I
						MD W CROSS ST 213 SPRUCE ST				J-C-C
										3 ML
						900 796	TL		X	
						MAIN ST				
						N. MAIN ST 213 MD 31 SAME AS				See MD 313
						MD				
						Σ				

FAS 1282 RURAL MAJOR COLLECTOR

MD 313 K K

LINE DIAGRAM

SYSTEM: FED. AID. | FUNCT. CLASS. | HWY. SYS. | HPMS SAMPLE
TRAFFIC: PRKG. REST. | COM/IND ACCESS
TRAFFIC: CONTROL | COM/IND ACCESS | PRKG. REST.

FAS 1282
RURAL MAJOR COLLECTOR

SWANTOWN CREEK #14011

10 13

10 07

PT

9 97 (PROP.)

9 81

45°

9 49

PC

PT

9 12

GREGG NECK RD Co 9

9 08

DAVIS RD Co 13

389

20°

8 91

PC

8 84

OLIVET HILL RD. Co 12

8 59

8 56

MILL CREEK #14012

8 46 SL = 50 MPH

OLIVET HILL RD Co. 12

8 35

PAVEMENT DATA

~~24'I~~
~~2'10'I SHD~~
~~2 ML~~

~~24'I~~
~~2'10'I SHD~~
~~2 ML~~

24'I
2'10'I SHD
2 ML

24'I
10'I SHD RT
10'I SHD LT
JCLT
2ML

SHA 51.3 - 8 Revised
4.83

MARYLAND STATE HIGHWAY ADMINISTRATION

ROAD INVENTORY SHEET

Party Chief: CG
Recorder: LW
Assistant:
Map No./Dir.: 1
State Coordinates:

Road No.: MD 290
Road Name: Galena Sassafras RD
County: KENT
Date: 6-20-89
Sheet No.: 7 OF 8

TRAFFIC CODES
TRAFFIC CONTROLS: STOP SIGN=SS, TRAFFIC LIGHT=T.L., FLASHING RED BALL=F.R.

TRAFFIC CODES
PARKING RESTRICTIONS: A.M. PEAK, P.M. PEAK, A.M./P.M. PEAK, NO PARKING ANYTIME=N.P., COMM/IND. ACCESS=E

SYSTEM				TRAFFIC		LINE DIAGRAM	TRAFFIC			PAVEMENT DATA
FED. AID.	FUNCT. CLASS.	HWY. SYS.	HPMS SAMPLE	PRK.G. REST.	COM/IND. ACCESS		CONTROL	COM/IND. ACCESS	PRK.G. REST.	
						PT JACOBS 11 81 CREEK #14010				
						30°				24'I
										2-10'I SHD
						PC 11 64				~~24'I~~
										~~2-10'I SHD~~
						11 58				
						WILSON POINT RD CO 6 10 87				
										~~24'I~~
										~~2-10' G SHD~~
										~~2 ML~~
						PT 10 68				
						30°				
						PC 10 46				24'I
										2-10'I SHD
										2 ML

8 of 8

SYSTEM				TRAFFIC		LINE DIAGRAM	TRAFFIC			PAVEMENT DATA
FED. AID.	FUNCT. CLASS.	HWY. SYS.	HPMS SAMPLE	PRKG. REST.	COM/IND ACCESS		CONTROL	COM/IND ACCESS	PRKG. REST.	
NON FA	RURAL MINOR COLLECTOR									
FAS 1282	RURAL MAJOR COLLECTOR									

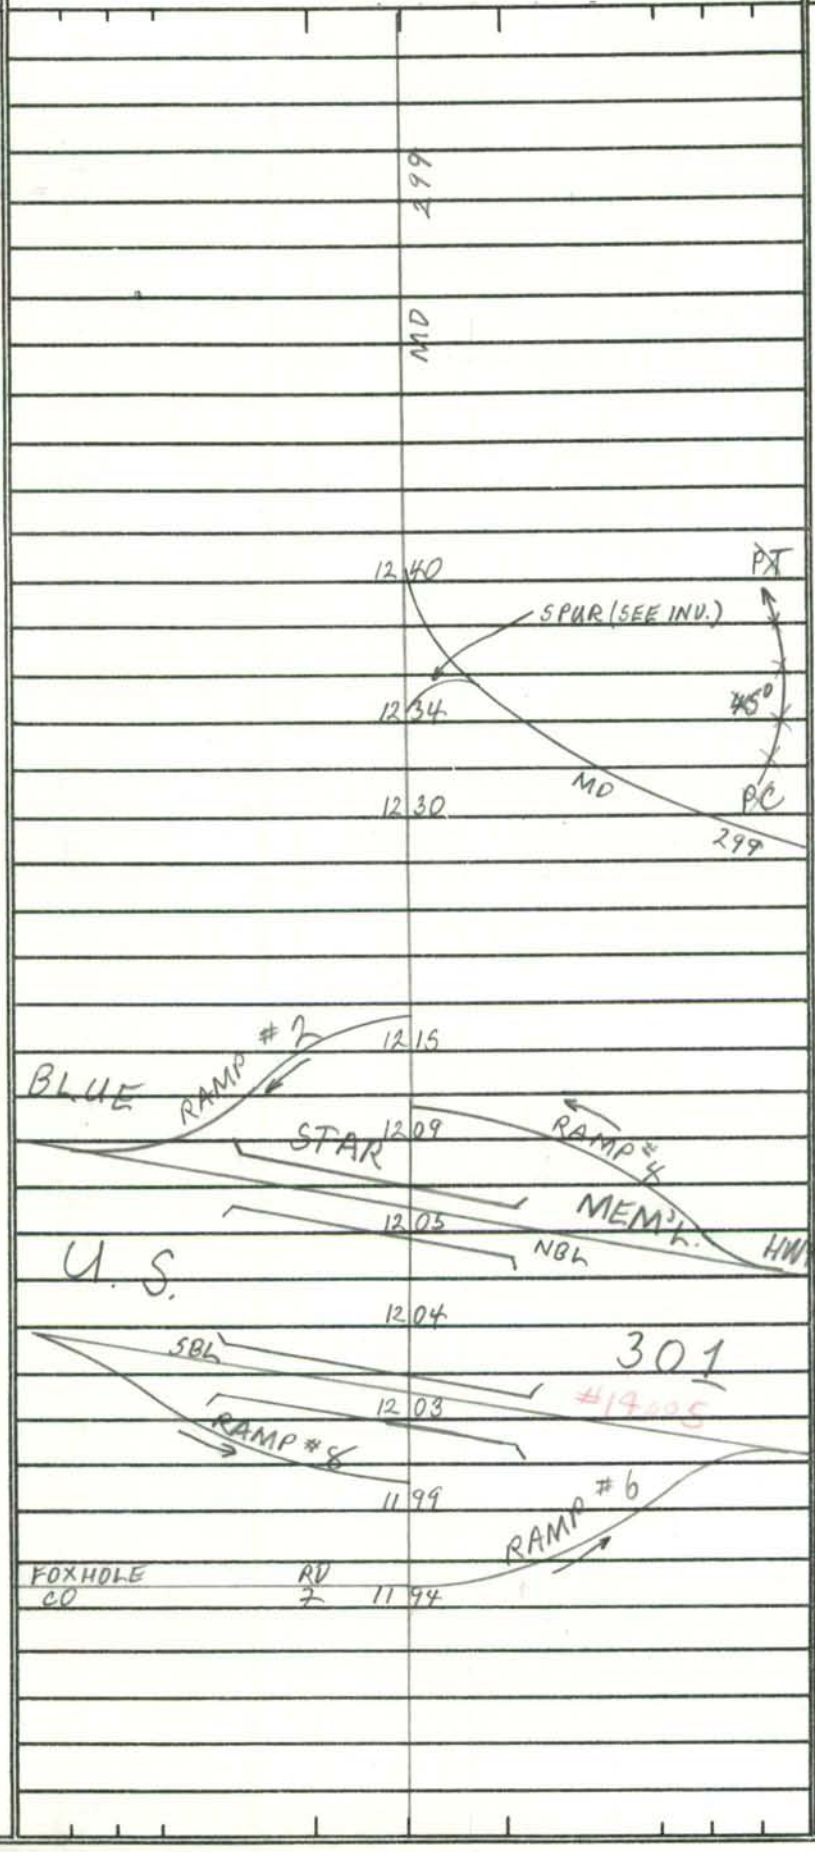

~~24' I~~
~~2-10'6 SHD~~
~~2 ML~~

24' I
2-10' I SHD
2 ML

SHA 51.3 - 8 Revised
4.83

MARYLAND STATE HIGHWAY ADMINISTRATION

ROAD INVENTORY SHEET

95-ST RE-INV.
BB/AL
6-9-95

SR00
4-27-00
GD/EF

Party Chief C G
Recorder L. W.
Assistant
Map No./Dir. /
State Coordinates

Road No. SPUR
Road Name MD 313 NB TO MD 290 EB
County Kent
Date 6-14-89
Sheet No. 1 OF 1

SYSTEM				TRAFFIC		LINE DIAGRAM	TRAFFIC			PAVEMENT DATA
FED. AID.	FUNCT. CLASS.	HWY. SYS.	HPMS SAMPLE	PRKG. REST.	COM/IND. ACCESS		CONTROL	COM/IND. ACCESS	PRKG. REST.	

TRAFFIC CODES

TRAFFIC CONTROLS: STOP SIGN=S.S., TRAFFIC LIGHT=T.L., FLASHING RED BALL=F.R.

TRAFFIC CODES

PARKING RESTRICTIONS: A.M. PEAK, P.M. PEAK, A.M./P.M. PEAK, NO PARKING ANYTIME=N.P., COMM/IND. ACCESS=E

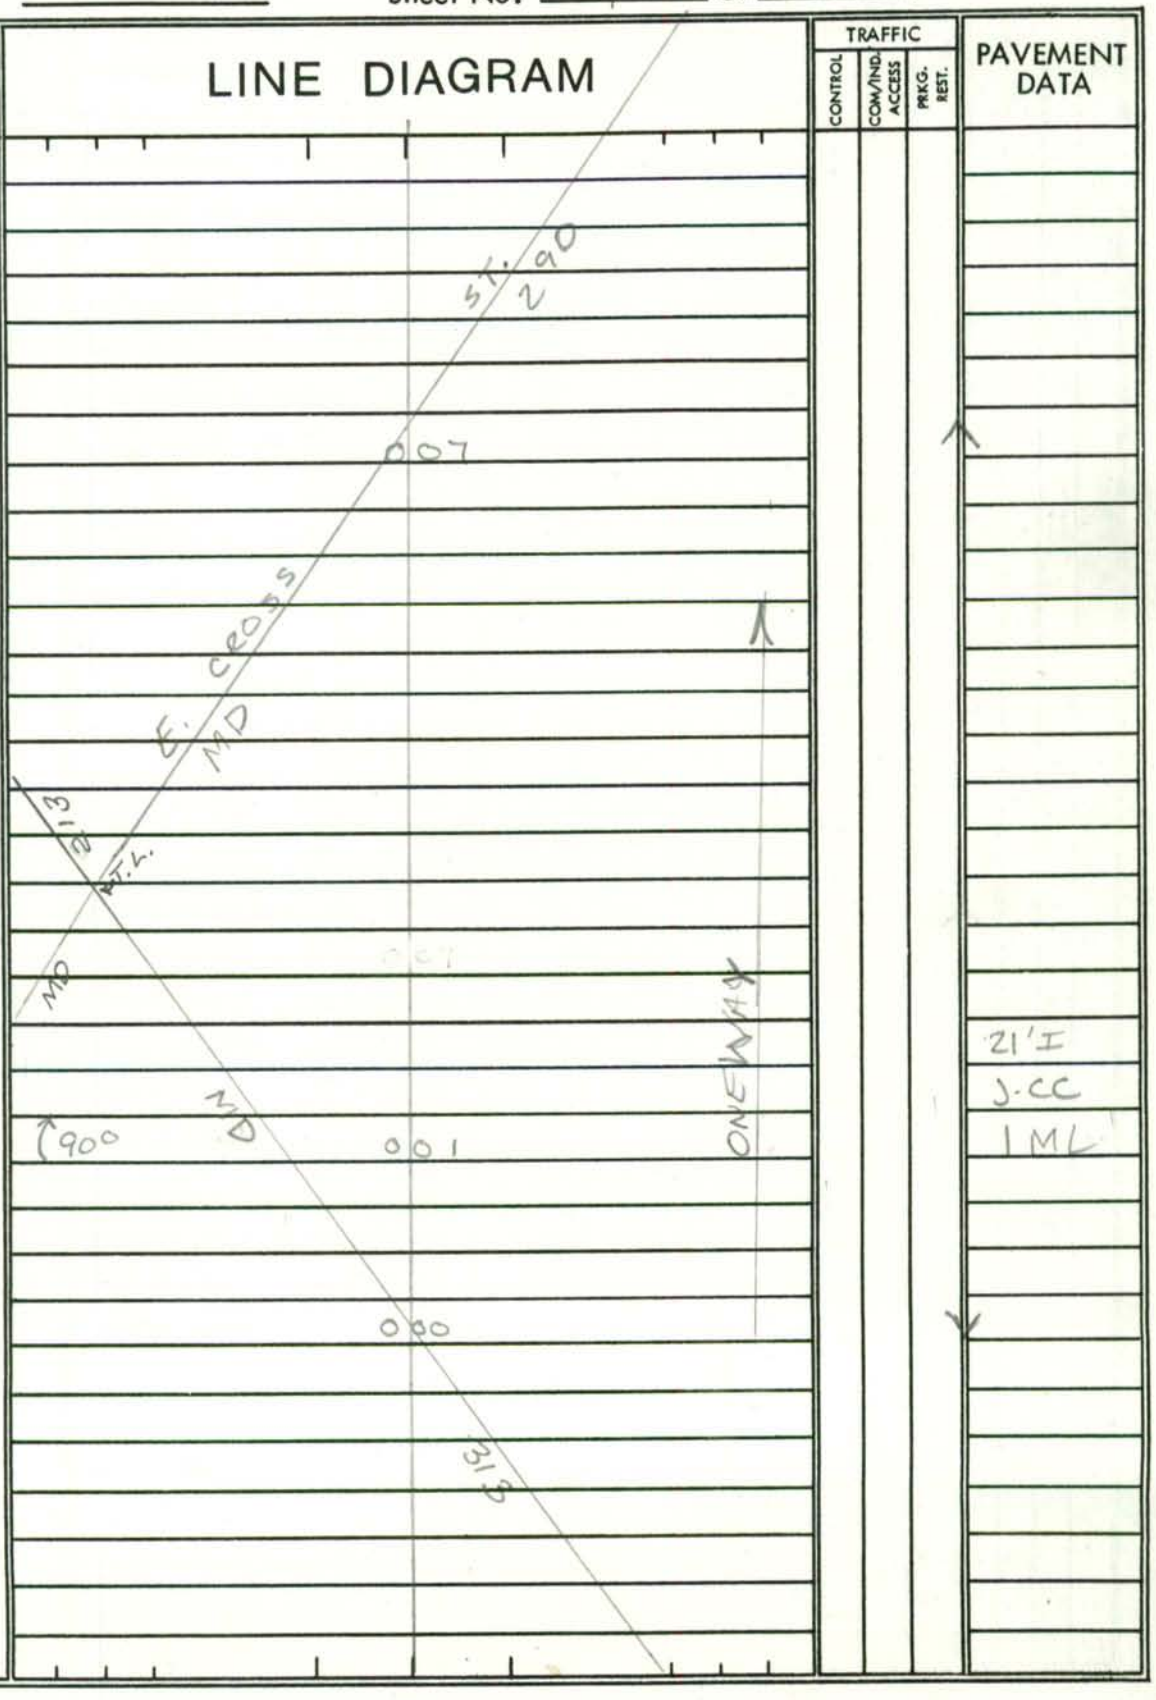

21'I
J.CC
1 ML

SYSTEM				TRAFFIC		LINE DIAGRAM	TRAFFIC				PAVEMENT DATA
FED. AID.	FUNCT. CLASS.	HWY. SYS.	HPMS SAMPLE	PRKG. REST.	COM/IND ACCESS		CONTROL	COM/IND ACCESS	PRKG. REST.		

SHA 51.3 - 8 Revised
4.83

MARYLAND STATE HIGHWAY ADMINISTRATION

ROAD INVENTORY SHEET

SR.00
4-27-00
GOIE/95-ST RE-INV
BB/AL
6-9-95

Party Chief: CG
Recorder: LW
Assistant:
Map No./Dir.: 1
State Coordinates:

Road No.: SPUR
Road Name: MD 290 TO MD 299
County: Kent
Date: 6-20-81
Sheet No.: 1 OF 1

TRAFFIC CODES

TRAFFIC CONTROLS: STOP SIGN=SS, TRAFFIC LIGHT=T.L., FLASHING RED BALL=F.R.

TRAFFIC CODES

PARKING RESTRICTIONS: A.M. PEAK, P.M. PEAK, A.M./P.M. PEAK, NO PARKING ANYTIME=N.P., COMM/IND. ACCESS=E

SYSTEM				TRAFFIC		LINE DIAGRAM	TRAFFIC			PAVEMENT DATA
FED. AID.	FUNCT CLASS.	HWY. SYS.	HPMS SAMPLE	PRK.G. REST.	COM/IND. ACCESS		CONTROL	COM/IND. ACCESS	PRK.G. REST.	
						299				
						MD				
						0.07 RD. 299	YLD			24' I
						WARWICK MD SS GALENA MD 0.08 SASSAFRAS 290 RD.	SS			21' I 6' F RT 2' I LT 2 ML

SYSTEM				TRAFFIC		LINE DIAGRAM	TRAFFIC			PAVEMENT DATA
FED. AID.	FUNCT. CLASS.	HWY. SYS.	HPMS SAMPLE	PRKG. REST.	COM/IND ACCESS		CONTROL	COM/IND ACCESS	PRKG. REST.	

SHA 51.3 - 8 Revised
4.83

MARYLAND STATE HIGHWAY ADMINISTRATION

95 STATE REINVENTORY 6-7-95 TM/BB

90 EX #2 1-10-91 BB/TM

ROAD INVENTORY SHEET

SR.00 4-27-00 GD/EF

00-1ST 1-29-01 GD/EF

00-3ST 1-29-01 GD/EF

Party Chief: C G
Recorder: L W
Assistant:
Map No./Dir.: D 15 / E
State Coordinates: 129 - 521

Road No.: MD 291
Road Name: (MORGNEC RD.)
County: Kent
Date: 6-20-89
Sheet No.: 1 OF 18

TRAFFIC CODES

TRAFFIC CONTROLS: STOP SIGN=SS, TRAFFIC LIGHT=T.L., FLASHING RED BALL=F.R.

TRAFFIC CODES

PARKING RESTRICTIONS: A.M. PEAK, P.M. PEAK, A.M./P.M. PEAK, NO PARKING ANYTIME=N.P., COMM/IND. ACCESS=E

SYSTEM				TRAFFIC		LINE DIAGRAM	TRAFFIC			PAVEMENT DATA
FED. AID.	FUNCT CLASS.	HWY. SYS.	HPMS SAMPLE	PRK.G. REST.	COM/IND. ACCESS		CONTROL	COM/IND. ACCESS	PRK.G. REST.	
						015				
						010 ENT. APT.				
						TALBOT BLVD MU. 0343 009 S.L. 40 MPH				
						J-RT 10' I RT.				
						007				
						006		E		26' I
						005				2-10' I SHD
						004				2 ML
						14' I RTL JCB OUT				21' I ON TAPER TO 12' I RT.
						001				14' I LT
						001/23' I C-C				2-13' I SHD OUT
						Chestertown MD 20 000 MU 0150 High ST	SS			J-CC IN
						ENT GRAIN ELEVATOR				13' J Med
										2 ML
K	K									

FAS 1284 RURAL MINOR ARTERIAL

LINE DIAGRAM

SYSTEM				TRAFFIC			TRAFFIC			PAVEMENT DATA
FED. AID.	FUNCT. CLASS.	HWY. SYS.	HPMS SAMPLE	PRKG. REST.	COM/IND ACCESS		CONTROL	COM/IND ACCESS	PRKG. REST.	
						|RXR| Roadway 0 44				
						MD AND BEL. E.R Exempt. 038	F			
					E	036				
					E	Kent AND Queen ANNE ~~V.F.D.~~ 034 Rescue Squad				
						|RXR| 031 |RXR| ROADWAY				26'I 2-10'ISHD 2 ML

EAS 1284
RURAL MINOR ARTERIAL

SHA 51.3 - 8 Revised
4.83

MARYLAND STATE HIGHWAY ADMINISTRATION

ROAD INVENTORY SHEET

95-25T
A/T
BB/AH
1/19/95

Party Chief: CG
Recorder: LW
Assistant:
Map No./Dir.: /
State Coordinates: 1129 - 521

Road No.: MD 291
Road Name: (MORGNEC RD.)
County: KENT
Date: 6-20-89
Sheet No.: 3 OF 18

TRAFFIC CODES
TRAFFIC CONTROLS: STOP SIGN=SS, TRAFFIC LIGHT=T.L., FLASHING RED BALL=F.R.

TRAFFIC CODES
PARKING RESTRICTIONS: A.M. PEAK, P.M. PEAK, A.M./P.M. PEAK, NO PARKING ANYTIME=N.P., COMM/IND. ACCESS=E

SYSTEM				TRAFFIC		LINE DIAGRAM	TRAFFIC			PAVEMENT DATA
FED. AID.	FUNCT CLASS.	HWY. SYS.	HPMS SAMPLE	PRK.G. REST.	COM/IND. ACCESS		CONTROL	COM/IND. ACCESS	PRK.G. REST.	
	RURAL MAJOR COLLECTOR				E	ONE WAY 069		E		
						13'I 068 S.L 30 MPH			X	
						067				24'I RT
					E	KENT PLAZA SHOP. CENTER 065		E		12'I LT
										~~8'I SHD OUT RT~~
					E	064		E		J C-C ~~SB OUT LT~~
						13'I 12'H				4'J Med
										2 ML
						062			X	
						Washington Ave				
						MD 060 213	TL			
										2-17'I
										J-C-C
						12'H 058 10'I				4'J Med
										2 ML
						055			X	
						053		E		
										2-14'I
										2-10'I SHD OUT
						RXR 051				J-C-C IN
										10'J Med
										2 ML
						047			X	
										26'I
										2-10'I SHD
										2 ML

FAS 1284
RURAL MINOR ARTERIAL

LINE DIAGRAM

SYSTEM: FED. AID. | FUNCT. CLASS. | HWY. SYS. | HPMS SAMPLE

TRAFFIC: PRKG. REST. | COM/IND ACCESS

TRAFFIC: CONTROL | COM/IND ACCESS | PRKG. REST.

PAVEMENT DATA

FAS 1284
RURAL MAJOR COLLECTOR

E

0093 CHURCH

0088 HADAWAY MU. DR. 0145

CHURCH 0084 RTL 12'

HAACK DRY MU. 0143 @.37 0080 12'

E

0079 12' 12' 12'

NURSING HOME 0077

E

0075

E

0073

0072

PAVEMENT DATA:
25'I
2-10' ISHD
X 2ML
2-12'I
3' ESHD ~~OUT~~
~~J-C OUT~~
10' ISHD OUT RT
J-C IN
10' ~~I~~ PAINTED Med
2 ML

SHA 51.3 - 8 Revised
4.83

MARYLAND STATE HIGHWAY ADMINISTRATION

ROAD INVENTORY SHEET

Party Chief: C G
Recorder: L W
Assistant: ~
Map No./Dir.: D 15 / E
State Coordinates: 1129 - 521

Road No.: MD 291
Road Name:
County: KENT
Date: 6-20-89
Sheet No.: 5 OF 18

TRAFFIC CODES
TRAFFIC CONTROLS: STOP SIGN=S.S., TRAFFIC LIGHT=T.L., FLASHING RED BALL=F.R.

TRAFFIC CODES
PARKING RESTRICTIONS: A.M. PEAK, P.M. PEAK, A.M./P.M. PEAK, NO PARKING ANYTIME=N.P., COMM/IND. ACCESS=E

SYSTEM				TRAFFIC		LINE DIAGRAM	TRAFFIC			PAVEMENT DATA
FED. AID.	FUNCT. CLASS.	HWY. SYS.	HPMS SAMPLE	PRK.G. REST.	COM/IND. ACCESS		CONTROL	COM/IND. ACCESS	PRK.G. REST.	
	RURAL MAJOR COLLECTOR		EAS 1284		2E	121				
						118 DPL SUB STATION				
						116 3-24" CMP D-4'				
						SCHAUBER ROAD				
						113				
						OP 36 JIMSTOWN CIRCLE 109				
						107				
					E	106				
						STRATTON				
					E	105				
						OP 36 JIMSTOWN CIRCLE (92-86CO) 103				
						CORP LMTS 101 S.L. 45MPH				
					E	099		E		
						096				25'I
										2-10' ISHD
										2m

LINE DIAGRAM

SYSTEM: FED. AID.	SYSTEM: FUNCT. CLASS.	SYSTEM: HWY. SYS.	SYSTEM: HPMS SAMPLE	TRAFFIC: PRKG. REST.	TRAFFIC: COM/IND ACCESS	LINE DIAGRAM	TRAFFIC: CONTROL	TRAFFIC: COM/IND ACCESS	TRAFFIC: PRKG. REST.	PAVEMENT DATA
	RURAL MAJOR COLLECTOR					201		E		
						194		E		
						192		E		
						178		E		
						171 S.H.A. DIST. 2 OFFICE		E		
						167		E		
						162		E		
						148 S.L. 55 MPH				
						135		E		
						130		E		
						129 2-36" CMP D-4'				
										25'I
										2-10 ISHD
										2ML
						MP — — 125 — 213 UL				

FAS 1284

SHA 51.3 - 8 Revised
4.83

MARYLAND STATE HIGHWAY ADMINISTRATION

ROAD INVENTORY SHEET

Party Chief: C G
Recorder: L W
Assistant:
Map No./Dir.: /
State Coordinates: 1129 - 521

Road No.: MD 291
Road Name:
County: KENT
Date: 6-20-89
Sheet No.: 7 OF 18

TRAFFIC CODES
TRAFFIC CONTROLS: STOP SIGN=SS, TRAFFIC LIGHT=T.L., FLASHING RED BALL=F.R.

TRAFFIC CODES
PARKING RESTRICTIONS: A.M. PEAK, P.M. PEAK, A.M./P.M. PEAK, NO PARKING ANYTIME=N.P., COMM/IND. ACCESS=E

SYSTEM				TRAFFIC		LINE DIAGRAM	TRAFFIC			PAVEMENT DATA
FED. AID.	FUNCT CLASS.	HWY. SYS.	HPMS SAMPLE	PRK.G. REST.	COM/IND. ACCESS		CONTROL	COM/IND ACCESS	PRK.G. REST.	
	RURAL MAJOR COLLECTOR					2 2 83, 80' CP Rd 2 77 FC ENT Public LDG 2 59 2 45 MORGAN 2 43 CREEK 14022 2 41 24J JC-C 2 38 10'I AMERICAN LEGION DR. 10'I 2 35 CO. 28 10'I 2 31 CREEK CO LA. 280 2 28				25'I 2-10'I SHD 2ML

5.E18

SYSTEM: FED. AID. | FUNCT. CLASS. | HWY. SYS. | HPMS SAMPLE

TRAFFIC: PRKG. REST. | COM/IND ACCESS

LINE DIAGRAM

TRAFFIC: CONTROL | COM/IND ACCESS | PRKG. REST.

PAVEMENT DATA

FAS 1284
RURAL MAJOR COLLECTOR

3+91

10'± 10'±

PERKINS HILL RD CO. 40

3+87

BUCKINGHAM RD CO. 228

10'± 10'±

3+83

3+74 36" CP D-6'

3+60 36" CP D-2'

PT

3+18

E 30°

3+04

PRC

2+94

PRC

2+83 60" CP D-5'

35°

2+77

PC

25'±
2-10'± SHD
2ML

SHA 51.3 - 8 Revised
4.83

MARYLAND STATE HIGHWAY ADMINISTRATION

ROAD INVENTORY SHEET

Rivers MD

Party Chief: C G
Recorder: L.W.
Assistant: ~
Map No./Dir.: /
State Coordinates: 1129 - 521

Road No.: MD 291
Road Name: MORGNEC RD
County: KENT
Date: 6-20-89
Sheet No.: 9 OF 18

TRAFFIC CODES
TRAFFIC CONTROLS: STOP SIGN=SS, TRAFFIC LIGHT=T.L., FLASHING RED BALL=F.R.

TRAFFIC CODES
PARKING RESTRICTIONS: A.M. PEAK, P.M. PEAK, A.M./P.M. PEAK, NO PARKING ANYTIME=N.P., COMM/IND. ACCESS=E

SYSTEM				TRAFFIC		LINE DIAGRAM	TRAFFIC			PAVEMENT DATA
FED. AID.	FUNCT CLASS.	HWY. SYS.	HPMS SAMPLE	PRKG. REST.	COM/IND. ACCESS		CONTROL	COM/IND. ACCESS	PRKG. REST.	
	RURAL MAJOR COLLECTOR									25'I
	FAS 1284									2-10'I SHD
										2ML

PT
5 36
5 07
10'I
10'I
MORGNEC RD
CO 18
MORGNEC RD CUTOFF RD
CO 316
(92-71 CO)
5 04
10'I
10'I SHD
40°
4 99
PC
4 87
4 67 48" CP D-6'
4 57
10'I SHD
MORGNEC CUTOFF RD
4 51
CO 317
10'I
10'I SHD
4 46
RR
MORGNEC CUTOFF
CO 316
4 36
10'I
10'I SHD
4 32

SYSTEM: FED. AID. | FUNCT. CLASS. | HWY. SYS. | HPMS SAMPLE
TRAFFIC: PRKG. REST. | COM/IND ACCESS

LINE DIAGRAM

TRAFFIC: CONTROL | COM/IND ACCESS | PRKG. REST.

PAVEMENT DATA

FAS 1284
RURAL MAJOR COLLECTOR

9 01 PT
300°
8 96 PC

#14028
TWIN CBC L-20' C10'CELL W-96" H-10' D-8'
8 35

8 18
10'I SHD
(CHERRY LA.)
MO 298
8 15
10'I SHD
10'I SHD
8 10

7 94 96" CMP D-7'

7 16 36" CP D-4'

6 80 60" CP D-6'

5 97 96" CMP Squash D-9'

5 70 PVT. RD

5 41 36" CP D-8'

25'I
2-10'I SHD
2ML

SHA 51.3 - 8 Revised
4.83

MARYLAND STATE HIGHWAY ADMINISTRATION

ROAD INVENTORY SHEET

91-1 STATE
1-13-92
GD/BB

Party Chief: C G
Recorder: K.W
Assistant: —
Map No./Dir.: /
State Coordinates: 1129 - 521

Road No.: MD 291
Road Name: (RIVER RD)
County: KENT
Date: 6-20-89
Sheet No.: 11 OF 18

TRAFFIC CODES
TRAFFIC CONTROLS: STOP SIGN=SS, TRAFFIC LIGHT=T.L., FLASHING RED BALL=F.R.

TRAFFIC CODES
PARKING RESTRICTIONS: A.M. PEAK, P.M. PEAK, A.M./P.M. PEAK, NO PARKING ANYTIME=N.P., COMM/IND. ACCESS=E

SYSTEM				TRAFFIC		LINE DIAGRAM	TRAFFIC			PAVEMENT DATA
FED. AID.	FUNCT CLASS.	HWY. SYS.	HPMS SAMPLE	PRK.G. REST.	COM/IND. ACCESS		CONTROL	COM/IND. ACCESS	PRK.G. REST.	
	RURAL MAJOR COLLECTOR				E	VFW 1090 1086 60" 48" CP D-7' 1008 4-24" CP D-6' 9 88 ONSHD 8'I MD 290 982 ONSHD 8'I ONSHD 10'I 976 PT PT 30° PC 935 918 ONSHD 10'I MD 290 915 ONSHD 10'I ONSHD 10'I 910				22'NI 2-8'I SHD 2ML ~~26'I~~ ~~8'I RT~~ ~~10'I LT~~ ~~2ML~~ 24'I 8'ISHD RT 10'ISHD LT. 2ML 25'I 2-10'I SHD 2ML
FAS 1294										

FAS 1284
RURAL MAJOR COLLECTOR

SYSTEM: FED. AID. | FUNCT. CLASS. | HWY. SYS. | HPMS SAMPLE
TRAFFIC: PRKG. REST. | COM/IND ACCESS

LINE DIAGRAM

PT 12 28
30°
PC 12 19 36" CP D-2'
~~11 98~~
11 61 3-36" CP D-5
11 09 ACCESS
CHESTERVILLE CO
FOREST RD 245
11 02
SHADDING REACH RD T 19
CO.
END CEM 11 00
ACCESS
Beg CEM 10 96
E V.F.W. # 652 10 93

TRAFFIC: CONTROL | COM/IND ACCESS | PRKG. REST.

PAVEMENT DATA

~~22' NI~~
~~2-8' I SHD~~
~~2 ML~~
~~22' I~~
~~2-8' I SHD~~
2 ML
22' I
2-8' SHD
2 ML

99-15T

SHA 51.3 - 8 Revised 4.83

MARYLAND STATE HIGHWAY ADMINISTRATION

ROAD INVENTORY SHEET

Party Chief CG
Recorder HD
Assistant
Map No./Dir. /
State Coordinates 1129-521

Road No. MD 291
Road Name
County KENT
Date 3/1/00
Sheet No. 13 OF 18

TRAFFIC CODES
TRAFFIC CONTROLS: STOP SIGN-SS, TRAFFIC LIGHT=T.L., FLASHING RED BALL=F.R.

TRAFFIC CODES
PARKING RESTRICTIONS: A.M. PEAK, P.M. PEAK, A.M./P.M. PEAK, NO PARKING ANYTIME=N.P., COMM/IND. ACCESS=E

SYSTEM: FUNCT CLASS	SYSTEM: HWY. SYS.	SYSTEM: HPMS SAMPLE	TRAFFIC: PREG. REST.	TRAFFIC: COM/IND ACCESS	LINE DIAGRAM	TRAFFIC: CONTROL	TRAFFIC: COM/IND ACCESS	TRAFFIC: PREG. REST.	PAVEMENT DATA
									24'I
					RIVER PARK DR				2-3'I SHD
					12 66 CO 210				2ML
					12 64				X 2-18'I
									22' I SHD IN I C-C IN/OUT
					HOWARD JOHNSON RD				30' GRS MED
					CO 701 12 63				2ML
					12 62				X
					#14030				
					BLUE STAR 12 57 MEMORIAL HWY				
					US 12 55 301				
									22'I
					12 52				2-3'I SHD
			E		~~ENT TO SHA SALT DOME~~ 12 49				2ML
					12 43				X
									2-18'I 22' I SHD IN
					EDGE RD				30' GRS MED
					CO 12 42 308				I C-C IN/OUT
					MD 701				2ML
					12 40				X
					#14014				22'I
					MILLS 12 36 BRANCH				2-8'I SHD
									2ML

COUNTY KENT ROAD NO. MD 291 PAGE 14 OF 18

SYSTEM				TRAFFIC		LINE DIAGRAM	TRAFFIC			PAVEMENT DATA
FUNCT. CLASS	HWY SYS	NHS	SAMPLE	PREG. REST.	COM/IND ACCESS		SCH/BUS	COM/IND ACCESS	PREG. REST.	
										22'I
										6'I SHD LT
										20'I ON TAPER TO 4'I SHD RT
						SCHOOL ST				
						MU 0060 13 76				JC-C
										2 ML
						13 72			X	
										22'I
										4'I SHD RT
						CORP LIMITS MILLINGTON				
						13 64			X	
										22'I
						13 62 25 MPH				8'I SHD RT
										2 ML
						13 52			X	
										22'I
										2 ML
						13 42 ~~SL 25 MPH~~			X	
						RIVER PARK RD				
						12 92 CO 210				24'I
										2 ML
						12 85		E		
									X	
						12 70				24'I
						12 68 ~~SL 50 MPH~~				2-3'I SHD
										2 ML

SHA 51.3 - 8 Revised
4.83

MARYLAND STATE HIGHWAY ADMINISTRATION

ROAD INVENTORY SHEET

Party Chief: C.G
Recorder: L.W
Assistant: —
Map No./Dir.: 1
State Coordinates: 1129 - 521

Road No.: MD 291
Road Name: (CYPRESS ST)
County: KENT
Date: 6-20-89
Sheet No.: 15 OF 18

TRAFFIC CODES
TRAFFIC CONTROLS: STOP SIGN=SS, TRAFFIC LIGHT=T.L., FLASHING RED BALL=F.R.

TRAFFIC CODES
PARKING RESTRICTIONS: A.M. PEAK, P.M. PEAK, A.M./P.M. PEAK, NO PARKING ANYTIME=N.P., COMM/IND. ACCESS=E

SYSTEM				TRAFFIC		LINE DIAGRAM	TRAFFIC			PAVEMENT DATA
FED. AID.	FUNCT CLASS.	HWY. SYS.	HPMS SAMPLE	PRKG. REST.	COM/IND. ACCESS		CONTROL	COM/IND. ACCESS	PRKG. REST.	
	RURAL MAJOR COLLECTOR			NPG	E	MD AND DEL 14 13 #MDDE526419R A.R				
						RAILROAD Ave MU. 0040 14 12				39'-I
										J-C-C
						14 10 RXR Roadway				2 ML
						14 09 RXR				
						SASSAFRASS MD 14 08 ST. 319	TL			
						CHURCH 14 04			NPG	26'-I
										J-C-C
						COMEGYS ST MU. 0010 13 92				2 ML
						13 82				22'-I
										~~6'-I SHD RT~~
										~~J-C-C~~
										20'-I on taper to 4'-I SHD RT
										J-C-C 2 ML

SYSTEM				TRAFFIC		LINE DIAGRAM	TRAFFIC			PAVEMENT DATA
FED. AID.	FUNCT. CLASS.	HWY. SYS.	HPMS SAMPLE	PRKG. REST.	COM/IND ACCESS		CONTROL	COM/IND ACCESS	PRKG. REST.	
						14 47				
						14 38				
						14 33 40 MPH				
						CYPRESS 14 32 BRANCH ## 14015				24'I
										2 ML
						CORP LMTS 14 29 MILLINGTON		E	X	
						CRANE MU. 14 20 ST 0020				
						(RXR) XING 14 19				
						RXR Roadway 14 17				
						~~MILLINGTON~~ ~~P.O.~~ 14 16				
						~~OLD~~ MILLINGTON P.O. 14 14				39'I
										J-C-C
										2 ML

FAS 1284
RURAL MAJOR COLLECTOR

SHA 51.3 - 8 Revised
4.83

MARYLAND STATE HIGHWAY ADMINISTRATION

ROAD INVENTORY SHEET

Party Chief: CG
Recorder: LW
Assistant:
Map No./Dir.: /
State Coordinates: 1129 - 521

Road No.: MD 291
Road Name: (CYPRESS RD)
County: KENT
Date: 6-20-89
Sheet No.: 17 OF 18

TRAFFIC CODES
TRAFFIC CONTROLS: STOP SIGN=SS, TRAFFIC LIGHT=T.L., FLASHING RED BALL=F.R.

TRAFFIC CODES
PARKING RESTRICTIONS: A.M. PEAK, P.M. PEAK, A.M./P.M. PEAK, NO PARKING ANYTIME=N.P., COMM/IND. ACCESS=E

SYSTEM				TRAFFIC		LINE DIAGRAM	TRAFFIC			PAVEMENT DATA
FED. AID.	FUNCT CLASS.	HWY. SYS.	HPMS SAMPLE	PRKG. REST.	COM/IND. ACCESS		CONTROL	COM/IND. ACCESS	PRKG. REST.	
	RURAL MAJOR COLLECTOR									
	FAS 1284									
						17 18 36" CMP D-1'				24'I
										2 ML
						76 59 PT			X	
						16 59 PT				24'I
						45°				2-10'I SHD
										2 ML
						16 48 PC			X	
						BIG STONE RD PEACOCK CORNER RD CO 26 227				
						15 47 PEACOCK CORNER RD CO. 241				
						KILEYS NECK RD CO 275 15 29				
						14 92 50 MPH				
						PT 14 81 PT				
						45° 14 58 S.L. 50 MPH 45°				
						PC 14 50 PC				24'I
										2 ML

18 of 18

SYSTEM				TRAFFIC		LINE DIAGRAM	TRAFFIC			PAVEMENT DATA
FED. AID.	FUNCT. CLASS.	HWY. SYS.	HPMS SAMPLE	PRKG. REST.	COM/IND ACCESS		CONTROL	COM/IND ACCESS	PRKG. REST.	

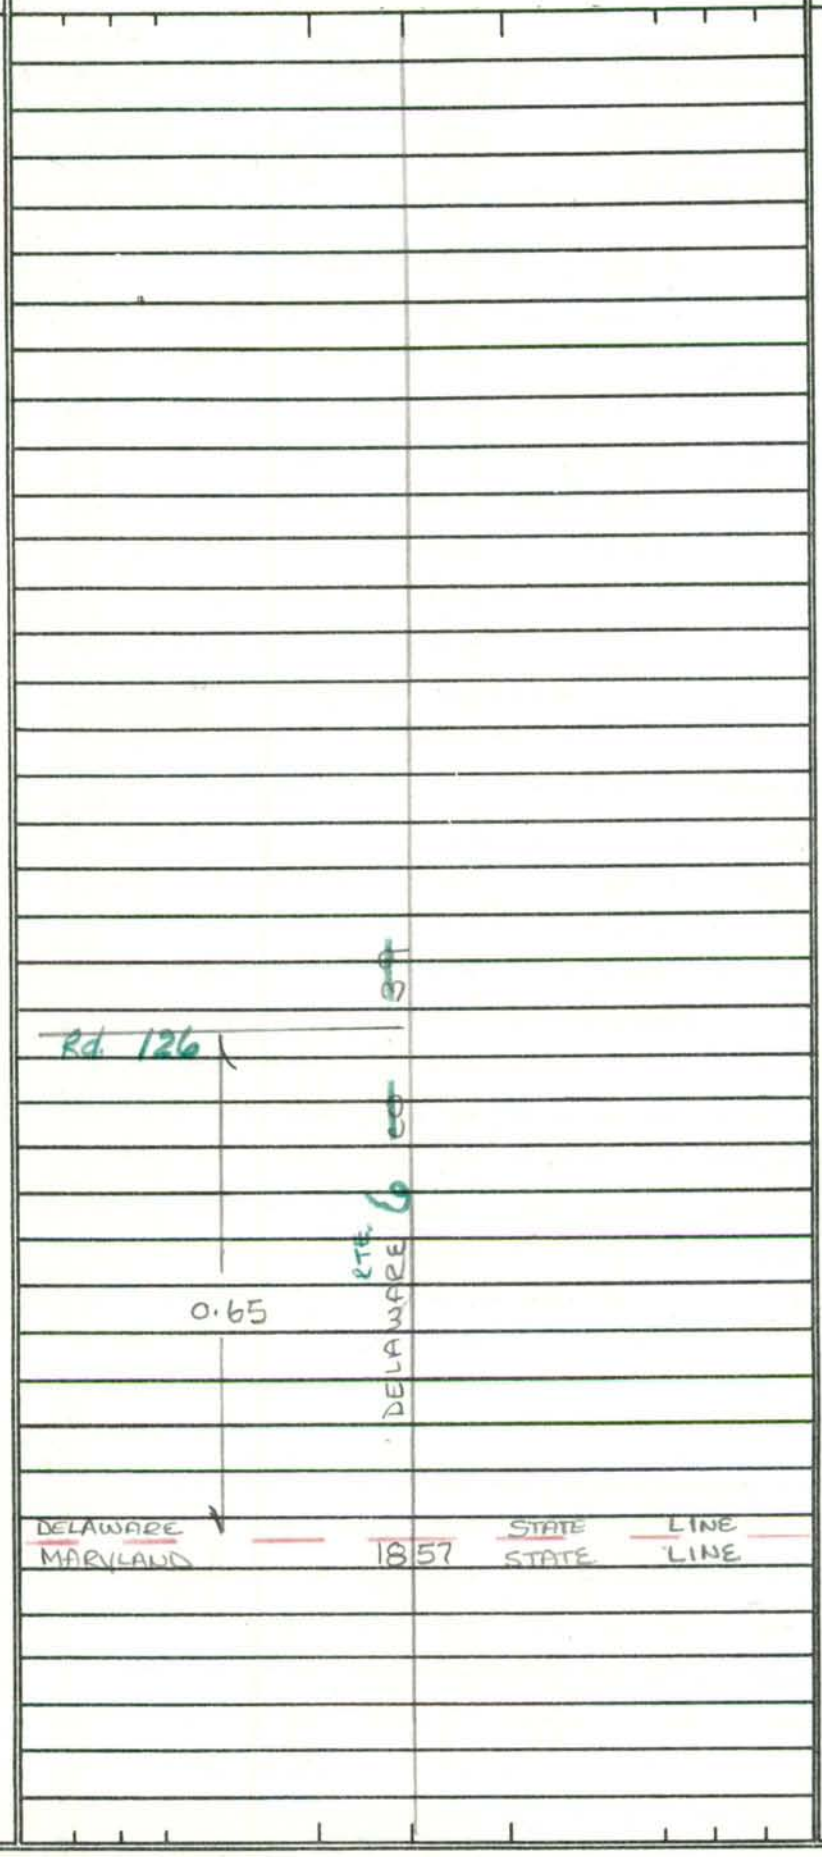

FAS 1284
R-MAJOR COLLECTOR

24'I
2 ML

SHA 51.3 - 8 Revised
4.83

MARYLAND STATE HIGHWAY ADMINISTRATION

ROAD INVENTORY SHEET

Party Chief _____
Recorder _____
Assistant _____
Map No./Dir. 1
State Coordinates _____

Road No. MD 291A
Road Name _____
County KENT
Date _____
Sheet No. _____ OF _____

SYSTEM				TRAFFIC		LINE DIAGRAM	TRAFFIC			PAVEMENT DATA
FED. AID.	FUNCT CLASS.	HWY. SYS.	HPMS SAMPLE	PRKG. REST.	COM/IND. ACCESS		CONTROL	COM/IND. ACCESS	PRKG. REST.	
						UNASSIGNED NOW CO 317 TRANSFER LETTER 12-1-87 87-63				

TRAFFIC CODES

TRAFFIC CONTROLS: STOP SIGN=S.S.,
TRAFFIC LIGHT=T.L.,
FLASHING RED BALL=F.R.

TRAFFIC CODES

PARKING RESTRICTIONS: A.M. PEAK,
P.M. PEAK, A.M./P.M. PEAK, NO PARKING
ANYTIME=N.P., COMM/IND. ACCESS=E

SYSTEM				TRAFFIC		LINE DIAGRAM	TRAFFIC				PAVEMENT DATA
FED. AID.	FUNCT. CLASS.	HWY. SYS.	HPMS SAMPLE	PRK'G. REST.	COM/IND ACCESS		CONTROL	COM/IND ACCESS	PRK'G. REST.		

SHA 51.3 - 8 Revised
4.83

MARYLAND STATE HIGHWAY ADMINISTRATION

ROAD INVENTORY SHEET

Party Chief _____
Recorder _____
Assistant _____
Map No./Dir. 1
State Coordinates _____

Road No. MD 291B
Road Name _____
County Kent
Date _____
Sheet No. _____ OF _____

SYSTEM				TRAFFIC		LINE DIAGRAM	TRAFFIC			PAVEMENT DATA
FED. AID.	FUNCT CLASS.	HWY. SYS.	HPMS SAMPLE	PRK.G. REST.	COM/IND. ACCESS		CONTROL	COM/IND. ACCESS	PRK.G. REST.	
						UNASSIGNED				
						Now Part of				
						Co 18				
						Transfer Letter				
						12-1-87				
						87-65				

TRAFFIC CODES

TRAFFIC CONTROLS: STOP SIGN=SS, TRAFFIC LIGHT=T.L., FLASHING RED BALL=F.R.

TRAFFIC CODES

PARKING RESTRICTIONS: A.M. PEAK, P.M. PEAK, A.M./P.M. PEAK, NO PARKING ANYTIME=N.P., COMM/IND. ACCESS=E

SYSTEM				TRAFFIC		LINE DIAGRAM	TRAFFIC			PAVEMENT DATA
FED. AID.	FUNCT. CLASS.	HWY. SYS.	HPMS SAMPLE	PRKG. REST.	COM/IND ACCESS		CONTROL	COM/IND ACCESS	PRK.G. REST.	

SHA 51.3 - 8 Revised
4.83

TRANSFER LETTER 11-18-94

'95 STATE REINVENTORY
6-6-95 TM/BB

MARYLAND STATE HIGHWAY ADMINISTRATION

ROAD INVENTORY SHEET

SR.00
4-27-00
CD/EF

Party Chief _____
Recorder _____
Assistant _____
Map No./Dir. 1 N
State Coordinates 1070 541

Road No. MD 292
Road Name STILL POND RD
County KENT
Date 11-15-94
Sheet No. 1 OF 4

TRAFFIC CODES
TRAFFIC CONTROLS: STOP SIGN=SS, TRAFFIC LIGHT=T.L., FLASHING RED BALL=F.R.

TRAFFIC CODES
PARKING RESTRICTIONS: A.M. PEAK, P.M. PEAK, A.M./P.M. PEAK, NO PARKING ANYTIME=N.P., COMM/IND. ACCESS=E

SYSTEM				TRAFFIC		LINE DIAGRAM	TRAFFIC			PAVEMENT DATA
FED. AID.	FUNCT CLASS.	HWY. SYS.	HPMS SAMPLE	PRKG. REST.	COM/IND. ACCESS		CONTROL	COM/IND. ACCESS	PRKG. REST.	
	RURAL MAJOR COLLECTOR	STATE SECONDARY			4 JS	1 24 CHURCH & CEMETERY				
						1 23				24' I
						1 09 ~~MAPLE AVE CO 46~~ Maple Ave CO 46				2-~~14~~ I SHD 2 ML
						1 04			X	21' I
										4' I SHD ET 2 ML
						1 00			X	
						0 94 (MAIN ST) CO 47 P.O. 90°		E		21' I 2-6' I SHD 2 ML
						0 93 (STILL POND RD) MD 566 90°	SS		X	
						0 79			X	22' I 2 ML
						0 76				
						0 67 PT				
						0 61 SIGN: STILL POND 30"				
						0 59 PC				
						0 57 S.L. 25 MPH				
						0 50 36" CMP D-1'				
										22' I 2-6' I SHD 2 ML
						(HANDS MEADOW RD) MD 298 0 00	SS		X	
						STILL POND RD 15				
						13				

SYSTEM				TRAFFIC		LINE DIAGRAM	TRAFFIC			PAVEMENT DATA
FED. AID.	FUNCT. CLASS.	HWY. SYS.	HPMS SAMPLE	PRK.G. REST.	COM/IND ACCESS		CONTROL	COM/IND ACCESS	PRK.G. REST.	

SHA 51.3 - 8 Revised
4.83

MARYLAND STATE HIGHWAY ADMINISTRATION

ROAD INVENTORY SHEET

Party Chief: C G
Recorder: L W
Assistant: —
Map No./Dir.: 1
State Coordinates:

Road No.: MD 292
Road Name:
County: Kent
Date: 6-20-89
Sheet No.: 32 OF 74

TRAFFIC CODES
TRAFFIC CONTROLS: STOP SIGN=SS, TRAFFIC LIGHT=T.L., FLASHING RED BALL=F.R.

TRAFFIC CODES
PARKING RESTRICTIONS: A.M. PEAK, P.M. PEAK, A.M./P.M. PEAK, NO PARKING ANYTIME=N.P., COMM/IND. ACCESS=E

SYSTEM				TRAFFIC		LINE DIAGRAM	TRAFFIC			PAVEMENT DATA
FED. AID.	FUNCT CLASS.	HWY. SYS.	HPMS SAMPLE	PRKG. REST.	COM/IND. ACCESS		CONTROL	COM/IND. ACCESS	PRKG. REST.	
						FAS 1285 RURAL MAJOR COLLECTOR				
						BEGIN DIVIDED				
						2 84 66 60" CP D-7'				
						3 80 S.L. 40 MPH				
						↑ CORP LMTS 3 72 64				
						3 21 03 2-24" CP D-1'				
						3 07 ROYAL SWAN RD 89 G 314				
						STILL POND NECK RD 2 69 57 G 52				
						2 47 29 36" CP D-3'				
						3 86 80 2-24" CMP D-1'				
						PT 1 87				
						4 86 68				
						45° INCREASING CAL. STATION 264 MD 313 0.02/16'E 1JML				
						1 83 65				22'I
						MD 864				2-6'I SHDS
						PC 1 76 58				2ML
						1 58 S.L. 50 MPH				X 24'I
						4 57 59 CHURCH				86'I SHD RT
										2 ML
						4 54 42 HALL				4'I SHD LT.
						1 34 S.L. 35 MPH				X

LINE DIAGRAM

SYSTEM: FED. AID. | FUNCT. CLASS. | HWY. SYS. | HPMS SAMPLE
TRAFFIC: PRKG. REST. | COM/IND ACCESS
TRAFFIC: CONTROL | COM/IND ACCESS | PRKG. REST.
PAVEMENT DATA

NON FA
RURAL MINOR COLLECTOR
FAS 1285
R-MAJOR COLLECTOR

4 46 CHURCH
4 42
4 41 SECOND AVE
723 MU. 110
4 39
4 32 THIRD AVE
714 MU. 120
4 30
712 CHURCH
WHEELER AVE 4 28
MU 0135
4 20 FOURTH AVE
MU. 0060
MAIN ST.
4 13 FIFTH AVE
695 MU. 0040
4 07
PARK
HOWELL PT. RD. 4 04 SIXTH AVE
MU 0085 CO 148
BETTERTON
3 99
Y.F.D 3 98
3 96 S.L. 25 MPH

PAVEMENT DATA:
22'I
3'I SHDRT
8'I SHD LT
JC-LT
2ML
22'I
8'I SHDLT
JC-LT
2ML
2
22'I
8'I SHD LT
J-C-LT
4'I SHD RT
2ML
20'I
2ML
20'I
3'I SHDLT
4'I SHDRT
2ML
20'I
2ML
22'I
2-6'I SHLD
2ML

SHA 51.3 - 8 Revised
4.83

MARYLAND STATE HIGHWAY ADMINISTRATION

ROAD INVENTORY SHEET

Party Chief: C.G.
Recorder: L.W.
Assistant:
Map No./Dir.: 1
State Coordinates:

Road No.: MD 292
Road Name: MAIN ST
County: KENT
Date: 6-20-89
Sheet No.: 74 OF 74

SYSTEM: FED. AID. | FUNCT. CLASS. | HWY. SYS. | HPMS SAMPLE
TRAFFIC: PRK.G. REST. | COM/IND. ACCESS

LINE DIAGRAM

TRAFFIC: CONTROL | COM/IND. ACCESS | PRK.G. REST.

PAVEMENT DATA

SASSAFRAS RIVER

ROAD ~~7 4 ~~ END

(ERICSSON AVE) 4 50
MU 0030 9 38

4 55
~~7 37~~ Sign: END STATE MAINT.

4 47 FIRST AVE
7 29 MU 0050

NON FA
RURAL MINOR COLLECTOR
R-LOCAL

4
53

20'I
I C-C
2 ML

20'I I-CC
2 ML

2
2'I
I' SHLD LT
8' I SHLD CT
3 4'I SHLD RT
2 ML

TRAFFIC CODES

TRAFFIC CONTROLS: STOP SIGN=SS, TRAFFIC LIGHT=T.L., FLASHING RED BALL=F.R.

TRAFFIC CODES

PARKING RESTRICTIONS: A.M. PEAK, P.M. PEAK, A.M./P.M. PEAK, NO PARKING ANYTIME=N.P., COMM/IND. ACCESS=E

SYSTEM				TRAFFIC		LINE DIAGRAM	TRAFFIC			PAVEMENT DATA
FED. AID.	FUNCT. CLASS.	HWY. SYS.	HPMS SAMPLE	PRKG. REST.	COM/IND ACCESS		CONTROL	COM/IND ACCESS	PRKG. REST.	

SHA 51.3 - 8 Revised
4.83

MARYLAND STATE HIGHWAY ADMINISTRATION

ROAD INVENTORY SHEET

Party Chief _____
Recorder _____
Assistant _____
Map No./Dir. 1
State Coordinates _____

Road No. MD 293
Road Name _____
County KENT
Date _____
Sheet No. _____ OF _____

SYSTEM				TRAFFIC		LINE DIAGRAM	TRAFFIC			PAVEMENT DATA
FED. AID.	FUNCT. CLASS.	HWY. SYS.	HPMS SAMPLE	PRKG. REST.	COM/IND. ACCESS		CONTROL	COM/IND. ACCESS	PRKG. REST.	
						UNASSIGNED NOW CO 319 TRANSFER LETTER 12-1-87 87-68				

TRAFFIC CODES

TRAFFIC CONTROLS: STOP SIGN=SS, TRAFFIC LIGHT=T.L., FLASHING RED BALL=F.R.

TRAFFIC CODES

PARKING RESTRICTIONS: A.M. PEAK, P.M. PEAK, A.M./P.M. PEAK, NO PARKING ANYTIME=N.P., COMM/IND. ACCESS=E

SYSTEM				TRAFFIC		LINE DIAGRAM	TRAFFIC			PAVEMENT DATA
FED. AID.	FUNCT. CLASS.	HWY. SYS.	HPMS SAMPLE	PRK'G. REST.	COM/IND ACCESS		CONTROL	COM/IND ACCESS	PRK'G. REST.	

SHA 51.3 - 8 Revised
4.83

MARYLAND STATE HIGHWAY ADMINISTRATION

ROAD INVENTORY SHEET

Party Chief _____
Recorder _____
Assistant _____
Map No./Dir. 1
State Coordinates _____

Road No. MD 293 A
Road Name _____
County KENT
Date _____
Sheet No. _____ OF _____

SYSTEM				TRAFFIC		LINE DIAGRAM	TRAFFIC			PAVEMENT DATA
FED. AID.	FUNCT CLASS.	HWY. SYS.	HPMS SAMPLE	PRKG. REST.	COM/IND. ACCESS		CONTROL	COM/IND. ACCESS	PRKG. REST.	
						UNASSIGNED				
						NOW MD 320				
						TRANSFER LETTER 12-1-87				
						87-64				

TRAFFIC CODES

TRAFFIC CONTROLS: STOP SIGN=SS, TRAFFIC LIGHT=T.L., FLASHING RED BALL=F.R.

TRAFFIC CODES

PARKING RESTRICTIONS: A.M. PEAK, P.M. PEAK, A.M./P.M. PEAK, NO PARKING ANYTIME=N.P., COMM/IND. ACCESS=E

SYSTEM				TRAFFIC		LINE DIAGRAM	TRAFFIC				PAVEMENT DATA
FED. AID.	FUNCT. CLASS.	HWY. SYS.	HPMS SAMPLE	PRK'G. REST.	COM/IND ACCESS		CONTROL	COM/IND ACCESS	PRK'G. REST.		

SHA 51.3 - 8 Revised
4.83

MARYLAND STATE HIGHWAY ADMINISTRATION

ROAD INVENTORY SHEET

Party Chief _____
Recorder _____
Assistant _____
Map No./Dir. 1
State Coordinates _____

Road No. MD 293B
Road Name _____
County Kent
Date _____
Sheet No. _____ OF _____

SYSTEM				TRAFFIC		LINE DIAGRAM	TRAFFIC			PAVEMENT DATA
FED. AID.	FUNCT CLASS.	HWY. SYS.	HPMS SAMPLE	PRKG. REST.	COM/IND. ACCESS		CONTROL	COM/IND. ACCESS	PRKG. REST.	

UNASSIGNED

Now Co 5/

TRANSFER LETTER
12-1-87
87-66

TRAFFIC CODES

TRAFFIC CONTROLS: STOP SIGN=SS, TRAFFIC LIGHT=T.L., FLASHING RED BALL=F.R.

TRAFFIC CODES

PARKING RESTRICTIONS: A.M. PEAK, P.M. PEAK, A.M./P.M. PEAK, NO PARKING ANYTIME=N.P., COMM/IND. ACCESS=E

SYSTEM				TRAFFIC		LINE DIAGRAM	TRAFFIC			PAVEMENT DATA
FED. AID.	FUNCT. CLASS.	HWY. SYS.	HPMS SAMPLE	PRK.G. REST.	COM/IND ACCESS		CONTROL	COM/IND ACCESS	PRK.G. REST.	

SHA 51.3 - 8 Revised
4.83

MARYLAND STATE HIGHWAY ADMINISTRATION

ROAD INVENTORY SHEET

Party Chief _____
Recorder _____
Assistant _____
Map No./Dir. 1
State Coordinates _____

Road No. MD 293 C
Road Name _____
County KENT
Date _____
Sheet No. _____ OF _____

SYSTEM				TRAFFIC		LINE DIAGRAM	TRAFFIC			PAVEMENT DATA
FED. AID.	FUNCT. CLASS.	HWY. SYS.	HPMS SAMPLE	PRKG. REST.	COM/IND. ACCESS		CONTROL	COM/IND. ACCESS	PRKG. REST.	
						UNASSIGNED NOW CO 318 TRANSFER LETTER 12-1-87 87-67				

TRAFFIC CODES

TRAFFIC CONTROLS: STOP SIGN=SS, TRAFFIC LIGHT=T.L., FLASHING RED BALL=F.R.

TRAFFIC CODES

PARKING RESTRICTIONS: A.M. PEAK, P.M. PEAK, A.M./P.M. PEAK, NO PARKING ANYTIME=N.P., COMM/IND. ACCESS=E

SYSTEM				TRAFFIC		LINE DIAGRAM	TRAFFIC				PAVEMENT DATA
FED. AID.	FUNCT. CLASS.	HWY. SYS.	HPMS SAMPLE	PRK.G. REST.	COM/IND ACCESS		CONTROL	COM/IND ACCESS	PRK.G. REST.		

SHA 51.3 - 8 Revised
4.83

MARYLAND STATE HIGHWAY ADMINISTRATION

ROAD INVENTORY SHEET

93-2 ST '95 STATE
B.D.A.H REINVENTORY
11-8-93 6-6-95
SR.00 TM/BB
M-27-00
GD/EF 95-1ST
BD/AH
1/19/95

Party Chief: C G
Recorder: L W
Assistant:
Map No./Dir.: D15, D14 / N W
State Coordinates: 1064-513.5

Road No.: MD 297
Road Name: (WORTON RD).
County: KENT
Date: 6-21-89
Sheet No.: 1 OF 86

TRAFFIC CODES
TRAFFIC CONTROLS: STOP SIGN=SS, TRAFFIC LIGHT=T.L., FLASHING RED BALL=F.R.

TRAFFIC CODES
PARKING RESTRICTIONS: A.M. PEAK, P.M. PEAK, A.M./P.M. PEAK, NO PARKING ANYTIME=N.P., COMM/IND. ACCESS=E

SYSTEM: FED. AID.	SYSTEM: FUNCT CLASS.	SYSTEM: HWY. SYS.	SYSTEM: HPMS SAMPLE	TRAFFIC: PRK.G. REST.	TRAFFIC: COM/IND. ACCESS	LINE DIAGRAM	TRAFFIC: CONTROL	TRAFFIC: COM/IND. ACCESS	TRAFFIC: PRK.G. REST.	PAVEMENT DATA
	FAS 1287 RURAL MAJOR COLLECTOR				E	PT 0|90 40° PRC 0|69 36" CP D-3' PRC 30° PC 0|53 0|40 36" CP D-1' 0|12 S.L 50MPH 0|04 0|03 0|02 0.01/16 I-3' I SHD RT HWY 23 0|00 HERMAN AUGUSTINE MD				20' I ~~22' I~~ 2-8' ~~I~~ SHD 2 ML 22' I 16' ~~I~~ SHD RT 14' I SHD LT ~~2 ML~~
K	K						SS			

FAS 1287
RURAL MASON COLLECTOR

SYSTEM: FED. AID.	SYSTEM: FUNCT. CLASS.	SYSTEM: HWY. SYS.	SYSTEM: HPMS SAMPLE	TRAFFIC: PRKG. REST.	TRAFFIC: COM/IND ACCESS	LINE DIAGRAM	TRAFFIC: CONTROL	TRAFFIC: COM/IND ACCESS	TRAFFIC: PRKG. REST.	PAVEMENT DATA
					E	2 00				
					E	HULS 1 94				
						PT 1 80				21'I
						30°				2-8'I SHOS
						PC 1 67				2 ML
						1 60				X 20'I
					E	To Paradee Gas Co. 1 55				14'I SHD LT JC-LT
										12'I SHORT
					E	~~(PROP.)~~ To Paradee Gas Co. 1 50				2 ML
						1 48				X
						1 15 48" CP D-1'				
						1 09 PT				
						MARY MORRIS RD				
						~~MORRIS~~ CO. ~~RD.~~ 69 1 06 30°				
						1 06				
						1 01 PC				20'I
										~~22'I~~
										2-8~~'I~~ SHD
										2 ML

SHA 51.3 - 8 Revised
4.83

MARYLAND STATE HIGHWAY ADMINISTRATION

ROAD INVENTORY SHEET

Party Chief: C G
Recorder: L W
Assistant:
Map No./Dir.: /
State Coordinates: 1064 - 513

Road No.: MD 297
Road Name: (~~EASTON~~ WORTON RD.)
County: KENT
Date: 6-21-89
Sheet No.: 3 OF ~~8~~ 6

TRAFFIC CODES
TRAFFIC CONTROLS: STOP SIGN=SS, TRAFFIC LIGHT=T.L., FLASHING RED BALL=F.R.

TRAFFIC CODES
PARKING RESTRICTIONS: A.M. PEAK, P.M. PEAK, A.M./P.M. PEAK, NO PARKING ANYTIME=N.P., COMM/IND. ACCESS=E

SYSTEM				TRAFFIC		LINE DIAGRAM	TRAFFIC			PAVEMENT DATA
FED. AID.	FUNCT. CLASS.	HWY. SYS.	HPMS SAMPLE	PRK.G. REST.	COM/IND. ACCESS		CONTROL	COM/IND. ACCESS	PRK.G. REST.	
						2 40 48" CP D-2'				
						2 33 36" CP D-4'				
						2 26 36" CP D-4'				22'I
										8'~~I~~ SHD RT
										8'I SHD LT.
										(J-CB LT)
						2 ~~13~~20				2 ML
						2 11 SL. 40 MPH				
						2 05 2-60" CMP SQUASH D-4'				
						CHINQUAPIN RD. CO. 68 2 04				
						2 02 48" CP D-2'				
										21'I
										~~22'I~~
										2-8'~~I~~ SHLD
										2 ML

FAS 1287
RURAL MAJOR COLLECTOR

FAS 1287
RURAL MAJOR COLLECTOR

SYSTEM: FED. AID.	SYSTEM: FUNCT. CLASS.	SYSTEM: HWY. SYS.	SYSTEM: HPMS SAMPLE	TRAFFIC: PRKG. REST.	TRAFFIC: COM/IND ACCESS	LINE DIAGRAM	TRAFFIC: CONTROL	TRAFFIC: COM/IND ACCESS	TRAFFIC: PRKG. REST.	PAVEMENT DATA
						WORTON LYNCH RD.				
						282 CO 67				
					E	281				
						~~280~~ RXR				
						277 RXR SIGN & Roadway Markings (RXR)				
						CHURCH 276				
						COUNTRY DR				
						262 OP (~~72~~ 63)				
						259 36" CP D-2'				22I
										2-9'I SHD
										2ML
						247 S.L. 30MPH				(40'I J-CC)
						246 SIGN: WORTON			X	
						24~~5~~				
										22'I
										8'~~I~~J SHD RT
										8'I SHD LT
										(J-CB LT)
										2ML

SHA 51.3 - 8 Revised
4.83

MARYLAND STATE HIGHWAY ADMINISTRATION

ROAD INVENTORY SHEET

G 393

Party Chief: CG
Recorder: LW
Assistant:
Map No./Dir.: /
State Coordinates: 1064 - 513

Road No.: MD 297
Road Name: (Worton E RD.)
County: Kent
Date: 6-21-89
Sheet No.: 5 OF 86

TRAFFIC CODES
TRAFFIC CONTROLS: STOP SIGN=SS, TRAFFIC LIGHT=T.L., FLASHING RED BALL=F.R.

TRAFFIC CODES
PARKING RESTRICTIONS: A.M. PEAK, P.M. PEAK, A.M./P.M. PEAK, NO PARKING ANYTIME=N.P., COMM/IND. ACCESS=E

SYSTEM				TRAFFIC		LINE DIAGRAM	TRAFFIC			PAVEMENT DATA
FED. AID.	FUNCT. CLASS.	HWY. SYS.	HPMS SAMPLE	PRKG. REST.	COM/IND. ACCESS		CONTROL	COM/IND. ACCESS	PRKG. REST.	
						(RXR) Sign 2 90				
						~~RXR~~ ~~Roadway~~ ~~2 89~~				
						2 88		E		
						PORTERS GROVE ~~NORTH~~ RD CO. 66 2 87		E		
					E	2 86				22'I
										2-8'~~S~~I SHD
										2 ML
						MD AND DELAWARE RAILROAD 2 85 MDDE526442K			X	
					E	2 84		E		
						WORTON P.O. 2 83				22'I
										2-9'I SHD
										2 ML
										(40'I JCC)

FAS 1287 RURAL MAJOR COLLECTOR

LINE DIAGRAM

SYSTEM				TRAFFIC				TRAFFIC			PAVEMENT DATA
FED. AID.	FUNCT. CLASS.	HWY. SYS.	HPMS SAMPLE	PRKG. REST.	COM/IND ACCESS			CONTROL	COM/IND ACCESS	PRKG. REST.	
X NON FA	X R-MINOR COLLECTOR			N/P						N/P	20'I
											2 ML
FAS 12-87	RURAL MAJOR COLLECTOR										

3 65
3 23
3 62 ~~36" CMP Squash~~ D-1
(Lamb's Meadow RD
MD 3 59 298
3 56 PT
30°
PC
3 46
3 43 WORTON ELE. School
3 39 Ent. Worton ELE. School
3 20 A
E Park office 3 08
3 07 WORTON Park ~~Rec. Cen.~~ Rd.
CO. 207
3 02 A
2 94 48" CP D-1'
RXR Roadway Markings 2 91

SS
E

22'I
2-8' S SHD
2 ML

SHA 51.3 - 8 Revised
4.83

MARYLAND STATE HIGHWAY ADMINISTRATION

ROAD INVENTORY SHEET

C0397

Party Chief: CG
Recorder: LW
Assistant:
Map No./Dir.: D14 / NW
State Coordinates:

Road No.: MD 297
Road Name: (SMITHVLLE RD)
County: Kent
Date: 6-21-89
Sheet No.: 7 OF 8

SYSTEM				TRAFFIC		LINE DIAGRAM	TRAFFIC			PAVEMENT DATA
FED. AID.	FUNCT. CLASS.	HWY. SYS.	HPMS SAMPLE	PRKG. REST.	COM/IND. ACCESS		CONTROL	COM/IND. ACCESS	PRKG. REST.	
	NON FA	RURAL MINOR COLLECTOR								

TRAFFIC CODES
TRAFFIC CONTROLS: STOP SIGN=SS, TRAFFIC LIGHT=T.L., FLASHING RED BALL=F.R.

TRAFFIC CODES
PARKING RESTRICTIONS: A.M. PEAK, P.M. PEAK, A.M./P.M. PEAK, NO PARKING ANYTIME=N.P., COMM/IND. ACCESS=E

6|96

6|16 PT

MASS / ANE

6|12 OP 180

SPUR .03 / 30'D 875

6|09

6|07 36" CMP D-1' PC 3 9 3

5|09 PT 20

30°

(92-23 CO)

ST. James Co. ~~Smithville~~ 60 Rd. 5|02 PC

Moorebello Lake RD 54

CO.

4|72

20'I

2 ML

LINE DIAGRAM

SYSTEM: FED. AID. | FUNCT. CLASS. | HWY. SYS. | HPMS SAMPLE

TRAFFIC: PRKG. REST. | COM/IND ACCESS

TRAFFIC: CONTROL | COM/IND ACCESS | PRKG. REST.

PAVEMENT DATA

ANDELOT FARM LA RD.
PVT.

GATE

Road 7 36 END (END STATEMENT)

NEWTOWN RD.
CO. 283 7 33

ST. JAMES NEWTOWN Rd.
CO. 119 7 13

3
3 9
CO

PT
7 09
50°
PC
7 00

POSSUM HOLLOW RD.
CO 61 6 96

NON FA
RURAL MINOR COLLECTOR

20'I
2 ML

SHA 51.3 - 8 Revised
4.83

MARYLAND STATE HIGHWAY ADMINISTRATION

ROAD INVENTORY SHEET

Party Chief _____
Recorder _____
Assistant _____
Map No./Dir. 1
State Coordinates _____

Road No. MD 297A
Road Name _____
County KENT
Date _____
Sheet No. _____ OF _____

SYSTEM				TRAFFIC		LINE DIAGRAM	TRAFFIC			PAVEMENT DATA
FED. AID.	FUNCT CLASS.	HWY. SYS.	HPMS SAMPLE	PRKG. REST.	COM/IND. ACCESS		CONTROL	COM/IND. ACCESS	PRKG. REST.	
						UNASSIGNED NOW G 394 TRANSFER LETTER 6-1-93				

TRAFFIC CODES

TRAFFIC CONTROLS: STOP SIGN=SS, TRAFFIC LIGHT=T.L., FLASHING RED BALL=F.R.

TRAFFIC CODES

PARKING RESTRICTIONS: A.M. PEAK, P.M. PEAK, A.M./P.M. PEAK, NO PARKING ANYTIME=N.P., COMM/IND. ACCESS=E

SYSTEM				TRAFFIC		LINE DIAGRAM	TRAFFIC			PAVEMENT DATA
FED. AID.	FUNCT. CLASS.	HWY. SYS.	HPMS SAMPLE	PRKG. REST.	COM/IND ACCESS		CONTROL	COM/IND ACCESS	PRKG. REST.	

SHA 51.3 - 8 Revised
4.83

MARYLAND STATE HIGHWAY ADMINISTRATION

'95 STATE REINVENTORY TRANSFER LETTER 12-1-87
6-6-95 TM/BB
89-6
11/30/89
BB/BB

ROAD INVENTORY SHEET

Party Chief: C G
Recorder: L W
Assistant: ——
Map No./Dir.: D14, D15 / N
State Coordinates:

Road No.: MD 298
Road Name: (FAIRLEE SR.) POND RD.
County: KENT
Date: 6 - 12 - 89
Sheet No.: 1 OF 11

SR.00
4-25-00
GD/EF

TRAFFIC CODES
TRAFFIC CONTROLS: STOP SIGN=SS, TRAFFIC LIGHT=T.L., FLASHING RED BALL=F.R.

TRAFFIC CODES
PARKING RESTRICTIONS: A.M. PEAK, P.M. PEAK, A.M./P.M. PEAK, NO PARKING ANYTIME=N.P., COMM/IND. ACCESS=E

SYSTEM				TRAFFIC		LINE DIAGRAM	TRAFFIC			PAVEMENT DATA
FED. AID.	FUNCT CLASS.	HWY. SYS.	HPMS SAMPLE	PRK.G. REST.	COM/IND. ACCESS		CONTROL	COM/IND. ACCESS	PRK.G. REST.	
					E	0 50				
						V.F.W. HALL 0 49				
					E	0 47				
						0 43 SPUR 0.11 MI OLD FAIRLEE RD. 310 CO				
						0 40				
						0 37 S.L. 25 MPH				
						0 29 36" CMP D-1'				
										24'I
										2-6'ISHD
										~~2 ML~~
										~~32'I~~
										~~5'ISHDRT~~
										~~2 ML~~
K	K	FAS 1286 RURAL MAJOR COLLECTOR				45° 0 02 ROCK HALL MD MD 298.8	SS			
						0 00 RD 20				

LINE DIAGRAM

SYSTEM: FED. AID. | FUNCT. CLASS. | HWY. SYS. | HPMS SAMPLE
TRAFFIC: PRKG. REST. | COM/IND ACCESS
TRAFFIC: CONTROL | COM/IND ACCESS | PRKG. REST.
PAVEMENT DATA

FAS 1286
RURAL MAJOR COLLECTOR

1.17 48" CP D-2'

0.99 2-48" CP D-2'

0.83 S.L. 30MPH

0.78 RALEIGH CO. RD 272

BAYSHORE CO. SPUR 82

0.69 BAYSHORE CO. RD 116

0.64 PARSONS RD ~~BAY SHORE RD~~ CO. 208

0.55 36" CMP D-3'

0.52 JONES CO. CUT-OFF RD. 202

24'I
2-6'ISHD
2 ML

SHA 51.3 - 8 Revised
4.83

MARYLAND STATE HIGHWAY ADMINISTRATION

ROAD INVENTORY SHEET

Party Chief: C G
Recorder: L. W
Assistant:
Map No./Dir.: /
State Coordinates:

Road No.: MD 298
Road Name: (FAIRLEE <RD) PINCRO
County: KENT
Date: 6 - 12 - 89
Sheet No.: 3 OF 11

TRAFFIC CODES
TRAFFIC CONTROLS: STOP SIGN=SS, TRAFFIC LIGHT=T.L., FLASHING RED BALL=F.R.

TRAFFIC CODES
PARKING RESTRICTIONS: A.M. PEAK, P.M. PEAK, A.M./P.M. PEAK, NO PARKING ANYTIME=N.P., COMM/IND. ACCESS=E

SYSTEM				TRAFFIC		LINE DIAGRAM	TRAFFIC			PAVEMENT DATA
FED. AID.	FUNCT. CLASS.	HWY. SYS.	HPMS SAMPLE	PRKG. REST.	COM/IND. ACCESS		CONTROL	COM/IND. ACCESS	PRKG. REST.	
	RURAL MAJOR COLLECTOR					2 40 48" CP				
						CROW RD 73				
						2 OT ANNIE CO				
						1 35 CEM S.L. 50MPH				
						Mt. Pleasant Rd.				
						1 33 PVT.				
						PT 1 27				22'I
						FISH CO. HATCHERY RD 72 25			X	2-5'ISHD
						35°				2 ML
						1 24 Church		E		
						PC 1 21				24'I
										2-6' ISHD
										2 ML

FAS 1286

SYSTEM: FED. AID. | FUNCT. CLASS. | HWY. SYS. | HPMS SAMPLE

TRAFFIC: PRKG. REST. | COM/IND ACCESS

LINE DIAGRAM

TRAFFIC: CONTROL | COM/IND ACCESS | PRKG. REST.

PAVEMENT DATA

FAS 1286
RURAL MAJOR COLLECTOR

BUCK NECK RD.
CO. 63 — 4 04

L RD.
CO. 121 — 3 92

3 69
12' I
3 67 (XX)
RTL
ACC. 9' I

22' I
2-6' ISHDS
2 ML

HANDY POINT RD.
CO 65 — 3 66 — (PORTERS GROVE MELITOTA RD.) MD 514

3 57 SIGN MELITOTA

PT
3 19

40°
3 09 36" CMP Δ-3' Squash

PRC
3 00 EARL NICHOLSON RD. CO 74
PRC
30°
PC
2 99

22' I
2-5' I SHD
2 ML

SHA 51.3 - 8 Revised
4.83

MARYLAND STATE HIGHWAY ADMINISTRATION

ROAD INVENTORY SHEET

Lambs meadow RD

96-3ST
GD/KS
1-28-97

Party Chief: C G
Recorder: L W
Assistant: —
Map No./Dir.: 1
State Coordinates:

Road No.: MD 298
Road Name: (Fairlee RD)
County: KENT
Date: 6-12-89
Sheet No.: 5 OF 11

SYSTEM: FED. AID. | FUNCT. CLASS. | HWY. SYS. | HPMS SAMPLE
TRAFFIC: PRKG. REST. | COM/IND. ACCESS

LINE DIAGRAM

5 38 CBC L=16'-W-25'-D-6'

5 ~~08~~

PT

5 08

NEWTOWN
ST. JAMES ~~NEWTOWN~~ RD
CO. 119 5 05

400

PC

4 90

~~BARNES GROVE~~ HANESVILLE RD
CO. 64

4 30 PVT CEM

4 17 36" CMP D-2'

KENT CT.
CO. 159 4 09

Lambs meadow RD

Fairlee RD

FAS 1286
RURAL MAJOR COLLECTOR

TRAFFIC: CONTROL | COM/IND. ACCESS | PRKG. REST.

PAVEMENT DATA

22'I
2-~~8~~ 6' I SHD
2 ML

TRAFFIC CODES
TRAFFIC CONTROLS: STOP SIGN=SS,
TRAFFIC LIGHT=T.L.,
FLASHING RED BALL=F.R.

TRAFFIC CODES
PARKING RESTRICTIONS: A.M. PEAK, P.M. PEAK, A.M./P.M. PEAK, NO PARKING ANYTIME=N.P., COMM/IND. ACCESS=E

LINE DIAGRAM

SYSTEM: FED. AID. | FUNCT. CLASS. | HWY. SYS. | HPMS SAMPLE
TRAFFIC: PRKG. REST. | COM/IND ACCESS
TRAFFIC: CONTROL | COM/IND ACCESS | PRKG. REST.
PAVEMENT DATA

FAS 1286
RURAL MAJOR COLLECTOR

Brindley Dr.
7 24 CO 376
OAK LANE
7 28 PT
CO 343
7 21
WALKER RD.
CO. 323
7 17 30°
7 15 PC

POTTS Rd
(SIGN OP 452)
OP 57
7 07
PLUM DR.
7 03 CO 398
6 99
6 91 E
HILLCREST Rd
6 83 CO 341

BOTTOM Rd
6 80 CO 432

CEM 6 63
6 61 SIGN: Buttertown
E CHURCH 6 60
6 55 S.L. 30MPH

PT 6 26
30°
PC 6 18

22'I
2-6 ISHD
2 ML

SHA 51.3 - 8 Revised
4.83

MARYLAND STATE HIGHWAY ADMINISTRATION

ROAD INVENTORY SHEET

Party Chief: C G
Recorder: L. W
Assistant:
Map No./Dir.: /
State Coordinates:

Road No.: MD. 298
Road Name: (Lambs meadow Rd)
County: KENT
Date: 6-12-89
Sheet No.: 7 OF 11

SYSTEM				TRAFFIC		LINE DIAGRAM	TRAFFIC			PAVEMENT DATA
FED. AID.	FUNCT. CLASS.	HWY. SYS.	HPMS SAMPLE	PRKG. REST.	COM/IND. ACCESS		CONTROL	COM/IND. ACCESS	PRKG. REST.	
						coopers CO. ∠A. 57 8 15				
					E	Church & CEM 7 80				
						7 60 S.L. 50 MPH (A)				
						7 50 KENT CO. HIGH School				
						7 48		2E		
						Smithville RD (Worton RD)				
						MD CO 393 7 39 MD 297				
					E	OLD WORTON RD MD ~~297~~ A CO 394 7 32				
						7 29		E		22 I
						7 28 PT 300				2-8 ISHD
										2 ML

FAS 12886
RURAL MAJOR COLLECTOR

TRAFFIC CODES

TRAFFIC CONTROLS: STOP SIGN=SS, TRAFFIC LIGHT=T.L., FLASHING RED BALL=F.R.

TRAFFIC CODES

PARKING RESTRICTIONS: A.M. PEAK, P.M. PEAK, A.M./P.M. PEAK, NO PARKING ANYTIME=N.P., COMM/IND. ACCESS=E

SYSTEM: FED. AID. | FUNCT. CLASS. | HWY. SYS. | HPMS SAMPLE

TRAFFIC: PRKG. REST. | COM/IND ACCESS

LINE DIAGRAM

TRAFFIC: CONTROL | COM/IND ACCESS | PRKG. REST.

PAVEMENT DATA

FAS 1286
RURAL MAJOR COLLECTOR

11 68 36 ~~48~~" CMP SQUASH

STILL ~~MD~~ POND

MD 292

10 99

N

S 39 5 ~~29~~

DADS DESIRE LANE

OP (22) (42) 10 80

PT

10 66

30°

PC

10 56

10 42 48" CMP D-3'

CLARK CO RD 53

9 70

9 56

PT

9 53

~~PT~~

MD 856

9 45

40°

9 43 MD 561 PC

PAVEMENT DATA:

21'I

2-7'ISHD

2 ML

X

22'I

2~~6~~8'ISHD

2 ML

SHA 51.3 - 8 Revised
4.83

MARYLAND STATE HIGHWAY ADMINISTRATION

ROAD INVENTORY SHEET

Party Chief: C G
Recorder: L. W.
Assistant:
Map No./Dir.: /
State Coordinates:

Road No.: MD 298
Road Name: (Lambs Meadow RD)
County: KENT
Date: 6-12-89
Sheet No.: 9 OF 11

SYSTEM: FED. AID. | FUNCT. CLASS. | HWY. SYS. | HPMS SAMPLE
TRAFFIC: PRKG. REST. | COM/IND. ACCESS

FAS 1286
RURAL MAJOR COLLECTOR

LINE DIAGRAM

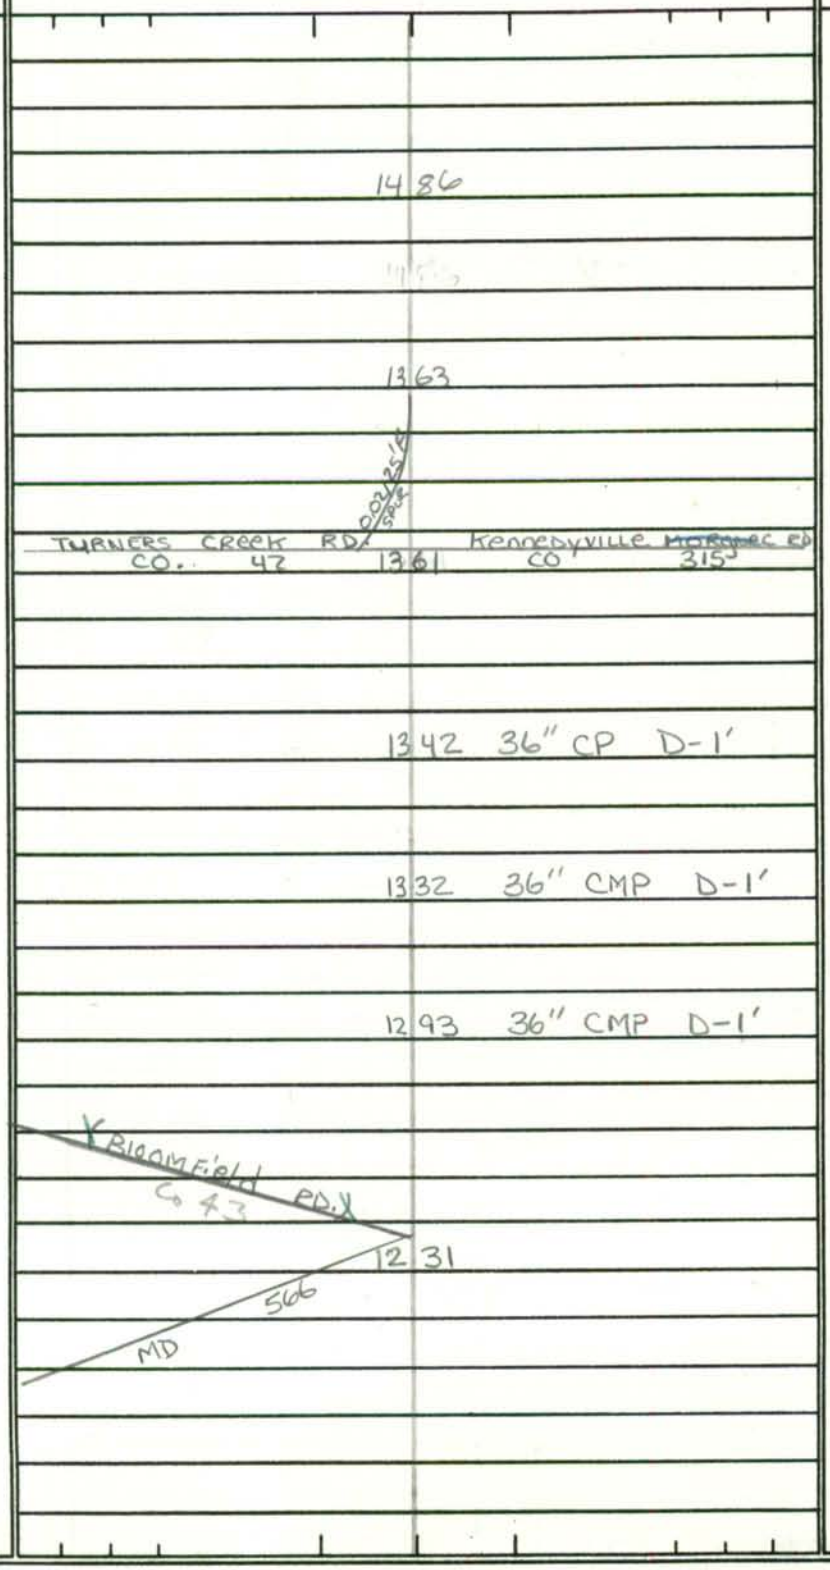

TRAFFIC: CONTROL | COM/IND. ACCESS | PRKG. REST.
E

PAVEMENT DATA
21' I
2-7' ISHD
2 ML

TRAFFIC CODES
TRAFFIC CONTROLS: STOP SIGN=SS, TRAFFIC LIGHT=T.L., FLASHING RED BALL=F.R.

TRAFFIC CODES
PARKING RESTRICTIONS: A.M. PEAK, P.M. PEAK, A.M./P.M. PEAK, NO PARKING ANYTIME=N.P., COMM/IND. ACCESS=E

LINE DIAGRAM

SYSTEM: FED. AID. | FUNCT. CLASS. | HWY. SYS. | HPMS SAMPLE

TRAFFIC: PRKG. REST. | COM/IND ACCESS

TRAFFIC: CONTROL | COM/IND ACCESS | PRKG. REST.

PAVEMENT DATA

NON FA
RURAL MINOR COLLECTOR

FAS 1286
2-MAJOR COLLECTOR

1672 36" CP D-2'

Sign R.R XING 1603 06

RXR | ROADWAY 1599 03 2-48" CP

MD / DEL. 1590'

MDDE 526437N

1578 | RXR | ROADWAY

1577 Sign RR XING

1566 36" CP D-2'

2-2' FSHD
20' I
2 ML

Parking

BROWNTOWN RD

1500

1492

24' I
~~20' I~~
8' ESHDRT
~~8'~~ SHD LT
2 ML

AUGUSTINE MD

1491

SS

HERMAN 213 RD

LANDS MEADOW RD

21' I
2-7' I SHD
2 ML

SHA 51.3 - 8 Revised
4.83

MARYLAND STATE HIGHWAY ADMINISTRATION

ROAD INVENTORY SHEET

CHERRY LA AND MORGNEC RD

Party Chief: C G
Recorder: L W
Assistant: —
Map No./Dir.: 1
State Coordinates:

Road No.: MD 298
Road Name: (BROWNTOWN RD)
County: KENT
Date: 6-12-89
Sheet No.: 11 OF 11

TRAFFIC CODES
TRAFFIC CONTROLS: STOP SIGN=SS, TRAFFIC LIGHT=T.L., FLASHING RED BALL=F.R.

TRAFFIC CODES
PARKING RESTRICTIONS: A.M. PEAK, P.M. PEAK, A.M./P.M. PEAK, NO PARKING ANYTIME=N.P., COMM/IND. ACCESS=E

SYSTEM				TRAFFIC		LINE DIAGRAM	TRAFFIC			PAVEMENT DATA
FED. AID.	FUNCT CLASS.	HWY. SYS.	HPMS SAMPLE	PRKG. REST.	COM/IND. ACCESS		CONTROL	COM/IND. ACCESS	PRKG. REST.	
1	7									
						MD 20 14 291	SS			~~21' I~~
										~~2 ML~~
						CHERRY LA. 20 05				
						(MORGNEC RD) CO 307				~~20' G~~ SHD
						90° OLD MORGNEC RD. 18 95				~~2 ML~~
										~~20' J~~ SHD
						(MORGNEC RD.) 18 58 CO 18 90°	SS			~~2 ML~~
						BROWNTOWN RD 18 21 36" CP D-1'				
						PT 17 15				
						STATION 17 14 36" C.P.				
						30° BLACKS 32 BROWNTOWN CO				
						PC 17 08				20' F I
										2 ML
										22' F SHD

NON FA RURAL MINOR COLLECTOR

SYSTEM				TRAFFIC		LINE DIAGRAM	TRAFFIC			PAVEMENT DATA
FED. AID.	FUNCT. CLASS.	HWY. SYS.	HPMS SAMPLE	PRKG. REST.	COM/IND ACCESS		CONTROL	COM/IND ACCESS	PRKG. REST.	

95 STATE REINVENTORY
6-2-95 TM/BB

SHA 51.3 - 8 Revised
4.83

MARYLAND STATE HIGHWAY ADMINISTRATION

ROAD INVENTORY SHEET

SR.00
4-25-00
GD/EF

Party Chief: C G
Recorder: L W
Assistant:
Map No./Dir.: /
State Coordinates:

Road No.: MD 298 - B
Road Name: SRUR
County: KENT
Date: 6 - 12 - 89
Sheet No.: 1 OF 1

TRAFFIC CODES
TRAFFIC CONTROLS: STOP SIGN=SS, TRAFFIC LIGHT=T.L., FLASHING RED BALL=F.R.

TRAFFIC CODES
PARKING RESTRICTIONS: A.M. PEAK, P.M. PEAK, A.M./P.M. PEAK, NO PARKING ANYTIME=N.P., COMM/IND. ACCESS=E

SYSTEM				TRAFFIC		LINE DIAGRAM	TRAFFIC			PAVEMENT DATA
FED. AID.	FUNCT. CLASS.	HWY. SYS.	HPMS SAMPLE	PRKG. REST.	COM/IND. ACCESS		CONTROL	COM/IND. ACCESS	PRKG. REST.	
	NON FA					0078 POINT GORE	YLD			16' I
	RURAL LOCAL					ROCK HALL MD				2-6' ISHD
						0002 36" CMP D-2' ONEWAY Squash				1 ML
						MD				
						0000				
						2798				

SYSTEM				TRAFFIC			LINE DIAGRAM	TRAFFIC			PAVEMENT DATA
FED. AID.	FUNCT. CLASS.	HWY. SYS.	HPMS SAMPLE	PRKG. REST.	COM/IND ACCESS			CONTROL	COM/IND ACCESS	PRKG. REST.	

SHA 51.3 - 8 Revised
4.83

MARYLAND STATE HIGHWAY ADMINISTRATION

ROAD INVENTORY SHEET

SR.00
4-26-06
GD/EF

Party Chief: CG
Recorder: LW
Assistant: —
Map No./Dir.: C13 / N
State Coordinates: 1132 - 550

Road No.: MD 299
Road Name: (Massey RD)
County: KENT
Date: 6-13 - 89
Sheet No.: 1 OF 4

TRAFFIC CODES
TRAFFIC CONTROLS: STOP SIGN=SS, TRAFFIC LIGHT=T.L., FLASHING RED BALL=F.R.

TRAFFIC CODES
PARKING RESTRICTIONS: A.M. PEAK, P.M. PEAK, A.M./P.M. PEAK, NO PARKING ANYTIME=N.P., COMM/IND. ACCESS=E

SYSTEM				TRAFFIC		LINE DIAGRAM	TRAFFIC			PAVEMENT DATA
FED. AID.	FUNCT. CLASS.	HWY. SYS.	HPMS SAMPLE	PRK.G. REST.	COM/IND. ACCESS		CONTROL	COM/IND. ACCESS	PRK.G. REST.	
	NON FA RURAL MINOR COLLECTOR			PARKING	E	016		E		
						010 S.L 40 MPH				
						RR ROADWAY 009				
					E	008 S.H.G (ABAN)				
						007		E		
						MD. DEL. R.R.				
						2-TRACKS 004 RXR Sign #MDDE 526 428P				
										22'I SHD
										2 ML
				PARKING	E	003			PARKING	X
						001 RXR ROADWAY				
										23'I SHD
										9'E SHORT
Y	Y			Y		(MASSEY GALENA RD) MD 313 — 000 — MASSEY DEL. LINE RD. MD 330			Y	ZML
						(MASSEY RD) 313				
						(MILLINGTON MD				

SYSTEM: FED. AID. | FUNCT. CLASS. | HWY. SYS. | HPMS SAMPLE
TRAFFIC: PRKG. REST. | COM/IND ACCESS

LINE DIAGRAM

TRAFFIC: CONTROL | COM/IND ACCESS | PRKG. REST.

PAVEMENT DATA

NON FA
RURAL MINOR COLLECTOR

JACOBS 2 94 CREEK
#14018

ALEXANDER CO 224 RD

2 33 ~~Hurlocks Con.~~ GOLTS RD CO 5
(92+14 comp)

2 17 PT
30°
2 03 PC

QUINN RD CO. 20 1 57

1 17 PT
30°
1 09 PC

0 39 50 MPH
0 27 ELECT. SUB STATION E

SIGN RXR ~~Roadway~~ 0 17

22'I SHLD
2 ML

SHA 51.3 - 8 Revised
4.83

MARYLAND STATE HIGHWAY ADMINISTRATION

ROAD INVENTORY SHEET

Party Chief: C G
Recorder: L W
Assistant:
Map No./Dir.: /
State Coordinates:

Road No.: MD 299
Road Name: (MASSEY RD / GALENA SASSAFRAS RD)
County: KENT
Date: 6 - 13 - 89
Sheet No.: 3 OF 4

SYSTEM: FED. AID. | FUNCT. CLASS. | HWY. SYS. | HPMS SAMPLE
TRAFFIC: PRK.G. REST. | COM/IND. ACCESS

TRAFFIC CODES
TRAFFIC CONTROLS: STOP SIGN=SS, TRAFFIC LIGHT=T.L., FLASHING RED BALL=F.R.

TRAFFIC CODES
PARKING RESTRICTIONS: A.M. PEAK, P.M. PEAK, A.M./P.M. PEAK, NO PARKING ANYTIME=N.P., COMM/IND. ACCESS=E

NON FA RURAL MINOR COLLECTOR

LINE DIAGRAM

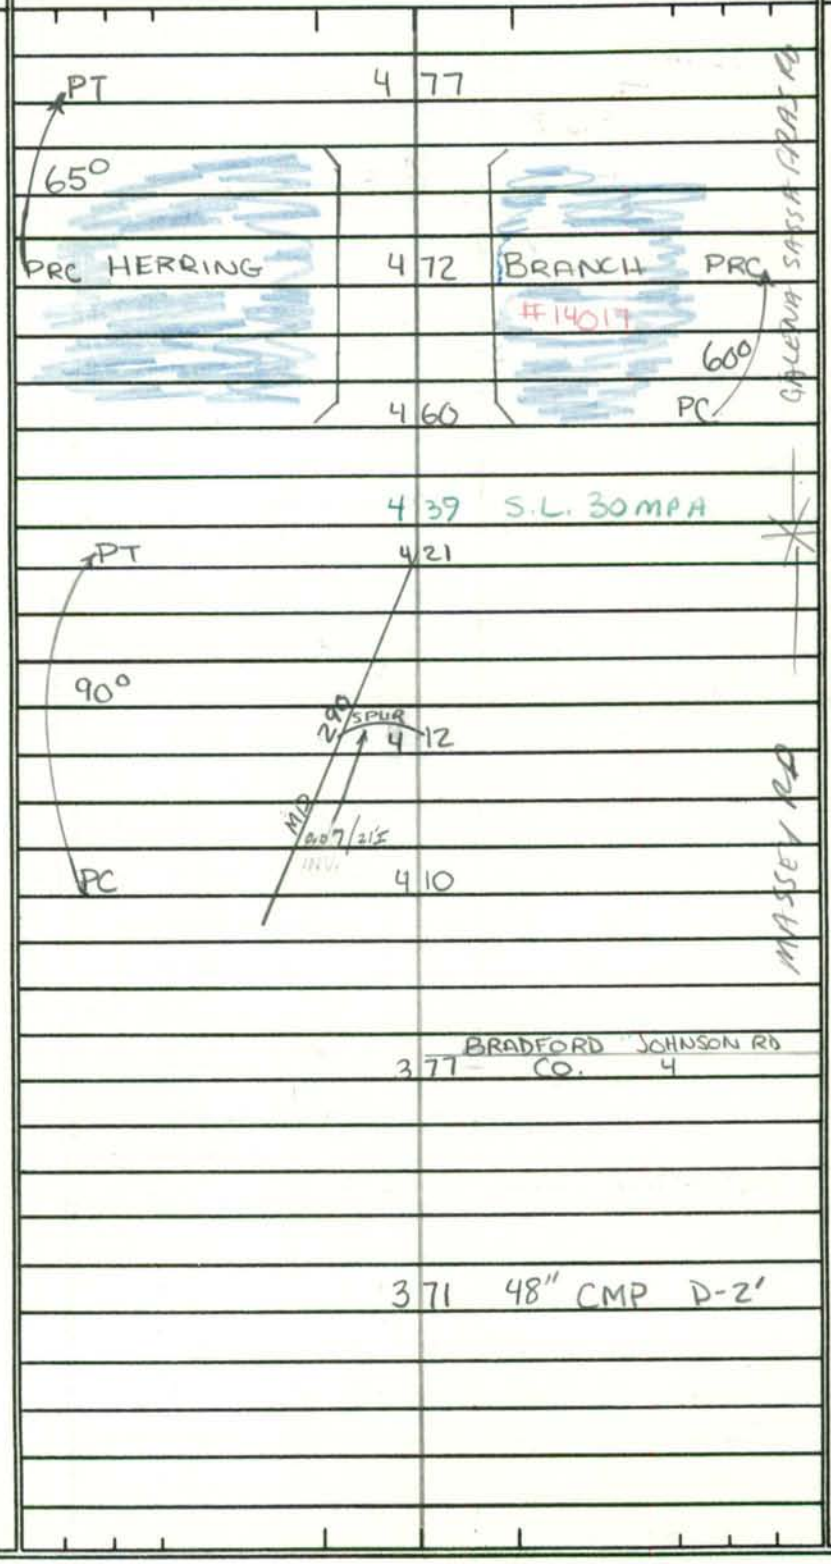

TRAFFIC: CONTROL | COM/IND. ACCESS | PRK.G. REST.

PAVEMENT DATA
22' I
2 ML

SYSTEM				TRAFFIC		LINE DIAGRAM	TRAFFIC			PAVEMENT DATA
FED. AID.	FUNCT. CLASS.	HWY. SYS.	HPMS SAMPLE	PRKG. REST.	COM/IND ACCESS		CONTROL	COM/IND ACCESS	PRKG. REST.	
	RURAL MINOR COLLECTOR		NON FA							22' I 2 ML

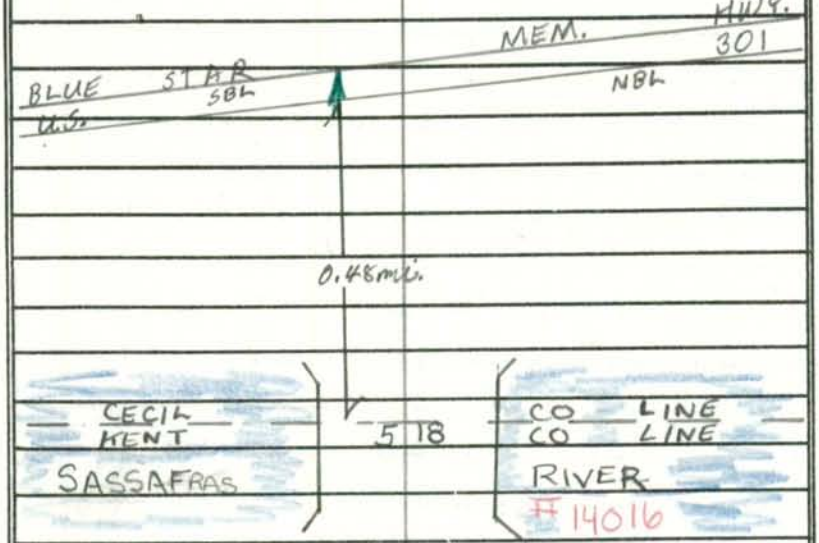

CECIL — CO LINE
KENT — CO LINE
SASSAFRAS — RIVER
5 18
#14016

4 90 CEM

4 86 Church PT

4 85 SASSAFRAS CG
70°
CALDWELL RD

4 81 PC

SHA 51.3 - 8 Revised
4.83

SR.00
4-27-00
GD/EF

MARYLAND STATE HIGHWAY ADMINISTRATION

ROAD INVENTORY SHEET

Party Chief CG
Recorder AD
Assistant
Map No./Dir. D-15 / N
State Coordinates 1121-522

Road No. US 301
Road Name (BLUE STAR MEMORIAL HWY)
County KENT
Date 3/1/00
Sheet No. 1 OF 7

TRAFFIC CODES
TRAFFIC CONTROLS: STOP SIGN-SS, TRAFFIC LIGHT=T.L., FLASHING RED BALL=F.R.

TRAFFIC CODES
PARKING RESTRICTIONS: A.M. PEAK, P.M. PEAK, A.M./P.M. PEAK, NO PARKING ANYTIME=N.P., COMM/IND. ACCESS=E

SYSTEM				TRAFFIC		LINE DIAGRAM	TRAFFIC			PAVEMENT DATA
	FUNCT CLASS	HWY. SYS	HPMS SAMPLE	PREG. REST.	COM/IND ACCESS		CONTROL	COM/IND ACCESS	PREG. REST.	
NHS	RURAL OTHER PRINCIPAL ARTERIAL	STATE PRIMARY				RAMP 8 0 36 RAMP 6 0 30 SL 55 MPH RAMP 2 0 29 0 28 RAMP 4 0 22 EXIT # 112 MD #14030 291 0 19 12' I 12' I 0 14 0 07 0 02 #17014 KENT CO LINE QUEEN ANNE 0 00 CO LINE CHESTER RIVER				2-24' I 10' I SHD OUT LT 12' I SHD OUT RT 4' I SHD IN LT 2' I SHD IN RT 60' ORS MED 4 ML

COUNTY KENT ROAD NO. hS 301 PAGE 2 OF 7

SYSTEM				TRAFFIC		TRAFFIC				
FUNCT CLASS	HWY SYS	NHS	STATE PRIMARY	PKG. REST	OW/INE ACCESS	LOW/HIGH	COM/IND ACCESS	PKG. REST.	LINE DIAGRAM	PAVEMENT DATA
NHS	RURAL OTHER PRINCIPAL ARTERIAL		103010000017							

1 70 PT

30°

1 48 MM 113

1 43 PC

0 95 2-24'I

0 94 10'I SHD OUT LT

4'I SHD IN LT

12'I SHD OUT RT

2'I SHD IN RT

60' GRS PKG

4 ML

(CHESTERVILLE BRIDGE RD)
CO 226

4' 10'

4' 10'

(MILLINGTON RD)
0 89 CO 380 Fy.

0 84

0 83

PT

0 76 CBC H 6' D 4' L 8' W 18'

30°

0 57

0 49 MM 112

0 46

0 45 PC

SHA 51.3 - 8 Revised
4.83

MARYLAND STATE HIGHWAY ADMINISTRATION

ROAD INVENTORY SHEET

Party Chief C. G
Recorder L. W
Assistant
Map No./Dir. /
State Coordinates

Road No. US 301
Road Name
County KENT
Date 6-15-89
Sheet No. 3 OF 7

SYSTEM: FED. AID. | FUNCT. CLASS. | HWY. SYS. | HPMS SAMPLE
TRAFFIC: PRKG. REST. | COM/IND. ACCESS

LINE DIAGRAM

NHS
RURAL OTHER PRINCIPAL ARTERIAL
STATE PRIMARY
10301000001700

MD. DEL. R.R
3 62 V.C. 17'-9" FR OH
MDDE526431X

3 53 RXR Roadway

3 48 MP. 115 (RXR)

3 09 3-48" CP 3'D

2 81 40" CP

2 47 MP- 114

2 40 ← 100' → RD.

L.9'-W-62'-D-5' H-6' CBC

2 22 CLARK 17

2 21 RT. SIDE ONLY CBC

2 20 CBC

CARROLL

TRAFFIC: CONTROL | COM/IND. ACCESS | PRKG. REST.

PAVEMENT DATA

2-24' I
2-10' I SHD OUT
2-4' I SHD IN
60' GRS MED
4 ML

X

2-24' I
2-10' I SHD OUT LT
2-4' I SHD IN LT
60' GRS PKWY
4 ML
12' I SHD OUT RT
2' I SHD IN RT

TRAFFIC CODES

TRAFFIC CONTROLS: STOP SIGN=SS, TRAFFIC LIGHT=T.L., FLASHING RED BALL=F.R.

TRAFFIC CODES

PARKING RESTRICTIONS: A.M. PEAK, P.M. PEAK, A.M./P.M. PEAK, NO PARKING ANYTIME=N.P., COMM/IND. ACCESS=E

LINE DIAGRAM

SYSTEM				TRAFFIC		TRAFFIC			PAVEMENT DATA
FED. AID.	FUNCT. CLASS.	HWY. SYS.	HPMS SAMPLE	PRKG. REST.	COM/IND ACCESS	CONTROL	COM/IND ACCESS	PRKG. REST.	
	RURAL OTHER PRINCIPAL ARTERIAL STATE PRIMARY		10301000000418 K			FY		X	

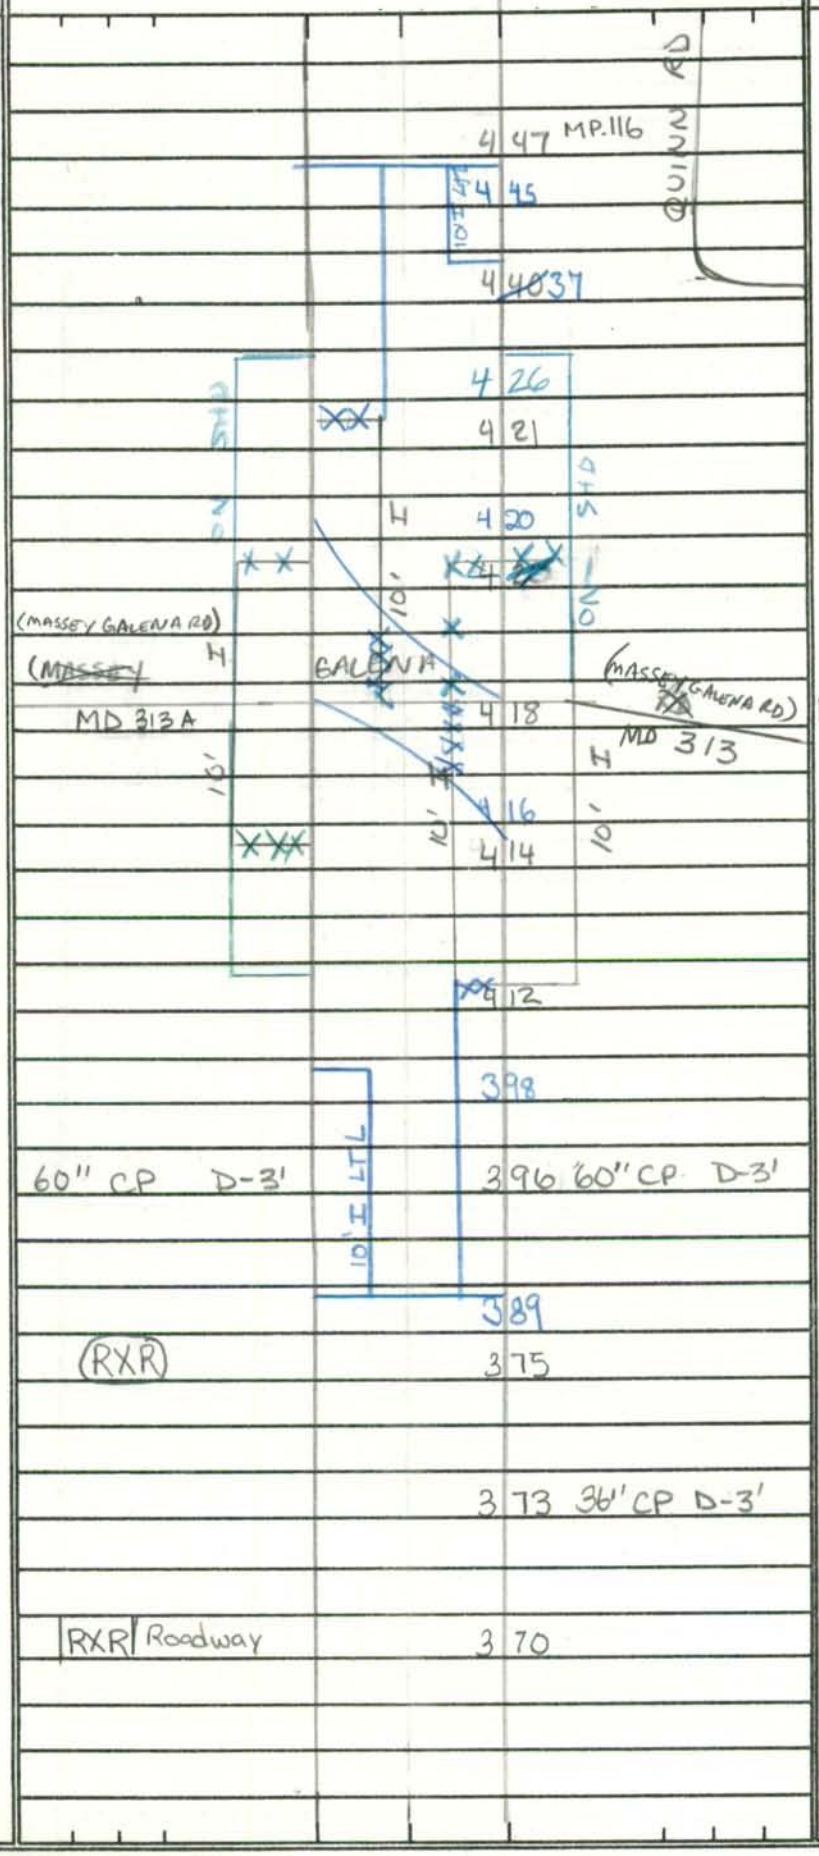

2-25'I
2-4'I OUT
2-4'I IN
60'gr MED
4 ML
2-24'I
2-10'I OUT
2-4'I IN
60'GRS MED
4 ML

SHA 51.3 - 8 Revised 4.83

MARYLAND STATE HIGHWAY ADMINISTRATION

ROAD INVENTORY SHEET

94-15
BB/AH
11-9-94

Party Chief CG
Recorder LW
Assistant —
Map No./Dir. /
State Coordinates

Road No. US 301
Road Name
County Kent
Date 6-15-89
Sheet No. 5 OF 7

TRAFFIC CODES
TRAFFIC CONTROLS: STOP SIGN=SS, TRAFFIC LIGHT=T.L., FLASHING RED BALL=F.R.

TRAFFIC CODES
PARKING RESTRICTIONS: A.M. PEAK, P.M. PEAK, A.M./P.M. PEAK, NO PARKING ANYTIME=N.P., COMM/IND. ACCESS=E

SYSTEM				TRAFFIC		LINE DIAGRAM	TRAFFIC			PAVEMENT DATA
FED. AID.	FUNCT. CLASS.	HWY. SYS.	HPMS SAMPLE	PRKG. REST.	COM/IND. ACCESS		CONTROL	COM/IND. ACCESS	PRKG. REST.	
	RURAL OTHER PRINCIPAL ARTERIAL					6 45 MP 118				
						Weigh Station 6 42				
						5 86 L-10' W-166' H-6' CBC D-4'				
						5 60 L-12' H-8' W-180' CBC D-10'				
		STATE PRIMARY				5 46 MP. 117				
						5 15 36" CP				
						5 08 100' →				2-24' I
										2-12' I OUT
										2-4' I IN
										60' SEG PKWY MED
										4 ML
						5 04 ED 20 QUINN CO				*
										~~2-25' I~~
										~~2-11' OUT~~
										~~2-4' I IN~~
										~~60' SEG PKWY MED~~
										~~4 ML~~

N.H.S.
10301000418

LINE DIAGRAM

SYSTEM				TRAFFIC		TRAFFIC			PAVEMENT DATA
FED. AID.	FUNCT. CLASS.	HWY. SYS.	HPMS SAMPLE	PRKG. REST.	COM/IND ACCESS	CONTROL	COM/IND ACCESS	PRKG. REST.	
	RURAL OTHER PRINCIPAL ARTERIAL	STATE PRIMARY	103010000780 X						
FAHS 103010000418 ②									

806

804

RAMP #8

RAMP #2

781

14005

RD

SASSAFRAS MD

290

780

RAMP #6

778

RAMP #4

776

12' I

754

757

744 MM 119

741 L-8' W-170' H-4' CBC D-4'

687 L-10' W-160' H-6' CBC D-4'

2-24' I

2-12' I OUT

2-4' I IN

60' GR~~S~~ MED

4 ML

SHA 51.3 - 8 Revised
4.83

MARYLAND STATE HIGHWAY ADMINISTRATION

ROAD INVENTORY SHEET

Party Chief C G
Recorder L W
Assistant —
Map No./Dir. /
State Coordinates

Road No. US 301
Road Name
County Kent
Date 6-15-89
Sheet No. 7 OF 7

SYSTEM: FED. AID. | FUNCT CLASS. | HWY. SYS. | HPMS SAMPLE
TRAFFIC: PKG. REST. | COM/IND. ACCESS

LINE DIAGRAM

CECIL CO. 327
CO. MD 299
0.64
880
CECIL Kent
CO LINE
CO LINE
SASSAFRAS
879
RIVER
#14004
878
~~877~~
861 60" CP D-1'
PT
853
30°
847 MP 120
PC
811

TRAFFIC: CONTROL | COM/IND. ACCESS | PKG. REST.

PAVEMENT DATA
2-24' I
2-12' I OUT
2-4' I IN
60' gis

TRAFFIC CODES
TRAFFIC CONTROLS: STOP SIGN=SS, TRAFFIC LIGHT=T.L., FLASHING RED BALL=F.R.

TRAFFIC CODES
PARKING RESTRICTIONS: A.M. PEAK, P.M. PEAK, A.M./P.M. PEAK, NO PARKING ANYTIME=N, P.. COMM/IND. ACCESS=E

NHS
RURAL OTHER PRINCIPAL ARTERIAL
STATE PRIMARY
1030/0000790

SYSTEM				TRAFFIC		LINE DIAGRAM	TRAFFIC			PAVEMENT DATA
FED. AID.	FUNCT. CLASS.	HWY. SYS.	HPMS SAMPLE	PRKG. REST.	COM/IND ACCESS		CONTROL	COM/IND ACCESS	PRKG. REST.	

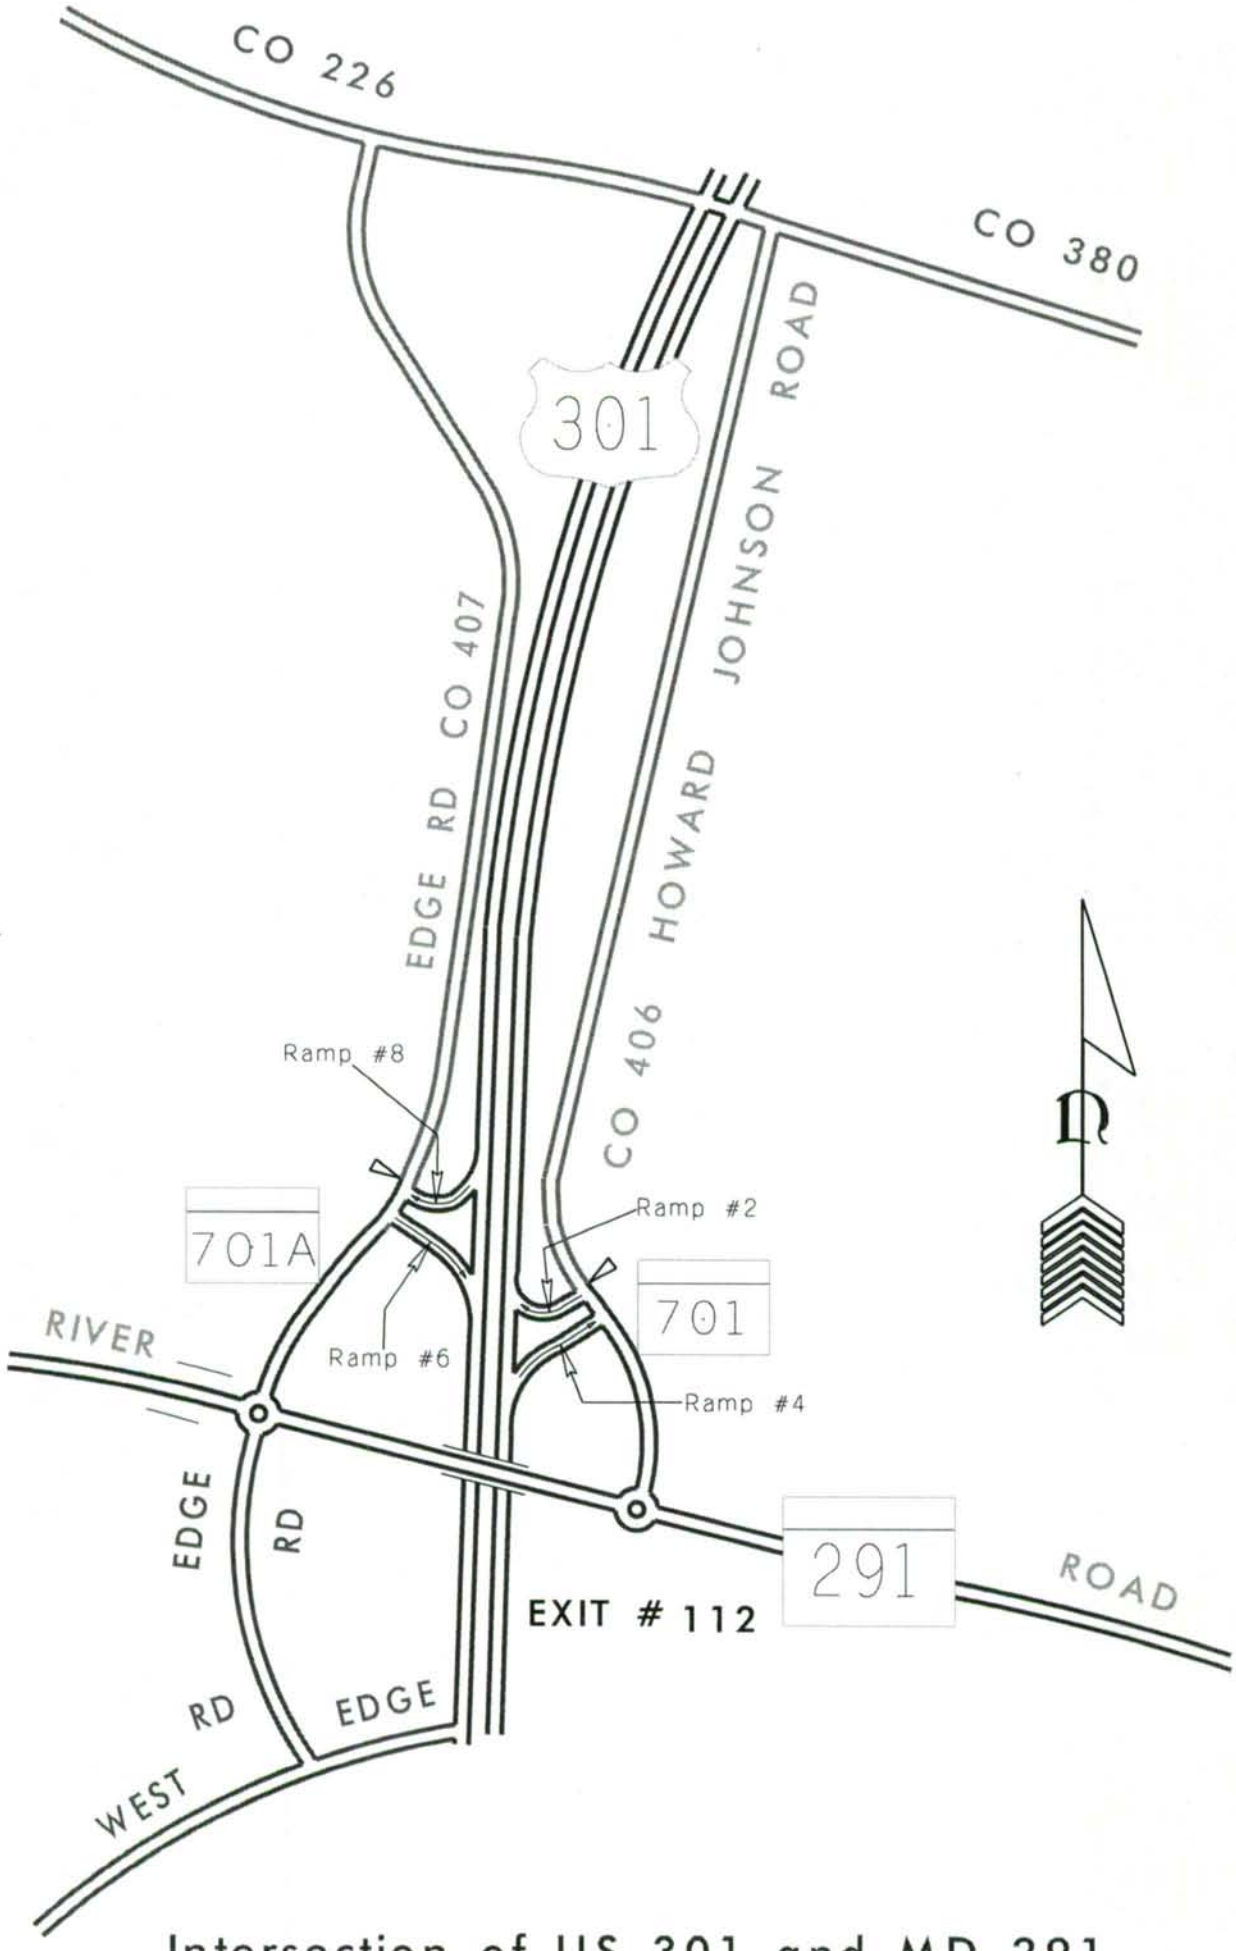

Intersection of US 301 and MD 291

99-1ST-EXS

SHA 51.3 - 8 Revised 4.83

MARYLAND STATE HIGHWAY ADMINISTRATION

ROAD INVENTORY SHEET

SR.00
4-27-00
GD/EF

Party Chief: CG
Recorder: HD
Assistant:
Map No./Dir.: I
State Coordinates:

Road No.: RAMP 2
Road Name: MD 701 to US 301 NB
County: KENT
Date: 3/1/00
Sheet No.: 1 OF 1

SYSTEM				TRAFFIC		LINE DIAGRAM	TRAFFIC			PAVEMENT DATA
	FUNCT CLASS	HWY. SYS.	HPMS SAMPLE	PREG. REST.	COM/IND. ACCESS		CONTROL	COM/IND. ACCESS	PREG. REST.	

TRAFFIC CODES

TRAFFIC CONTROLS: STOP SIGN-SS, TRAFFIC LIGHT=T.L., FLASHING RED BALL=F.R.

TRAFFIC CODES

PARKING RESTRICTIONS: A.M. PEAK, P.M. PEAK, A.M./P.M. PEAK, NO PARKING ANYTIME=N.P., COMM/IND. ACCESS=E

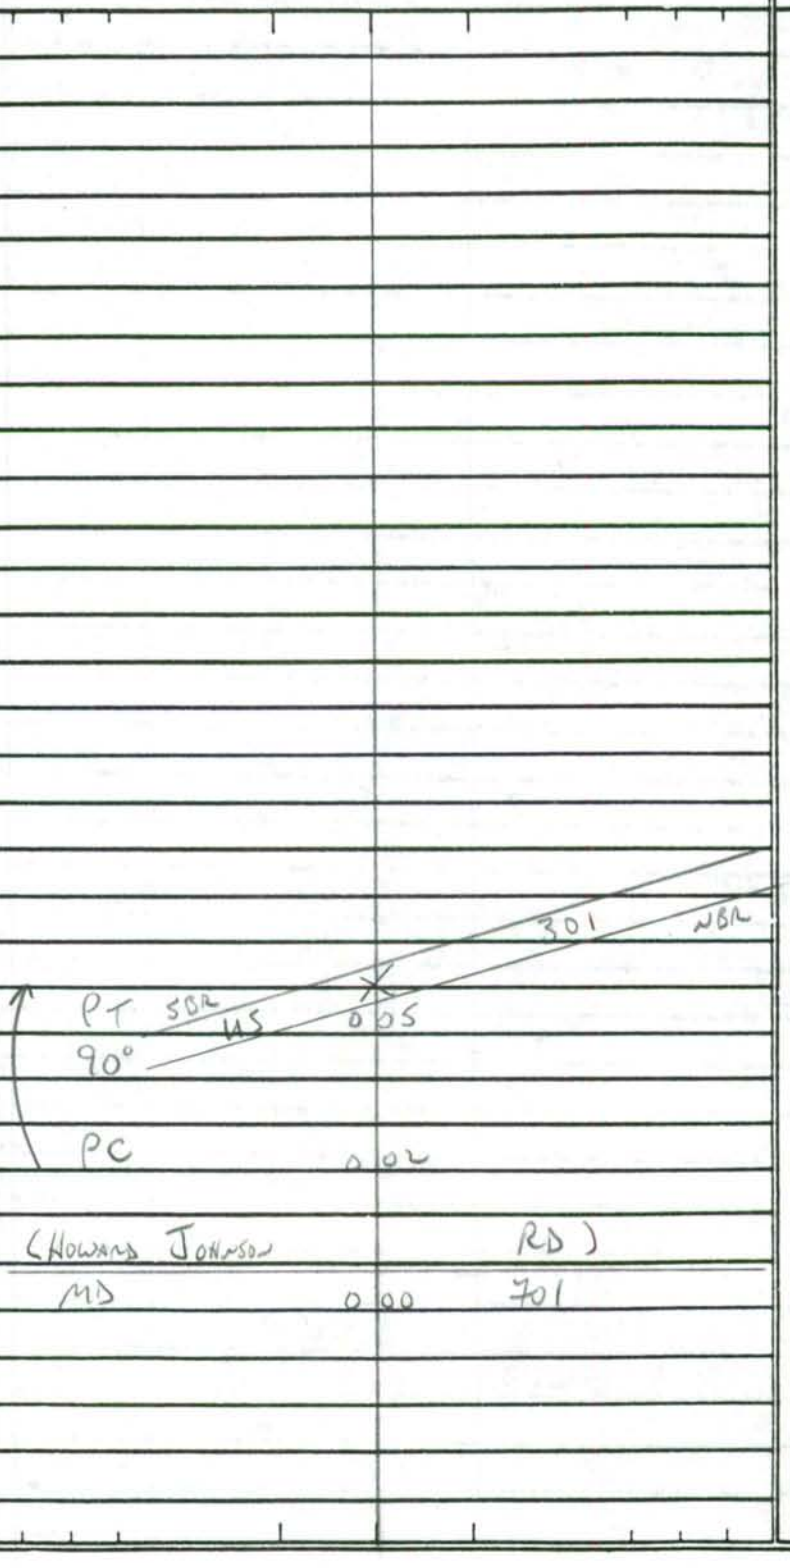

20'I
4'I SHOLDR
J CRB RT
1ML

COUNTY _____ ROAD NO. _____ PAGE ___ OF ___

SYSTEM				TRAFFIC		LINE DIAGRAM	TRAFFIC				PAVEMENT DATA
FUNCT. CLASS	HWY SYS	HPMS SAMPLE		PREG. REST.	COM/IND ACCESS		CONTROL	COM/IND ACCESS	PREG. REST.		

99-1ST-EX4

SHA 51.3 - 8 Revised 4.83

MARYLAND STATE HIGHWAY ADMINISTRATION

ROAD INVENTORY SHEET

SR00
4-27-00
GD/EF

Party Chief CG
Recorder AD
Assistant
Map No./Dir. 1
State Coordinates

Road No. RAMP 4
Road Name US 301 NB TO MD 701
County KENT
Date 3/1/00
Sheet No. 1 OF 1

TRAFFIC CODES

TRAFFIC CONTROLS: STOP SIGN-SS, TRAFFIC LIGHT=T.L., FLASHING RED BALI=F.R.

TRAFFIC CODES

PARKING RESTRICTIONS: A.M. PEAK, P.M. PEAK, A.M./P.M. PEAK, NO PARKING ANYTIME=N.P., COMM/IND. ACCESS=E

SYSTEM				TRAFFIC		LINE DIAGRAM	TRAFFIC			PAVEMENT DATA
	FUNCT CLASS	HWY. SYS	HPMS SAMPLE	PREG. REST.	COM/IND ACCESS		CONTROL	COM/IND ACCESS	PREG. REST.	
						(HOWARD JOHNSON RD)				
						CO 406 0.08 MD 701	55			
						PT 0.03				16'I
						30°				8'I SNB RT
						JBR				4'I SNB LT
						US				JCRB RT
						PC 0.00				1MC
						301				
						SBR				

COUNTY _____ ROAD NO. _____ PAGE ___ OF _____

SYSTEM				TRAFFIC		LINE DIAGRAM	TRAFFIC				PAVEMENT DATA
FUNCT CLASS	HWY SYS	HPMS SAMPLE		PREG	OM/MNL ACCESS		CHRGN	OM/MNL ACCESS	PREG. REST.		

99-1ST-EX 3

SHA 51.3 - 8 Revised 4.83

MARYLAND STATE HIGHWAY ADMINISTRATION

SR.00 487-00 GD/EF

ROAD INVENTORY SHEET

Party Chief: CG
Recorder: HD
Assistant:
Map No./Dir.: I
State Coordinates:

Road No.: RAMP 6
Road Name: MD701A & TO US 301 SBR
County: KENT
Date: 3/1/00
Sheet No.: 1 OF 1

SYSTEM				TRAFFIC		LINE DIAGRAM	TRAFFIC			PAVEMENT DATA
FUNCT CLASS	HWY SYS	HPMS SAMPLE		PREG. REST.	COM/IND ACCESS		CONTROL	COM/IND ACCESS	PREG. REST.	
						301 SBR PT NBR US 0.07 45° PC 0.04 (EDGE RD) MD 0.00 701 A				20'I 6'I SHD RT JCRB RT 1 MC

TRAFFIC CODES

TRAFFIC CONTROLS: STOP SIGN-SS, TRAFFIC LIGHT=T.L., FLASHING RED BALL=F.R.

TRAFFIC CODES

PARKING RESTRICTIONS: A.M. PEAK, P.M. PEAK, A.M./P.M. PEAK, NO PARKING ANYTIME=N.P., COMM/IND. ACCESS=E

COUNTY _____ ROAD NO. _____ PAGE ___ OF _____

SYSTEM				TRAFFIC		LINE DIAGRAM	TRAFFIC				PAVEMENT DATA
FUNCT CLASS	HWY SYS	NHS	STRAHNET	PREG	REST	COM/IND ACCESS		COM/IND ACCESS	PREG.	REST.	

99-1ST-EX6

SHA 51.3 - 8 Revised 4.83

MARYLAND STATE HIGHWAY ADMINISTRATION

SR00
H07-00
GD/EF

ROAD INVENTORY SHEET

Party Chief: CG
Recorder: HD
Assistant:
Map No./Dir.: 1
State Coordinates:

Road No.: RAMP 8
Road Name: US 301 SB TO MD 301A
County: KENT
Date: 3/1/00
Sheet No.: 1 OF 1

SYSTEM				TRAFFIC		LINE DIAGRAM	TRAFFIC			PAVEMENT DATA
	FUNCT CLASS	HWY. SYS	HPMS SAMPLE	PKG. REST.	COM/IND. ACCESS		CONTROL	COM/IND. ACCESS	PKG. REST.	
						(EDGE RD)				
						MD 301 A 0 07 00 407	SS			
						PT 0 05				
						90°				16'I
						SBR PC 0 01				8'I SHD RT
						US				J CRB RT
						0 X 00				1ML
						301				
						NBR				

TRAFFIC CODES

TRAFFIC CONTROLS: STOP SIGN-SS, TRAFFIC LIGHT=T.L., FLASHING RED BALL=F.R.

TRAFFIC CODES

PARKING RESTRICTIONS: A.M. PEAK, P.M. PEAK, A.M./P.M. PEAK, NO PARKING ANYTIME=N.P., COMM/IND. ACCESS=E

COUNTY _____ ROAD NO. _____ PAGE ___ OF ___

SYSTEM				TRAFFIC				LINE DIAGRAM	TRAFFIC				PAVEMENT DATA
FUNCT. CLASS	HWY SYS	NPMS SAMPLE		PREG. REST.	COM/IND ACCESS				CONFIG.	COM/IND ACCESS	PREG. REST.		

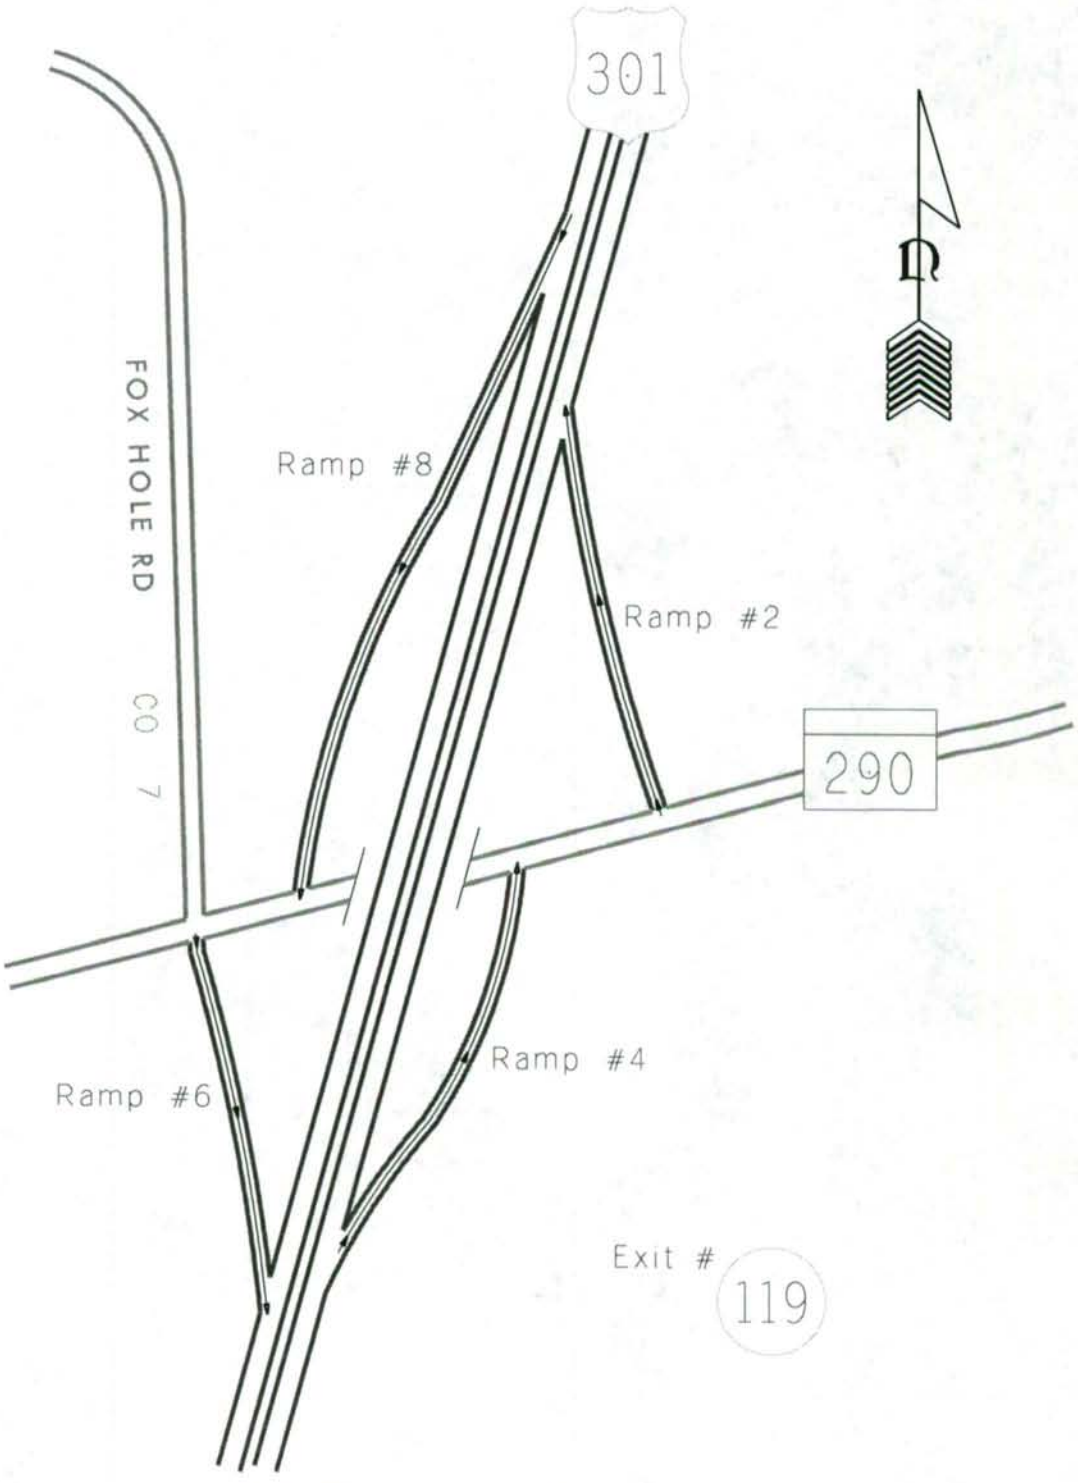

Interchange 119 of US 301 at MD 290

...\kent_us301md290_exit119.dgn Feb. 15, 2001 10:51:00

NP1301002080 4
'95 STATE REINV
6-8-95 TM/BB

SHA 51.3 - 8 Revised 4.83

MARYLAND STATE HIGHWAY ADMINISTRATION

ROAD INVENTORY SHEET

SR.00
4-27-00
GD/EF

Party Chief: C G
Recorder: L W
Assistant:
Map No./Dir.: 1 N
State Coordinates:

Road No.: Ramp # 2 F/L
Road Name: MD 290 TO US. 301 NBL
County: Kent
Date: 6-15-89
Sheet No.: 1 OF 1

SYSTEM				TRAFFIC		LINE DIAGRAM	TRAFFIC			PAVEMENT DATA
FED. AID.	FUNCT. CLASS.	HWY. SYS.	HPMS SAMPLE	PRKG. REST.	COM/IND. ACCESS		CONTROL	COM/IND. ACCESS	PRKG. REST.	
						NBL 301 PT SBL 0 23 US 40° PC 0 19 PC 0 10 04 MD 0 00 290	YL			15' I 10' I SHD RT 1 ML X 15' I 10' I SHD RT 5' I SHD LT 1 ML Y

TRAFFIC CODES

TRAFFIC CONTROLS: STOP SIGN=SS, TRAFFIC LIGHT=T.L., FLASHING RED BALL=F.R.

TRAFFIC CODES

PARKING RESTRICTIONS: A.M. PEAK, P.M. PEAK, A.M./P.M. PEAK, NO PARKING ANYTIME=N.P., COMM/IND. ACCESS=E

SYSTEM				TRAFFIC		LINE DIAGRAM	TRAFFIC			PAVEMENT DATA
FED. AID.	FUNCT. CLASS.	HWY. SYS.	HPMS SAMPLE	PRKG. REST.	COM/IND ACCESS		CONTROL	COM/IND ACCESS	PRKG. REST.	

RP13010040756
'95 STATEREINV
6-8-95 TM/BB

SHA 51.3 - 8 Revised 4.83

MARYLAND STATE HIGHWAY ADMINISTRATION

ROAD INVENTORY SHEET

SR00
4-27-00
GD/EF

Party Chief C.G
Recorder L.W
Assistant —
Map No./Dir. 1 N
State Coordinates

Road No. Ramp # 4 FN
Road Name US.301 TO MD 290 ~~NBL~~ SBL
County Kent
Date 6-15-89
Sheet No. 1 OF 1

TRAFFIC CODES
TRAFFIC CONTROLS: STOP SIGN=SS, TRAFFIC LIGHT=T.L., FLASHING RED BALL=F.R.

TRAFFIC CODES
PARKING RESTRICTIONS: A.M. PEAK, P.M. PEAK, A.M./P.M. PEAK, NO PARKING ANYTIME=N.P., COMM/IND. ACCESS=E

SYSTEM				TRAFFIC		LINE DIAGRAM	TRAFFIC			PAVEMENT DATA
FED. AID.	FUNCT. CLASS.	HWY. SYS.	HPMS SAMPLE	PRKG. REST.	COM/IND. ACCESS		CONTROL	COM/IND. ACCESS	PRKG. REST.	
						MD 025 290	SS			
						023 PT 30° PC				16'I
						016				10'I SHD RT
										4'I SHD LT
										1 ML
						005				
										16'I
						NBL BLUE STAR U.S. 000 MEM HWY 301 SBL				10'I SHD RT
										1 ML
						6 FARM				

SYSTEM				TRAFFIC		LINE DIAGRAM	TRAFFIC			PAVEMENT DATA
FED. AID.	FUNCT. CLASS.	HWY. SYS.	HPMS SAMPLE	PRKG. REST.	COM/IND ACCESS		CONTROL	COM/IND ACCESS	PRKG. REST.	

RP|30100607 56
95 STATE REINV.
6-8-95 TM/BB

SHA 51.3 - 8 Revised
4.83

MARYLAND STATE HIGHWAY ADMINISTRATION

ROAD INVENTORY SHEET

SR.00
427-00
GD/EF

Party Chief C G
Recorder L.W
Assistant
Map No./Dir. 1 S
State Coordinates

Road No. RAMP #6 FR
Road Name MD 290 TO US 301 SBL
County Kent
Date 6-15-89
Sheet No. 1 OF 1

SYSTEM: FED. AID. | FUNCT CLASS. | HWY. SYS. | HPMS SAMPLE
TRAFFIC: PRKG. REST. | COM/IND. ACCESS

LINE DIAGRAM

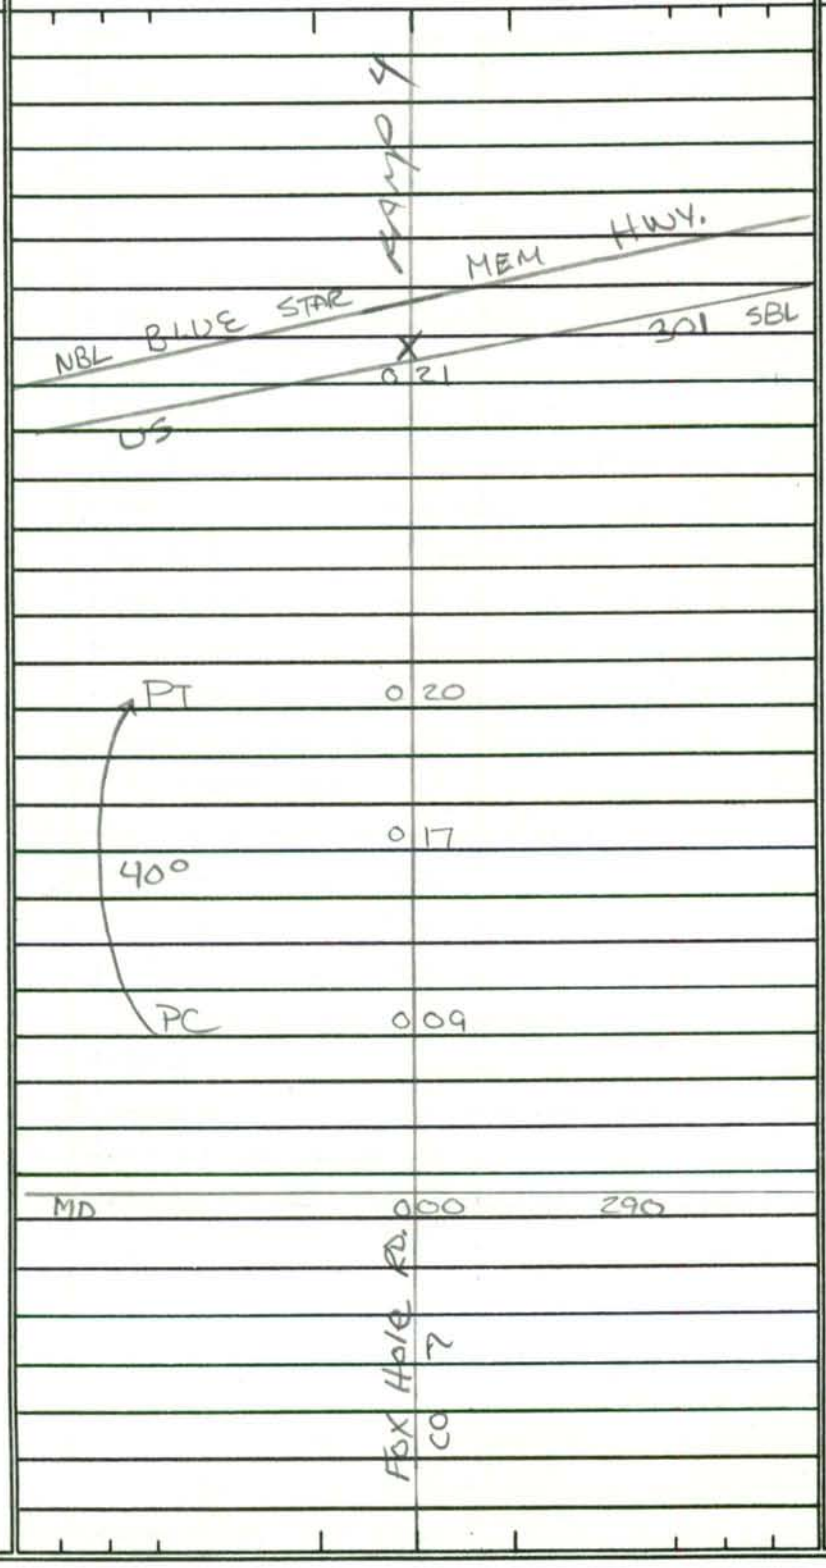

TRAFFIC: CONTROL | COM/IND. ACCESS | PRKG. REST.

CONTROL: YL

PAVEMENT DATA

16' I
10' I SHD RT
1 ML
16' I
10' I SHD RT
4' I SHLDR
1 ML

TRAFFIC CODES

TRAFFIC CONTROLS: STOP SIGN=S.S., TRAFFIC LIGHT=T.L., FLASHING RED BALL=F.R.

TRAFFIC CODES

PARKING RESTRICTIONS: A.M. PEAK, P.M. PEAK, A.M./P.M. PEAK, NO PARKING ANYTIME=N.P., COMM/IND. ACCESS=E

SYSTEM				TRAFFIC		LINE DIAGRAM	TRAFFIC			PAVEMENT DATA
FED. AID.	FUNCT. CLASS.	HWY. SYS.	HPMS SAMPLE	PRKG. REST.	COM/IND ACCESS		CONTROL	COM/IND ACCESS	PRKG. REST.	

RP13010080806
'95 STATE REINV.
6-8-95 TM/BB

SHA 51.3 - 8 Revised
4.83

MARYLAND STATE HIGHWAY ADMINISTRATION

ROAD INVENTORY SHEET

SR00
4-27-00
GD/EF

Party Chief CG
Recorder L.W
Assistant —
Map No./Dir. 19
State Coordinates

Road No. Ramp # 8 FR
Road Name US 301 ~~SBL~~ TO MD 290
County KENT
Date 6-15-89
Sheet No. 1 OF 1

TRAFFIC CODES
TRAFFIC CONTROLS: STOP SIGN=SS, TRAFFIC LIGHT=T.L., FLASHING RED BALL=F.R.

TRAFFIC CODES
PARKING RESTRICTIONS: A.M. PEAK, P.M. PEAK, A.M./P.M. PEAK, NO PARKING ANYTIME=N.P., COMM/IND. ACCESS=E

SYSTEM				TRAFFIC		LINE DIAGRAM	TRAFFIC			PAVEMENT DATA
FED. AID.	FUNCT CLASS.	HWY. SYS.	HPMS SAMPLE	PRKG. REST.	COM/IND. ACCESS		CONTROL	COM/IND. ACCESS	PRKG. REST.	
						MD. 031 290	SS			
						028 PT 30° PC				
						018				20' I
										10' I SHD RT
										4' I SHD LT
										1 ML
						005				
										24' I TAPER
										20' I
										10' I RT
										1 ML
						SBL BLUE STOP US. 000 MEM HWY 301 NBL				

SYSTEM				TRAFFIC		LINE DIAGRAM	TRAFFIC			PAVEMENT DATA
FED. AID.	FUNCT. CLASS.	HWY. SYS.	HPMS SAMPLE	PRKG. REST.	COM/IND ACCESS		CONTROL	COM/IND ACCESS	PRKG. REST.	

'95 STATE REINVENTORY
6-7-95 TM/EB

SHA 51.3 - 8 Revised
4.83

MARYLAND STATE HIGHWAY ADMINISTRATION

MILLINGTON

ROAD INVENTORY SHEET

SR.00
4-26-00
GD/EF

Party Chief: C G
Recorder: L.W.
Assistant: —
Map No./Dir.: / N
State Coordinates:

Road No.: MD 313
Road Name: SASSAFRAS ST
County: KENT
Date: 6-14-89
Sheet No.: 1 OF 5

TRAFFIC CODES
TRAFFIC CONTROLS: STOP SIGN=SS, TRAFFIC LIGHT=T.L., FLASHING RED BALL=F.R.

TRAFFIC CODES
PARKING RESTRICTIONS: A.M. PEAK, P.M. PEAK, A.M./P.M. PEAK, NO PARKING ANYTIME=N.P., COMM/IND. ACCESS=E

SYSTEM				TRAFFIC		LINE DIAGRAM	TRAFFIC			PAVEMENT DATA
FED. AID.	FUNCT. CLASS.	HWY. SYS.	HPMS SAMPLE	PRK.G. REST.	COM/IND. ACCESS		CONTROL	COM/IND. ACCESS	PRK.G. REST.	
	RURAL MAJOR COLLECTOR	STATE SECONDARY	FAS 1283	NPG	4' J-S	0.20		E		
						0.19			NPG	37'I
										J-C-C
										2 ML
				PKG		CYPRESS MD — 0.17 — ST. 291	TL			
						0.12		E 4' JS		
				NPG	4' J-S	HAZEL MU — LA. 0025 — 0.11				32'I
										J-C-C
										2 ML
						0.07				
						0.05				24'I
						0.03 S/L 25MPH				I 6'/SHD RT
						0.02 BR. 17030				I 5'/SHD LT
						Chester RIVER				2 ML
						KENT CO LINE — QUEEN ANNES CO. LINE — 0.00				
						0.02 BEG BRIDGE				
						3.13 MD 313				

FAS 1283
RURAL MAJOR COLLECTOR
STATE SECONDARY

SYSTEM				TRAFFIC		LINE DIAGRAM	TRAFFIC			PAVEMENT DATA
FED. AID.	FUNCT. CLASS.	HWY. SYS.	HPMS SAMPLE	PRKG. REST.	COM/IND ACCESS		CONTROL	COM/IND ACCESS	PRKG. REST.	
					E	(RT)				
						NASSEY				
						0 46				
					E	INGTON				
						0 44 Millington Ele. School				
						MILL		E		22' I
						0 41				3 5' SHD RT
						380				2 ML
						0 39 LMTS MILLINGTON				
						ST				27' I
										J-C-C
						SASSAFRAS				2' I SHDLT
						0 33 36" CMP D-3'				2 ML
				NPG					NPG	
						MILLINGTON V.F.W. 0 29				
						Hurtt MU. L.A. AVE .0030 0 28		4' JS		
					E	0 25				
				4' JS		0 24 Back MU. ST. 0005				
						CHURCH 0 23				37' I
										J-G-C
										2 ML

SHA 51.3 - 8 Revised
4.83

MARYLAND STATE HIGHWAY ADMINISTRATION

99-25T
CG HD
3/1/00

ROAD INVENTORY SHEET

Party Chief: C G
Recorder: L.W
Assistant: —
Map No./Dir.: 1
State Coordinates:

Road No.: MD 313
Road Name: (MILLINGTON MASSEY RD.)
County: Kent
Date: 6-14-89
Sheet No.: 3 OF X 5

TRAFFIC CODES
TRAFFIC CONTROLS: STOP SIGN=SS, TRAFFIC LIGHT=T.L., FLASHING RED BALL=F.R.

TRAFFIC CODES
PARKING RESTRICTIONS: A.M. PEAK, P.M. PEAK, A.M./P.M. PEAK, NO PARKING ANYTIME=N.P., COMM/IND. ACCESS=E

SYSTEM				TRAFFIC		LINE DIAGRAM	TRAFFIC			PAVEMENT DATA
FED. AID.	FUNCT CLASS.	HWY. SYS.	HPMS SAMPLE	PRKG. REST.	COM/IND. ACCESS		CONTROL	COM/IND. ACCESS	PRKG. REST.	
	RURAL MAJOR COLLECTOR	STATE SECONDARY	FAS 1283			PT 3 45 PC 3 29 (PT 350, PC)				
						Carroll Co. Clark RD. 17 2 90				
						WALNUT TREE CO. RD. #10 School 25 — 2 47				
						SPEER CO RD 136 — 1 23				
						1 11		E		
						1 08 CP. L-11'-W-25' D-51'				
						0 55 S.L 50 MPH				22'I
						0 53 (A)		E		2ML
						0 48		E	X	
										22'I
										5'GSHD RT
										2 ML

LINE DIAGRAM

SYSTEM: FED. AID. | FUNCT. CLASS. | HWY. SYS. | HPMS SAMPLE: 20313000046Z

TRAFFIC: PRKG. REST. | COM/IND ACCESS

TRAFFIC: CONTROL | COM/IND ACCESS | PRKG. REST.

PAVEMENT DATA

FAS 1283
RURAL MAJOR COLLECTOR
STATE SECONDARY

SIGN (RXR) 4 73

RXR | Roadway 4 68

PT MD DEL. 4 64
4 62 MDDES26430R
R.R

PT

40° 4 58 4 | RXR | Roadway

~~PT~~ ~~4 51~~

~~40°~~ 4 ~~55~~ 48 SIGN RXR XING

PC 4 44 22'I

4 16 S.L. 50 MPH 299 2 ML

4 00 S.L. 40 MPH

MD 180° 90°

3 88 SS

MD MASSEY DEL LINE 330

3 86 (RXR) 22'I

2.5'I SHD

2 ML

(MILLINGTON MASSEY RD.) (MASSEY GALENA RD.)

4' DI

3 83 MASSEY P.O.

3 81

CHURCH 3 76 22'I

3 63 SIGN. Massey 2 ML

3 61 S.L. 25 MPH

SHA 51.3 - 8 Revised
4.83

00-2 ST

MARYLAND STATE HIGHWAY ADMINISTRATION

ROAD INVENTORY SHEET

Party Chief: C G
Recorder: L.W
Assistant:
Map No./Dir.: /
State Coordinates:

Road No.: MD 313
Road Name: (MASSEY GALENA RD.)
County: Kent
Date: 6-14-89
Sheet No.: 5 OF X5

TRAFFIC CODES
TRAFFIC CONTROLS: STOP SIGN=SS, TRAFFIC LIGHT=T.L., FLASHING RED BALL=F.R.

TRAFFIC CODES
PARKING RESTRICTIONS: A.M. PEAK, P.M. PEAK, A.M./P.M. PEAK, NO PARKING ANYTIME=N.P., COMM/IND. ACCESS=E

SYSTEM				TRAFFIC		LINE DIAGRAM	TRAFFIC			PAVEMENT DATA
FED. AID.	FUNCT. CLASS.	HWY. SYS.	HPMS SAMPLE	PRKG. REST.	COM/IND. ACCESS		CONTROL	COM/IND. ACCESS	PRKG. REST.	
FAP 291	RURAL MINOR ARTERIAL	STATE PRIMARY (TRAVELWAY)	20130000462			MD 313 A LA. 14 5 83 SCOTTS CO. 5 62 2-48" CMP D-2' squash US SBL BLUE STAR 5 83 MEM HWY 301 NBL 5 30 ENT. PICNIC Area 5 26 ENT. PICNIC Area PT 5 25 QUINN CO. RD 103 30° 5 21 PC 5 02 QUINN CO RD 20	SS FR	E E		24'I 2-10' I SHD 2 ML 22'I 8'I SHD RT 10' I SHD LT. 2 ML 22'I 2 ML
FAS 1283	RURAL MAJOR COLLECTOR	STATE SECONDARY								

92-67
3-4-93
BB/JS

6 of 7

LINE DIAGRAM

SYSTEM: FED. AID. | FUNCT. CLASS. | HWY. SYS. | HPMS SAMPLE

TRAFFIC: PRKG. REST. | COM/IND ACCESS

TRAFFIC: CONTROL | COM/IND ACCESS | PRKG. REST.

PAVEMENT DATA

FAP 291
RURAL MINOR ARTERIAL
STATE PRIMARY (TRAVELWAY)
K 20313000671

JIM

IRELAND CORNER RD CO. 313 @ 1.05

7 42 DAVIS RD. CO. 13

7 40 S.C. 40 MPH

7 20 36" CP D-6'

Decel ON SHD

7

~~7 20 36" CP D-6'~~

7 17

Spur 02/NHI 4'ISHORT

7 16

RD

7 14 OnSHD

Chesterville MD.

290

7 13 Bypass

Spur .01/14'I 12'ISHORT

7 12

7 00 36" CP D-6'

PT

6 94

IRELAND CORNER RD 313 @ 0.8

700

6 71

PC

6 67

6 18

PT

6 08 36" CMP SQUASH 35°

6 03

PC

24'I
240' SHD
2 ML

SHA 51.3 - 8 Revised
4.83

MARYLAND STATE HIGHWAY ADMINISTRATION

ROAD INVENTORY SHEET

Party Chief: Office Inventory
Recorder: WS 2-20-01
Assistant:
Map No./Dir.: D16/15 / N
State Coordinates: C15 1128 573

Road No.: MD 313 A
Road Name: (MASSEY GALENA) RD
County: KENT
Date: 2-20-01
Sheet No.: 1 OF 3

TRAFFIC CODES
TRAFFIC CONTROLS: STOP SIGN=SS, TRAFFIC LIGHT=T.L., FLASHING RED BALL=F.R.

TRAFFIC CODES
PARKING RESTRICTIONS: A.M. PEAK, P.M. PEAK, A.M./P.M. PEAK, NO PARKING ANYTIME=N.P., COMM/IND. ACCESS=E

SYSTEM				TRAFFIC		LINE DIAGRAM	TRAFFIC			PAVEMENT DATA
FED. AID.	FUNCT. CLASS.	HWY. SYS.	HPMS SAMPLE	PRKG. REST.	COM/IND. ACCESS		CONTROL	COM/IND. ACCESS	PRKG. REST.	
	RURAL MINOR ARTERIAL	STATE PRIMARY (Travelway)				0 85 PT 35° 0 75 36" CMP Squash 0 70 PC SCOTTS LA 14 0 50 CO 0 29 2-48" CMP 0.2' Squash BLUE STAR MEMORIAL HWY US 0X00 301	SS FR			24' I 2-10' I Shd 2ML

KENT MD 313A 2 of 3

SYSTEM: FED. AID. | FUNCT. CLASS. | HWY. SYS. | HPMS SAMPLE
TRAFFIC: PRKG. REST. | COM/IND ACCESS

LINE DIAGRAM

TRAFFIC: CONTROL | COM/IND ACCESS | PRKG. REST.
PAVEMENT DATA

RURAL MINOR ARTERIAL
STATE PRIMARY (TRAVELWAY)
20313 0000 0671

2 07 SL = 40 MPH

1 87 36" C.P D-6'

Decel & Shd

1 84

.02/14'I
4'I Shd Rt
SPUR

1 83

CHESTERVILLE RD
MD 290

1 81

Bypass on Shd

1 80

SPUR
.01/14'I
12'I Shd Rt

1 79

1 67 36" CP D-6'

PT 1 61

IRELAND'S CORNER RD
CO 313
(@ 0.00)

70°

1 38

PC 1 34

PAVEMENT DATA:
24'I
2-10' I Shd
2 ML

SHA 51.3 - 8 Revised
4.83

MARYLAND STATE HIGHWAY ADMINISTRATION

ROAD INVENTORY SHEET

S. MAIN ST

Party Chief: Office Inventory
Recorder: WS
Assistant:
Map No./Dir.: D 16 / N
State Coordinates:

Road No.: MD 313 A
Road Name: (MASSEY GALENA RD)
County: KENT
Date: 2-20-01
Sheet No.: 3 OF 3

TRAFFIC CODES
TRAFFIC CONTROLS: STOP SIGN=SS, TRAFFIC LIGHT=T.L., FLASHING RED BALL=F.R.

TRAFFIC CODES
PARKING RESTRICTIONS: A.M. PEAK, P.M. PEAK, A.M./P.M. PEAK, NO PARKING ANYTIME=N.P., COMM/IND. ACCESS=E

SYSTEM				TRAFFIC		LINE DIAGRAM				TRAFFIC			PAVEMENT DATA
FED. AID.	FUNCT CLASS.	HWY. SYS.	HPMS SAMPLE	PRKG. REST.	COM/IND. ACCESS					CONTROL	COM/IND. ACCESS	PRKG. REST.	
	RURAL MINOR ARTERIAL	STATE PRIMARY (TRAVELWAY)		4' JS	E	(W. CROSS ST) MAIN ST MD 213 (E. CROSS ST)				TL	E	4' JS	
						MD 213	2	53	MD 290				
							2	51	SPUR 0.07/21'I				
					E		2	42					
						SCHOOL	2	40					
							2	37	CHURCH & CEM.				40'I
									S MAIN ST				JC-C
													2ML
							2	34	GALENA TWN LIBRARY				
					E	SCHOOL	2	33					
							2	30	SL=25 MPH				
						CORP LIMITS OF GALENA							
							2	26					
									(MASSEY GALENA RD)				24'I
						IRELANDS CORNER RD			JIM DAVIS RD				2-10'I Shd
						CO 313 (@1.05)	2	09	CO 13				2ML

SYSTEM				TRAFFIC		LINE DIAGRAM	TRAFFIC			PAVEMENT DATA
FED. AID.	FUNCT. CLASS.	HWY. SYS.	HPMS SAMPLE	PRKG. REST.	COM/IND ACCESS		CONTROL	COM/IND ACCESS	PRKG. REST.	

SHA 51.3 - 8 Revised
4.83

MARYLAND STATE HIGHWAY ADMINISTRATION

ROAD INVENTORY SHEET

95 STATE REINVENTORY TRANSFER LETTER
6-8-95 TM/BB 12-1-87
00-ST & #1
1-29-01
GD/EF
SR.00
4-26-00
GD/EF

Party Chief C G
Recorder L W
Assistant
Map No./Dir. D16 /
State Coordinates 1132-539

Road No. MD 330
Road Name (MASSEY Delaware Line RD.)
County KENT
Date 6-14-89
Sheet No. 1 OF 3

TRAFFIC CODES
TRAFFIC CONTROLS: STOP SIGN=SS, TRAFFIC LIGHT=T.L., FLASHING RED BALL=F.R.

TRAFFIC CODES
PARKING RESTRICTIONS: A.M. PEAK, P.M. PEAK, A.M./P.M. PEAK, NO PARKING ANYTIME=N.P., COMM/IND. ACCESS=E

SYSTEM				TRAFFIC		LINE DIAGRAM	TRAFFIC			PAVEMENT DATA
FED. AID.	FUNCT. CLASS.	HWY. SYS.	HPMS SAMPLE	PRKG. REST.	COM/IND. ACCESS		CONTROL	COM/IND. ACCESS	PRKG. REST.	
						CEM 0 26				
						CHURCH 0 23 SL. 50 MPH				
						Sign (RXR) XING 0 17				
						RXR | Roadway 0 11				24'I
										2-5'ISHOS
						0 10 SL. 40 MPH				2 ML
						~~MD. DEL 0 06 R.R~~ MDDE 5264241			*	
						~~21'I~~				
						~~2 ML~~				
						0 05 RXR | Roadway			*	
						0 05				
						0 02				
						0 01 SIGN (RXR) XING				21' ~~I~~
										2-6'ESHD
										2 ML
K	K					(MILLINGTON MASSEY RD.)				
						MD 299 0 00 MD 313	SS		Y	
						313				
						MD				
								E		
						NON FA RURAL MINOR COLLECTOR				

SYSTEM				TRAFFIC		LINE DIAGRAM	TRAFFIC			PAVEMENT DATA
FED. AID.	FUNCT. CLASS.	HWY. SYS.	HPMS SAMPLE	PRKG. REST.	COM/IND ACCESS		CONTROL	COM/IND ACCESS	PRKG. REST.	
						1 90 36" CP D-2'				
					E	DNR. WILDLIFE REFUGE 1 69				
						1 43		E		
						1 17 PT				
						80°				
						0 97 PC				
						0 90 96" CMP D-3'				
						PT 0 87				
						45°				
						PC 0 56				
						0 37 PT				
						30°				~~21' F~~
						0 31 PC				~~2 ML~~
										24' I
										2-5' I SHDS
										2 ML

NON FA
RURAL MINOR COLLECTOR

SHA 51.3 - 8 Revised
4.83

MARYLAND STATE HIGHWAY ADMINISTRATION

ROAD INVENTORY SHEET

Party Chief: C G
Recorder: L W
Assistant: —
Map No./Dir.: 1
State Coordinates:

Road No.: MD 330
Road Name: MASSEY DELAWARE LINE RD
County: Kent
Date: 6-14-89
Sheet No.: 3 OF 3

TRAFFIC CODES
TRAFFIC CONTROLS: STOP SIGN=SS, TRAFFIC LIGHT=T, L., FLASHING RED BALL=F.R.

TRAFFIC CODES
PARKING RESTRICTIONS: A.M. PEAK, P.M. PEAK, A.M./P.M. PEAK, NO PARKING ANYTIME=N.P., COMM/IND. ACCESS=E

SYSTEM				TRAFFIC		LINE DIAGRAM	TRAFFIC			PAVEMENT DATA
FED. AID.	FUNCT. CLASS.	HWY. SYS.	HPMS SAMPLE	PRKG. REST.	COM/IND. ACCESS		CONTROL	COM/IND. ACCESS	PRKG. REST.	
	NON FA RURAL MINOR COLLECTOR					MD LINE RD 40 DELAWARE CO. DEL 0.01' CLAYTON DELAWARE RD 478				
						DELAWARE (SIGN/SURVEY POST) MD 3 72 STATE LINE STATE LINE				
						WAECKER RD CO. 24 3 53				
						3 36 2-24" CP				
						(92-18Co) 3 78 BIG STONE ~~NO School~~ RD CO. 26				
						3 00 PT 500 2 75 PC				
						2 59 72" CMP D-2'				
						BLACK BOTTOM RD CO 222 2 43				~~21'F~~ ~~2 MC~~ 24 I 2-5'ISHDS 2 ML

SYSTEM				TRAFFIC		LINE DIAGRAM	TRAFFIC			PAVEMENT DATA
FED. AID.	FUNCT. CLASS.	HWY. SYS.	HPMS SAMPLE	PRKG. REST.	COM/IND ACCESS		CONTROL	COM/IND ACCESS	PRKG. REST.	

SHA 51.3 - 8 Revised
4.83

MARYLAND STATE HIGHWAY ADMINISTRATION

ROAD INVENTORY SHEET

Party Chief _____
Recorder _____
Assistant _____
Map No./Dir. 1
State Coordinates _____

Road No. MD 442
Road Name _____
County Kent
Date _____
Sheet No. _____ OF _____

SYSTEM				TRAFFIC		LINE DIAGRAM	TRAFFIC			PAVEMENT DATA
FED. AID.	FUNCT CLASS.	HWY. SYS.	HPMS SAMPLE	PRKG. REST.	COM/IND. ACCESS		CONTROL	COM/IND. ACCESS	PRKG. REST.	

UNASSIGNED
Now G 314
87-59
TRANSCON LETTER
12-1-87

TRAFFIC CODES

TRAFFIC CONTROLS: STOP SIGN=SS, TRAFFIC LIGHT=T.L., FLASHING RED BALL=F.R.

TRAFFIC CODES

PARKING RESTRICTIONS: A.M. PEAK, P.M. PEAK, A.M./P.M. PEAK, NO PARKING ANYTIME=N.P., COMM/IND. ACCESS=E

SYSTEM				TRAFFIC		LINE DIAGRAM	TRAFFIC				PAVEMENT DATA
FED. AID.	FUNCT. CLASS.	HWY. SYS.	HPMS SAMPLE	PRKG. REST.	COM/IND ACCESS		CONTROL	COM/IND ACCESS	PRKG. REST.		

SHA 51.3 - 8 Revised
4.83

MARYLAND STATE HIGHWAY ADMINISTRATION

ROAD INVENTORY SHEET

Party Chief _____
Recorder _____
Assistant _____
Map No./Dir. 1
State Coordinates _____

Road No. MD 493
Road Name _____
County KENT
Date _____
Sheet No. _____ OF _____

SYSTEM				TRAFFIC		LINE DIAGRAM	TRAFFIC			PAVEMENT DATA
FED. AID.	FUNCT CLASS.	HWY. SYS.	HPMS SAMPLE	PRKG. REST.	COM/IND. ACCESS		CONTROL	COM/IND. ACCESS	PRKG. REST.	
						UNASS/GNEL				
						NOW PART OF				
						CO 52				
						TRANSFER LETTER 12-1-87 8760				

TRAFFIC CODES

TRAFFIC CONTROLS: STOP SIGN=SS, TRAFFIC LIGHT=T.L., FLASHING RED BALL=F.R.

TRAFFIC CODES

PARKING RESTRICTIONS: A.M. PEAK, P.M. PEAK, A.M./P.M. PEAK, NO PARKING ANYTIME=N.P., COMM/IND. ACCESS=E

SYSTEM				TRAFFIC		LINE DIAGRAM	TRAFFIC				PAVEMENT DATA
FED. AID.	FUNCT. CLASS.	HWY. SYS.	HPMS SAMPLE	PRK.G. REST.	COM/IND ACCESS		CONTROL	COM/IND ACCESS	PRK.G. REST.		

SHA 51.3 - 8 Revised
4.83

MARYLAND STATE HIGHWAY ADMINISTRATION

'95 STATE REINVENTORY
Transfer Letter 12/1/87
Transfer TM188 Letter 6-1-93

ROAD INVENTORY SHEET

Kentmore Park RD
Locust Grove RD

SR.00
4-26-00
GD/EF

Party Chief office copy 5/27/93 JB.
Recorder
Assistant
Map No./Dir. 6H 15 / N
State Coordinates 1106 - 528

Road No. MD 444
Road Name
County Kent
Date 6-13-89
Sheet No. 1 OF 5

TRAFFIC CODES
TRAFFIC CONTROLS: STOP SIGN=SS, TRAFFIC LIGHT=T.L., FLASHING RED BALL=F.R.

TRAFFIC CODES
PARKING RESTRICTIONS: A.M. PEAK, P.M. PEAK, A.M./P.M. PEAK, NO PARKING ANYTIME=N.P., COMM/IND. ACCESS=E

SYSTEM				TRAFFIC		LINE DIAGRAM	TRAFFIC			PAVEMENT DATA
FED. AID.	FUNCT CLASS.	HWY. SYS.	HPMS SAMPLE	PRKG. REST.	COM/IND. ACCESS		CONTROL	COM/IND. ACCESS	PRKG. REST.	
						↑30' 1 24 2-48" CP				
						Grove RD				
						0 88 25° ↑				~~18' F~~
										~~2-7'6 SHDS~~
										~~40' CW~~
						Locust 120° 0 39				20' I
										2-2' E SHDS
										2 ML
						MORGNEC RD				
NON	FA					90° CO 307 0 30	SS			
	Local									
	Rural									
						0 28 CBC 1-15' V W-240' D-5'				
										19' F 20' I
						0 12 sign - chesterville				~~2-3' E SHDS~~
										~~2 FT SHDS~~
										~~2 ML~~
										~~40 CW~~
						0 11 SL. 50 MPH				
						(Chesterville RD)				
						MD 000 290	SS			
						9				
						8				
						0				

LINE DIAGRAM

SYSTEM				TRAFFIC		TRAFFIC			PAVEMENT DATA
FED. AID.	FUNCT. CLASS.	HWY. SYS.	HPMS SAMPLE	PRKG. REST.	COM/IND ACCESS	CONTROL	COM/IND ACCESS	PRKG. REST.	
	Rural LOCAL								

LON FA

2 87 DR

(RXR) 2 80

RXR sign Roadway 2 74

2 71 10° ↑

~~9' F~~

~~2-5' HDRS~~

~~2-H'E SHDS~~

— T 2 68 T — SL

~~30' CLW~~

~~NONE~~

~~FOOE 20'F)~~

20'I 2ML

H MODE 526 435 A

2 67 X

Blacks Station RD

CO 32 2 66

2 58 RXR Roadway Marking

~~18' F~~

2 ~~59~~ 49 (RXR) sign

~~2-7'E SHDS~~

~~40' CLW~~

2 40 DR

2 05 20° ↑

20'I

2-2'ESHDS

2ML

SHA 51.3 - 8 Revised
4.83

MARYLAND STATE HIGHWAY ADMINISTRATION

ROAD INVENTORY SHEET

Party Chief _____
Recorder _____
Assistant _____
Map No./Dir. 1
State Coordinates _____

Road No. MD 444
Road Name Kentmore Park RD
County KENT
Date _____
Sheet No. 3 OF 5

TRAFFIC CODES
TRAFFIC CONTROLS: STOP SIGN=SS, TRAFFIC LIGHT=T.L., FLASHING RED BALL=F.R.

TRAFFIC CODES
PARKING RESTRICTIONS: A.M. PEAK, P.M. PEAK, A.M./P.M. PEAK, NO PARKING ANYTIME=N.P., COMM/IND. ACCESS=E

SYSTEM				TRAFFIC		LINE DIAGRAM	TRAFFIC			PAVEMENT DATA
FED. AID.	FUNCT CLASS.	HWY. SYS.	HPMS SAMPLE	PRKG. REST.	COM/IND. ACCESS		CONTROL	COM/IND. ACCESS	PRKG. REST.	
										20'I
										2-8'I SHLD
										2 ML
										X
										20'I
										2 ML
										X
										20'I
										2'-F SHLD RT
										J-CB LT
										2 ML
										X
										~~4 J~~
										~~2-5' WORKS~~
										~~2-4'E SLTRS~~
										~~30' CW~~
										~~2 CM L~~
										~~(code 20 J)~~
										20'I
										2ML

Non FA
Rural minor Collector
X
Rural local

KENTMORE PARK RD
SHALLCROSS RD
CO MD 449
4 29
WHARF RD
27
CO
4 22
444-A
MD
MD
4 20 213
SS
3 23 24" cmp 10°J
VANSANTS corner RD
3 01 CO 31

LINE DIAGRAM

SYSTEM				TRAFFIC		TRAFFIC			PAVEMENT DATA
FED. AID.	FUNCT. CLASS.	HWY. SYS.	HPMS SAMPLE	PRKG. REST.	COM/IND ACCESS	CONTROL	COM/IND ACCESS	PRKG. REST.	
NON FA	Rural Minor collector				E				

Hillside DR
OP 50 7 16

~~Valley RD~~
OP 48 7 06

Turner Point RD
CO 132 6 96

6 92

6 82 30 MPH

GLENCOE RD
6 55 CO 134

6 52 ~~S.L. 40MPH~~

5 74 40 MPH

PUT RD
H 77

H 63 ~~COLD HOLLOW RD~~ CO 311

18' I
2 mL

20' I
2 mL

20' I
2-8' Isl
2 mL

SHA 51.3 - 8 Revised
4.83

MARYLAND STATE HIGHWAY ADMINISTRATION

ROAD INVENTORY SHEET

Party Chief _____
Recorder _____
Assistant _____
Map No./Dir. 1
State Coordinates _____

Road No. MD 444
Road Name Kentmore Park RD
County KENT
Date _____
Sheet No. 5 OF 5

TRAFFIC CODES
TRAFFIC CONTROLS: STOP SIGN=SS, TRAFFIC LIGHT=T.L., FLASHING RED BALL=F.R.

TRAFFIC CODES
PARKING RESTRICTIONS: A.M. PEAK, P.M. PEAK, A.M./P.M. PEAK, NO PARKING ANYTIME=N.P., COMM/IND. ACCESS=E

SYSTEM				TRAFFIC		LINE DIAGRAM	TRAFFIC			PAVEMENT DATA
FED. AID.	FUNCT CLASS.	HWY. SYS.	HPMS SAMPLE	PRKG. REST.	COM/IND. ACCESS		CONTROL	COM/IND. ACCESS	PRKG. REST.	
						KENTMORE PARK RD				
						BEECHESTER CO 130				
						729 sign END STATE maint.				
						RIVERSIDE RD OP 126 725				181 2mL
NON FA										
Rural	local									

SYSTEM				TRAFFIC		LINE DIAGRAM	TRAFFIC			PAVEMENT DATA
FED. AID.	FUNCT. CLASS.	HWY. SYS.	HPMS SAMPLE	PRKG. REST.	COM/IND ACCESS		CONTROL	COM/IND ACCESS	PRKG. REST.	

'95 STATE REINVENTORY
6-7-95 TM/BB

SHA 51.3 - 8 Revised
4.83

MARYLAND STATE HIGHWAY ADMINISTRATION

ROAD INVENTORY SHEET

SR.00
4-26-00
GD/EF

Party Chief CG
Recorder LW
Assistant
Map No./Dir. /
State Coordinates 1097 - 546

Road No. MD 444 - A
Road Name SPUR
County KENT
Date 6-13-89
Sheet No. 1 OF 1

TRAFFIC CODES
TRAFFIC CONTROLS: STOP SIGN=SS, TRAFFIC LIGHT=T.L., FLASHING RED BALL=F.R.

TRAFFIC CODES
PARKING RESTRICTIONS: A.M. PEAK, P.M. PEAK, A.M./P.M. PEAK, NO PARKING ANYTIME=N.P., COMM/IND. ACCESS=E

SYSTEM				TRAFFIC		LINE DIAGRAM	TRAFFIC			PAVEMENT DATA
FED. AID.	FUNCT CLASS.	HWY. SYS.	HPMS SAMPLE	PRK.G. REST.	COM/IND. ACCESS		CONTROL	COM/IND ACCESS	PRK.G. REST.	

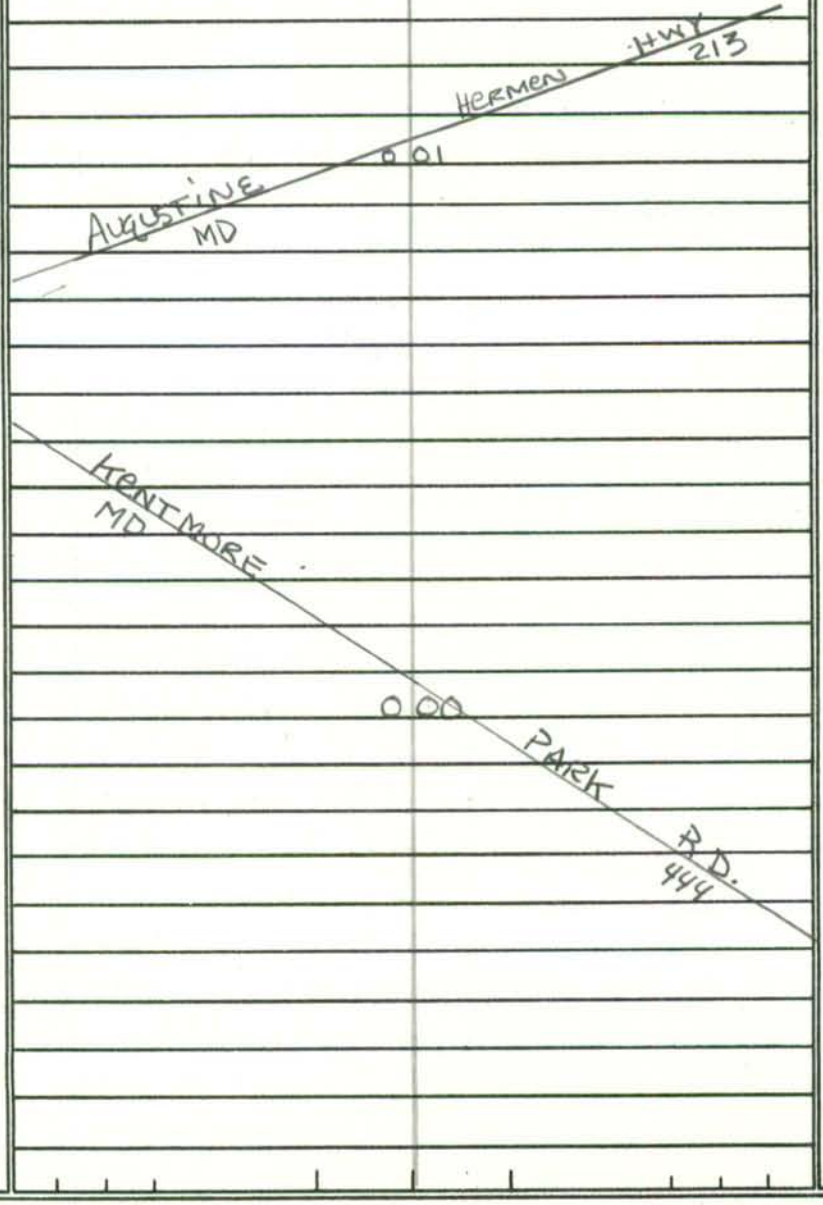

18'I
2'I SHD RT.
J-CB LT

SYSTEM				TRAFFIC		LINE DIAGRAM	TRAFFIC			PAVEMENT DATA
FED. AID.	FUNCT. CLASS.	HWY. SYS.	HPMS SAMPLE	PRKG. REST.	COM/IND ACCESS		CONTROL	COM/IND ACCESS	PRKG. REST.	

SHA 51.3 - 8 Revised
4.83

MARYLAND STATE HIGHWAY ADMINISTRATION

ROAD INVENTORY SHEET

'95 STATE REINVENTORY 6-295 TM/BB

SR.00 M-2500 GD/EF

Party Chief: C G
Recorder: L W
Assistant:
Map No./Dir.: EH, DH / N
State Coordinates:

Road No.: MD 445
Road Name: (EASTERN NECK RD)
County: KENT
Date: 6-6-89
Sheet No.: 1 OF 10

TRAFFIC CODES
TRAFFIC CONTROLS: STOP SIGN=SS, TRAFFIC LIGHT=T.L., FLASHING RED BALL=F.R.

TRAFFIC CODES
PARKING RESTRICTIONS: A.M. PEAK, P.M. PEAK, A.M./P.M. PEAK, NO PARKING ANYTIME=N.P., COMM/IND. ACCESS=E

SYSTEM				TRAFFIC		LINE DIAGRAM	TRAFFIC			PAVEMENT DATA
FED. AID.	FUNCT. CLASS.	HWY. SYS.	HPMS SAMPLE	PRK.G. REST.	COM/IND. ACCESS		CONTROL	COM/IND. ACCESS	PRK.G. REST.	
NON FA	RURAL MAJOR ~~MINOR~~ COLLECTOR	~~STATE~~	20445000000	E		0 45 S.L. 50 MPH 0 32 PT 30 0 24 PC PT 0 16 35° 0 09 PC 0 05 0 02 ~~30~~ 0 00 ~~NO~~ SIGN BEG STATE Maint #14025 0.02 EASTERN Neck ~~ROAD~~ NARROWS 1.5 EASTERN Neck CO				19' I 2 ML

SYSTEM: FED. AID. | FUNCT. CLASS. | HWY. SYS. | HPMS SAMPLE
TRAFFIC: PRKG. REST. | COM/IND ACCESS

NON FA
RURAL MAJOR ~~ARTERIAL~~ COLLECTOR
20445000000

LINE DIAGRAM

E

CAMP SITE 2 76

2 74 2-18" CMP

OP ~~PVT RD~~ 231 (~'70)
2 53 NAPLEY GREEN ~~INN~~ RD

E

2 50 2-24" CMP

ELLENDALE FARM DR
OP 232 (~'70) 2 51

PT
45°
PRC
0 95
0 93
0 84

PRC
30°
PC
0 78

PT
30°
PC
0 57
0 50

TRAFFIC: CONTROL | COM/IND ACCESS | PRKG. REST.

L

E

PAVEMENT DATA

19'I
2 ML

SHA 51.3 - 8 Revised
4.83

MARYLAND STATE HIGHWAY ADMINISTRATION

ROAD INVENTORY SHEET

Party Chief C G
Recorder L W
Assistant
Map No./Dir. E14-D14 / N
State Coordinates

Road No. MD 445
Road Name
County KENT
Date 6-6-89
Sheet No. 3 OF 10

SYSTEM: FED. AID. | FUNCT. CLASS. | HWY. SYS. | HPMS SAMPLE
TRAFFIC: PRKG. REST. | COM/IND. ACCESS

LINE DIAGRAM

TRAFFIC: CONTROL | COM/IND. ACCESS | PRKG. REST.

PAVEMENT DATA

4 71 PT

45°

4 53 PC

4 52 3-18" CMP

4 50 36" CMP

20'I
2 ML

BERRYMAN RD
~~GRAYS~~ CO 387

4 49

GRAYS INN LANDING RD
CO. 113

X

PT

4 38

30°

19' I
2 ML

PC

4 32

HUNTINGFIELD RD
Op 230

3 81

NON FA
RURAL MAJOR COLLECTOR

TRAFFIC CODES

TRAFFIC CONTROLS: STOP SIGN=SS, TRAFFIC LIGHT=T.L., FLASHING RED BALL=F.R.

TRAFFIC CODES

PARKING RESTRICTIONS: A.M. PEAK, P.M. PEAK, A.M./P.M. PEAK, NO PARKING ANYTIME=N.P., COMM/IND. ACCESS=E

LINE DIAGRAM

SYSTEM: FED. AID. | FUNCT. CLASS. | HWY. SYS. | HPMS SAMPLE
TRAFFIC: PRKG. REST. | COM/IND ACCESS
TRAFFIC: CONTROL | COM/IND ACCESS | PRKG. REST.
PAVEMENT DATA

NON FA
RURAL MAJOR COLLECTOR

4'
JS

ANN ST
MU 10 5 57

5 53 ROCK HALL HL

5 51

5 49 PC

CORP LMTS 5 47 ROCK HALL

5 46 PTA

S MAIN ST

BOUNDREX AVE
004
MU
35°

5 44

5 40 PC

5 33 SL 25 MPH

Hidden Creek Dr
5 22 PVT.

Green LANE
CO 111 5 17

Hill Lane
4 96 PVT.

ALLENS LANE
CO 112 4 82

E

NP

24'I
JC-LT
2ML

24'I
2 ML

20'I
2 ML

SHA 51.3 - 8 Revised
4.83

MARYLAND STATE HIGHWAY ADMINISTRATION

ROAD INVENTORY SHEET

A/T
92-11,5 MON
3-8-93
BB/JS

Party Chief C G
Recorder L W
Assistant
Map No./Dir. E14·D14/ N
State Coordinates

Road No. MD 445
Road Name
County KENT
Date 6-6-89
Sheet No. 5 OF 10

TRAFFIC CODES
TRAFFIC CONTROLS: STOP SIGN=SS, TRAFFIC LIGHT=T.L., FLASHING RED BALL=F.R.

TRAFFIC CODES
PARKING RESTRICTIONS: A.M. PEAK, P.M. PEAK, A.M./P.M. PEAK, NO PARKING ANYTIME=N.P., COMM/IND. ACCESS=E

SYSTEM				TRAFFIC		LINE DIAGRAM	TRAFFIC			PAVEMENT DATA
FED. AID.	FUNCT. CLASS.	HWY. SYS.	HPMS SAMPLE	PRKG. REST.	COM/IND. ACCESS		CONTROL	COM/IND. ACCESS	PRKG. REST.	
	RURAL MAJOR COLLECTOR				4' DJ	E. MAIN ST 5 88 W. MAIN ST W. SHARP ST MU 5 87 SPUR 0-02 / 12°J-CC E. SHARP ST. 0188 CHURCH 5 86 S. MAIN ST 5 82 CHESAPEAKE AVE MU 70 5 77 5 70 (CIVIC CENTER DR) MU 0085 5 68 CATHOLIC AVE MU 50 5 67 5 66 CHURCH 5 65 5 58	FY NY	4' DJ E E E E E N/P	31'I J-CB-CB 2 ML 24'I 2 ML JC-LT

SYSTEM: FED. AID. | FUNCT. CLASS. | HWY. SYS. | HPMS SAMPLE

TRAFFIC: PRKG. REST. | COM/IND ACCESS

LINE DIAGRAM

TRAFFIC: CONTROL | COM/IND ACCESS | PRKG. REST.

PAVEMENT DATA

NON FA
RURAL MINOR COLLECTOR

RD

SPRING COVE RD
60 89 672

Tolchester

" ~~SIGN~~ "
ANDERSON AVE
~~SP~~ ~~35~~
655 OP 35

~~CORP~~ LMTS / 650 ROCK HALL

648 PT
300
645 PC

Main ST

640 Sewage Treatment PLANT

20' I
2 ML

HAVEN
MV RD 623 RD 120

Frederick ~~RD~~ AV.
615 MV 110

20'
~~28'~~ I
2 ML

SP SPUR
0.01 / 20' I J-CC 602

ROCKHALL AVE
MD 601 20

31' I
J-C-C
2 ML

4' JS

FR SS

4' JS

SHA 51.3 - 8 Revised
4.83

MARYLAND STATE HIGHWAY ADMINISTRATION

ROAD INVENTORY SHEET

Party Chief C G
Recorder LW
Assistant
Map No./Dir. E14 D14 / N
State Coordinates

Road No. MD 445
Road Name (OLCHESTER RD)
County KENT
Date 6-6-89
Sheet No. 7 OF 10

SYSTEM				TRAFFIC		LINE DIAGRAM	TRAFFIC			PAVEMENT DATA
FED. AID.	FUNCT. CLASS.	HWY. SYS.	HPMS SAMPLE	PRKG. REST.	COM/IND. ACCESS		CONTROL	COM/IND. ACCESS	PRKG. REST.	
	NON FA RURAL MINOR COLLECTOR					PT 8 0 ~~0~~ 3				
						35°				
						~~PC~~ 7 96 LOVERS CO (92-31) LANE ~~RD.~~ 102				
						PC 7 92				
						PT 7 73				
						7 65 48" CMP				
						50°				
						HUMPHREYS CO ~~ROAD~~ 101 RD PT 7 60				
						PC 7 52				20' I
										2-8' ~~7~~ SHD
										2 ML
						6 85		X		
						CARTER CO 157 AVE 6 79 S.L. 50 MPH				20' I
										2 ML

TRAFFIC CODES
TRAFFIC CONTROLS: STOP SIGN=S.S., TRAFFIC LIGHT=T.L., FLASHING RED BALL=F.R.

TRAFFIC CODES
PARKING RESTRICTIONS: A.M. PEAK, P.M. PEAK, A.M./P.M. PEAK, NO PARKING ANYTIME=N.P., COMM/IND. ACCESS=E

SYSTEM: FED. AID. | FUNCT. CLASS. | HWY. SYS. | HPMS SAMPLE
TRAFFIC: PRKG. REST. | COM/IND ACCESS

LINE DIAGRAM

TRAFFIC: CONTROL | COM/IND ACCESS | PRKG. REST.

PAVEMENT DATA

NON FA
RURAL MINOR COLLECTOR

SWAN 9 36 CREEK
14019

PAVEMENT DATA: ~~20' I~~ ~~2-8' A~~ 2-8' I SHD
2 ML

CREEK RD
240
SWAN CO
9 33 CO REESES CORNER RD
98

SWAN 9 04 CREEK
14020

8 70 PT

8 67 2-36" CMP
60°

8 ~~40~~ 37 PC

PAVEMENT DATA: 20' I
2-8" I SHD
2 ML

SHA 51.3 - 8 Revised
4.83

MARYLAND STATE HIGHWAY ADMINISTRATION

ROAD INVENTORY SHEET

99-ST-EX2
CG AD
2/29/00

Party Chief: CG
Recorder: LW
Assistant:
Map No./Dir.: E14 D14 / N
State Coordinates:

Road No.: MD 445
Road Name:
County: KENT
Date: 6-6-89
Sheet No.: 9 OF 10

SYSTEM				TRAFFIC		LINE DIAGRAM	TRAFFIC			PAVEMENT DATA
FED. AID.	FUNCT CLASS.	HWY. SYS.	HPMS SAMPLE	PRK.G. REST.	COM/IND. ACCESS		CONTROL	COM/IND. ACCESS	PRK.G. REST.	
						10 88		E		
						10 85		E		
						10 37 PT				
						35°				
						10 25 PC				
						HINCHINGHAM LANE				
						OP (225) 10 06				
						9 78 36" CMP				
						PT 9 67				
						30°				
						PC 9 58				20'I
										2-8" SHD
										2 ML

RURAL MINOR COLLECTOR FA

TRAFFIC CODES
TRAFFIC CONTROLS: STOP SIGN=SS, TRAFFIC LIGHT=T.L., FLASHING RED BALL=F.R.

TRAFFIC CODES
PARKING RESTRICTIONS: A.M. PEAK, P.M. PEAK, A.M./P.M. PEAK, NO PARKING ANYTIME=N.P., COMM/IND. ACCESS=E

D14 ↑ ↓ E14

SYSTEM				TRAFFIC		LINE DIAGRAM	TRAFFIC			PAVEMENT DATA
FED. AID.	FUNCT. CLASS.	HWY. SYS.	HPMS SAMPLE	PRKG. REST.	COM/IND ACCESS		CONTROL	COM/IND ACCESS	PRKG. REST.	
						BAYSHORE RD				
						TOLCHESTER Beach ~~SANDY~~ bottom Rd. MD ~~RD~~ 359 MD CO 11 96 21	SS			
						11 24 36" CMP				
						11 20 APTS		E		
						11 14 APTS		E		
				E	E	USA ~~NIKE~~ MISSIE BASE 11 12				
						PT 11 07 30° PC 11 02				20'I 2-8'~~I~~ SHTD 2 ML
NON FA RURAL MINOR COLLECTOR										

SHA 51.3 - 8 Revised
4.83

MARYLAND STATE HIGHWAY ADMINISTRATION

90-5
1-10-91
BB/TM

TRANSFER LETTER
12-1-87
'95 STATE
REINVENTORY
6-2-95
TM/BB

SR 00
4-25-00
GD/EF

ROAD INVENTORY SHEET

Party Chief: C G
Recorder: L W
Assistant: ——
Map No./Dir.: E14 D14 / NE
State Coordinates: 1038 - 478

Road No.: MD 446
Road Name: Broad Neck RD
County: Kent
Date: 6-6-89
Sheet No.: 1 OF 3

TRAFFIC CODES
TRAFFIC CONTROLS: STOP SIGN=S.S., TRAFFIC LIGHT=T.L., FLASHING RED BALL=F.R.

TRAFFIC CODES
PARKING RESTRICTIONS: A.M. PEAK, P.M. PEAK, A.M./P.M. PEAK, NO PARKING ANYTIME=N.P., COMM/IND. ACCESS=E

SYSTEM				TRAFFIC		LINE DIAGRAM	TRAFFIC			PAVEMENT DATA
FED. AID.	FUNCT. CLASS.	HWY. SYS.	HPMS SAMPLE	PRKG. REST.	COM/IND. ACCESS		CONTROL	COM/IND. ACCESS	PRKG. REST.	
	NON FA					Beg. CEM 1 21				
	RURAL MINOR COLLECTOR					0 93 36" CMP D 2'				
						0 17 FLOVERY CO LAT 97				
						(92-91CO) CEDAR POINT RD FLOVERY OP LAT 62 0 16				
						Sign 0 01 S.L. 30 MPH ~~BEG~~ Sign "STATE MAINT"				20' 18' I 2-24 FSHD 2 ML
V	V					LANGFORD BAY ~~ESTATES~~ RD CO 146 0 00 SIGN: END STATE Maint (92-90CO)				
						NE DR RD 0 6 .9				
						BROAD CO				

LINE DIAGRAM

SYSTEM: FED. AID. | FUNCT. CLASS. | HWY. SYS. | HPMS SAMPLE

TRAFFIC: PRKG. REST. | COM/IND ACCESS

TRAFFIC: CONTROL | COM/IND ACCESS | PRKG. REST.

PAVEMENT DATA

NON FA
RURAL MINOR COLLECTOR

PT
30°
PRC
2 99
2 92
PRC
30°
2 86
PC
2 67
PT
30°
2 59
PC
2 42 S.L. 50 MPH
PT
60°
PC
1 78
1 71
FOX POINT FARM LANE
1 47 OP
(199 #47)
END CEM
1 25
CHURCH "ABAN"
1 23

20'
~~18'~~ I
~~2-2' FSHD~~
2 ML

SHA 51.3 - 8 Revised
4.83

MARYLAND STATE HIGHWAY ADMINISTRATION

ROAD INVENTORY SHEET

Party Chief: C G
Recorder: L W
Assistant: —
Map No./Dir.: E14 D14 / NE
State Coordinates: 1038 - 478

Road No.: MD 446
Road Name: "BROADNECK RD
County: KENT
Date: 6-6-89
Sheet No.: 3 OF 3

TRAFFIC CODES
TRAFFIC CONTROLS: STOP SIGN=SS, TRAFFIC LIGHT=T.L., FLASHING RED BALL=F.R.

TRAFFIC CODES
PARKING RESTRICTIONS: A.M. PEAK, P.M. PEAK, A.M./P.M. PEAK, NO PARKING ANYTIME=N.P., COMM/IND. ACCESS=E

SYSTEM				TRAFFIC		LINE DIAGRAM	TRAFFIC			PAVEMENT DATA
FED. AID.	FUNCT. CLASS.	HWY. SYS.	HPMS SAMPLE	PRKG. REST.	COM/IND. ACCESS		CONTROL	COM/IND. ACCESS	PRKG. REST.	

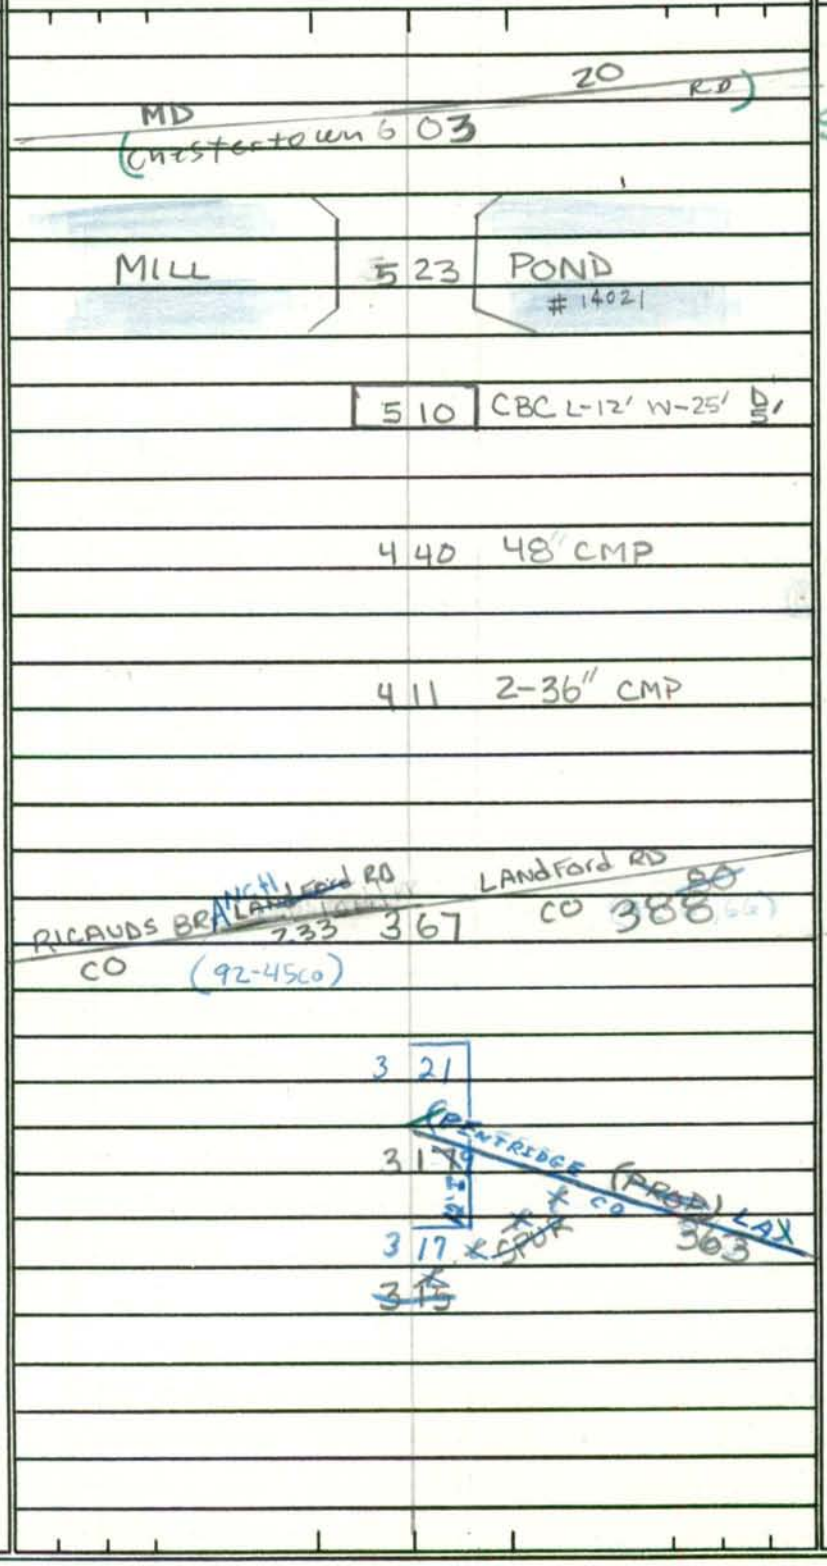

NON FA
RURAL MINOR COLLECTOR

~~20' I~~
~~2-2' GSHDS~~
~~2 ML~~
~~20' I~~
~~2-3" FSHD~~
~~2 ML~~
20'
~~18' I~~
~~2-2' FSHD~~
2 ML

SYSTEM				TRAFFIC		LINE DIAGRAM	TRAFFIC			PAVEMENT DATA
FED. AID.	FUNCT. CLASS.	HWY. SYS.	HPMS SAMPLE	PRKG. REST.	COM/IND ACCESS		CONTROL	COM/IND ACCESS	PRKG. REST.	

SHA 51.3 - 8 Revised
4.83

MARYLAND STATE HIGHWAY ADMINISTRATION

ROAD INVENTORY SHEET

Party Chief _____
Recorder _____
Assistant _____
Map No./Dir. 1
State Coordinates _____

Road No. MD 447
Road Name _____
County KENT
Date _____
Sheet No. _____ OF _____

SYSTEM				TRAFFIC		LINE DIAGRAM	TRAFFIC			PAVEMENT DATA
FED. AID.	FUNCT CLASS.	HWY. SYS.	HPMS SAMPLE	PRKG. REST.	COM/IND. ACCESS		CONTROL	COM/IND. ACCESS	PRKG. REST.	
						UNASSIGNED NOW 6311 87-55 TRANSFER LETTER 12-1-87				

TRAFFIC CODES

TRAFFIC CONTROLS: STOP SIGN=SS, TRAFFIC LIGHT=T.L., FLASHING RED BALL=F.R.

TRAFFIC CODES

PARKING RESTRICTIONS: A.M. PEAK, P.M. PEAK, A.M./P.M. PEAK, NO PARKING ANYTIME=N.P., COMM/IND. ACCESS=E

SYSTEM				TRAFFIC		LINE DIAGRAM	TRAFFIC				PAVEMENT DATA
FED. AID.	FUNCT. CLASS.	HWY. SYS.	HPMS SAMPLE	PRKG. REST.	COM/IND ACCESS		CONTROL	COM/IND ACCESS	PRKG. REST.		

SHA 51.3 - 8 Revised
4.83

MARYLAND STATE HIGHWAY ADMINISTRATION

ROAD INVENTORY SHEET

Party Chief _____
Recorder _____
Assistant _____
Map No./Dir. 1
State Coordinates _____

Road No. MD 448
Road Name _____
County KENT
Date _____
Sheet No. _____ OF _____

SYSTEM				TRAFFIC		LINE DIAGRAM	TRAFFIC			PAVEMENT DATA
FED. AID.	FUNCT CLASS.	HWY. SYS.	HPMS SAMPLE	PRKG. REST.	COM/IND. ACCESS		CONTROL	COM/IND. ACCESS	PRKG. REST.	
						~~UNASSIGNED~~				
						Now Co 42 &				
						Co 315				
						TRANSFER LETTER 12-1-87				
						87-61 & 62				

TRAFFIC CODES

TRAFFIC CONTROLS: STOP SIGN=SS, TRAFFIC LIGHT=T.L., FLASHING RED BALL=F.R.

TRAFFIC CODES

PARKING RESTRICTIONS: A.M. PEAK, P.M. PEAK, A.M./P.M. PEAK, NO PARKING ANYTIME=N.P., COMM/IND. ACCESS=E

SYSTEM				TRAFFIC		LINE DIAGRAM	TRAFFIC				PAVEMENT DATA
FED. AID.	FUNCT. CLASS.	HWY. SYS.	HPMS SAMPLE	PRKG. REST.	COM/IND ACCESS		CONTROL	COM/IND ACCESS	PRKG. REST.		

* To eventually be abandoned by District.

SHA 51.3 - 8 Revised 4.83

MARYLAND STATE HIGHWAY ADMINISTRATION

Transfer Letter (Dead only) 12-30-97

ROAD INVENTORY SHEET

SR.00 4-27-00 GD/EF

Party Chief: Office Inv. AL
Recorder:
Assistant:
Map No./Dir.: C-15 / NE
State Coordinates: 1097-546

Road No.: MD 449
Road Name: Shallcross Wharf Rd
County: Kent
Date: 4-20-98
Sheet No.: 1 OF 1

TRAFFIC CODES

TRAFFIC CONTROLS: STOP SIGN-SS, TRAFFIC LIGHT=T.L., FLASHING RED BALL=F.R.

TRAFFIC CODES

PARKING RESTRICTIONS: A.M. PEAK, P.M. PEAK, A.M./P.M. PEAK, NO PARKING ANYTIME=N.P., COMM/IND. ACCESS=E

SYSTEM				TRAFFIC		LINE DIAGRAM	TRAFFIC			PAVEMENT DATA
	FUNCT CLASS	HWY. SYS.	HPMS SAMPLE	PREG. REST.	COM/IND ACCESS		CONTROL	COM/IND ACCESS	PREG. REST.	
						Shallcross Wharf Rd				
						Shallcross Co 27				
						Kentmore / Park Rd				
						MD 0 07 444	SS			
NON FA	Rural Local									22'I
										2 yml
										2-3' E SHD
						MD 0 00 213	SS			

COUNTY _____ ROAD NO. _____ PAGE ___ OF ___

SYSTEM				TRAFFIC		LINE DIAGRAM	TRAFFIC			PAVEMENT DATA
FUNCT CLASS	HWY SYS	NHS	STRAHNET	PREG. REST.	% OWN/IND ACCESS		% OTHER	% OWN/IND ACCESS	PREG. REST.	

SHA 51.3 - 8 Revised
4.83

MARYLAND STATE HIGHWAY ADMINISTRATION

ROAD INVENTORY SHEET

(94-25T) BB-AH 11-7-94

9551 RI 6-5-95 TM/SB

SR.00 4-25-00 GD/EF

Party Chief CG
Recorder LW
Assistant Rewritten 2-94 A.R.
Map No./Dir. D14 / NW
State Coordinates

Road No. MD 514
Road Name (FLATLAND Rd)
County Kent
Date 6-6-89
Sheet No. 1 OF 4

TRAFFIC CODES

TRAFFIC CONTROLS: STOP SIGN=SS, TRAFFIC LIGHT=T.L., FLASHING RED BALL=F.R.

TRAFFIC CODES

PARKING RESTRICTIONS: A.M. PEAK, P.M. PEAK, A.M./P.M. PEAK, NO PARKING ANYTIME=N.P., COMM/IND. ACCESS=E

SYSTEM				TRAFFIC		LINE DIAGRAM	TRAFFIC			PAVEMENT DATA
FED. AID.	FUNCT CLASS.	HWY. SYS.	HPMS SAMPLE	PRK.G. REST.	COM/IND. ACCESS		CONTROL	COM/IND. ACCESS	PRK.G. REST.	
	Rural major Collector					0.14			PKG	24 I
										6' Shd RT
										2' Shd LT
										2 mL
						0.12				
						0.11 DPL Elect Substation				
										24' I
						0.08 PT		E		4' I Shd LT
										10' I Shd RT
						0.07		E		2 mL
						0.06 35°		E		
						0.05 S.L 30MPH				
						0.03 PC		E	X	
						↑ Corp Limits : Chestertown ↑				24 I
						0.01				7' H Shd RT
										7' H Shd LT
						Chester Town				2 mL
						MD 0.00 RD 20	38			

FAS 1289

LINE DIAGRAM

SYSTEM: FED. AID. | FUNCT. CLASS. | HWY. SYS. | HPMS SAMPLE

TRAFFIC: PRKG. REST. | COM/IND ACCESS

TRAFFIC: CONTROL | COM/IND ACCESS | PRKG. REST.

PAVEMENT DATA

FAS 1289

Rural Major Collector

20514000000056

0 75 Devon DR

0 72 MK 0112

0 66

~~0 60~~

0 62 Radio Station (WCTR)

0 56 S.L. 50 MPH

0 51 Chesterfield

(Lincoln DR.)

0 47 MK 0168

Ent. Vickers DR. to Rent CO Jail CO 326

0 44

Edge of Town DR.

0 40 Trailer Court

0 38

PT

0 35

0 34

To Apts

0 30

30°

(Brookmeadow DR)

0 27

0 25

0 24

PC

0 20

2E

E

E

E

24'I

2.5'I Shd

2mL

24'I

2-10'I Shd

J-CB LT

2mL

24'I

2-6'I Shd

2mL

24'I

2-10'I Shds

2mL

JC-LT

24'I

2-6'I Shd

2mL JC-LT

24'I

6'I Shd RT

2'I Shd LT

2mL

SHA 51.3 - 8 Revised
4.83

MARYLAND STATE HIGHWAY ADMINISTRATION

ROAD INVENTORY SHEET

Party Chief: CG
Recorder: LW
Assistant: —
Map No./Dir.: D 14 / NW
State Coordinates:

Road No.: MD 514
Road Name: (FLATLAND RD)
County: KENT
Date: 6-7-89
Sheet No.: 3 OF 4

SYSTEM: FED. AID. | FUNCT. CLASS. | HWY. SYS. | HPMS SAMPLE
TRAFFIC: PRKG. REST. | COM/IND. ACCESS

LINE DIAGRAM

TRAFFIC: CONTROL | COM/IND. ACCESS | PRKG. REST.

PAVEMENT DATA

TRAFFIC CODES
TRAFFIC CONTROLS: STOP SIGN=SS, TRAFFIC LIGHT=T.L., FLASHING RED BALL=F.R.

TRAFFIC CODES
PARKING RESTRICTIONS: A.M. PEAK, P.M. PEAK, A.M./P.M. PEAK, NO PARKING ANYTIME=N.P., COMM/IND. ACCESS=E

FOR PASI289
RURAL MAJOR COLLECTOR
20514000056

MARYMORE'S RD
2 05 CO. 69

1 92 36" CMP

1 58 PT
40°
PC

STOCKTON STARTT RD
CO 75 1 37

CROMWELL CLARK RD
1 29 CO. 71

PT
1 23
35°
1 20
ARRAN. SEPT. MD 514
PC
1 06

PAVEMENT DATA:
24'I
~~20'I~~
~~2-6'G SHD~~
2 ML
2-5'I SHD

LINE DIAGRAM

SYSTEM: FED. AID. | FUNCT. CLASS. | HWY. SYS. | HPMS SAMPLE
TRAFFIC: PRKG. REST. | COM/IND ACCESS
TRAFFIC: CONTROL | COM/IND ACCESS | PRKG. REST.
PAVEMENT DATA

NOT FAS 1289
RURAL MAJOR COLLECTOR
20514000056

HANDY POINT RD
MD (Fairlee) 4 89 298 E/O
PT 4 614 PT
30° 30°
PC 4 57 PC
PORTER GROVE MIELLE DATA RD
PORTER GROVE HAVENSVILLE RD 64 CO
(FLATLAND RD) 3 76 80°
PORTERS GROVE WORTON RD 3 59 CO 66
2 15 E

TRAFFIC: CONTROL SS

PAVEMENT DATA:
~~22'F~~
~~2 ML~~
24' ~~F~~ I
2 ML
2-4' ~~E~~ SHD I
~~20'I~~
~~2-6' G SHD~~
~~2 ML~~
24' I
2-5' I SHD
2 ML

SHA 51.3 - 8 Revised
4.83

MARYLAND STATE HIGHWAY ADMINISTRATION

OD-STEX#2
1-29-01
GD/EF

'95 STATE
REINVENTORY
6-6-95
TM188

SR.00
4-27-00
GD/EF

ROAD INVENTORY SHEET

Party Chief: CG
Recorder: LW
Assistant:
Map No./Dir.: D15 / N
State Coordinates:

Road No.: MD 561
Road Name: (HASSENGERS COR. RD.)
County: Kent
Date: 6-19-89
Sheet No.: 1 OF 3

TRAFFIC CODES
TRAFFIC CONTROLS: STOP SIGN=SS, TRAFFIC LIGHT=T.L., FLASHING RED BALL=F.R.

TRAFFIC CODES
PARKING RESTRICTIONS: A.M. PEAK, P.M. PEAK, A.M./P.M. PEAK, NO PARKING ANYTIME=N.P., COMM/IND. ACCESS=E

SYSTEM				TRAFFIC		LINE DIAGRAM	TRAFFIC			PAVEMENT DATA
FED. AID.	FUNCT. CLASS.	HWY. SYS.	HPMS SAMPLE	PRKG. REST.	COM/IND. ACCESS		CONTROL	COM/IND. ACCESS	PRKG. REST.	
	NON RURAL	FA LOCAL				159 PT 40°				
						136 BIGWOODS RD 49 PC CO				
						WORTON LYNCH RD CO 67 104				
						061 2-48" CP D-3'				
						~~005~~				22'I
						018 S.L. 50 MPH				2-7'I SHD 2ML
K	K					HERMAN HWY 213 (AUGUSTINE MD	SS			~~24'I~~ ~~2-7'I SHD~~ ~~2ML~~

SYSTEM				TRAFFIC		LINE DIAGRAM	TRAFFIC			PAVEMENT DATA
FED. AID.	FUNCT. CLASS.	HWY. SYS.	HPMS SAMPLE	PRKG. REST.	COM/IND ACCESS		CONTROL	COM/IND ACCESS	PRKG. REST.	
						MD / DEL. RAILROAD 2 23 MDDE526441D				22'I ~~23'I SHDS~~ 2ML
					E	2 20		E		
						LYNCH P.O. 2 19				
					E	2 18		E		
						2 16 ~~RXR Roadway~~		E		
						2 14 RxR Roadway Markings		E		~~22'I~~ ~~2 3'I SHD~~ ~~2ML~~
						2 13		E	X	22'I 7'I SHD RT 3'I SHD LT 2ML
						2 12 Sign (RXR) 2 06 SL 30 MPH 2 01 SIGN: LYNCH 1 90 36" CP D-2'			X	
						PT 1 83 40° PC 1 68				22'I 2-7'~~I~~ SHD 2ML

NON FA RURAL LOCAL

SHA 51.3 - 8 Revised
4.83

MARYLAND STATE HIGHWAY ADMINISTRATION

ROAD INVENTORY SHEET

Party Chief: C G
Recorder: L W
Assistant:
Map No./Dir.: D 15 / N
State Coordinates:

Road No.: MD 561
Road Name: (HASSENGERS COR. RD.)
County: Kent
Date: 6-19-89
Sheet No.: 3 OF 3

TRAFFIC CODES
TRAFFIC CONTROLS: STOP SIGN=SS, TRAFFIC LIGHT=T.L., FLASHING RED BALL=F.R.

TRAFFIC CODES
PARKING RESTRICTIONS: A.M. PEAK, P.M. PEAK, A.M./P.M. PEAK, NO PARKING ANYTIME=N.P., COMM/IND. ACCESS=E

SYSTEM				TRAFFIC		LINE DIAGRAM	TRAFFIC			PAVEMENT DATA
FED. AID.	FUNCT. CLASS.	HWY. SYS.	HPMS SAMPLE	PRK.G. REST.	COM/IND. ACCESS		CONTROL	COM/IND. ACCESS	PRK.G. REST.	
						(RD.) 248 856				
						Lambs Meadow				
						MD 248 MD	SS			
						← 0.03 MI →				
						Chickadee LANE				
						238 PVT				
						~~237 CHURCH~~				
						RXR Roadway Markings 228				
						(RXR) Sign 227				
						~~RXR Roadway 226~~				22'I
										2'~~I~~SHD 2ML
				E		DPL SUB STATION 225				X
										22'I
										2-3'I SHD
										2 ML

RURAL LOCAL NON FA

SYSTEM				TRAFFIC		LINE DIAGRAM	TRAFFIC			PAVEMENT DATA
FED. AID.	FUNCT. CLASS.	HWY. SYS.	HPMS SAMPLE	PRKG. REST.	COM/IND ACCESS		CONTROL	COM/IND ACCESS	PRKG. REST.	

'95 STATE REINVENTORY
6-6-95 TM188

SHA 51.3 - 8 Revised
4.83

MARYLAND STATE HIGHWAY ADMINISTRATION

ROAD INVENTORY SHEET

SR.00
4-27-00
GDIEF

00-ST EX#3
1-29-01
GDIEF

Party Chief C.G
Recorder L.W
Assistant —
Map No./Dir. 1 / E
State Coordinates 1070 - 545

Road No. MD 566
Road Name (STILLPOND HARMONY RD.)
County Kent
Date 6-19-89
Sheet No. 1 OF 1

TRAFFIC CODES
TRAFFIC CONTROLS: STOP SIGN=SS, TRAFFIC LIGHT=T.L., FLASHING RED BALL=F.R.

TRAFFIC CODES
PARKING RESTRICTIONS: A.M. PEAK, P.M. PEAK, A.M./P.M. PEAK, NO PARKING ANYTIME=N.P., COMM/IND. ACCESS=E

SYSTEM				TRAFFIC		LINE DIAGRAM	TRAFFIC			PAVEMENT DATA
FED. AID.	FUNCT. CLASS.	HWY. SYS.	HPMS SAMPLE	PRKG. REST.	COM/IND. ACCESS		CONTROL	COM/IND. ACCESS	PRKG. REST.	
						Sawmill RD 298				
						BLOOMFIED RD CO 43 MD 19 Meadow MD RD.) 298	SS			
						036				
						RD 309				21' I
										2-7'ISHD
						0.02 / 21'E 2UML				2 ML
						SPUR 030				
						MEADES CO				
										21'I
										2-6'ISHDS
						MEADES CO 021 36" CMP				2ML
						019 S.L. 50MPH				
						015		41'		
						309 RD 004				
						002 S.L. 25 MPH				
						001				20'I
										~~5'I SHD RT~~
										4'ISHD ~~LT~~
										2 ML
						(MAIN ST) CO 47 000 (STILLPOND RD.) MD 292				
						(STILLPOND RD.) 292				
						(STILLPOND MD				

FAS 1268 RURAL MAJOR COLLECTOR

SYSTEM				TRAFFIC		LINE DIAGRAM	TRAFFIC			PAVEMENT DATA
FED. AID.	FUNCT. CLASS.	HWY. SYS.	HPMS SAMPLE	PRKG. REST.	COM/IND ACCESS		CONTROL	COM/IND ACCESS	PRKG. REST.	

SHA 51.3 - 8 Revised
4.83

MARYLAND STATE HIGHWAY ADMINISTRATION

ROAD INVENTORY SHEET

Party Chief _____
Recorder _____
Assistant _____
Map No./Dir. 1
State Coordinates _____

Road No. MD 661
Road Name _____
County Kent
Date _____
Sheet No. _____ OF _____

SYSTEM				TRAFFIC		LINE DIAGRAM	TRAFFIC			PAVEMENT DATA
FED. AID.	FUNCT CLASS.	HWY. SYS.	HPMS SAMPLE	PRKG. REST.	COM/IND. ACCESS		CONTROL	COM/IND. ACCESS	PRKG. REST.	
						UNASSIGNED NOW G396 TRANSFER LETTER 11-18-94				

TRAFFIC CODES

TRAFFIC CONTROLS: STOP SIGN=SS, TRAFFIC LIGHT=T.L., FLASHING RED BALL=F.R.

TRAFFIC CODES

PARKING RESTRICTIONS: A.M. PEAK, P.M. PEAK, A.M./P.M. PEAK, NO PARKING ANYTIME=N.P., COMM/IND. ACCESS=E

SYSTEM				TRAFFIC		LINE DIAGRAM	TRAFFIC			PAVEMENT DATA
FED. AID.	FUNCT. CLASS.	HWY. SYS.	HPMS SAMPLE	PRK.G. REST.	COM/IND ACCESS		CONTROL	COM/IND ACCESS	PRK.G. REST.	

SHA 51.3 - 8 Revised
4.83

MARYLAND STATE HIGHWAY ADMINISTRATION

ROAD INVENTORY SHEET

Party Chief _____
Recorder _____
Assistant _____
Map No./Dir. 1
State Coordinates _____

Road No. MD 664
Road Name _____
County Kent
Date _____
Sheet No. _____ OF _____

SYSTEM				TRAFFIC		LINE DIAGRAM	TRAFFIC			PAVEMENT DATA
FED. AID.	FUNCT CLASS.	HWY. SYS.	HPMS SAMPLE	PRKG. REST.	COM/IND. ACCESS		CONTROL	COM/IND. ACCESS	PRKG. REST.	
						UNASSIGNED				
						NON G 397				
						TRANSFER LETTER 11-18-94				

TRAFFIC CODES

TRAFFIC CONTROLS: STOP SIGN=S.S., TRAFFIC LIGHT=T.L., FLASHING RED BALL=F.R.

TRAFFIC CODES

PARKING RESTRICTIONS: A.M. PEAK, P.M. PEAK, A.M./P.M. PEAK, NO PARKING ANYTIME=N.P., COMM/IND. ACCESS=E

SYSTEM				TRAFFIC		LINE DIAGRAM	TRAFFIC			PAVEMENT DATA
FED. AID.	FUNCT. CLASS.	HWY. SYS.	HPMS SAMPLE	PRK.G. REST.	COM/IND ACCESS		CONTROL	COM/IND ACCESS	PRK.G. REST.	

SHA 51.3 - 8 Revised
4.83

Transfer Agreement 10/13/95

MARYLAND STATE HIGHWAY ADMINISTRATION

ROAD INVENTORY SHEET

E SHARP ST
MU 0188

SR.00
4-2500
GD/EF

89-2
1-30-90
BB/BB
A/T

'95 STATE REINVENTORY
6-2-95
TM/BB

N/T
92-6, 7 MON
3-8-93
BB/JS
00-09

1 PROVE

Party Chief: C G
Recorder: L W
Assistant:
Map No./Dir.: E14 / E
State Coordinates: 1016-472

Road No.: MD 674
Road Name: W. SHARP ST.
County: Kent
Date: 6-8-89
Sheet No.: 1 OF 4

TRAFFIC CODES
TRAFFIC CONTROLS: STOP SIGN=SS, TRAFFIC LIGHT=T.L., FLASHING RED BALL=F.R.

LN E 666

TRAFFIC CODES
PARKING RESTRICTIONS: A.M. PEAK, P.M. PEAK, A.M./P.M. PEAK, NO PARKING ANYTIME=N.P., COMM/IND. ACCESS=E

D W

SYSTEM				TRAFFIC		LINE DIAGRAM	TRAFFIC			PAVEMENT DATA
FED. AID.	FUNCT. CLASS.	HWY. SYS.	HPMS SAMPLE	PRKG. REST.	COM/IND. ACCESS		CONTROL	COM/IND. ACCESS	PRKG. REST.	
NON FA	RURAL LOCAL	MU	0188	NP		0 34 School 0 32 ROCKHALL MIDDLE SCHOOL 0 30 School Second St. SIGN: Pvt Rd 0 27 0 21 (A) WATERMANS WAY 0 18 (NO NAME) OP 156 0 08 0 04 S.L. 25MPH HIST SIGN 0 01 CHESAPEAKE AVE MU 70 HAWTHORNE AVE MU 140 0 00 W SHARP ST 1 56 0		E 4 N	NP	22' I J-C-C 2 ML

LINE DIAGRAM

SYSTEM: FED. AID. | FUNCT. CLASS. | HWY. SYS. | HPMS SAMPLE
TRAFFIC: PRKG. REST. | COM/IND ACCESS
TRAFFIC: CONTROL | COM/IND ACCESS | PRKG. REST.
PAVEMENT DATA

NON FA
RURAL LOCAL
RURAL MINOR COLLECTOR
MD 0188

0.53 ROCK HALL V.F.D
0.52
0.51 ROCK HALL V.F.D. ANEX
0.50
SPUR 0.02 / 12'I J-C-C
0.49 N. MAIN ST. MD — S. MAIN ST. 445
0.47 HISTORICAL SIGN
0.45 LIONS CLUB
0.42 LIBERTY MUN. — ST. 0180

E SHARP ST. — E
4' JS
SS RB FR
W SHARP ST. — 0188 MD
4' JS
NP
NP

PAVEMENT DATA:
~~31'I~~ ~~J CB LF~~ ~~2 ML~~
24'I I-C-C 2 ML
31'I J-C-C 2 ML
22'I J-C-C 2 ML

SHA 51.3 - 8 Revised
4.83

MARYLAND STATE HIGHWAY ADMINISTRATION

ROAD INVENTORY SHEET MU 0188

96-1 ST
GO/HS
1-28-97

Party Chief C G
Recorder L W
Assistant —
Map No./Dir. 1
State Coordinates

Road No. ~~MD~~ 674
Road Name ~~E.W.~~ SHARP ST.
County KENT
Date 6-8-89
Sheet No. 3 OF 4

SYSTEM				TRAFFIC		LINE DIAGRAM	TRAFFIC			PAVEMENT DATA
FED. AID.	FUNCT. CLASS.	HWY. SYS.	HPMS SAMPLE	PKG. REST.	COM/IND. ACCESS		CONTROL	COM/IND. ACCESS	PKG. REST.	
NON FA	RURAL MAJOR COLLECTOR	MU 0188			E	0 99 0 88 PT 0 80 BOUNDARY MU. AVE 0021 0 84 80° 0 83 PC (Chesapeake Ville) MU. 0072 @.23 0 76 0 73 American Legion 0188 MU CHURCH 0 63 JUDEFIND AVE MU 160 0 62 0 54		E		X ~~29'G~~ ~~33'I~~ ~~2-3'ESHD~~ ~~2 ML~~ * ~~33'I~~ ~~I-C~~ ~~2 ML~~ ~~24'I~~ ~~2 ML~~ * ~~31'I~~ ~~I-CB LT~~ ~~2 ML~~

TRAFFIC CODES
TRAFFIC CONTROLS: STOP SIGN=SSy, TRAFFIC LIGHT=T.L., FLASHING RED BALL=F.R.

MAP

TRAFFIC CODES
PARKING RESTRICTIONS: A.M. PEAK, P.M. PEAK, A.M./P.M. PEAK, NO PARKING ANYTIME=N.P., COMM/IND. ACCESS=E

IMF

SYSTEM: FED. AID. | FUNCT. CLASS. | HWY. SYS. | HPMS SAMPLE
TRAFFIC: PRKG. REST. | COM/IND ACCESS

LINE DIAGRAM

TRAFFIC: CONTROL | COM/IND ACCESS | PRKG. REST.

PAVEMENT DATA


Rock Hall RD 20

MD

116

SPUR .01 12'I

114

90°

108

Pine Lane

106 PVT.

PT

CORP LMTS 100

099 ROCK HALL

300

098 S.L 30 MPH

PC GRAYS CROSSING 091 INN CREEK

14023

E

PAVEMENT DATA:
- ~~20' I RT~~
- ~~23' I HLI~~
- ~~8' G SHD LFT~~
- ~~4' J MED G-C~~
- 2 UML IN
- ~~9.6 23' I~~
- ~~3-8' I SHD 3' E SHD RT~~
- ~~10' J SHD LT~~
- 2 ML
- 20' I
- ~~2 I~~
- ~~2 I SHD~~
- 2 ML
- 2 ML
- ~~20' I 2 G~~
- ~~33' I~~
- ~~2-3' I SHD~~
- ~~2 ML~~
- 2 ML
- 2-9' I SHD

SHA 51.3 - 8 Revised
4.83

MARYLAND STATE HIGHWAY ADMINISTRATION

ROAD INVENTORY SHEET

95STATE REINVENTORY TM/DB 6-2-95

96-1ST GA/KS 1-28-97

Party Chief: CG
Recorder: LW
Assistant:
Map No./Dir.: 1 / E
State Coordinates:

Road No.: MD 674-A
Road Name: SPUR
County: Kent
Date: 6-8-89
Sheet No.: 1 OF 1

TRAFFIC CODES
TRAFFIC CONTROLS: STOP SIGN=SS, TRAFFIC LIGHT=T.L., FLASHING RED BALL=F.R.

TRAFFIC CODES
PARKING RESTRICTIONS: A.M. PEAK, P.M. PEAK, A.M./P.M. PEAK, NO PARKING ANYTIME=N.P., COMM/IND. ACCESS=E

SYSTEM				TRAFFIC		LINE DIAGRAM	TRAFFIC			PAVEMENT DATA
FED. AID.	FUNCT CLASS.	HWY. SYS.	HPMS SAMPLE	PRKG. REST.	COM/IND. ACCESS		CONTROL	COM/IND. ACCESS	PRKG. REST.	
NON FA	RURAL LOCAL					ABANDON 0.20 0.08 POINT GORE ROCK HALL RD 0.05 MD ONE WAY W MD SHARP 0.00 90° STOP				19'I 14'I SHDR 9'I SHDR 10-C-C- 9 / ML 19'I 6'E SHDR 1 ML

SYSTEM				TRAFFIC		LINE DIAGRAM	TRAFFIC			PAVEMENT DATA
FED. AID.	FUNCT. CLASS.	HWY. SYS.	HPMS SAMPLE	PRKG. REST.	COM/IND ACCESS		CONTROL	COM/IND ACCESS	PRKG. REST.	

MP 0.13 to 0.74 transferred to county
MQA. 11-25-97 Now CO 406
Construction complete 3/3/2000
See Contract # KE 4255170

SHA 51.3 - 8 Revised 4.83

MARYLAND STATE HIGHWAY ADMINISTRATION

SR.00
4-26-00
GD/EF

ROAD INVENTORY SHEET

Party Chief: Office Inventory WS
Recorder:
Assistant:
Map No./Dir.: D15 / N
State Coordinates: 1122-522

Road No.: MD 701
Road Name: (HOWARD JOHNSON RD)
County: KENT
Date: 4-11-00
Sheet No.: 1 OF 1

99-1ST Ex #1

TRAFFIC CODES
TRAFFIC CONTROLS: STOP SIGN-SS, TRAFFIC LIGHT=T.L., FLASHING RED BALL=F.R.

TRAFFIC CODES
PARKING RESTRICTIONS: A.M. PEAK, P.M. PEAK, A.M./P.M. PEAK, NO PARKING ANYTIME=N.P., COMM/IND. ACCESS=E

SYSTEM			TRAFFIC		LINE DIAGRAM	TRAFFIC			PAVEMENT DATA
FUNCT CLASS	HWY. SYS.	HPMS SAMPLE	PEAK REST.	COM/IND ACCESS		CONTROL	COM/IND ACCESS	PEAK REST.	
RURAL LOCAL	STATE SECONDARY				(HOWARD JOHNSON RD) CO 406				
					RAMP 2 TO US 301 N/B 0 13				
					RAMP 4 FR US 301 N/B 0 12				
					0 09 PT				24' I
					30°				2-10' I SHD
									2ML
					0 04 PC				
					0 02				X 2-18' I
					RIVER RD MD 0 00 291				22' J SHD IN 30' GRS MED
									J C-C IN/OUT 2ML

COUNTY _____ ROAD NO. _____ PAGE ___ OF ___

SYSTEM				TRAFFIC		LINE DIAGRAM	TRAFFIC				PAVEMENT DATA
FUNCT CLASS	HWY SYS	HPMS SAMPLE		PREG. REST.	COM/IND ACCESS		CONTROL	COM/IND ACCESS	PREG. REST.		

99-1ST. Ex #2
New road completed
3-3-2000
Contract # KE 4255170

SR.00
4-26-00
GD/EF

SHA 51.3 - 8 Revised
4.83

MARYLAND STATE HIGHWAY ADMINISTRATION

ROAD INVENTORY SHEET

Party Chief: Office Inventory WS
Recorder:
Assistant:
Map No./Dir.: D 15 / N
State Coordinates: 1120 - 523

Road No.: MD 701 A
Road Name: EDGE RD
County: KENT
Date: 4-11-00
Sheet No.: 1 OF 1

TRAFFIC CODES
TRAFFIC CONTROLS: STOP SIGN-SS, TRAFFIC LIGHT=T.L., FLASHING RED BALL=F.R.

TRAFFIC CODES
PARKING RESTRICTIONS: A.M. PEAK, P.M. PEAK, A.M./P.M. PEAK, NO PARKING ANYTIME=N.P., COMM/IND. ACCESS=E

SYSTEM: FUNCT CLASS	SYSTEM: HWY. SYS	SYSTEM: HPMS SAMPLE	TRAFFIC: PEAK. REST.	TRAFFIC: COM/IND. ACCESS	LINE DIAGRAM	TRAFFIC: CONTROL	TRAFFIC: COM/IND. ACCESS	TRAFFIC: PEAK. REST.	PAVEMENT DATA
RURAL LOCAL	STATE SECONDARY				EDGE RD CO 407				
					RAMP 8 FR US 301 S/B				
					0 14				
					RAMP 6 TO US 301 S/B				
					0 13				
					PT 0 06				24' I
					30°				2-4' I SHD
					PC 0 01				2 ML
					RIVER MD 0 00 291 RD				2-18' I
					EDGE RD CO 308				22' I SHD IN 30' GRS MED
									3 C-C IN/OUT
									2 ML

COUNTY _____ ROAD NO. _____ PAGE ___ OF ___

SYSTEM				TRAFFIC		LINE DIAGRAM	TRAFFIC				PAVEMENT DATA
	FUNCT CLASS	HWY SYS	HPMS SAMPLE	PKG REST	OWNERSHIP ACCESS		OWNERSHIP	ACCESS	PKG. REST.		

'95 STATE REINVENTORY
6-7-95 TM/BB

SHA 51.3 - 8 Revised
4.83

MARYLAND STATE HIGHWAY ADMINISTRATION

ROAD INVENTORY SHEET

SR.00
4-25-00
GD/EF

Party Chief C G
Recorder L W
Assistant
Map No./Dir. / E
State Coordinates 1087½-541½

Road No. MD 855
Road Name (OLD SECT. MD. 213)
County KENT
Date 6-14-89
Sheet No. 1 OF 1

SYSTEM: FED. AID. | FUNCT. CLASS. | HWY. SYS. | HPMS SAMPLE
TRAFFIC: PRKG. REST. | COM/IND. ACCESS

LINE DIAGRAM

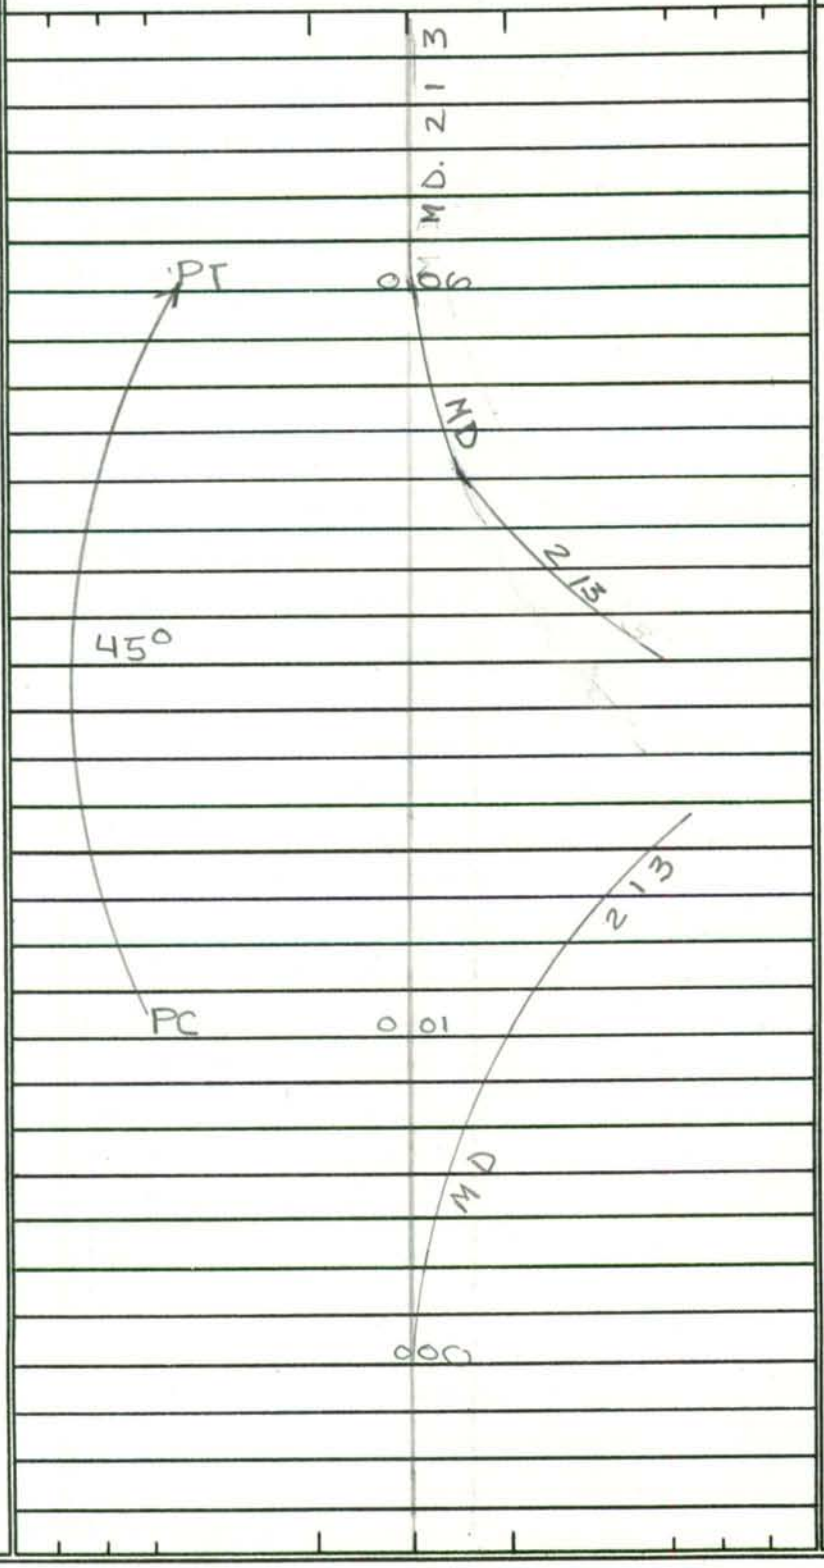

TRAFFIC: CONTROL | COM/IND. ACCESS | PRKG. REST.

PAVEMENT DATA

NON FA
RURAL LOCAL

13'H
3'JSHD LT
2 UNL

TRAFFIC CODES
TRAFFIC CONTROLS: STOP SIGN=SS, TRAFFIC LIGHT=T.L., FLASHING RED BALL=F.R.

TRAFFIC CODES
PARKING RESTRICTIONS: A.M. PEAK, P.M. PEAK, A.M./P.M. PEAK, NO PARKING ANYTIME=N.P., COMM/IND. ACCESS=E

SYSTEM				TRAFFIC		LINE DIAGRAM	TRAFFIC			PAVEMENT DATA
FED. AID.	FUNCT. CLASS.	HWY. SYS.	HPMS SAMPLE	PRKG. REST.	COM/IND ACCESS		CONTROL	COM/IND ACCESS	PRKG. REST.	

SHA 51.3 - 8 Revised
4.83

MARYLAND STATE HIGHWAY ADMINISTRATION

ROAD INVENTORY SHEET

'95 ST. RI.
6-6-95
TM/BB

SR.00
H-26-00
GD/EF

Party Chief: C. G
Recorder: L W
Assistant:
Map No./Dir.: / N
State Coordinates: 1067¾ - 521 ¾

Road No.: MD 855 A
Road Name:
County: KENT
Date: 6 - 14 - 89
Sheet No.: 1 OF 1

TRAFFIC CODES
TRAFFIC CONTROLS: STOP SIGN=SS, TRAFFIC LIGHT=T.L., FLASHING RED BALL=F.R.

TRAFFIC CODES
PARKING RESTRICTIONS: A.M. PEAK, P.M. PEAK, A.M./P.M. PEAK, NO PARKING ANYTIME=N.P., COMM/IND. ACCESS=E

SYSTEM				TRAFFIC		LINE DIAGRAM	TRAFFIC			PAVEMENT DATA
FED. AID.	FUNCT. CLASS.	HWY. SYS.	HPMS SAMPLE	PRKG. REST.	COM/IND. ACCESS		CONTROL	COM/IND. ACCESS	PRKG. REST.	
	NON FA RURAL LOCAL									15'H G 2-4'-J SHD 2UML

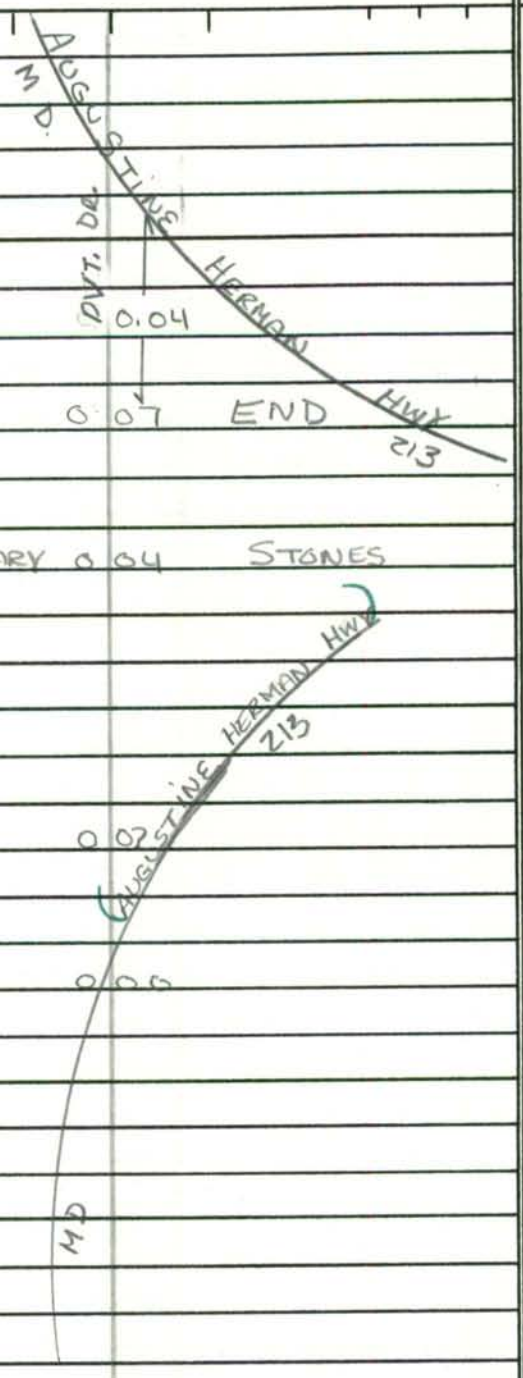

SYSTEM				TRAFFIC		LINE DIAGRAM	TRAFFIC			PAVEMENT DATA
FED. AID.	FUNCT. CLASS.	HWY. SYS.	HPMS SAMPLE	PRKG. REST.	COM/IND ACCESS		CONTROL	COM/IND ACCESS	PRKG. REST.	

SHA 51.3 - 8 Revised
4.83

MARYLAND STATE HIGHWAY ADMINISTRATION

'95 STATE
REINVENTORY
6-6-95
TM18B

ROAD INVENTORY SHEET

SR.00
H-25-00
60/EF

Party Chief C G
Recorder L. W
Assistant
Map No./Dir. D-15 / NE
State Coordinates 1065¼ - 534½

Road No. MD 856
Road Name (OLD SECT. MD. 298)
County KENT
Date 6 - 14 - 89
Sheet No. 1 OF 1

TRAFFIC CODES
TRAFFIC CONTROLS: STOP SIGN=SS, TRAFFIC LIGHT=T.L., FLASHING RED BALL=F.R.

TRAFFIC CODES
PARKING RESTRICTIONS: A.M. PEAK, P.M. PEAK, A.M./P.M. PEAK, NO PARKING ANYTIME=N.P., COMM/IND. ACCESS=E

SYSTEM				TRAFFIC		LINE DIAGRAM	TRAFFIC			PAVEMENT DATA
FED. AID.	FUNCT. CLASS.	HWY. SYS.	HPMS SAMPLE	PRKG. REST.	COM/IND. ACCESS		CONTROL	COM/IND. ACCESS	PRKG. REST.	

SYSTEM				TRAFFIC		LINE DIAGRAM	TRAFFIC			PAVEMENT DATA
FED. AID.	FUNCT. CLASS.	HWY. SYS.	HPMS SAMPLE	PRKG. REST.	COM/IND ACCESS		CONTROL	COM/IND ACCESS	PRKG. REST.	

SHA 51.3 - 8 Revised
4.83

MARYLAND STATE HIGHWAY ADMINISTRATION

ROAD INVENTORY SHEET

Party Chief _____
Recorder _____
Assistant _____
Map No./Dir. 1
State Coordinates _____

Road No. MD 857
Road Name _____
County Kent
Date _____
Sheet No. _____ OF _____

SYSTEM				TRAFFIC		LINE DIAGRAM	TRAFFIC			PAVEMENT DATA
FED. AID.	FUNCT. CLASS.	HWY. SYS.	HPMS SAMPLE	PRK.G. REST.	COM/IND. ACCESS		CONTROL	COM/IND. ACCESS	PRK.G. REST.	
						UNASSIGNED Now Co 309 87-52 (Co. IMP.) TRANSFER LETTER 12-1-87				

TRAFFIC CODES

TRAFFIC CONTROLS: STOP SIGN=SS, TRAFFIC LIGHT=T.L., FLASHING RED BALL=F.R.

TRAFFIC CODES

PARKING RESTRICTIONS: A.M. PEAK, P.M. PEAK, A.M./P.M. PEAK, NO PARKING ANYTIME=N.P., COMM/IND. ACCESS=E

SYSTEM				TRAFFIC		LINE DIAGRAM	TRAFFIC				PAVEMENT DATA
FED. AID.	FUNCT. CLASS.	HWY. SYS.	HPMS SAMPLE	PRKG. REST.	COM/IND ACCESS		CONTROL	COM/IND ACCESS	PRKG. REST.		

SHA 51.3 - 8 Revised
4.83

MARYLAND STATE HIGHWAY ADMINISTRATION

ROAD INVENTORY SHEET

Party Chief _____
Recorder _____
Assistant _____
Map No./Dir. 1
State Coordinates _____

Road No. MD 859B
Road Name _____
County KENT
Date _____
Sheet No. _____ OF _____

SYSTEM				TRAFFIC		LINE DIAGRAM	TRAFFIC			PAVEMENT DATA
FED. AID.	FUNCT CLASS.	HWY. SYS.	HPMS SAMPLE	PRK.G. REST.	COM/IND. ACCESS		CONTROL	COM/IND. ACCESS	PRK.G. REST.	
						UNASSIGNED Now 6316 TRANSFER LETTER 12-1-87 87-63				

TRAFFIC CODES

TRAFFIC CONTROLS: STOP SIGN=SS,
TRAFFIC LIGHT=T.L.,
FLASHING RED BALL=F.R.

TRAFFIC CODES

PARKING RESTRICTIONS: A.M. PEAK,
P.M. PEAK, A.M./P.M. PEAK, NO PARKING
ANYTIME=N.P., COMM/IND. ACCESS=E

SYSTEM				TRAFFIC		LINE DIAGRAM	TRAFFIC				PAVEMENT DATA
FED. AID.	FUNCT. CLASS.	HWY. SYS.	HPMS SAMPLE	PRKG. REST.	COM/IND ACCESS		CONTROL	COM/IND ACCESS	PRKG. REST.		

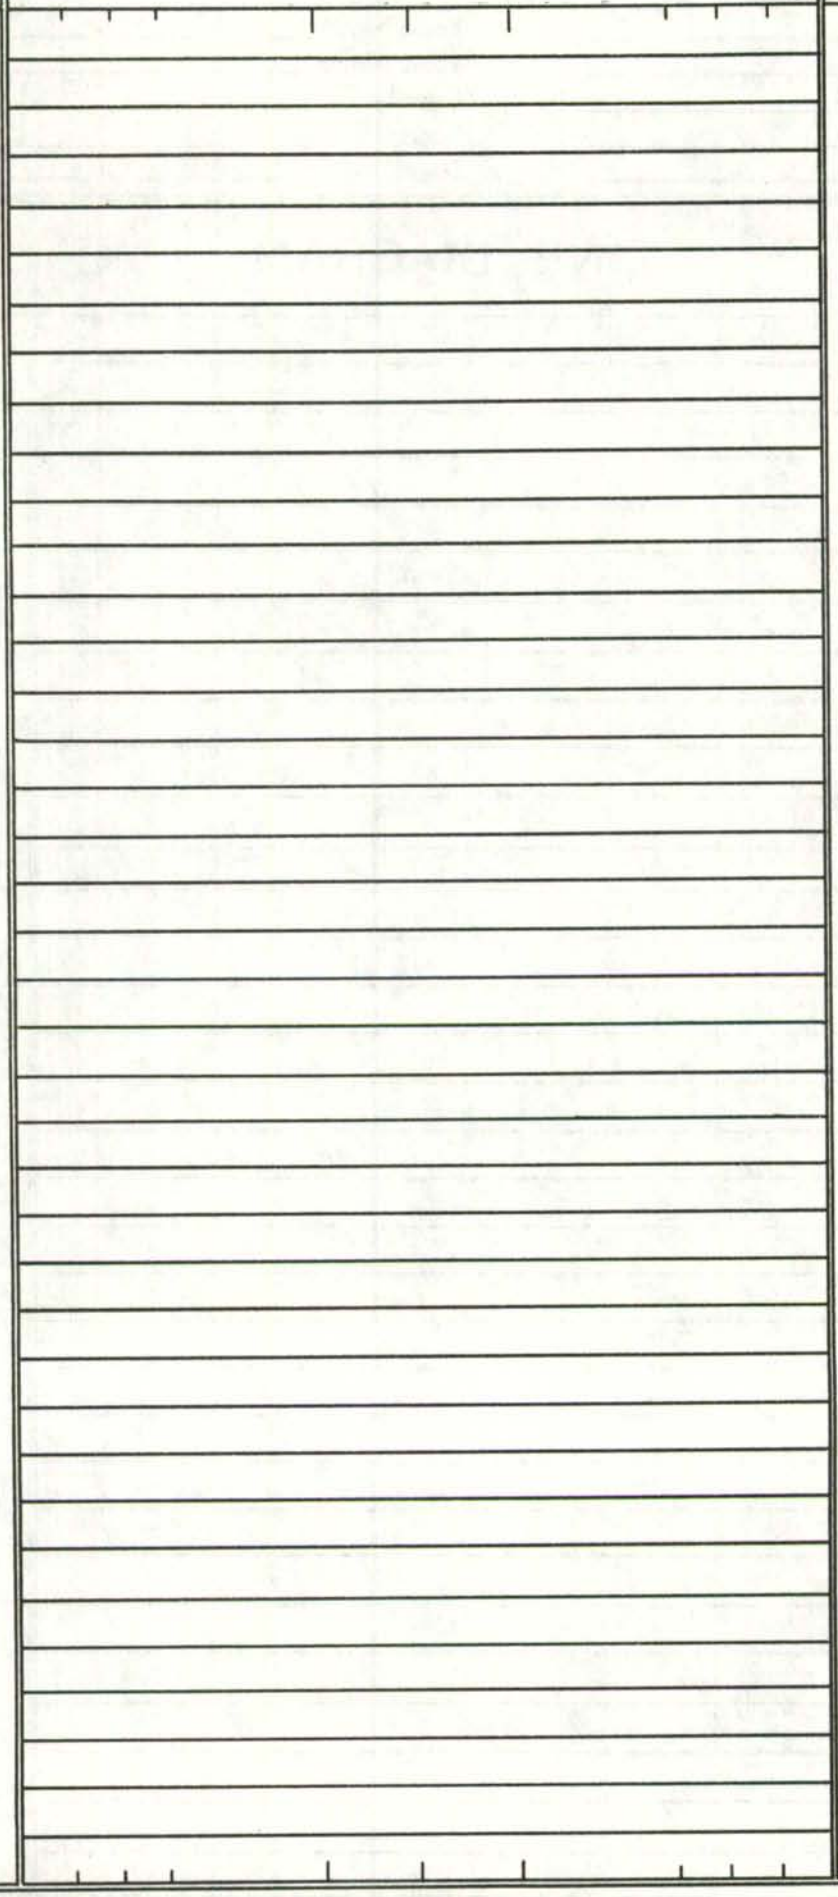

SHA 51.3 - 8 Revised
4.83

MARYLAND STATE HIGHWAY ADMINISTRATION

ROAD INVENTORY SHEET

Party Chief _____
Recorder _____
Assistant _____
Map No./Dir. 1
State Coordinates _____

Road No. MD 859C
Road Name _____
County Kent
Date _____
Sheet No. _____ OF _____

SYSTEM				TRAFFIC		LINE DIAGRAM	TRAFFIC			PAVEMENT DATA
FED. AID.	FUNCT CLASS.	HWY. SYS.	HPMS SAMPLE	PRKG. REST.	COM/IND. ACCESS		CONTROL	COM/IND. ACCESS	PRKG. REST.	
						UNASSIGNED Now MV 0183 Chestertown TRANSFER LETTER 8-11-78				

TRAFFIC CODES

TRAFFIC CONTROLS: STOP SIGN=SS, TRAFFIC LIGHT=T, L., FLASHING RED BALL=F, R.

TRAFFIC CODES

PARKING RESTRICTIONS: A.M. PEAK, P.M. PEAK, A.M./P.M. PEAK, NO PARKING ANYTIME=N.P., COMM/IND. ACCESS=E

SYSTEM				TRAFFIC		LINE DIAGRAM	TRAFFIC			PAVEMENT DATA
FED. AID.	FUNCT. CLASS.	HWY. SYS.	HPMS SAMPLE	PRKG. REST.	COM/IND ACCESS		CONTROL	COM/IND ACCESS	PRKG. REST.	

'95 STATE REINVENTORY
6-6-95 TM/BB

SHA 51.3 - 8 Revised
4.83

MARYLAND STATE HIGHWAY ADMINISTRATION

ROAD INVENTORY SHEET

SR.00
4-27-00
GD/EF

Party Chief: CG
Recorder: L.W
Assistant:
Map No./Dir.: / N
State Coordinates: 1066 -547

Road No.: MD 864
Road Name: (OLD SECT. MD 292)
County: KENT
Date: 6-19-89
Sheet No.: 1 OF 1

SYSTEM: FED. AID. | FUNCT. CLASS. | HWY. SYS. | HPMS SAMPLE
TRAFFIC: PRK.G. REST. | COM/IND. ACCESS

LINE DIAGRAM

TRAFFIC: CONTROL | COM/IND. ACCESS | PRK.G. REST.

PAVEMENT DATA

TRAFFIC CODES
TRAFFIC CONTROLS: STOP SIGN=SS, TRAFFIC LIGHT=T.L., FLASHING RED BALL=F.R.

TRAFFIC CODES
PARKING RESTRICTIONS: A.M. PEAK, P.M. PEAK, A.M./P.M. PEAK, NO PARKING ANYTIME=N.P., COMM/IND. ACCESS=E

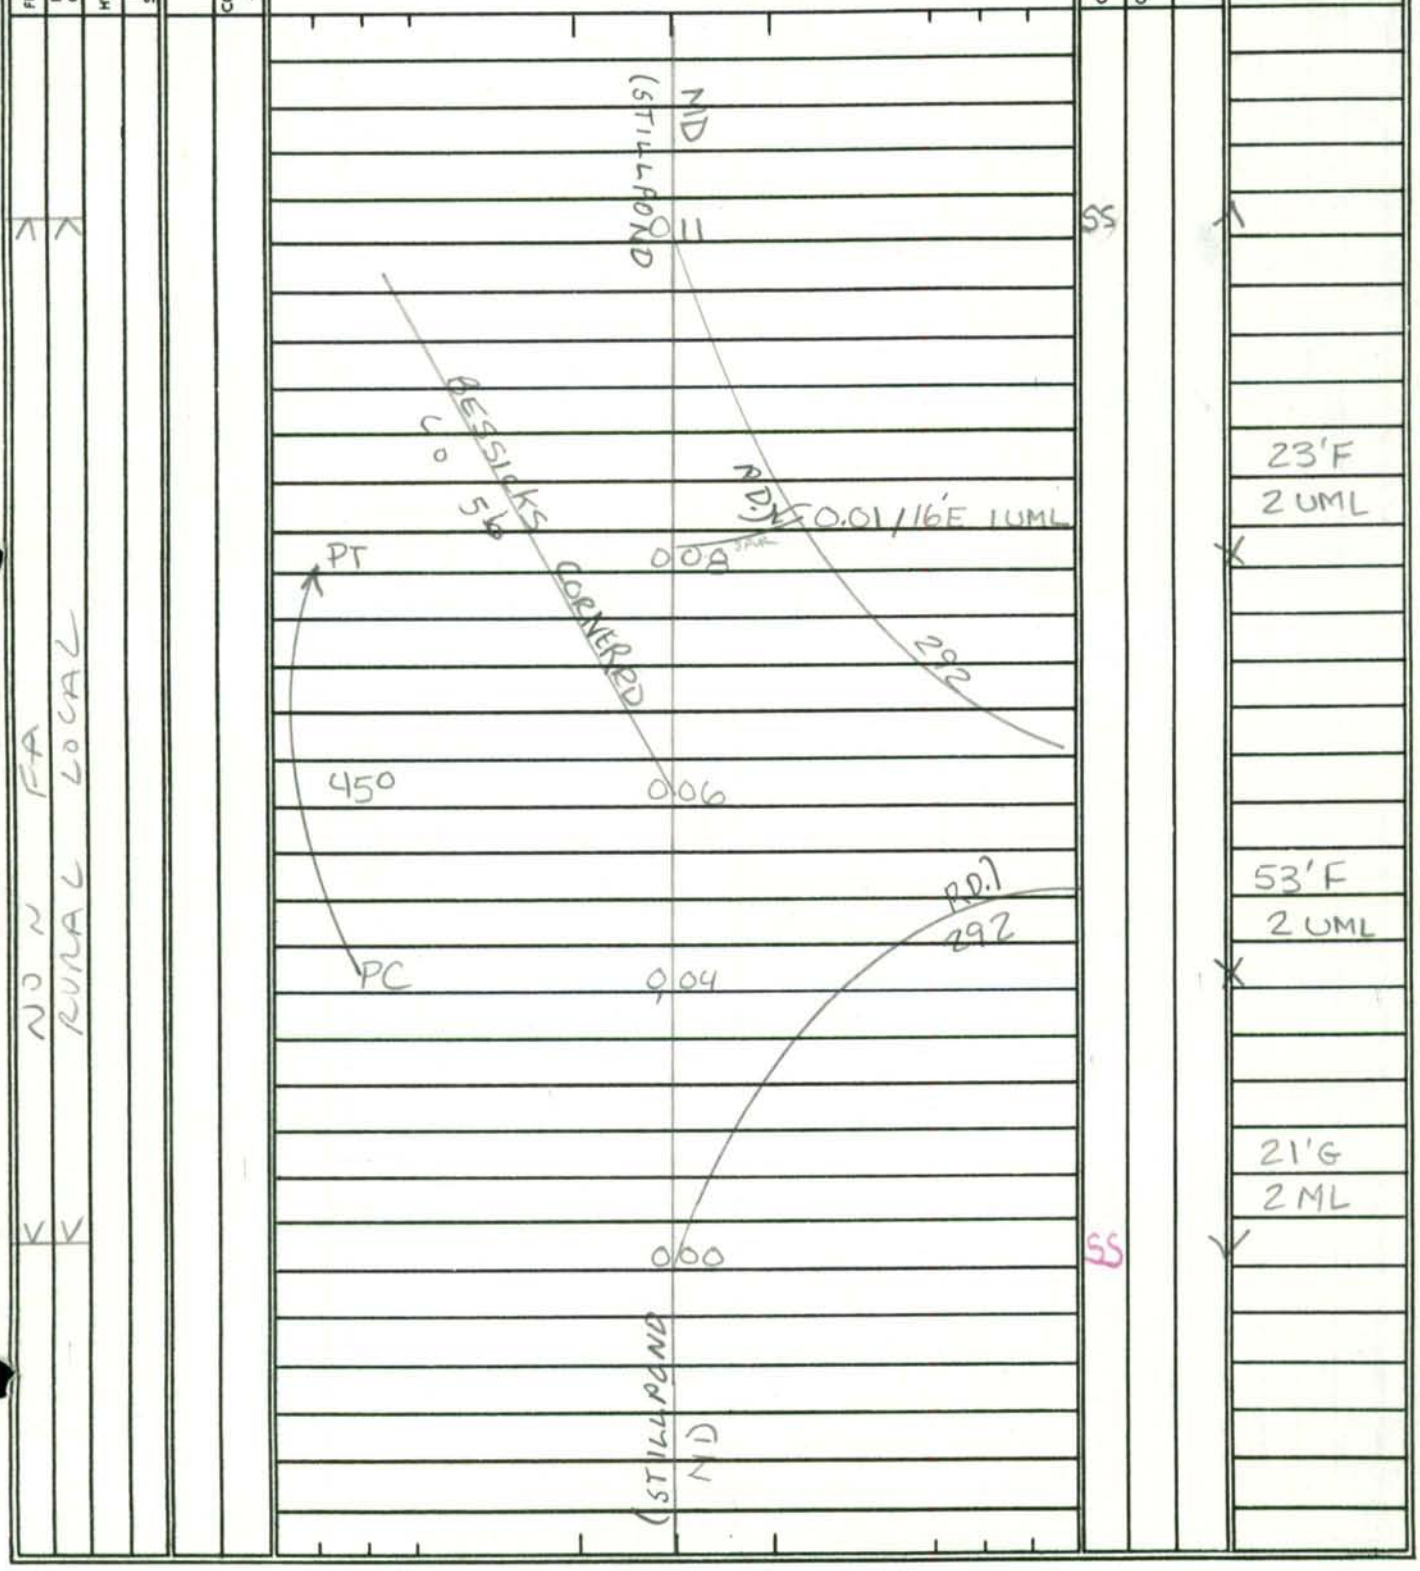

SYSTEM				TRAFFIC		LINE DIAGRAM	TRAFFIC			PAVEMENT DATA
FED. AID.	FUNCT. CLASS.	HWY. SYS.	HPMS SAMPLE	PRKG. REST.	COM/IND ACCESS		CONTROL	COM/IND ACCESS	PRKG. REST.	