WASHINGTON COUNTY
HAGERSTOWN ALLEYS

Form 6 HPS (Rev. 1961)

1176 +

A/T

ROAD INVENTORY SHEET

Party Chief	R. VOUGHT	Road No.	~~6010~~ 5010
Recorder	L. COFFELT JR.	Name	ALLEY #1
Chainman		Sheet No.	1 OF 1
	HAGERSTOWN	Date	10-28-63
		County	WASHINGTON

VER 7-19-70

ALLEY #225

MUN 008 7250

9' J
12' CW

CONNECTICUT AVE

MUN 000 530

Form 6 HPS (Rev. 1961)

AT

ROAD INVENTORY SHEET

5020

Party Chief R. VOUGHT
Recorder L. COFFELT JR.
Chainman

HAGERSTOWN

VER 7-20-76

Road No. ~~6020~~
Name ALLEY #2
Sheet No. 1 OF 1
Date 11-12-63
County WASHINGTON

S. Poromac		ST	
MUN	004	20085	
			8'J
Alley		4	10'cu
MUN	000	5040	

Form 6 HPS (Rev. 1961)

87-17A/T ✓ AT

ROAD INVENTORY SHEET

5030

Party Chief	R. VOUGHT	Road No.	~~6030~~
Recorder	L. COFFELT JR.	Name	ALLEY #3
Chainman		Sheet No.	1 OF 1
		Date	11-12-63
HAGERSTOWN	VER 7-20-76	County	WASHINGTON

Road End

0 20

12'E

Alley #~~5B~~ 14 16'CW

MUN 0 19 5140

0 16 35°

Alley #~~3A~~ 6

MUN 5060 0 14

Ray ST

MUN 0 11 2080

Alley #171

MUN 6710 0 08

H 18'

80-18

Elm ST

MUN 0 06 750

Alley #172

MUN 6720 0 03 8'J

E. Lee ST 10'CW

MUN ← 0 00 ← 1360

Form 6 HPS (Rev. 1961)

AT

ROAD INVENTORY SHEET

Party Chief	R. VOUGHT	Road No.	~~6040~~ 5040
Recorder	L. COFFELT JR.	Name	ALLEY #4
Chainman		Sheet No.	1 OF 1
	HAGERSTOWN VER. 7-20-76	Date	11-12-63
		County	WASHINGTON

Road.	End		
0	17		
ALLEY #2			
MUN 5020	0 13		
			8'J
0	04	90°	12'CW
S.		Potomac St	
MUN	0 40	2005	

Locust St. Mu 1430

Form 6 HPS (Rev. 1961)

AT

ROAD INVENTORY SHEET

5050

Party Chief R. Vought
Recorder L. Coffelt, Jr.
Chainman

VER. 7-20-76

Road No. ~~6050~~
Name Alley 5
Sheet No. 1 of 1
Date 11-12-63
County Wash.

Alley 121 MUN 6210	004	
		8'J 10'CW.
S. Potomac MUN	000	20005 St.

Form 6 HPS (Rev. 1961)

AT

ROAD INVENTORY SHEET

Party Chief	R. VOUGHT	Road No.	~~6060~~ 5060
Recorder	L. COFFELT JR.	Name	ALLEY #6
Chainman		Sheet No.	1 OF 1
		Date	11-12-63
	HAGERSTOWN	County	WASHINGTON

VER 7-20-76

ALLEY 3

MUN 0-07 5030

8' I 80-17

8' J

10' CW

S. MULBERRY ST

MUN 0-00 1760

Form 6 HPS (Rev. 1961)

AT

ROAD INVENTORY SHEET

Party Chief	R. VOUGHT	Road No.	~~6070~~ 5070
Recorder	L. COFFELT JR.	Name	ALLEY #7
Chainman		Sheet No.	1 OF 1
		Date	11-13-63
HAGERSTOWN	VER 7-20-76	County	WASHINGTON

S Potomac ST

MUN 0 06 2005

59-41
8'5 100

8'E

Rochester PL

10'CW

MUN 0 00 2130

*Erroneously abandoned during 02-6PS. GPS shows Alley still exists.

SHA 51.3 - 8 Revised
4.83

MARYLAND STATE HIGHWAY ADMINISTRATION
HAGERSTOWN
ROAD INVENTORY SHEET

Party Chief: R. Vought
Recorder: L. Coffelt Jr.
Assistant: Rewritten - JMK 1-15-03
Map No./Dir.: A-8 /
State Coordinates:

Road No.: Mu. 5080
Road Name: Alley 8
County: Washington
Date: 11-13-63
Sheet No. 1 OF 1

02-6PS

TRAFFIC CODES
TRAFFIC CONTROLS: STOP SIGN-SS, TRAFFIC LIGHT=T.L., FLASHING RED BALL=F.R.

TRAFFIC CODES
PARKING RESTRICTIONS: A.M. PEAK, P.M. PEAK, A.M./P.M. PEAK, NO PARKING ANYTIME=N.P., COMM/IND. ACCESS=E

SYSTEM: FUNCT CLASS	SYSTEM: HWY. SYS.	SYSTEM: HPMS SAMPLE	TRAFFIC: PRKG. REST.	TRAFFIC: COM/IND. ACCESS	LINE DIAGRAM	TRAFFIC: CONTROL	TRAFFIC: COM/IND. ACCESS	TRAFFIC: PRKG. REST.	PAVEMENT DATA
					S. Potomac St.				
					Mu 0 06 2005				
									8' K
									8' CW
					0 03				
									10' J
									10' CW
					Alley #20				
					Mu 0 00 5200				

COUNTY _____ ROAD NO. _____ PAGE ___ OF ___

SYSTEM				TRAFFIC		LINE DIAGRAM	TRAFFIC				PAVEMENT DATA
	FUNCT. CLASS	HWY SYS	HPMS SAMPLE	PKG. REST.	COM/IND ACCESS		CONTROL	COM/IND ACCESS	PKG. REST.		

Form 6 HPS (Rev. 1961)

ROAD INVENTORY SHEET

5090

Party Chief R. VOUGHT
Recorder L. COFFELT JR.
Chainman
HAGERSTOWN

VEQ
7-20-76

Road No. ~~6090~~
Name ALLEY #9
Sheet No. 1 OF 1
Date 11-5-63
County WASHINGTON

MARKET			
ALLEY	005	19	(HAYS ALLEY)
MUN			9110
N. POTOMAC			ST
MUN	000	2095	

8.5
8.CW

AT

Form 6 HPS (Rev. 1961)

ROAD INVENTORY SHEET

Party Chief R. VOUGHT
Recorder L. COFFELT JR.
Chainman

HAGERSTOWN

VER 7-20-76

Road No. ~~6120~~ 5120
Name ALLEY #12
Sheet No. 1 OF 1
Date 10-29-63
County WASHINGTON

WASHINGTON		AVE EAST →
US	0.14	40
		ALLEY #40
	0.10	MUN 5400
DALE		ST
MUN →	0.07	→ 610
	0.102	ALLEY #39
	0.05	MUN 5390
ALLEY #37		
MU 5370	0.03	
W. WASHINGTON		ST
MUN ~~DR.~~	0.00 2300	~~DR.~~

8'S
10'CW

Form 6 HPS (Rev. 1961)

A1 ✓

ROAD INVENTORY SHEET

Party Chief R. VOUGHT
Recorder L. COFFELT JR.
Chainman

HAGERSTOWN

VER 7-20-76

Road No. ~~6130~~ 5130
Name ALLEY #13
Sheet No. 1 OF 1
Date 10-29-63
County WASHINGTON

W. WASHINGTON ST
MUN ~~BAT.~~ 007 2500 ~~BAT.~~

ALLEY #39
003 MUN 5340

DALE ST
000 MUN 610

NORTH

8'J
2-2' KNDRS
14' CW

Form 6 HPS (Rev. 1961)

ROAD INVENTORY SHEET

5140 ✓ AT

Party Chief R. VOUGHT
Recorder L. COFFELT JR.
Chainman

HAGERSTOWN

VER. 7-20-76

Road No. ~~6140~~
Name ALLEY #14
Sheet No. 1 OF 1
Date 11-12-63
County WASHINGTON

S. Mulberry St.		
MUN 1760	010	
Alley	#3	
MUN	004 5030	
S. Potomac	St	8'J
MUN	000 20005	10'CW

Hagerstown Urban

SHA 51.3 - 8 Revised
4.83

MARYLAND STATE HIGHWAY ADMINISTRATION

Ver. 7-20-76

ROAD INVENTORY SHEET

Party Chief R. Vought
Recorder L. Coffelt
Assistant Rewritten 12/30/94 KJP
Map No./Dir. / S
State Coordinates

Road No. Mu 5170
Road Name Alley #17
County Washington
Date 11-5-63
Sheet No. 1 OF 1

94 Mu. Ex # 1 - 12/9/94

TRAFFIC CODES
TRAFFIC CONTROLS: STOP SIGN=SS, TRAFFIC LIGHT=T.L., FLASHING RED BALL=F.R.

TRAFFIC CODES
PARKING RESTRICTIONS: A.M. PEAK, P.M. PEAK, A.M./P.M. PEAK, NO PARKING ANYTIME=N.P., COMM/IND. ACCESS=E

SYSTEM: FED. AID.	SYSTEM: FUNCT. CLASS.	SYSTEM: HWY. SYS.	SYSTEM: HPMS SAMPLE	TRAFFIC: PRKG. REST.	TRAFFIC: COM/IND. ACCESS	LINE DIAGRAM	TRAFFIC: CONTROL	TRAFFIC: COM/IND. ACCESS	TRAFFIC: PRKG. REST.	PAVEMENT DATA
						Hagerstown				
						(Court PL.) Mu 0765				
						W. Washington ST				
						US 0 10 40 @35.97				8' J
						0 09				
										8' G
						(Wareham PL #2)				8' CW
						Mu 0 05 2492 @.08	SS			
						Alley #18				
						0 03 Mu 5180 @.00				
										8' I
						E. Franklin ST				12' CW
						US 0 00 40 WB/L @.76				

SYSTEM				TRAFFIC		LINE DIAGRAM	TRAFFIC			PAVEMENT DATA
FED. AID.	FUNCT. CLASS.	HWY. SYS.	HPMS SAMPLE	PRKG. REST.	COM/IND ACCESS		CONTROL	COM/IND ACCESS	PRKG. REST.	

Form 6 HPS (Rev. 1961)

✓ RT

ROAD INVENTORY SHEET

Party Chief	R. VOUGHT	Road No.	~~6180~~ 5180
Recorder	L. COFFELT JR.	Name	Alley # 18
Chainman		Sheet No.	1 OF 1
	VER 7-20-76	Date	11-5-63
		County	WASHINGTON

JONATHAN ~~SUMMIT~~ ~~JONATHAN~~ ~~AVE~~ ST

MUN 0.03 ~~8300~~ 1230

@.07

10'J

12'CW

ALLEY #17

MUN 0.00 5170

@.03

Form 6 HPS (Rev. 1961)

A

ROAD INVENTORY SHEET

Party Chief R. Vought
Recorder L. Coffelt, Jr
Chainman

Road No. ~~6200~~ 5200
Name Alley 20
Sheet No. 1 of 1
Date 11-13-63
County Wash.

VER. 7-20-76

CRAMERS ALLEY
MU 9070

E. Franklin St.
← East US 0 34 40

67-37 8'J 12'CW

031 Alley #23
0 29

one way
ONE WAY
ONE WAY

E. Washington St.
U.S. 0 23 40 EAST →

Mathews Ave.
0 18 MUN 1560

~~Alley #8~~
~~MUN 5000~~ 0 17

8'J 70-36

10'H
12'CW

E. Antietam St.
MUN 0 12 30

Bixler's Alley
0 07 MUN 9020

8'J 70-35

8'J
10'C.W.

0 04

10'J
12'CW.

E. Baltimore St.
MUN 0 00 0090
US 40 ALT

M

Form 6 HPS (Rev. 1961)

ROAD INVENTORY SHEET

Party Chief R. VOUGHT

Recorder L. COFFELT JR.

Chainman

HAGERSTOWN

VER. 7-20-76

Road No. ~~6210~~ 5210

Name ALLEY #21

Sheet No. 1 OF 1

Date 11-5-63

County WASHINGTON

E. FRANKLIN	ST
← WEST US 000 5	40
ALLEY	~~#21A~~ 23
MUN 000	5230

8'J
12'CW

Form 6 HPS (Rev. 1961)

AT

ROAD INVENTORY SHEET

5220

Party Chief	R. VOUGHT	Road No.	~~6220~~
Recorder	L. COFFELT JR.	Name	ALLEY #22
Chainman		Sheet No.	1 OF 1
	VER 7-20-76	Date	11-25-63
		County	WASHINGTON

W. WASHINGTON ST		
US 012	40 EAST	
		8'J
E. ANTIETAM ST		12'CW
MV 000	0030	

Form 6 HPS (Rev. 1961)

M

ROAD INVENTORY SHEET

5230

Party Chief ~~R. VOUGHT~~
Recorder
Chainman ~~L. COFFELT~~ JR.

VER. 7-20-76

HAGERSTOWN

Road No. ~~6230~~
Name ALLEY # 23
Sheet No. 1 OF 1
Date 10-5-63
County WASHINGTON

ALLEY ~~CRAMER~~		#20 ~~ALLEY~~	
MUN →	0.30	5200 ONE WAY	
			8' J 12' CW
	0.22		
N. LOCUST		ST	
MUN	0.20	1430 ONEWAY →	12' J 14' CW
N. MULBERRY		ST	
← ONEWAY MUN	0.10	1760	
		ALLEY #21	
	0.06		
ALLEY #24			
MUN 5210	0.05		8' J 12' CW
N. CANNON		~~ST~~ AVE	
MU	0.00	0330	

Form 6 HPS (Rev. 1961)

ROAD INVENTORY SHEET

Party Chief R. VOUGHT
Recorder L. COFFELT JR.
Chainman

HAGERSTOWN

VER 7-20-76

Road No. ~~6240~~ 5240
Name ALLEY # 24
Sheet No. 1 OF 1
Date 11-5-63
County WASHINGTON

ALLEY			~~#21-A~~ 23	
MUN		0.05	5230	
~~#~~ WASHINGTON			ST	
MUN	US	0.00	5210	40 ~~EAST~~

8'J
12'CW

Form 6 HPS (Rev. 1961)

AT ✓

ROAD INVENTORY SHEET

Party Chief R. VOUGHT
Recorder L. COFFELT JR.
Chainman

VER. 7-19-76

HAGERSTOWN

Road No. ~~6250~~ 5250
Name ALLEY #25
Sheet No. 1 OF 1
Date 10-23-63
County WASHINGTON

A/T 84-14

← EAST WASHINGTON	ST
MUN US 0 32	3210 40
W. FRANKLIN	ST
US 0 26	40 → WEST
W. CHURCH	ST
MUN 0 12	0440
SALEM	AVE
MUN MD. 0 00	2200 58

8'J
12'CW

AT

Form 6 HPS (Rev. 1961)

ROAD INVENTORY SHEET

Party Chief	R. VOUGHT	Road No.	~~6260~~ 5260
Recorder	L. COFFELT JR.	Name	ALLEY #26
Chainman		Sheet No.	1 OF 1
	VER	Date	10-29-63
HAGERSTOWN	7-19-76	County	WASHINGTON

WASHINGTON ST 033 ST
US 40 MUN 2510 40 EAST ←
W. FRANKLIN ST
US 027 40 WEST
OXFORD CIRCLE
AVON RD
MU 1895

8'I
11'CW
82-19

W. CHURCH ST
MUN 013 440
8'J
11'CW

SALEM AVE
MUN md 000 2200 58

AT ✓

Form 6 HPS (Rev. 1961)

ROAD INVENTORY SHEET

Party Chief R. VOUGHT
Recorder L. COFFELT JR.
Chainman

VER. 7-19-76

HAGERSTOWN

Road No. ~~6270~~ 5270
Name ALLEY #27
Sheet No. 1 OF 1
Date 10-29-63
County WASHINGTON

ALLEY	# 37
MUN 0/2	5370
0/03	30°
EAST WASHINGTON	ST
MUN DS 000	2370 40

8'J
12'CW

AT

Form 6 HPS (Rev. 1961)

ROAD INVENTORY SHEET

Party Chief R. VOUGHT
Recorder L. COFFELT JR.
Chainman

VER
HAGERSTOWN 7-19-76

Road No. ~~6280~~ 5280
Name ALLEY #28
Sheet No. 1 OF 1
Date 10-29-63
County WASHINGTON

BERNER AVE
MUN 005 140

ALLEY #38
004 MUN 5380

AVALON
MU-0060
000 AVE

8 'J
10 'CW

AT ✓

Form 6 HPS (Rev. 1961)

ROAD INVENTORY SHEET

Party Chief R. VOUGHT
Recorder L. COFFELT JR.
Chainman
HAGERSTOWN VED 7-20-76

Road No. ~~6290~~ 5290
Name ALLEY #29
Sheet No. 1 OF 1
Date 10-30-63
County WASHINGTON

WINTER ST.		
MUN	006	2610
190°	003	
(WAREHAM PL)		
MUN	000	2490

8'J
11'CW

AT

Form 6 HPS (Rev. 1961)

ROAD INVENTORY SHEET

Party Chief R. VOUGHT
Recorder L. COFFELT JR.
Chainman

HAGERSTOWN

VER. 7-20-76

Road No. ~~6300~~ 5300
Name ALLEY #30
Sheet No. 1 OF 1
Date 10-30-63
County WASHINGTON

HIGH			ST
MUN	0	14	1030
(ALLEY 271) MV 7710 Ames (80-17)	0	10	ST
MUN ←	0	08	← 1200
ALLEY			#60
MUN →	0	05	→ 5600
NORWAY			ST
MUN →	0	03	1820 →
ALLEY			#48
MUN	0	00	5480

8'J
12'CW

Form 6 HPS (Rev. 1961)

ROAD INVENTORY SHEET

Party Chief R. VOUGHT
Recorder L. COFFELT JR.
Chainman
HAGERSTOWN

VER 7-20-76

Road No. ~~6310~~ 5310
Name ALLEY #31
Sheet No. 1 OF 1
Date 10-29-63
County WASHINGTON

ROAD END
0 18

PARK ~~LA~~ AVE
CO ~~MUN~~ 0 08 ~~LA~~ 477

N MONT VALLA Ave
mv 000 ~~1270~~ 1730

OP 196

8' F
12' CW

8' J
12' CW

8' H
80-10

Form 6 HPS (Rev. 1961)

AT

ROAD INVENTORY SHEET

Party Chief R. VOUGHT
Recorder L. COFFELT JR.
Chainman

HAGERSTOWN

VER
7-20-76

Road No. ~~6320~~ 5320
Name ALLEY #32
Sheet No. 1 OF 1
Date 10-30-63
County WASHINGTON

BURHAN'S		BLVD
~~MUN~~ US	0 10	~~500~~ 11
		8'J 10'CW
	0 04	
		8'K 10'CW
	0 02	
		8'J 10'CW
HIGH		ST
MUN ←	000	← 1030

Form 6 HPS (Rev. 1961)

ROAD INVENTORY SHEET

Party Chief R. VOUGHT
Recorder L. COFFELT JR.
Chainman

VER 7-20-76

HAGERSTOWN

Road No. ~~6330~~ 5330
Name ALLEY #33
Sheet No. 1 OF 1
Date 10-28-63
County WASHINGTON

WINTER	ST
MUN ← 0.10	← 26D
↑90° 0.09	
0.07	90°↑
ALLEY #34	
MUN 53D 0.05	
↑30° 0.03	8'J 10'CW
ALLEY	#62
MUN → 0.00	→ 56D

AT ✓

Form 6 HPS (Rev. 1961)

ROAD INVENTORY SHEET

Party Chief R. VOUGHT
Recorder L. SOFFELT JR.
Chainman

VER 7-20-76

HAGERSTOWN

Road No. ~~6340~~ 5340
Name ALLEY #34
Sheet No. 1 OF 1
Date 10-29-63
County WASHINGTON

ALLEY	#33
MUN 004	5330
130° 001	
W. WASHINGTON	ST
MUN ~~MA.~~ 000	2500 ~~MA~~

8'J
10'CW

Form 6 HPS (Rev. 1961)

AT

ROAD INVENTORY SHEET

Party Chief R. VOUGHT
Recorder L. COFFELT JR.
Chainman

VER
7-20-76

HAGERSTOWN

Road No. ~~6350~~ 5350
Name ALLEY #35
Sheet No. 1 OF 1
Date 10-29-63
County WASHINGTON

NOTTINGHAM RD
MUN 0.08 1830

8'J
12'CW

DEVONSHIRE Rd.
MUN 0.00 630

Form 6 HPS (Rev. 1961)

AT

ROAD INVENTORY SHEET

Party Chief R. VOUGHT
Recorder L. COFFELT JR.
Chainman

UEQ 7-19-76

HAGERSTOWN

Road No. ~~6370~~ 5370
Name Alley #37
Sheet No. 1 OF 1
Date 10-29-63
County WASHINGTON

WAKEFIELD	ROAD
MU 0 21	2460
~~ROAD END~~	
0 20	ENT School
AVALON	AVE
MUN 0 14	MU 0060
	ALLEY #38
0 10	MUN 5380
Beence	Ave.
→ 0 08	→ MU. 0140
	ALLEY #27
0 06	MUN 5270
West Side	Ave
MUN 0 04	2560
ALLEY	#12
MU 0 00	5120

S.J 10'CW

Form 6 HPS (Rev. 1961)

ROAD INVENTORY SHEET

5380

Party Chief R. VOUGHT
Recorder L. COFFELT JR.
Chainman

VER 7-19-76

HAGERSTOWN

Road No. ~~6380~~
Name ALLEY 38
Sheet No. 1 OF 1
Date 10-29-63
County WASHINGTON

ALLEY	#37
MUN 0.08	5370
ALLEY	#28
MUN 0.00	5280

8'J
10'CW

Form 6 HPS (Rev. 1961)

AT

ROAD INVENTORY SHEET

Party Chief R. VOUGHT
Recorder L. COFFELT JR.
Chainman

VER 7-20-76

HAGERSTOWN

Road No. ~~6390~~ 5390
Name ALLEY #39
Sheet No. 1 OF 1
Date 10-29-63
County WASHINGTON

Alley	#12
MUN 006	5120
Alley	#13
MUN 000	5130

10' J
16' CW

SHA 51.3-8
11-15-72

STATE HIGHWAY ADMINISTRATION OF MARYLAND

ROAD INVENTORY SHEET

Party Chief R Vought
Recorder L Cottelt JR
Helper

Map No.
Rewrit 11-23-81
VER 7-20-76

Road No. 5400
Road Name ALLEY #40
Sheet No. 1 of 1
Date 10-29-63
County WASH
State Coordinates

HAGERSTOWN

ALLEY 12
MUN 006 5120

ALEXANDER ST
→ MUN 002 0020 →

8' J
10' CW

ROAD 600 END

SHA 51.3-8
11-15-72

ROAD INVENTORY SHEET

Road No. _____
Road Name _____
Sheet No. _____
Date _____
County _____
State Coordinates _____

Form 6 HPS (Rev. 1961)

✓ AT

ROAD INVENTORY SHEET

Party Chief R. VOUGHT
Recorder L. COFFELT JR.
Chainman

HAGERSTOWN

VER 7-20-76

Road No. ~~6410~~ 5410
Name ALLEY # 41
Sheet No. 1 OF 1
Date 10-30-63
County WASHINGTON

West Side	Ave
MUN 0	08 2560
ALEXANDER	ST
MUN → 0	00 → 0020

8 J
12 CW

✓ AT

Form 6 HPS (Rev. 1961)

ROAD INVENTORY SHEET

Party Chief R. VOUGHT
Recorder L. COFFELT JR.
Chainman
T. LANDON
F. RHODES
2/20/75 REVISED

VER. 7-19-76

HAGERSTOWN

Road No. ~~6420~~ 5420
Name ALLEY #42
Sheet No. 1 OF 1
Date 10-29-63
County WASHINGTON

ALEXANDER ST
MUN ← 0 07 0020 ←

ALLEY #43
MUN 5430 0 05

WEST SIDE AVE
MUN 0 00 2560

8' JI
10' CW
~~9' J~~
~~8' H~~
~~12' CW~~
82-21

/ AT

Form 6 HPS (Rev. 1961)

ROAD INVENTORY SHEET

Party Chief R. VOUGHT
Recorder L. COFFELT JR.
Chainman

VER. 7-19-76

HAGERSTOWN

Road No. ~~6430~~ 5430
Name ALLEY #43
Sheet No. 1 OF
Date 10-29-63
County WASHINGTON

ALLEY	#42
MUN 0.21 5420	
W. CHURCH	ST
MUN ← 0.11	← 440
ALLEY #44	
MUN 5440 0.03	
SALEM	AVE
MUN Md 0.00 5200	58

8.5
11'CW

Form 6 HPS (Rev. 1961)

ROAD INVENTORY SHEET

Party Chief R. VOUGHT
Recorder L. COFFELT JR.
Chainman

HAGERSTOWN

VER. 7-20-76

Road No. ~~6440~~ 5440
Name ALLEY #44
Sheet No. 1 OF 1
Date 10-30-63
County WASHINGTON

WINTER	ST
MUN → 0.09	→ 2610
ALEXANDER	ST
MUN ← 0.03	← 20
ALLEY	#43
MUN 0.00	5430

8' J
11' CW

Form 6 HPS (Rev. 1961)

AT

ROAD INVENTORY SHEET

Party Chief R. VOUGHT
Recorder L. COFFELT JR.
Chainman

HAGERSTOWN

VER 7-20-76

Road No. ~~6450~~ 5450
Name ALLEY #45
Sheet No. 1 OF 1
Date 10-30-63
County WASHINGTON

WINTER ST.
MUN → 0.07 → 2610

8'J
12'CW

ALEXANDER ST.
← MUN 0.00 0020 ←

Form 6 HPS (Rev. 1961)

DT ✓

ROAD INVENTORY SHEET

Party Chief R. VOUGHT
Recorder L. COFFELT JR.
Chainman

VER 7-20-76

HAGERSTOWN

Road No. ~~6460~~ 5460
Name ALLEY #46
Sheet No. 1 OF 1
Date 10-30-63
County WASHINGTON

BURHANS		BLVD
~~MUN~~ US	0.34	~~300~~ 11
HIGH		ST
MUN	0.24	1030
ALLEY		#53
MUN	0.21	5530
WINTER		ST
MUN	0.08	2610
ALEXANDER		ST
MUN.	0.00	0020

8'J
10'CW

Form 6 HPS (Rev. 1961)

AT

ROAD INVENTORY SHEET

Party Chief R. VOUGHT
Recorder L. COFFELT JR.
Chainman

VER
7-20-76

HAGERSTOWN

Road No. ~~6470~~ 5470
Name ALLEY #47
Sheet No. 1 OF 1
Date 10-30-63
County WASHINGTON

Alley		# 58
	0.22	
	~~Road Ext.~~	
	0.20	
WISE		ST
MUN	0.16	2620
WINTER		ST
MUN	0.08	2610
	0.03	
ALEXANDER		ST
MUN	0.00	0020

67-29 8'J 10'CW

8'E 10'CW

8'J 10'CW

67-31 8'J 10'CW

8'G 10'CW

8'J 10'CW

Form 6 HPS (Rev. 1961)

AT

ROAD INVENTORY SHEET

Party Chief R. VOUGHT
Recorder L. COFFELT JR.
Chainman

HAGERSTOWN

VER 7-20-76

Road No. ~~6400~~ 5480
Name ALLEY #48
Sheet No. 1 OF 1
Date 10-30-63
County WASHINGTON

W. CHURCH ST
MUN ← 0.11 ← 440
ALLEY #30
MUN 5200 0.08
ALLEY #49
MUN 5490 0.03
SALEM AVE
MU 2200

8'J
10'CW

Form 6 HPS (Rev. 1961)

AT

ROAD INVENTORY SHEET

Party Chief R. VOUGHT
Recorder L. COFFELT JR.
Chainman

HAGERSTOWN

VED 7-20-76

Road No. ~~6490~~ 5490
Name ALLEY #49
Sheet No. 1 OF 1
Date 10-30-63
County WASHINGTON

ALLEY #48
MUN 0.03 5480

NORWAY AVE
MUN 0.00 1820

8 JI
10 CW
82-22

Form 6 HPS (Rev. 1961)

ROAD INVENTORY SHEET

Party Chief R. VOUGHT
Recorder L. COFFELT JR.
Chainman

VER 2-20-76

HAGERSTOWN

Road No. ~~6500~~ 5500
Name ALLEY #50
Sheet No. 1 OF 1
Date 10-30-63
County WASHINGTON

NORWAY AVE
MUN ← 003 ← 1820

ALLEY #60
MUN 000 5600

8'J
10'CW

NT

Form 6 HPS (Rev. 1961)

ROAD INVENTORY SHEET

5510

Party Chief R. VOUGHT
Recorder L. COFFELT JR.
Chainman

VEQ
7-20-76

HAGERSTOWN

Road No. ~~6510~~
Name ALLEY #51
Sheet No. 1 OF 1
Date 10-30-63
County WASHINGTON

JAMES	ST
MUN ← 0.03	← 1200
ALLEY	#60
MUN 0.00	5600

8'J
10'CN

Form 6 HPS (Rev. 1961)

ROAD INVENTORY SHEET

Party Chief R. VOUGHT
Recorder L. COFFELT JR.
Chainman

HAGERSTOWN

VED
7-20-76

Road No. ~~6530~~ 5530
Name ALLEY #53
Sheet No. 1 OF 1
Date 10-30-63
County WASHINGTON

GEORGE	ST
MUN ← 006	← 910
ALLEY	#46
MUN 004	5760
W. CHURCH	ST
MUN ← 000	440 ←

8'J
10'CW

Form 6 HPS (Rev. 1961)

AT

ROAD INVENTORY SHEET

Party Chief R. VOUGHT

Recorder L. COFFELT JR.

Chainman

HAGERSTOWN

VER 7-20-76

Road No. ~~6550~~ 5550

Name ALLEY #55

Sheet No. 10F

Date 11-4-63

County WASHINGTON

PARKING LOT

006

8'E

12'CW

W. CHURCH ST

MUN 000 440

Form 6 HPS (Rev. 1961)

AT ✓

ROAD INVENTORY SHEET

Party Chief R. VOUGHT
Recorder L. COFFELT JR.
Chainman

HAGERSTOWN VER 7-20-76

Road No. ~~6570~~ 5570
Name ALLEY #57
Sheet No. 1 OF 1
Date 10-30-63
County WASHINGTON

ALLEY	#58
MUN 006	5580
WISE	ST
MUN 000	2620

8'H
12'CW

AT

Form 6 HPS (Rev. 1961)

ROAD INVENTORY SHEET

Party Chief R. VOUGHT
Recorder L. COFFELT JR.
Chainman

HAGERSTOWN

VER 7-20-76

Road No. ~~6580~~ 5580
Name ALLEY #58
Sheet No. 1 OF 1
Date 10-30-63
County WASHINGTON

GEORGE ST
MUN. → 0.10 → 0910
Alley # 47
MUN 5470 0.08

← WEST W. FRANKLIN ST
US 0.05 40
ALLEY # 57
MUN 5570 0.02
(WAKEHAM PL)
MUN. ← 0.00 ← 2490

10' E
14' CW
8' 6
14' CW
8' 6
14' CW

Form 6 HPS (Rev. 1961)

ROAD INVENTORY SHEET

Party Chief R. VOUGHT
Recorder L. COFFELT JR.
Chainman

VER. 7-19-76

HAGERSTOWN

Road No. ~~6590~~ 5590
Name ALLEY #59
Sheet No. 1 OF 1
Date 10-28-63
County WASHINGTON

SALEM		AVE.
Md.	0.15	58
		ALLEY #81
	0.12	MUN 5810
ALLEY #140		
MUN 6400	0.11	
HAMMOND		ST
MUN	0.06	980
CARR		ST
MUN	0.00	350

8'S
10'CW

Form 6 HPS (Rev. 1961)

ROAD INVENTORY SHEET

Party Chief R. VOUGHT
Recorder L. COFFELT JR.
Chainman

VER 7-20-76

HAGERSTOWN

Road No. ~~6600~~ 5600
Name ALLEY #60
Sheet No. 1 OF 1
Date 10-30-63
County WASHINGTON

W. CHURCH ST
MUN ← 008 ← 440

ALLEY #30
MUN 005 5300

ALLEY #51
MUN 5510 003

ALLEY #50
002 MUN 5500

SALEM AVE
MD MUN RD 2200 58

8' J
12' CW

Form 6 HPS (Rev. 1961)

✓ A1

ROAD INVENTORY SHEET

5610

Party Chief R. VOUGHT

Recorder L. COFFELT JR.

Chainman

HAGERSTOWN

VER. 7-19-76

Road No. ~~6610~~

Name ALLEY 61

Sheet No. 1 OF 1

Date 11-8-63

County WASHINGTON

~~Road~~ ~~END~~

~~0~~ ~~04~~

ALLEY # 96

0 03 MUN 5960

8'G

SPRUCE ST

10'CW

MUN 0 00 2260

✓ AT

Form 6 HPS (Rev. 1961)

ROAD INVENTORY SHEET

5620

Party Chief R. VOUGHT
Recorder L. COFFELT JR.
Chainman

VER 7-20-76

HAGERSTOWN

Road No. ~~6620~~
Name ALLEY #62
Sheet No. 1 OF 1
Date 10-29-63
County WASHINGTON

WASHINGTON AVE →
U.S. 003 40

ALLEY 33
MUN 5330 002

W. WASHINGTON ST
MUN ~~TAA~~ 000 2500 ~~TAA~~

9'J CURBRT 9'CW

SHA 51.3-8
11-15-72

STATE HIGHWAY ADMINISTRATION OF MARYLAND

ROAD INVENTORY SHEET

Party Chief R Vought
Recorder L Coffelt Jr
Helper

Map No.
REWRIT 11-23-81
VER 7-20-76 HAGERSTOWN

Road No. 5630
Road Name ALLEY 63
Sheet No. 1 of 1
Date 10-29-63
County WASH
State Coordinates

EAST		PL		
~~ALLEY~~		~~H~~		
MUN		700		
	12'			
ROAD	0 35	END		
BUENA VISTA		AVE		
MUN	0 27	290		
ROSS		ST		
MUN	0 14	2160		
ALLEY #69				
MUN 5690	0 08			
	0 07		30°	8' J
ALLEY #72				12' CW
30° MUN 5720	0 05			
SUMMER		ST		
MUN	0 03	2290		8' H
				12' CW
ROAD	0 00	END		
	5'			
ALLEY		68		
MUN		5680		

SHA 51.3-8
11-15-72

ROAD INVENTORY SHEET

Road No. _____
Road Name _____
Sheet No. _____
Date _____
County _____
State Coordinates _____

Form 6 HPS (Rev. 1961)

ROAD INVENTORY SHEET

Party Chief R. VOUGHT
Recorder L. COFFELT JR.
Chainman

VER
7-20-76

HAGERSTOWN

Road No. ~~6690~~ 5640
Name ALLEY #L4
Sheet No. 1 OF 1
Date 10-29-63
County WASHINGTON

ALLEY		#69	
MUN	0.27	5690	
ROSS		ST	8' I 10' CW 82-24
MUN	0.21	2160	
BUENA VISTA		AVE	9' J 12' CW
MUN	0.08	270	
EAST ~~ALLEY~~		PL ~~#11~~	8' I 12' CW 82-23
MUN	0.00	700	

Form 6 HPS (Rev. 1961)

ROAD INVENTORY SHEET

Party Chief R. VOUGHT
Recorder L. COFFELT JR.
Chainman

VER
7-20-76

HAGERSTOWN

Road No. ~~6650~~ 5650
Name ALLEY #65
Sheet No. 1 OF 1
Date 10-29-63
County WASHINGTON

Road End
004

ALLEY #246
MUN 7160 002

EAST ~~ALLEY~~ PLACE ~~H~~
MUN 000 700

8'G
10'CW

✓ AT

Form 6 HPS (Rev. 1961)

ROAD INVENTORY SHEET

Party Chief R. VOUGHT
Recorder L. COFFELT JR.
Chainman

HAGERSTOWN

VER 7-20-76

Road No. ~~6660~~ 5660
Name ALLEY #66
Sheet No. 10F1
Date 10-29-63
County WASHINGTON

89-36

BUENA VISTA AVE
MUN 008 290

10'I
~~8'0~~ I
10'CW

EAST ~~ALLEY~~ PL #
MV 000 710

Form 6 HPS (Rev. 1961)

✓ A/T

ROAD INVENTORY SHEET

Party Chief R. VOUGHT
Recorder L. COFFELT JR.
Chainman
HAGERSTOWN

VER.
7-19-76

Road No. ~~6670~~ 5670
Name ALLEY 67
Sheet No. 1 OF 1
Date 11-8-63
County WASHINGTON

E FIRST	ST	
MUN 012	800	
		8 J
		10'CW
MUN 000	2600	
WILSON X	BLVD E	
MUN 5840	← ALLEY 84	

Form 6 HPS (Rev. 1961)

MACS

ROAD INVENTORY SHEET

Party Chief R. Vought
Recorder L. Coffelt, Jr.
Chainman

VER
7-20-76

Road No. ~~6680~~ 5680
Name Alley 68
Sheet No. 1 of 1
Date 10-29-63
County Wash.

ROAD	END	
0	23	8'H 10'CW
0	20	
LANVACE	ST	
0	18	8'J 10'CW
~~Road~~	~~End~~	
0	16	
		8'H 10'C.W.
0	10 MUN Alley 70 5700	
0	** 01 MUN Alley 63 3630	
		10'H 13'C.W.
Court Alley MUN 9060	0	00

Form 6 HPS (Rev. 1961)

AT

ROAD INVENTORY SHEET

Party Chief R. Vought
Recorder L. Coffelt, Jr.
Chainman

VER
7-20-76

Road No. ~~6690~~ 5690
Name Alley 69
Sheet No. 1 of 1
Date 10-29-63
County Nash.

Alley MUN	0	10	5630	63	
Concord MUN	0	07	520	St.	8'H 79-21
Alley #64 MUN 5640	0	04			8'H 10'CW.
Lanvale MUN	0	00	1340	St.	
MUN 5710		← ALLEY 71			

Form 6 HPS (Rev. 1961)

ROAD INVENTORY SHEET

Party Chief R. VOUGHT
Recorder L. COFFELT JR.
Chainman

HAGERSTOWN

VER. 7-20-76

Road No. ~~6700~~ 5700
Name ALLEY #70
Sheet No. 1 OF 1
Date 10-29-63
County WASHINGTON

Summer ST
MUN 003 2290

Alley #68
MUN 000 5680

10'H
14'CW

Form 6 HPS (Rev. 1961)

AT

ROAD INVENTORY SHEET

Party Chief R. Vought
Recorder L. Coffelt, Jr.
Chainman

VER
7-20-76

Road No. ~~6710~~ 5710
Name Alley 71
Sheet No. 1 of 1
Date 10-29-63
County Wash.

Lanvale St. MUN	0	06	1340	
Alley 76 MUN 5760	0	03		8'H 10'CW.
Main St. MUN	0	00	1490	

8'H 79-23

A1

Form 6 HPS (Rev. 1961)

ROAD INVENTORY SHEET

5720

Party Chief R. VOUGHT

Recorder L. COFFELT JR.

Chainman

VER. 7-20-76

HAGERSTOWN

Road No. ~~6720~~

Name ALLEY #72

Sheet No. 1 OF 1

Date 10-29-63

County WASHINGTON

88-25 11-28-88

CONCRETE	ST
MUN 003	520
ALLEY	#63
MUN 000	5630

8'I
~~6'6~~
8'CW
82-25

Form 6 HPS (Rev. 1961)

AT

ROAD INVENTORY SHEET

Party Chief R. VOUGHT
Recorder L. COFFELT JR.
Chainman

VGA
7-20-76

HAGERSTOWN

Road No. ~~6730~~ 5730
Name ALLEY #73
Sheet No. 1 OF 1
Date 10-29-63
County WASHINGTON

ELGIN BLVD
MUN 008 720

CUSHWA'S ALLEY #
MUN 000 9090

8'G
12'CW

AJ

Form 6 HPS (Rev. 1961)

ROAD INVENTORY SHEET

5740

Party Chief R. VOUGHT
Recorder L. COFFELT JR.
Chainman

VER 7-20-76

HAGERSTOWN

Road No. ~~6740~~
Name Alley #14
Sheet No. 1 OF 1
Date 10-29-63
County WASHINGTON

CUSHWA'S	ALLEY
MUN 0.07	9090
ELIZABETH	ST
MUN 0.03	740
Alley	#75
MUN 0.00	5750

8'J
12'CW

*Code minimum roadway width as 8 feet. KJP

AT

Form 6 HPS (Rev. 1961)

ROAD INVENTORY SHEET

Party Chief R. VOUGHT
Recorder L. COFFELT JR.
Chainman
HAGERSTOWN

GPS-02
6-4-02
GD/EF VER.
7-20-76

Road No. ~~6750~~ 5750
Name ALLEY #75
Sheet No. 1 OF 1
Date 10-29-63
County WASHINGTON

~~BURHANS~~ ROAD ~~Road End~~ END ~~BLVD~~		
~~MUN~~	0 ~~17~~ 16 ~~300~~	
LEROY ST		6'D 8'CW
MU	0 15 1380	
ALLEY #74		
	0 05 MUN 5740	6'J 12'CW
	0 02	
W. WASHINGTON ST		8'J 12'CW
MUN	000 2500	

Form 6 HPS (Rev. 1961)

AT

ROAD INVENTORY SHEET

Party Chief R. VOUGHT
Recorder L. COFFELT JR.
Chainman

HAGERSTOWN

VER 7-20-76

Road No. ~~6760~~ 5760
Name Alley # 76
Sheet No. 1 OF 1
Date 10-29-63
County WASHINGTON

Alley #71
MUN 006 5710

8'G
10'CW

Ross ST
MUN 000 2160

✓ AT

Form 6 HPS (Rev. 1961)

ROAD INVENTORY SHEET

Party Chief R. VOUGHT
Recorder L. COFFELT JR.
Chainman

HAGERSTOWN

VER. 7-20-76

Road No. ~~6770~~ 5770
Name ALLEY #77
Sheet No. 1 OF 1
Date 10-29-63
County WASHINGTON

Road End
0.07

8'E
10'CW

0.02

8'6
10'CW

CHASE ST

0.00 MUN 420

Form 6 HPS (Rev. 1961)

90-30
3-8-91
GD/TM

89-EX#2
DT/CG
2/1/90

AT

ROAD INVENTORY SHEET

5780

Party Chief ~~R. VOUGHT~~
Recorder ~~L. COFFELT~~ JR.
Chainman

VER
7-20-76

HAGERSTOWN

Road No. ~~6780~~
Name ALLEY #78
Sheet No. 1 OF 1
Date 10-29-63
County WASHINGTON

WESEL BLVD
0 30
MU 2547 90-30

~~ROAD END~~
~~0 58~~
~~0 36~~ ~~90~~
~~HEISTER ST~~
~~MUN 0 31 1020~~
~~ROAD 0 30 END~~
CLAIRE ST
MUN 0 20 450

CENTRE ST
MUN 0 11 390

CHASE ST
MUN 0 00 420

~~6'E~~
~~8'CW~~

8'XI
10'CW

Form 6 HPS (Rev. 1961)

90-30
3-8-91
GD/TM

89-EX#2 AT
DT/CG 2/1/90
5790

ROAD INVENTORY SHEET

Party Chief R. VOUGHT
Recorder L. COFFELT JR.
Chainman

HAGERSTOWN

VER. 7-20-76

Road No. ~~6790~~
Name ALLEY #79
Sheet No. 1 OF 1
Date 10-29-63
County ~~WASHINGTON~~

~~CHASE~~	CHASE ST
~~MUN~~ 0	~~30~~ ~~29~~ 30 420 - MU
CENTRE	ST
MUN 0	~~18~~ 19 390
CLAIRE	ST
MUN 0	~~19~~ 10 450
~~ROAD~~ ~~0.00~~	~~END~~ ~~Heister Rd.~~
WESEL ~~0.00~~	~~MUN~~ ~~1020~~ BLVD (ABAN.)
0.00	SS

8'J
12'CW

MU 2547 90-30

Form 6 HPS (Rev. 1961)

ROAD INVENTORY SHEET

Party Chief R. VOUGHT
Recorder L. COFFELT JR. VER. 7-19-76
Chainman
HAGERSTOWN

Road No. ~~6800~~ 5800
Name ALLEY #80
Sheet No. 1 OF 1
Date 10-28-63
County ~~WASHINGTON~~

ALLEY #81
MUN 009 5810

8' ✓
10' CW

MARSHALL ST
MUN 000 1540

Form 6 HPS (Rev. 1961)

ROAD INVENTORY SHEET

Party Chief R. VOUGHT
Recorder L. COFFELT JR.
Chainman

HAGERSTOWN

VER 7-19-76

Road No. ~~6810~~ 5810
Name ALLEY # 81
Sheet No. 1 OF 1
Date 10-28-63
County WASHINGTON

WYOMING		AVE
MUN	0.33	2660
		~~RD~~ ALLEY 262
	0.30	
STRATFORD		AVE
MUN	0.26	2270
		ALLEY # 82
	0.23	MUN 5820
CLARENDON		AVE
MUN	0.19	460
		ALLEY #80
	0.15	
CENTRAL		AVE
MUN	0.11	400
		ALLEY #83
	0.07	MUN 5830
LINGANORE		AVE
MUN	0.04	1420
ALLEY		#59
MUN	0.00	5590

8' J
10' CW

10' J
13' CW

/ AT

Form 6 HPS (Rev. 1961)

ROAD INVENTORY SHEET

Party Chief R. VOUGHT
Recorder L. COFFELT JR. VER 7-19-76
Chainman

HAGERSTOWN

Road No. 5820 ~~6820~~
Name ALLEY #82
Sheet No. 1 OF 1
Date 10-28-63
County WASHINGTON

MARSHALL ST
MUN 009 1570

8'J
10'CW

ALLEY #81
MUN 000 5810

AT

Form 6 HPS (Rev. 1961)

ROAD INVENTORY SHEET

5830

Party Chief R. VOUGHT
Recorder L. COFFELT JR.
Chainman

HAGERSTOWN

VER 7-19-76

Road No. ~~6830~~
Name ALLEY #83
Sheet No. 1 OF 1
Date 10-28-63
County WASHINGTON

GEORGIA AVE
MUN 015 920

MARSHALL ST
MUN 009 1540

ALLEY #81
MUN 000 5810

69-38
8'J 10'CW

8'H
10'CW

8'J
10'CW

SHA 51.3 - 8 Revised
4.83

MARYLAND STATE HIGHWAY ADMINISTRATION

ROAD INVENTORY SHEET

Party Chief: R.V.
Recorder: L.C. JR
Assistant: Rewritten (JEL) 4-14-94
Map No./Dir.: A-8 / N
State Coordinates: 595-653

Road No.: MU 5840
Road Name: Alley 84
County: Washington
Date: 9-19-63
Sheet No.: 1 OF 1

TRAFFIC CODES
TRAFFIC CONTROLS: STOP SIGN=S.S., TRAFFIC LIGHT=T.L., FLASHING RED BALL=F.R.

TRAFFIC CODES
PARKING RESTRICTIONS: A.M. PEAK, P.M. PEAK, A.M./P.M. PEAK, NO PARKING ANYTIME=N.P., COMM/IND. ACCESS=E

SYSTEM				TRAFFIC		LINE DIAGRAM	TRAFFIC			PAVEMENT DATA
FED. AID.	FUNCT. CLASS.	HWY. SYS.	HPMS SAMPLE	PRKG. REST.	COM/IND. ACCESS	HAGERSTOWN	CONTROL	COM/IND. ACCESS	PRKG. REST.	
						MU 5870 Alley 67				
						MU 2600 Wilson 0.13 Blvd East				
	K URBAN LOCAL									9' I 14' CW
						(Third St) CO 0.00 406 IN CORP LMTS HAGERSTOWN				
						(Fourth St) 0.40				

SYSTEM				TRAFFIC		LINE DIAGRAM	TRAFFIC			PAVEMENT DATA
FED. AID.	FUNCT. CLASS.	HWY. SYS.	HPMS SAMPLE	PRK.G. REST.	COM/IND ACCESS		CONTROL	COM/IND ACCESS	PRK.G. REST.	

Form 6 HPS (Rev. 1961)

AT

ROAD INVENTORY SHEET

Party Chief	R. VOUGHT	Road No.	~~6850~~ 5850
Recorder	L. COFFELT JR.	Name	ALLEY #85
Chainman		Sheet No.	1 OF 1
	HAGERSTOWN	Date	11-8-63
		County	WASHINGTON

VER 7-19-76

CORBETT	ST	
MUN 0 07	550	
ALLEY #87		
MUN 5870 0 04		
		8'J
POPE	AVE	10'CW
~~CO~~ MUN 0 00	1990 ~~[illegible]~~ ~~405~~	

Form 6 HPS (Rev. 1961)

AT

ROAD INVENTORY SHEET

Party Chief R. VOUGHT
Recorder L. COFFELT JR.
Chainman

HAGERSTOWN

VER
7-19-76

Road No. ~~6860~~ 5860
Name ALLEY #86
Sheet No. 1 OF 1
Date 11-8-63
County WASHINGTON

Pope		Ave	
MUN	007	1990	
Alley #87			
MUN 5870	003		
			8'J
Corbett		ST	10'(W)
MUN	000	550	

Form 6 HPS (Rev. 1961)

✓ AT

ROAD INVENTORY SHEET

5870

Party Chief R. VOUGHT
Recorder L. COFFELT JR.
Chainman
HAGERSTOWN

Ver. 7-19-76

Road No. ~~6870~~
Name ALLEY #87
Sheet No. 1 OF 1
Date 11-8-63
County WASHINGTON

ALLEY MUN	0.03	#85 5850
		8'J 10'CW
ALLEY MUN	0.00	#86 5860

Form 6 HPS (Rev. 1961)

✓ AT

ROAD INVENTORY SHEET

Party Chief R. VOUGHT
Recorder L. COFFELT JR.
Chainman
HAGERSTOWN

ALLEY 89-A
WILSON BLVD
VER 7-19-76

Road No. ~~6880~~ 5880
Name ALLEY #88
Sheet No. 1 OF 1
Date 11-8-63
County WASHINGTON

ALLEY 89

WILSON X BLVD EAST
MUN 019 2600

E FIRST ST
MUN 007 800

E. HOWARD ST
MUN 000 1090

8'S
10'CW

Form 6 HPS (Rev. 1961)

✓ AT

ROAD INVENTORY SHEET

5890

Party Chief R. VOUGHT
Recorder L. COFFELT JR.
Chainman

HAGERSTOWN

VER. 7-19-76

Road No. ~~6890~~
Name ALLEY 89
Sheet No. 1 OF 1
Date 11-8-63
County WASHINGTON

THIRD.	ST	
CO 012	0406	^
		8'J
		10'CW
MUN 000 2600		✓
WILSON X	BLVD E	
5580 MUN	← ALLEY 88	

Form 6 HPS (Rev. 1961)

✓ AT

ROAD INVENTORY SHEET

5900

Party Chief R. VOUGHT
Recorder L. COFFELT JR.
Chainman

HAGERSTOWN

VER 7-19-76

Road No. ~~6900~~
Name ALLEY #90
Sheet No. 1 OF 1
Date 11-8-63
County WASHINGTON

E FIRST	ST	
MUN 012	800	
		8' J
		10' CW
000		
WILSON	BLVD E	
MUN	2600	

Form 6 HPS (Rev. 1961)

ROAD INVENTORY SHEET

Party Chief R. VOUGHT
Recorder
Chainman L. JOFFELT JR.

HAGERSTOWN

VER. 7-19-76

Road No. ~~6970~~ 5910
Name ALLEY #91
Sheet No. 1 OF 1
Date 11-12-63
County WASHINGTON

ROWLAND AVE		
MUN 012 2170		
	ONE WAY	8'J
MEMORIAL BLVD W		12'CW
MUN 000 1650		

Form 6 HPS (Rev. 1961)

AT

ROAD INVENTORY SHEET

5920

Party Chief F. VOUGHT
Recorder L. COFFELT JR.
Chainman

HAGERSTOWN

VER 7-19-76

Road No. ~~6920~~
Name ALLEY #92
Sheet No. 1 OF 1
Date 11-12-63
County WASHINGTON

AT 84-11

WILLOW		CIRCLE	
MUN	0 28	2590	
			8' J
COMMONWEALTH		AVE	10' CW
MU	0 00	0510	

Form 6 HPS (Rev. 1961)

✓ A/T

ROAD INVENTORY SHEET

Party Chief R. VOUGHT
Recorder L. COFFELT JR.
Chainman

HAGERSTOWN

VER. 7-19-76

Road No. ~~6930~~ 5930
Name ALLEY #93
Sheet No. 1 OF 1
Date 11-12-63
County WASHINGTON

Frederick		St
ALT	0.10	U.S. 40
	0.07	90
		8' J
Rowland		Ave
MUN	0.00	2170

10' CW

Form 6 HPS (Rev. 1961)

A1

ROAD INVENTORY SHEET

Party Chief R. VOUGHT
Recorder L. COFFELT JR.
Chainman

VER. 7-20-76

HAGERSTOWN

Road No. ~~6940~~ 5940
Name ALLEY #94
Sheet No. 1 OF 1
Date 10-31-63
County WASHINGTON

MULBERRY ST
MUN 003 1760

69-45
8'13 12 CW

8'H
12'CW

CROSS ST
MUN 000 580

Form 6 HPS (Rev. 1961)

✓ AT

ROAD INVENTORY SHEET

Party Chief	R. VOUGHT	Road No.	~~6950~~ 5950
Recorder	L. COFFELT JR.	Name	ALLEY # 95
Chainman		Sheet No.	10F1
	HAGERSTOWN	Date	11-8-63
		County	WASHINGTON

VER 7-19-76

WILSON		BLVD	EAST
MUN	0 12	2600	
			8'J
E. FIRST		ST	10'CW
MUN	0 00	800	

Form 6 HPS (Rev. 1961)

ROAD INVENTORY SHEET

Party Chief R. VOUGHT
Recorder L. COFFELT JR.
Chainman

HAGERSTOWN

GPS-02
5-29-02
GD/EF

VER.
7-19-16

A/T
83-12

Road No. ~~6960~~ 5960
Name ALLEY #96
Sheet No. 1 OF 1
Date 11-8-63
County WASHINGTON

ALLEY #61		~~#61~~	
MUN 5610	0.32	~~5610~~	
			8'E
			10'CW
W. HOWARD		ST	
MUN	0.26	1100	
			8'J
W. FIRST		ST	10'CW
MUN	0.13	810	8'H
			10'CW
	0.06		
ALLEY		# 101	
MUN	0.04	6010	8'J
			10'CW
	0.00		
WILSON		BLVD W	
MUN		2600	

Form 6 HPS (Rev. 1961)

M

ROAD INVENTORY SHEET

Party Chief R. Vought
Recorder L. Coffelt, Jr.
Chainman

VER
7-19-76

Road No. ~~6970~~ 5970
Name Alley 97
Sheet No. 1 of 1
Date 11-8-63
County Wash

	PINE ST 1970		
Old Wilson	0 04	Blvd. ~~W~~	
MUN		~~2600~~ 2601	
			8'G
			10'C.W.
	0 00 MUN	Alley ~~99~~ 100 6000	

Form 6 HPS (Rev. 1961)

AT

ROAD INVENTORY SHEET

5980

Party Chief R. VOUGHT
Recorder L. COFFELT JR.
Chainman

HAGERSTOWN

VER. 7-19-76

Road No. ~~6980~~
Name ALLEY #98
Sheet No. 1 OF 1
Date 11-13-63
County WASHINGTON

ROAD	END	
0	05	
		8' E
		12' CW
0	04	
		8' J
W. HOWARD	ST	10 CW
MUN	1100	
MUN 6120	← ALLEY 112	

Form 6 HPS (Rev. 1961)

AT

ROAD INVENTORY SHEET

Party Chief R. Vought
Recorder L. Coffelt, Jr.
Chainman

VER
7-19-76

Road No. ~~6990~~ 5990
Name Alley 99
Sheet No. 1 of 1
Date 11-8-63
County Wash.

CHESTNUT ST
MU 0430

Wilson 0 04 Blvd W.
MUN 2600

8' I 79-24
10' F 64-2
10' E
12' C.W.

Alley 100
0 00
MUN 6000

Form 6 HPS (Rev. 1961)

FCR-97
GD, MP
11/10/97 6000

AT

ROAD INVENTORY SHEET

Party Chief	R. VOUGHT	Road No.	~~8000~~
Recorder	L. COFFELT JR.	Name	ALLEY #100
Chainman		Sheet No.	1 OF 1
	HAGERSTOWN	Date	11-8-63
		County	WASHINGTON

(92-28)
BB/AH
4-1-73
VER
7-19-76

		ALLEY #97		
	0 48	MUN. 5970		
		~~ALLEY 98~~ SUMMIT AVE		
	0 41	MUN 2300	8'I 80-15/16	8'H
		ALLEY #99		10'CW
	0 26	MUN 5990		8'G
MARYLAND		AVE		10'CW
MU ~~MD~~	0 19	1550 ~~632~~		
ALLEY #103				
MUN 6030	0 14			
SPRUCE		ST		
MUN	0 11	2260	8'I 79-25	8'H
ALLEY #102				12'CW
MUN 6020	0 07			
			79-26	10'H
DOWNSVILLE MUN				12'CW
	0 00			
	670	~~PIKE~~ RD		

Form 6 HPS (Rev. 1961)

AT

ROAD INVENTORY SHEET

Party Chief R. VOUGHT
Recorder L. COFFELT JR.
Chainman

VER. 7-19-76

HAGERSTOWN

Road No. ~~8010~~ C010
Name ALLEY #101
Sheet No. 1 OF 1
Date 11-8-63
County WASHINGTON

7876 + 17 + 18

POTOMAC ST.		
MUN 0 ~~48~~ 2000 5		
ALLEY #96		
MUN 0 ~~25~~ 5960		8'J
SPRUCE AVE		10'CW
MUN 0 ~~39~~ 2260		8'H
ALLEY #104		10'CW
MUN 0 ~~26~~ 6040		8'J
MARYLAND AVE		10'CW
MUN 0 ~~22~~ 1550		
ALLEY #105		
MUN 0 ~~42~~ 6050		
CHESTNUT AVE		
MUN 0 ~~45~~ 430		
ALLEY #109		
MUN 6090 0 ~~14~~		8'H
GUILFORD AVE		10'CW
MUN 0 ~~92~~ 940	0940	
ALLEY #113		
MUN 6130 0 ~~04~~		
SUMMIT AVE		
MUN 0 0 ~~80~~ 2300		
~~ALLEY~~	~~112~~	
~~0 04~~		8'J
~~RINE~~	~~ST~~	10'CW
~~0 00~~		

Form 6 HPS (Rev. 1961)

ROAD INVENTORY SHEET

Party Chief R. VOUGHT
Recorder L. COFFELT JR.
Chainman

(92-28) BB/AH 4-1-93 VER 7-19-96

HAGERSTOWN

Road No. ~~8020~~ 6020
Name ALLEY #102
Sheet No. 1 OF 1
Date 11-8-63
County WASHINGTON

~~DOWNSVILLE PIKE~~ RD MUN	007 670	
ALLEY MUN	~~000~~ 6000 ~~#100~~	8'H 10'CW

Form 6 HPS (Rev. 1961)

(92-28)
BB-AH
4-1-93

AT

ROAD INVENTORY SHEET

Party Chief	R. VOUGHT	Road No.	~~8030~~ 6030
Recorder	L. COFFELT JR.	Name	ALLEY #103
Chainman		Sheet No.	1 OF 1
	HAGERSTOWN	Date	11-8-63
		County	WASHINGTON

VER.
7-19-76

ALLEY	#100	
MUN 012	6000	
~~AKE~~ RD		8'H
DOWNSVILLE 000		10'CW
MUN	670	

Form 6 HPS (Rev. 1961)

✓ AT

ROAD INVENTORY SHEET

Party Chief R. VOUGHT
Recorder ~~L. COFFELT JR.~~
Chainman

HAGERSTOWN

VER. 7-19-76

Road No. ~~8040~~ 6040
Name ALLEY # 104
Sheet No. 1 OF 1
Date 11-8-63
County WASHINGTON

ROAD END		
	043	
		8'E
GARRETT	ST	10'CW
MUN	038 900	
ALLEY #247		
MUN 7470	029	
W. HOWARD	ST	
MUN 1100	026	
W. FIRST	ST	
MUN 810	013	8'J
ALLEY	#101	10'CW
MUN	004 6010	10'H
		10'CW
	000	
WILSON	BLVD W	
MUN	2600	

Form 6 HPS (Rev. 1961)

ROAD INVENTORY SHEET

Party Chief R. Vought
Recorder L. Coffelt, Jr
Chainman

VER. 7-19-76

Road No. ~~8050~~ 6050
Name Alley 105
Sheet No. 1 of 1
Date 11-8-63
County Wash.

Wilson MUN	0.55	2600 Blvd. W	
Alley MUN	0.52	6010 101	
W. First MUN	0.43	910 St.	
W. Howard MUN	0.30	1100 St.	
Alley 248 MUN ~~4800'~~	0.26		
Garrett MUN 900	0.17	900 St.	
Garlinger MUN 890	0.07	Ave.	8' J 12' CW.
Alley 107 MUN 6070	0.00		

Form 6 HPS (Rev. 1961)

AT

ROAD INVENTORY SHEET

6060

Party Chief R. VOUGHT
Recorder L. COFFELT JR.
Chainman

HAGERSTOWN

VER 7-20-76

Road No. ~~8060~~
Name ALLEY #106
Sheet No. 1 OF 1
Date 11-8-63
County WASHINGTON

ONE WAY

UNDER CONST

CHESTNUT AVE
MUN 430 0.23 430

ALLEY #119
MUN 0.20 6190

GUILFORD AVE
MUN 0.16 940

ALLEY #131 ALLEY #131
MUN 0.12 6310

SUMMIT AVE
MUN 0.09 2300

8' J

VIRGINIA AVE
~~US~~ 0.00 ~~H~~ 2430

10' CW

Form 6 HPS (Rev. 1961)

AT

ROAD INVENTORY SHEET

Party Chief R. Vought
Recorder L. Coffelt, Jr.
Chainman

VER.
7-19-76

Road No. ~~8070~~ 6070
Name Alley 107
Sheet No. 1 of 1
Date 11-8-63
County Wash.

Alley 105
MUN 60.50 0.04

8'J
12'C.W.

Maryland ~~Ave~~ ~~MEMORIAL~~ ~~BLVD.~~ AVE
MUN 0.00 15.50

Form 6 HPS (Rev. 1961)

AT

ROAD INVENTORY SHEET

Party Chief R. VOUGHT
Recorder L. COFFELT JR.
Chainman

HAGERSTOWN

VER 7-19-76

Road No. ~~8080~~ 6080
Name Accept 108
Sheet No. 10F1
Date 11-8-63
County WASHINGTON

	0270 Ave Brown		
VIRGINIA		Ave	
~~US~~	0 13	~~11~~ 2430	
↑90°	0 10		
	0 09	90°↑	
	0 06	90°↑	8'J
			10'CW
	0 02		
			10'J
2320 SUNSET			10'CW
	0 00 MUN	AVE ~~DR~~	

Form 6 HPS (Rev. 1961)

✓ AT

ROAD INVENTORY SHEET

Party Chief	R. VOUGHT	Road No.	~~8090~~ 6090
Recorder	L. COFFELT JR.	Name	ALLEY #109
Chainman		Sheet No.	1 OF 1
	HAGERSTOWN	Date	11-8-63
		County	WASHINGTON

VER. 7-19-76

GARLINGER			
MUN 890	0 49	AVE	
GARRETT		ST	
MUN 900	0 39		
	0 33	35°	
35°	0 30		
W. HOWARD		ST	
MUN 1100	0 26		8'J
W. FIRST		ST	10'CW
MUN 810	0 13		
			8'H
			12'CW
ALLEY		#101	
MUN	0 04	6010	
			11'H
			12'CW
MUN	0 00	2600	CURB LT
WILSON		BLVD W	

63-48 8'J 12CW 11'J CLT

Form 6 HPS (Rev. 1961)

AT

ROAD INVENTORY SHEET

Party Chief R. VOUGHT
Recorder L. COFFELT JR.
Chainman

HAGERSTOWN

VER. 7-20-76

Road No. ~~8100~~ 6100
Name ALLEY #110
Sheet No. 1 OF 1
Date 11-8-63
County WASHINGTON

Reynolds Ave		
MUN	014 2090	
		8'J
Surrey Ave		10'CW
MUN	000 2330	

Form 6 HPS (Rev. 1961)

✓ AT

ROAD INVENTORY SHEET

Party Chief R. VOUGHT
Recorder L. COFFELT JR.
Chainman

HAGERSTOWN

VER 7-19-76

Road No. ~~8110~~ 6110
Name ALLEY #111
Sheet No. 1 OF 1
Date 11-8-63
County WASHINGTON

Rad.	END	
0.06		
0.04		90°
		8' H
Summit	AVE	10' CW
MUN 0.00	2300	

Form 6 HPS (Rev. 1961)

AT

ROAD INVENTORY SHEET

Party Chief	R. VOUGHT	Road No.	~~8120~~ 6120
Recorder	L. COFFELT JR.	Name	ALLEY #112
Chainman		Sheet No.	1 OF 1
	HAGERSTOWN	Date	11-8-63
		County	WASHINGTON

VER 7-19-76

ALLEY 98

W. HOWARD ST

MUN 0 ~~26~~ 22 1100

ALLEY #116

MUN 6160 0 ~~22~~ 19

8'-J

~~ALLEY #111~~ 0 04 90°

8'I

~~8'J~~

0 00 1970

10'CW

PINE ~~WILSON~~ ST ~~BLVD~~

0.07

Form 6 HPS (Rev. 1961)

✓ AT

ROAD INVENTORY SHEET

Party Chief	R. VOUGHT	Road No.	~~8130~~ 6130
Recorder	L. COFFELT JR.	Name	ALLEY #113
Chainman		Sheet No.	1 OF 1
	HAGERSTOWN	Date	11-8-63
		County	WASHINGTON

VER 7-19-76

Road End

0 27

W. HOWARD ST

MUN 0 23 1100

W. FIRST ST

MUN 0 10 810

70.34

8' J

10' CW

ALLEY #101

MUN 0 00 6010

Form 6 HPS (Rev. 1961)

AT

ROAD INVENTORY SHEET

6140 93-4

Party Chief R. VOUGHT
Recorder L. COFFELT JR.
Chainman

HAGERSTOWN

VER 7-19-76

Road No. ~~8140~~
Name ALLEY # 114
Sheet No. 1 OF 1
Date 11-8-63
County WASHINGTON

City Park		Drive ~~xxx~~	
MUN	0 05	1920	
			8'E 10'CW
↑90°	0 03		
			12'E 14'CW
Virginia		Ave	
~~VX~~	0 00	# 2430	

67-32 8'J 14'CW 8'J 10'CW

Form 6 HPS (Rev. 1961)

AT

ROAD INVENTORY SHEET

Party Chief R. VOUGHT
Recorder L. COFFELT JR.
Chainman

HAGERSTOWN

VER. 7-19-76

Road No. ~~8150~~ 6150
Name ALLEY #115
Sheet No. 1 OF 1
Date 11-8-63
County WASHINGTON

Road. End	0.07	
ALLEY #116 MUN 6160	0.03	
		8' J
W. HOWARD ST MUN	0.00 1100	10' CW

Form 6 HPS (Rev. 1961)

✓ AT

ROAD INVENTORY SHEET

Party Chief R. VOUGHT
Recorder L. COFFELT JR.
Chainman

HAGERSTOWN

VER 7-19-76

Road No. ~~8160~~ 6160
Name Alley #116
Sheet No. 1 OF 1
Date 11-8-63
County WASHINGTON

ALLEY		# 112	
MUN	0.05	6120	
PINE		ST	
MUN	0.03	1970 @.25	
ALLEY		# 115	8'J 10'CW
MUN	0.00	6150	

Form 6 HPS (Rev. 1961)

AT

ROAD INVENTORY SHEET

Party Chief R. VOUGHT
Recorder L. COFFELT JR.
Chainman

HAGERSTOWN

VER 7-20-76

Road No. ~~8170~~ 6170
Name ALLEY #117
Sheet No. 1 OF 1
Date 11-8-63
County WASHINGTON

78-15

WEST	ST	
MUN 005	2570	↑
		8'J
		10'CW
REYNOLDS	AVE	
MUN 000	2090	✓

Form 6 HPS (Rev. 1961)

AT

ROAD INVENTORY SHEET

C180

Party Chief R. VOUGHT
Recorder L. COFFELT JR.
Chainman

VER 7-20-76

HAGERSTOWN

Road No. ~~9180~~
Name ALLEY # 118
Sheet No. 1 OF 1
Date 11-8-63
County WASHINGTON

Memorial		Blvd	
MUN	014	1650	
Surrey		Ave	
MUN	009	2330	
			8' J
West		ST	10' CW
MUN	000	2570	

Form 6 HPS (Rev. 1961)

ROAD INVENTORY SHEET

Party Chief F. VOUGHT
Recorder L. COFFELT JR.
Chainman

HAGERSTOWN

VER. 7-20-76

Road No. ~~8190~~ C190
Name Alley #119
Sheet No. 1 OF 1
Date 11-8-63
County WASHINGTON

Memorial		Blvd	
MUN	0.28	1650	
Reynolds		Ave	
MUN	0.16	2090	8'J
Alley		#106	10'CW
	0.13		8'H
			10'CW
	0.07		
			11'H
Guilford		Ave	12'CW
MUN	0.03	940	
			8'J
Alley		131	10'CW
MUN	0.00	6310	

Form 6 HPS (Rev. 1961)

AT

ROAD INVENTORY SHEET

Party Chief R. VOUGHT
Recorder L. COFFELT JR.
Chainman

HAGERSTOWN

VER. 7-20-76

Road No. ~~8200~~ C200
Name Alley #120
Sheet No. 1 of 1
Date 11-12-63
County WASHINGTON

78-19

Memorial		Blvd W	
MUN	0 29	1630	
			22' J
			26' CW
	0 23		
			23' J
Garlinger		Ave	26' CW
MUN ←	0 19	← 890	
			8' J
			10' CW
	0 09		
170°	0 02		12' E
S Potomac		St	16' CW
MUN	0 00	2008 S	

Form 6 HPS (Rev. 1961)

✓ CS ✓

ROAD INVENTORY SHEET

Party Chief R. Vought
Recorder L. Coffelt, Jr
Chainman

VER
7-20-76

Road No. ~~9210~~ 6210
Name Alley 121
Sheet No. 1 of 1
Date 11-12-63
County Wash

71-32

W. Lee MUN	0 07	St. 1360	↑
			8' J
			~~10' CW.~~
			2-2' I SHD
Alley 5 MUN 5050	0 00		✓ 14' CW

Form 6 HPS (Rev. 1961)

A.

ROAD INVENTORY SHEET

Party Chief R. Vought
Recorder L. Coffelt, Jr.
Chainman

VER
7-20-76

Road No. ~~8220~~ 6220
Name Alley 122
Sheet No. 1 of 1
Date 11-12-63
County Wash.

81-3

W. Baltimore MUN 0 15 90 St. 0100

Alley #123 MUN 6230 0 11 ~~123~~ ~~6230~~

W. Lee MUN 0 00 St. 1360

Hood St

Mu 1082

70-33

8'J
12'CW.

Form 6 HPS (Rev. 1961)

GPS-02
5-29-02
GO/EF

— A1

ROAD INVENTORY SHEET

6230

Party Chief R. VOUGHT
Recorder L. COFFELT JR.
Chainman

VER
7-20-76

HAGERSTOWN

Road No. ~~8230~~
Name ALLEY #123
Sheet No. 1 of 1
Date 11-12-63
County WASHINGTON

SUMMIT		AVE	
~~MUN~~	0.084	~~2300~~ 2301	
ALLEY		#122	
MUN	0.040	6220	
~~SPUR~~	~~0.01~~	~~BFO RR~~	
			10'6
HOOD		ST	12'CW
~~MUN~~	~~0.00~~	~~1080~~	

68-42
10'5 12'CW

Form 6 HPS (Rev. 1961)

AT

ROAD INVENTORY SHEET

Party Chief R. VOUGHT
Recorder L. COFFELT JR.
Chainman

HAGERSTOWN

VER. 7-20-76

Road No. ~~8240~~ C240
Name ALLEY #124
Sheet No. 1 of 1
Date 11-12-63
County WASHINGTON

ABANDONDED
GPS-02
6-6-02
GD/EF

S. PROSPECT ST

MUN 0.07 ~~2020~~ 2030

10'H
12'CW

0.06

10'E
12'CW

S. WALNUT ST

MUN 0.00 2470

Form 6 HPS (Rev. 1961)

ROAD INVENTORY SHEET

Party Chief R. VOUGHT
Recorder L. COFFELT JR.
Chainman

HAGERSTOWN

VER 7-19-76

Road No. C250
Name ALLEY # 125
Sheet No. 1 OF 1
Date 11-12-63
County WASHINGTON

EASTERN ~~BLVD~~		BLVD ~~AVE~~	
MUN	0.26	~~170~~ ~~750~~ 705	
ROWLAND		AVE	
MUN	0.11	2170	
			8'J
MEMORIAL		BLVD E	10'CW
MUN	0.09	1650	

Form 6 HPS (Rev. 1961)

AT

ROAD INVENTORY SHEET

Party Chief	R. VOUGHT	Road No.	~~8260~~ 6260
Recorder	L. COFFELT JR.	Name	ALLEY #126
Chainman		Sheet No.	1 OF 1
		Date	11-5-63
		County	WASHINGTON

VER 7-20-76

E. BALTIMORE ST

MUN 0 05 90

ALLEY MUN 0 00 62 #127

8 'J

10 'CW

Form 6 HPS (Rev. 1961)

AT

ROAD INVENTORY SHEET

Party Chief	R. VOUGHT	Road No.	~~8270~~ 6270
Recorder	L. COFFELT JR.	Name	ALLEY #127
Chainman		Sheet No.	1 OF 1
		Date	11-5-63
		County	WASHINGTON

VER 7-20-76

HAGER ← MUN 011 950 ← ST

ALLEY #126 MUN 6260 006

E BALTIMORE MUN 000 90 ST

8'J
10'CW

Form 6 HPS (Rev. 1961)

AT

ROAD INVENTORY SHEET

Party Chief R. VOUGHT
Recorder L. COFFELT JR.
Chainman

VER
7-20-76

Road No. ~~8280~~ 6280
Name ALLEY #128
Sheet No. 1 OF 1
Date 11-5-63
County WASHINGTON

ROAD. End		
0 16		
		8'E
E. ANTIETAM	ST	10'CW
MUN. 0 13	0030	8'J
		12'CW
E. BALTIMORE	ST	
MUN 000	90	

Form 6 HPS (Rev. 1961)

✓ AT

ROAD INVENTORY SHEET

Party Chief R. VOUGHT

Recorder L. COFFELT JR.

Chainman

VER. 7-20-76

Road No. ~~8290~~ 6290

Name ALLEY # 129

Sheet No. 1 OF 1

Date 11-5-63

County WASHINGTON

MILE MUN 0.11 1670 ST

0.09 60°

E BALTIMORE MUN

8'J

10'CW

0.00 90 ST

Form 6 HPS (Rev. 1961)

CS

ROAD INVENTORY SHEET

Party Chief R. VOUGHT
Recorder L. COFFELT JR.
Chainman

VER
7-20-76

Road No. ~~8300~~ 6300
Name ALLEY #130
Sheet No. 1 OF 1
Date 11-5-63
County WASHINGTON

(TRACK'S 2370	0.40	MUN	LA)	
~~ALLEY~~	0.21	~~END~~	90°	8' J 2-2' I SHD. 14' CW
RADCLIFFE MUN	0.18	2040	AVE	
	0.15		90°	
(TRACK'S MUN	0.00	2370	LA.)	8' J 10' CW

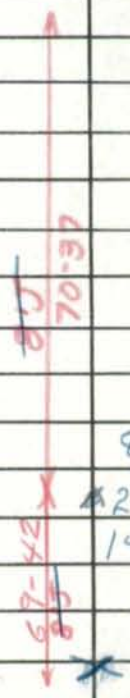

Form 6 HPS (Rev. 1961)

A+

ROAD INVENTORY SHEET

Party Chief ~~R. VOUGHT~~
Recorder
Chainman ~~L. COFFELT~~ JR.
HAGERSTOWN

VER
7-20-76

Road No. ~~8010~~ 6310
Name ALLEY #131
Sheet No. 1 OF 1
Date 11-8-63
County WASHINGTON

Road END	0.18		
GARLINGER		AVE	
MUN	0.12	890	
ALLEY #119			
MUN 6190	0.10		
ALLEY		#106	
MUN	0.04	6060	
			8' 'J
REYNOLDS		AVE	10 'CW
MUN	0.00	2090	

Form 6 HPS (Rev. 1961)

✓ A/T

ROAD INVENTORY SHEET

Party Chief	R. VOUGHT	Road No.	~~8320~~ 6320
Recorder	L. COFFELT JR.	Name	ALLEY #132
Chainman		Sheet No.	1 OF 1
	VER. 7-20-76	Date	11-5-63
		County	WASHINGTON

	S. CANNON MUN	020	~~330~~ ~~342~~ 330 Ave	
↑90°	~~X~~ 0.01 Rd. End. 8'J	017		8'J 12'CW
		005		
↑90°		004		12'H 14'CW
	S. CANNON MUN	000	~~330~~ ~~342~~ 330 Ave	

Form 6 HPS (Rev. 1961)

BB 84-12
Rm 4-26-85
C330

AT

ROAD INVENTORY SHEET

Party Chief R. VOUGHT
Recorder
Chainman L. COFFELT JR.

VER
7-20-76

Road No. ~~0330~~
Name ALLEY #133
Sheet No. 1 OF 1
Date 11-5-63
County WASHINGTON

S. Conway		Ave	
MUN.	0.07	0330	↑
↑65°	0.04		
			30'I
			40' cw
			~~8'-J~~
			~~8' cw~~
ALLEY		#134	
MUN	0.00	0340	↓

Form 6 HPS (Rev. 1961)

ROAD INVENTORY SHEET

Party Chief R. Vought
Recorder L. Coffelt, Jr.
Chainman

VER
7-20-76

Road No. ~~8340~~ 6340
Name Alley 134
Sheet No. 1 of 1
Date 11-5-63
County Wash.

	Matthews Ave	
Locust MUN →	0.22 →	St. 1430
One Way ↓		
Mulberry MUN	0.12	St. 1760 / 8'J 12' C.W.
	0.06	
	0.04	Alley 133 MUN 6330 / 12'H 14' C.W.
Ent. To Hospital	0.02	16'H 18' C.W.
S. Cannon MUN	0.00	Ave. ~~0340~~ 0330

8'J

Form 6 HPS (Rev. 1961)

AT

ROAD INVENTORY SHEET

Party Chief R. VOUGHT
Recorder L. COFFELT JR.
Chainman

VER. 7-10-76

HAGERSTOWN

Road No. ~~8350~~ 6350
Name ALLEY #135
Sheet No. 1 OF 1
Date 10-28-63
County WASHINGTON

W. IRVIN		AVE
MUN	0 25	~~1132~~ 1180
HILLCREST		AVE
MUN →	0 13	→ 1050
PARK		LA
MUN	000	1930

8'J
12'CW

Form 6 HPS (Rev. 1961)

AT

ROAD INVENTORY SHEET

Party Chief R. Vought
Recorder L. Coffelt, Jr.
Chainman

92-31
BB/AH
4-1-93
VER
2-19-76

Road No. ~~8360~~ C360
Name Alley 136
Sheet No. 1 of 1
Date 10-28-63
County Wash.

	Road End		
	0 19		
Freemont St. MUN	0 09	860	8'J 9'CW
Mechanic St. MUN	0 00	1630	8'J Curb Lt. 9'CW
MUN 1700		~~Mitchell St~~ KINSLOW ST	

Form 6 HPS (Rev. 1961)

A/T

ROAD INVENTORY SHEET

6370

Party Chief R. VOUGHT
Recorder L. COFFELT JR.
Chainman
HAGERSTOWN

VER
7-20-76

CM
A/T
83-13

Road No. ~~9370~~
Name ALLEY #137
Sheet No. 1 OF 1
Date 11-12-63
County WASHINGTON

S. PROSPECT ST
MUN. 005 2050

ONE WAY

W ANTIETAM
MUN.

000

ST
0030

12'H
C-C

Form 6 HPS (Rev. 1961)

ROAD INVENTORY SHEET

Party Chief R. VOUGHT
Recorder L. JOFFELT JR.
Chainman

HAGERSTOWN

VER 7-20-76

Road No. ~~8380~~ 6380
Name ALLEY #138
Sheet No. 1 OF 1
Date 10-28-63
County WASHINGTON

FREEMONT ST
MUN 0.08 860

Mechanic ST
MUN → 0.00 → 1700

8'J
10'CW

AT

Form 6 HPS (Rev. 1961)

ROAD INVENTORY SHEET

Party Chief	R. VOUGHT	Road No.	~~8390~~ 6390
Recorder	[illegible]FE[illegible]T JR.	Name	ALLEY #139
Chainman		Sheet No.	1 OF 1
		Date	11-5-63
	HAGERSTOWN VER 7-20-76	County	WASHINGTON

CRAMERS		ALLEY
MUN	0.29	9070
N. LOCUST		ST
MUN	0.19	ONE WAY 1430
W. MULBERRY		ST
MUN	0.09	ONE WAY 1760
N. CANNON		AVE
MU	0.00	0330

P.J
12 CW

Form 6 HPS (Rev. 1961)

12-31
BB-AH
4-1-93

AT ✓

ROAD INVENTORY SHEET

6400
~~8400~~

Party Chief R. VOUGHT
Recorder ~~L. COFFE~~LT JR.
Chainman

VER.
7-19-76

HAGERSTOWN

Road No. ~~8400~~
Name ALLEY #140
Sheet No. 1 OF 1
Date 10-28-63
County WASHINGTON

ALLEY MUN	0 17	#59 5590	11' J C-C
	0 15		10' J CURB-RT 'CW
McDowell MUN ←	0 13	← AVE 1590	
	0 09	ALLEY #141 MUN 610	
~~KINSLOW~~ Mitchell ~~MITCHELL~~ MUN →	0 05	~~ST~~ ~~AVE~~ Ave → 1690	8' J 10' CW
~~Kinslow~~ ~~MITCHELL~~ MUN	000	ST 1700	

✓ AT

Form 6 HPS (Rev. 1961)

ROAD INVENTORY SHEET

Party Chief R. VOUGHT
Recorder L. COFFELT JR.
Chainman

VER 7-19-76

HAGERSTOWN

Road No. ~~8410~~ 6410
Name ALLEY #141
Sheet No. 1 OF 1
Date 10-28-63
County WASHINGTON

LANDGON	
MUN 0.24 1330	ST
CARR	ST
MUN 0.15 350	
HAMMOND.	ST
MUN 0.04 980	
ALLEY	#140
MUN 0.00 6400	

8'J
10'CW

Form 6 HPS (Rev. 1961)

(G2-31)
4-1-93
BO/AH

AT

ROAD INVENTORY SHEET

Party Chief R. VOUGHT
Recorder L. COFFELT JR.
Chainman

HAGERSTOWN

VER
7-20-76

Road No. ~~8430~~ 6430
Name ALLEY #143
Sheet No. 1 OF 1
Date 10-28-63
County WASHINGTON

KINSLOW

~~MITCHELL~~ ST
MUN 003 1700

79+15

8' J
14' CW

ALLEY #144
MUN 000 6470

AT ✓

Form 6 HPS (Rev. 1961)

ROAD INVENTORY SHEET

C440

Party Chief R. VOUGHT
Recorder L. COFFELT JR.
Chainman
HAGERSTOWN

VER. 7-20-76

Road No. ~~8440~~
Name ALLEY # 144
Sheet No. 1 OF 1
Date 10-28-63
County WASHINGTON

Cook St
MUN 006 540

ALLEY # 143
MUN 6430 003

Salem Ave
MUN MD. 000 2200 SB

15' I 79-16

15' H
18' CW

Form 6 HPS (Rev. 1961)

✓ AT

ROAD INVENTORY SHEET

Party Chief R. Vought
Recorder L. Coffelt, Jr.
Chainman

VER 7-20-76

Road No. ~~8450~~ 6450
Name Alley 145
Sheet No. 1 of 1
Date 11-5-63
County Wash.

	JOHN ST 1220	
N. Locust MUN ←	0 11 1430 ←	St.
		8'J 12'C.W.
Cramers MUN	0 00 9070	Alley

Form 6 HPS (Rev. 1961)

ROAD INVENTORY SHEET

6460
~~8460~~

Party Chief R. VOUGHT
Recorder L. COFFELT JR.
Chainman

HAGERSTOWN

VER 7-20-76

Road No. ~~8460~~
Name ALLEY #146
Sheet No. 1 OF 1
Date 11-5-63
County WASHINGTON

CRAMER	ALLEY
MUN 0 20	9070
0 15	
N. LOCUST	ST.
MUN 0 10	1430
	ALLEY #204
0 07	7040
0 04	
N. MULBERRY	ST.
MUN 0 00	1760

8' J
12' CW

12' J
14' CW

10' J
12' CW

8' J
12' CW

Form 6 HPS (Rev. 1961)

AT

ROAD INVENTORY SHEET

Party Chief R. VOUGHT
Recorder L. COFFELT JR.
Chainman

HAGERSTOWN

VER 7-16-76

Road No. ~~8470~~ 6470
Name ALLEY # 147
Sheet No. 1 OF 1
Date 10-31-63
County WASHINGTON

#148
ALLEY
005
MUN 6480

8'J
12'CW

McKee Ave
MUN 000 1600

Form 6 HPS (Rev. 1961)

91-17 Ex #2
BB/SP
3-19-92

FCR-97
GD, MP
11/12/97

AT

ROAD INVENTORY SHEET

Party Chief R. VOUGHT
Recorder L. COFFELT JR.
Chainman

HAGERSTOWN

VER
7-16-76

Road No. ~~8430~~ C480
Name ALLEY #148
Sheet No. 1 OF 1
Date 10-31-63
County WASHINGTON

MULBERRY
~~IRVIN~~
~~END MULBERRY~~
MUN

~~PKWY~~ ~~Ave~~ AVE
0 33 ~~1170~~ ~~Ave~~ ~~1170~~ 1760

0 30 ALLEY #147
MUN 6470

0 27 35°

0 21 90°

~~IRVIN~~ AVE #2
MUN 0 18 1132

0 11 90°

8' J
12' CW

~~IRVIN~~
MUN

0 00 Ave ~~PKWY~~ ~~AVE~~
1170

Form 6 HPS (Rev. 1961)

ROAD INVENTORY SHEET

Party Chief R. VOUGHT
Recorder L. COFFELT JR.
Chainman

HAGERSTOWN

VER 7-16-76

Road No. ~~8500~~ 6500
Name ALLEY #150
Sheet No. 1 OF 1
Date 10-30-63
County WASHINGTON

PANGBORN MUN
0.31
BLVD 1900
0.28
300
ALLEY #151
MUN 6510
0.22
ALLEY #242
0.19
MUN 7420
HILL CREST
Rd
MUN
0.13
~~1060~~ 1062
AVE 1500
MANILA MUN
0.00

8'J
10'CW

Form 6 HPS (Rev. 1961)

AT

ROAD INVENTORY SHEET

Party Chief R. VOUGHT
Recorder ~~L. COFFELT~~ JR.
Chainman

VER. 7-16-76

HAGERSTOWN

Road No. ~~8510~~ 6510
Name ALLEY # 151
Sheet No. 1 OF 1
Date 10-30-63
County ~~WASHINGTON~~

MULBERRY	AVE
MUN 0.04 1760	
ALLEY	#150
MUN 0.80 6300	

8'J
14'CW

Form 6 HPS (Rev. 1961)

A/T

ROAD INVENTORY SHEET

Party Chief R. VOUGHT
Recorder L. COFFELT JR.
Chainman

HAGERSTOWN

VER 7-16-76

Road No. ~~8520~~ 6520
Name ALLEY #152
Sheet No. 1 OF 1
Date 10-30-63
County WASHINGTON

MANILA	AVE
MUN 0.29	1500
HILL CREST	RD
MUN 0.13	1060
0.03	90
MULBERRY	AVE
MUN 0.00	1760

8'S
12'CW

A/T

Form 6 HPS (Rev. 1961)

ROAD INVENTORY SHEET

Party Chief R. VOUGHT
Recorder L. COFFELT JR.
Chainman

VER
HAGERSTOWN 7-16-76

Road No. ~~8530~~ 6530
Name ALLEY #153
Sheet No. 1 OF 1
Date 10-30-63
County WASHINGTON

COLUMBIA AVE 0.37
MUN 490

E. IRVIN 0.16 AVE
MUN ~~1150~~ 1140

ALLEY #192
MUN 6920 0.04

E. MAGNOLIA ST
MUN 0.00 470

8'J
10'CW

Form 6 HPS (Rev. 1961)

AT

ROAD INVENTORY SHEET

Party Chief R. VOUGHT
Recorder L. COFFELT JR.
Chainman

VER. 7-16-76

HAGERSTOWN

Road No. ~~8540~~ 6540
Name ALLEY #154
Sheet No. 1 OF 1
Date 10-30-63
County WASHINGTON

ROAD	END
0.20	
E. HILL CREST	RD
MUN 0.17	1062
MANILA	AVE
MUN 0.00	1500

10' H
16' CW

8' J
12' CW

Form 6 HPS (Rev. 1961)

AT

ROAD INVENTORY SHEET

Party Chief	R. VOUGHT	Road No.	~~8560~~ 6560
Recorder	L. COFFELT JR.	Name	ALLEY #156
Chainman		Sheet No.	1 of 1
	HAGERSTOWN	Date	10-30-63
		County	WASHINGTON

VER 7-16-76

WOODLAND WAY

WOODLAND WAY

MUN 0 09 2650

ALLEY #240

0 05 MUN 7400

THE TERRACE

MUN 0 00 2360

67-43
8'5 12 CW

8' H
12' CW

Form 6 HPS (Rev. 1961)

A/T 87-20

AT

6570

ROAD INVENTORY SHEET

Party Chief R. VOUGHT
Recorder L. CORFELT JR.
Chainman

HAGERSTOWN

VER 7-16-76

Road No. ~~8570~~
Name ALLEY #157
Sheet No. 1 OF 1
Date 10-30-63
County WASHINGTON

MUN 1570

MAY 028 ST

~~ROAD END~~

021

W. IRVIN AVE

MUN 013 ~~1132~~ 1160

10.09

W HILLCREST RD

MUN 020 MU. 1060

68-45
9'J 13'CW

9'E
13'CW

8'J
14'CW

Form 6 HPS (Rev. 1961)

AT

ROAD INVENTORY SHEET

6580

Party Chief R. VOUGHT
Recorder L. COFFELT JR.
Chainman

VER
7-16-76

HAGERSTOWN

Road No. ~~8580~~
Name ALLEY #158
Sheet No. 1 OF 1
Date 10-30-63
County WASHINGTON

School Playground.
Road End.
0.21

8'E
12'CW

PARK LA.
MUN 0.16 1930

8'J
12'CW

~~Prospect AVE~~
~~MUN~~ 0.00 ~~2020~~

A CS ~~A~~

Form 6 HPS (Rev. 1961)

ROAD INVENTORY SHEET

Party Chief	R. VOUGHT	Road No.	~~8610~~ 6610
Recorder	L. COFFELT JR.	Name	ALLEY # 161
Chainman		Sheet No.	1 OF 1
	HAGERSTOWN VER 7-16-76	Date	10-30-63
		County	WASHINGTON

POTOMAC MUN	058	2000	AVE
	054		ONE WAY 390°
PROSPECT MUN	051	2020	AVE
PARK MUN	041	1930	LA
HILLCREST MUN	030	1062	RD #2
IRVIN MU	018	1132	AVE #2
ALLEY # 182 MUN 6820	004		
CYPRESS MUN	000	590	ST

73-26

~~8'E~~ 9'J ~~10'CW~~ 2-2'I SHD 14'CW

~~14'G~~ ~~18'CW~~

68-43 8'J 14'CW

68-44 8'J 14'CW

~~8'H~~ 14'CW

8'J 12'CW

Form 6 HPS (Rev. 1961)

AT

ROAD INVENTORY SHEET

Party Chief R. VOUGHT
Recorder L. COFFELT JR.
Chainman

HAGERSTOWN

VER 7-16-76

Road No. ~~8620~~ 6620
Name ALLEY #162
Sheet No. 1 OF 1
Date 10-30-63
County WASHINGTON

PROSPECT		AVE	
MUN	0.51	2020	
			10'H 14'CW
PARK			
MUN	0.45	1930 LA.	8'J 12'CW
	0.37		8'H 12'CW
HILLCREST			
MUN ~~1050~~	0.33	AVE 1062	
190°	0.04		
			8'J 10'CW
THE		TERRACE	
MUN	0.00	2360	

AT

Form 6 HPS (Rev. 1961)

ROAD INVENTORY SHEET

Party Chief R. VOUGHT
Recorder L. COFFELT JR.
Chainman
HAGERSTOWN

VER 7-16-76

Road No. ~~8630~~ 6630
Name ALLEY #163
Sheet No. 1 OF 1
Date 11-4-63
County WASHINGTON

GATE
0.08

10'H
12'CW

0.04 90°

14'H
22'CW

FOREST ST #2 ~~DR~~ SPUR
MUN 0.00 832

Form 6 HPS (Rev. 1961)

AT

ROAD INVENTORY SHEET

Party Chief R. VOUGHT
Recorder L. COFFELT JR.
Chainman

HAGERSTOWN

VER. 7-20-76

Road No. ~~8680~~ 6680
Name ALLEY #168
Sheet No. 1 OF 1
Date 11-12-63
County WASHINGTON

Road End			
	0.06		
			12'E
Bester		ST	14'W
MUN	0.04	MU-0150	
			8'J
Bromert		Ave	10'W
MUN	0.00	250	

Form 6 HPS (Rev. 1961)

ROAD INVENTORY SHEET

Party Chief R. VOUGHT
Recorder ~~L. COFFELT~~ JR.
Chainman
HAGERSTOWN

VER 7-20-76

Road No. ~~8710~~ C710
Name ALLEY # 171
Sheet No. 1 OF 1
Date 11-12-63
County WASHINGTON

Alley	#3	
MUN	.05 5030	
		8 J
Cromers	Alley #2	10 CW
MUN	~~.00~~ ~~9080~~ 9082 @ .08	

Form 6 HPS (Rev. 1961)

AT

ROAD INVENTORY SHEET

Party Chief
Recorder R. VOUGHT
Chainman L. COFFELT JR.

HAGERSTOWN

VER. 7-20-76

Road No. ~~8720~~ 6720
Name ALLEY #172
Sheet No. 1 OF 1
Date 11-12-63
County WASHINGTON

CROMERS	ALLEY	
005		
		8 'J
ALLEY	#3	10 'CW
000		

Form 6 HPS (Rev. 1961)

AT

ROAD INVENTORY SHEET

Party Chief R. VOUGHT
Recorder L. COFFELT JR.
Chainman

VER
7-20-76

Road No. C730 ~~8730~~
Name ALLEY #173
Sheet No. 1 OF 1
Date 11-5-63
County WASHINGTON

Road End.
0.04

9'H
11'W

S. LOCUST ST

MUN 0.00 1930

Form 6 HPS (Rev. 1961)

ROAD INVENTORY SHEET

Party Chief	R. VOUGHT	Road No.	~~8740~~ C740
Recorder	L. COFFELT JR.	Name	ALLEY #174
Chainman		Sheet No.	1 OF 1
		Date	11-5-63
		County	WASHINGTON

2001 MU EX #4
3-14-02
GD/EF

VER
7-20-76

AT

E. BALTIMORE ST

MUN 0 09 90

↑90° Cem. 0 05 8' I

10' CW

0 03 ~~90°~~

~~16' E~~

~~22' CW~~

~~BIXLERS ALLEY~~

~~MU ROAD 0 00 END 9020~~

Form 6 HPS (Rev. 1961)

AT

ROAD INVENTORY SHEET

6750

Party Chief R. VOUGHT
Recorder L. COFFELT JR.
Chainman

HAGERSTOWN

VEQ. 7-20-76

CM A/T 83-14

Road No. ~~8750~~
Name ALLEY #175
Sheet No. 1 OF 1
Date 11-12-63
County WASHINGTON

	S. PROSPECT		ST
	MUN	0 10	2030
↑90°		0 05	
			8'J
	W. ANTIETAM		ST
	MUN.	0 00	0030

S. Walnut St #2

MU 8472

AT

Form 6 HPS (Rev. 1961)

ROAD INVENTORY SHEET

Party Chief R. VOUGHT
Recorder L. COFFELT JR.
Chainman

HAGERSTOWN

VER 7-20-76

Road No. ~~8760~~ 6760
Name ALLEY #176
Sheet No. 1 OF 1
Date 10-31-63
County WASHINGTON

BLOOMS ALLEY
MUN 006 9030

8'J 79-18

8'J
12'CW

W. NORTH AVE ~~ST~~
MU 000 1790

AT

Form 6 HPS (Rev. 1961)

ROAD INVENTORY SHEET

Party Chief R. VOUGHT
Recorder L. COFFELT JR.
Chainman

HAGERSTOWN

VER. 7-16-76

Road No. ~~8770~~ 6770
Name ALLEY #177
Sheet No. 1 OF 1
Date 10-30-63
County WASHINGTON

NORTHERN AVE
MUN CR 015 255 MUN

COUNTRY CLUB RD.
MUN 000 560

8'J
11'CW

Form 6 HPS (Rev. 1961)

A/T.

ROAD INVENTORY SHEET

6780

Party Chief R. VOUGHT
Recorder L. COFFELT JR.
Chainman

VER 7-20-76

HAGERSTOWN

Road No. ~~8780~~
Name ALLEY #178
Sheet No. 1 OF 1
Date 10-31-63
County WASHINGTON

W. NORTH Ave.
MUN 0.29 1790

SUMANS Ave.
MUN 2280 0.10

0.02 90°

PENDA. Ave
MUN. ~~US~~ → 0.00 → #1960

8' J
12' CW

Form 6 HPS (Rev. 1961)

AT

ROAD INVENTORY SHEET

6790

Party Chief R. VOUGHT

Recorder L. COFFELT JR.

Chainman

HAGERSTOWN

VER. 7-20-76

Road No. ~~8790~~

Name ALLEY #179

Sheet No. 1 OF 1

Date 10-31-63

County WASHINGTON

HAMILTON LA.

MUN 005 970

8' J

12' CW

BOWARD ST

MUN 000 190

✓ AT

Form 6 HPS (Rev. 1961)

ROAD INVENTORY SHEET

Party Chief	R. VOUGHT	Road No.	~~8800~~ 6800
Recorder	L. COFFELT JR.	Name	ALLEY #180
Chainman		Sheet No.	1 OF 1
		Date	10-31-63
	HAGERSTOWN	County	WASHINGTON

VER 7-20-76

Penna Ave

US. 010 11

90° 006

PENMAR Ave

000

~~68-46~~ 8'J 12' CW

8'E 12' CW

AT

Form 6 HPS (Rev. 1961)

ROAD INVENTORY SHEET

6810 ✓

Party Chief R. VOUGHT
Recorder L. COFFELT JR.
Chainman

HAGERSTOWN

VER. 7-16-76 NS
82-26 CM

Road No. ~~8810~~
Name ALLEY #181
Sheet No. 1 OF 1
Date 10-30-63
County WASHINGTON

ALLEY	#182
MUN 0	23 6820
COUNTRY CLUB	RD
MUN 0	13 560
NORTHERN	AVE
MUN Co. 0	00 1810 ~~255~~ MUN

9'I
12'CW
8'J
12'CW

Form 6 HPS (Rev. 1961)

AT

ROAD INVENTORY SHEET

6820

Party Chief R. VOUGHT
Recorder L. COFFELT JR.
Chainman

HAGERSTOWN

VER 7-16-76

82-27 NS CM

Road No. ~~8820~~
Name ALLEY #182
Sheet No. 1 OF 1
Date 10-30-63
County WASHINGTON

CYPRESS		ST
MUN	0+24	590
ALLEY #183		
MUN 6830	0+22	
MAGNOLIA		ST
MUN	0+19	1470
	0+16	90°
		ALLEY #181
	0+15	MUN 6810
	0+13	90° 8'J 12'CW
MAGNOLIA	0+12	ST X 8'H
MUN	0+11	1470 X 12'CW
ALLEY #183		
MUN 6830	0+08	
CYPRESS		ST
MUN	0+05	590
	0+01	90° 8'J 12'CW
ALLEY		#161
MUN	0+00	660

AT ✓

Form 6 HPS (Rev. 1961)

ROAD INVENTORY SHEET

6830

Party Chief R. VOUGHT
Recorder L. COFFELT JR.
Chainman

HAGERSTOWN

VER. 7-16-76

Road No. ~~8830~~
Name ALLEY #183
Sheet No. 1 OF 1
Date 10-30-63
County WASHINGTON

ALLEY	# 182
MUN 003 6820	
ALLEY	# 182
MUN 000 6820	

8'J
10'CW

Form 6 HPS (Rev. 1961)

AK ✓

ROAD INVENTORY SHEET

Party Chief R. Vought	Road No. ~~8840~~ 6840
Recorder L. Coffelt, Jr.	Name Alley 18K
Chainman	Sheet No. 1 of 1
	Date 10-30-63
VER. 7-16-76	County Wash.

	Alley 18S 6850		
Country Club MUN	0.15	560 Rd.	^
↰90°	0.06		
	0.04	90° ↱	8' T 12' CW.
May MUN	0.00	1570 St.	∨

Form 6 HPS (Rev. 1961)

ROAD INVENTORY SHEET

6850 ✓ DI CS✓

Party Chief R. Vought
Recorder L. Coffelt Jr.
Chainman

VER 7-16-76

Road No. ~~9850~~
Name Alley 185
Sheet No. 1 of 1
Date 10-30-63
County Wash.

MUN NORTHERN	0 11	1810 AVE	8'-J 64-9
	0 10		
		8'-J 12'CW 64-9	8'E 12'CW.
	0 06		
		8'-J 12'CW 64-9	~~12'E~~ 16'CW.
Country Club	0 00	560 Rd.	
MUN MUN 6840	← ALLEY 184		

Form 6 HPS (Rev. 1961)

ROAD INVENTORY SHEET

Party Chief R. VOUGHT
Recorder L. COFFELT JR.
Chainman

HAGERSTOWN

VER 7-16-76

Road No. ~~8860~~ 6860
Name ALLEY #186
Sheet No. 1 OF 1
Date 10-30-63
County WASHINGTON

ALLEY	#188
0.33	
MUN	6880
(W. IRVIN	AVE. #2)
MUN 0.21	~~1130~~ 1132
(W. HILL CREST	Rd #2)
0.09	
MUN	1060 2
PARK	LA.
MUN 0.00	1930

8'J
12'CW

Form 6 HPS (Rev. 1961)

AT

ROAD INVENTORY SHEET

Party Chief ~~R. VOUGHT~~
Recorder ~~L. COFFELT~~ JR.
Chainman

VER 7-16-76

HAGERSTOWN

CM A/T 83-19

Road No. 6870 ~~8870~~
Name ALLEY #187
Sheet No. 1 OF 1
Date 10-30-63
County WASHINGTON

E MAGNOLIA		ST
MUN	0.13	1490
ALLEY #190		
MUN 6900	0.10	
Cypress		ST
MUN	0.08	590
ALLEY #189		
MUN 6890	0.05	
~~LAUREL MUN~~		
	0.00	~~ST 1350~~

8' J
12' CW

AT

Form 6 HPS (Rev. 1961)

ROAD INVENTORY SHEET

Party Chief R. VOUGHT
Recorder L. COFFELT JR.
Chainman

HAGERSTOWN

VER 7-16-76

Road No. ~~8880~~ 6880
Name ALLEY # 188
Sheet No. 1 OF 1
Date 10-31-63
County WASHINGTON

Road End.

020

E. MAGNOLIA ST
MUN 017 1470

ALLEY 190
014 MUN 6900

CYPRESS ST
MUN 011 590

↑90°

004

ALLEY #186
MUN 6860 003

FRY AVE ~~ST~~
MUN 000 880

8'E 10'CW

8'J 12'CW

Form 6 HPS (Rev. 1961)

ROAD INVENTORY SHEET

C890

Party Chief R. VOUGHT
Recorder L. COFFELT JR.
Chainman

VER 7-16-76

HAGERSTOWN

Road No. ~~8890~~
Name ALLEY # 189
Sheet No. 1 OF 1
Date 10-31-63
County WASHINGTON

	#182
ALLEY MUN 004	6870
LAUREL	ST
MUN 000	1350

8'J
12'CW

Form 6 HPS (Rev. 1961)

AT

ROAD INVENTORY SHEET

Party Chief R. VOUGHT
Recorder L. COFFELT JR.
Chainman

VER
7-16-76

HAGERSTOWN

Road No. ~~8900~~ 6900
Name ALLEY # 190
Sheet No. 1 OF 1
Date 10-31-63
County WASHINGTON

ALLEY #188
MUN 006 6890

8'6
12'CW

ALLEY #187
MUN 010 6870

Form 6 HPS (Rev. 1961)

ROAD INVENTORY SHEET

Party Chief ~~R. VOUGHT~~
Recorder ~~L. COFFELT~~ JR.
Chainman

VER
7-20-76

HAGERSTOWN

Road No. ~~8910~~ 6910
Name ALLEY #191
Sheet No. 1 OF 1
Date 10-31-63
County WASHINGTON

BROADWAY

MU 0.10 0240

ALLEY #201

MUN 7010 0.05

8'J
12'CW

0.02

11'J
13'CW

NORTH AVE

MUN 0.00 1790

AT

Form 6 HPS (Rev. 1961)

ROAD INVENTORY SHEET

6920

Party Chief R. VOUGHT
Recorder L. COFFELT J...
Chainman

HAGERSTOWN

VER 7-16-76

Road No. ~~8920~~
Name ALLEY #192
Sheet No. 10F1
Date 10-31-63
County WASHINGTON

~~X.~~ 0.06 IRVIN ~~ST~~ AVE	
MUN 11~~X~~0 3	
	#153
ALLEY MUN 000 6530	

8:J
12 KW

AT

Form 6 HPS (Rev. 1961)

ROAD INVENTORY SHEET

Party Chief R. VOUGHT
Recorder L. COFFELT JR.
Chainman

VER 7-20-76

HAGERSTOWN

Road No. ~~8930~~ C930
Name ALLEY #193
Sheet No. 1 OF 1
Date 10-31-63
County WASHINGTON

FAIRGROUND AVE
MUN 005 780
Alley #194
MUN 6940 003
McCamas ST
MUN 000 1580

8'J
12'CW

Form 6 HPS (Rev. 1961)

ROAD INVENTORY SHEET

Party Chief R. VOUGHT
Recorder L. DOFFELT JR.
Chainman

HAGERSTOWN

VER 7-20-76

Road No. ~~8940~~ 6940
Name ALLEY # 194
Sheet No. 1 OF 1
Date 10-31-63
County ~~WASHINGTON~~

ALLEY #193
MUN 0.13 6930

N. LOCUST ST
MUN 0.07 1430

ALLEY #195
MUN 0.00 6950

8' J
12' CW

Form 6 HPS (Rev. 1961)

AT

ROAD INVENTORY SHEET

Party Chief R. VOUGHT
Recorder L. COFFELT JR.
Chainman

HAGERSTOWN

VER 7-20-76

Road No. ~~8950~~ C950
Name ALLEY #195
Sheet No. 1 OF 1
Date 10-31-63
County WASHINGTON

AT 84-13

BROADWAY

MUN 0 27 0240

ALLEY #196

0 24 MUN 6960

WAYSIDE AVE

MUN 0 17 2540

ALLEY #200

0 12 MUN 7000

FAIRGROUND AVE

MUN 0 06 780

ALLEY #194

0 03 MUN 6940

McCOMAS ST.

MUN 0 40 1580

9'J CURB RT 12'CW

8'J 10'CW

Form 6 HPS (Rev. 1961)

ROAD INVENTORY SHEET

Party Chief R. VOUGHT
Recorder L. DEFFALT JR.
Chainman

HAGERSTOWN

VER 7-20-76

Road No. ~~8960~~ 6960
Name ALLEY #196
Sheet No. 1 OF 1
Date 10-31-63
County WASHINGTON

78-22

N. LOCUST ST

MUN → 006 → 1430

ALLEY #195

MUN 000 6950

8'J
12'CW

Form 6 HPS (Rev. 1961)

A/T

6970 ✓

ROAD INVENTORY SHEET

Party Chief R. VOUGHT
Recorder L. DEFELT JR.
Chainman

VER
7-20-76

HAGERSTOWN

Road No. ~~8970~~
Name ALLEY #197
Sheet No. 1 OF 1
Date 10-31-63
County ~~WASHINGTON~~

N. LOCUST ST
MUN ← 011 ← 1430

ALLEY #198
MUN 6980 008

8'J
12'CW

CORNER ALLEY
MUN 000 9070 ✓

Form 6 HPS (Rev. 1961)

ROAD INVENTORY SHEET

Party Chief R. VOUGHT
Recorder L. COFFELT JR.
Chainman

VER. 7-20-76

HAGERSTOWN

Road No. ~~6980~~ C980
Name ALLEY #198
Sheet No. 1 OF 1
Date 10-31-63
County WASHINGTON

WAYSIDE AVE
MUN → 006 → 2540

ALLEY #197
MUN 000 6970

8'J
10'CW

Form 6 HPS (Rev. 1961)

AT

ROAD INVENTORY SHEET

6990

Party Chief R. VOUGHT
Recorder L. COFFELT JR.
Chainman

HAGERSTOWN

VER
7-20-76

Road No. ~~8990~~
Name ALLEY # 199
Sheet No. 1 OF 1
Date 10-31-63
County ~~WASHINGTON~~

School PLAYGROUND
Road End
003

10'6
14'CW

001

10'J
8'H SHOLT
22'CW

WAYSIDE Ave
MUN 000 2540

A/T ✓

Form 6 HPS (Rev. 1961)

ROAD INVENTORY SHEET

Party Chief R. VOUGHT
Recorder L. COFFELT JR.
Chainman

VER 7-20-76

HAGERSTOWN

Road No. 7000
Name ALLEY # 200
Sheet No. 1 OF 1
Date 10-31-63
County WASHINGTON

ALLEY		# 195
MUN	0.15	6950
N. LOCUST		ST
MUN	0.08	1430
		ALLEY
CRAMER MUN	0.10	9070

79-29

8'J
12'CW

Form 6 HPS (Rev. 1961)

ROAD INVENTORY SHEET

Party Chief ~~R. VOUGHT~~
Recorder ~~L. COFFELT~~ JR.
Chainman

VER 1-20-76

HAGERSTOWN

Road No. 7010
Name ALLEY #201
Sheet No. 1 OF 1
Date 10-31-63
County ~~WASHINGTON~~

ALLEY #191
MUN 0.18 6910

8'J
12'CW

0.13

N. LOCUST ST
MUN 0.10 1430

10'J
12'CW

0.09

8'J
10'CW

CRAMER ALLEY
MUN 0.80 9070

Form 6 HPS (Rev. 1961)

4T

ROAD INVENTORY SHEET

Party Chief ~~R. VOUGHT~~
Recorder ~~L. COFFELT~~ JR.
Chainman

HAGERSTOWN

VER 7-20-76

Road No. 7020
Name ALLEY #202
Sheet No. 1 OF 1
Date 10-31-63
County WASHINGTON

N. MULBERRY ST
MUN → 0 11 → 1760

8' J
12' CW

0 05

10' J
12' CW

0 03

8' J
10' CW

N. LOCUST ST
MUN ← 2 00 ← 1430

Form 6 HPS (Rev. 1961)

AT

ROAD INVENTORY SHEET

Party Chief R. VOUGHT
Recorder L. COFFELT JR.
Chainman

HAGERSTOWN

VER 7-20-76

Road No. 7030
Name ALLEY #203
Sheet No. 1 OF 1
Date 10-31-63
County WASHINGTON

N. LOCUST ST
MUN → 010 → 1430

N. MULBERRY ST
MUN ← 000 ← 1760

8'J
12'CW

AT

Form 6 HPS (Rev. 1961)

ROAD INVENTORY SHEET

Party Chief R. VOUGHT
Recorder L. COFFELT JR.
Chainman

VER 7-20-76

HAGERSTOWN

Road No. 7040
Name ALLEY # 204
Sheet No. 1 OF 1
Date 11-5-63
County WASHINGTON

RANDOLPH AVE
MUN → 0.05 → 2050

9'E 10'W 174.3

C'E 10'CW

ALLEY 0.00 #146
MUN 6460

Form 6 HPS (Rev. 1961)

AT

ROAD INVENTORY SHEET

Party Chief R. VOUGHT
Recorder L. COFFELT JR.
Chainman

VER
7-20-76

Road No. 7050
Name ALLEY #205
Sheet No. 1 OF 1
Date 11-5-63
County WASHINGTON
78-20

	ST	
Jefferson MUN	0.04 1210	
		8 'J
		10 'CW
	0.02	
		10K
	AVE	10CW
EAST MUN	0.00 690	

Form 6 HPS (Rev. 1961)

AT

ROAD INVENTORY SHEET

Party Chief ~~R. VOUGHT~~
Recorder
Chainman ~~L. COFFELT~~ JR.

HAGERSTOWN

VER
7-20-16

Road No. 7060
Name ALLEY #206
Sheet No. 1 OF 1
Date 11-13-63
County WASHINGTON

JEFFERSON		ST	
MUN	0.15	1210	
			10'J
			10'CW
	0.13		
ALLEY #207			
MUN 7070	0.12		
N. CANNON ~~NORTH~~		AVE ~~AVE~~	8'J
MV	0.00	~~1790~~ 0330	10'CW

Form 6 HPS (Rev. 1961)

AT

ROAD INVENTORY SHEET

Party Chief R. VOUGHT
Recorder L. COFFELT JR.
Chainman

HAGERSTOWN

VER. 7-20-76

Road No. 7070
Name ALLEY #201
Sheet No. 1 OF 1
Date 11-13-63
County WASHINGTON

CANNON		AVE.	
MUN.	0.04	0330	
			8'6
			12'CW
	0.03		
			8'6
ALLEY		206	12'CW
MU	0.00	7060	

Form 6 HPS (Rev. 1961)

87-18 AT
A/T

ROAD INVENTORY SHEET

Party Chief R. VOUGHT
Recorder L. COFFELT JR.
Chainman

VER.
7-20-76

HAGERSTOWN

Road No. 7080
Name ALLEY # 208
Sheet No. 1 OF 1
Date 11-13-63
County WASHINGTON

JEFFERSON		ST	
MUN	0.13	1210	
↑90°	0.03		
N.		CANNON	S.J
~~N. NORTH AVE.~~		~~N. CANNON~~ Ave	10cw
MU ~~1790~~	0.00	~~MU0330~~ ~~1790~~ 0330	

Form 6 HPS (Rev. 1961)

AT

ROAD INVENTORY SHEET

Party Chief R. VOUGHT
Recorder L. COFFELT JR.
Chainman

VER
7-20-76

Road No. 7090
Name ALLEY #209
Sheet No. 1 OF 1
Date 11-5-63
County WASHINGTON

WOOD.		ST	
MUN	0.17	2640	
CLEVELAND.		Ave	
MUN	0.08	480	
			8' J
VISTA		ST	10' CW
MUN	0.06	2470 ONE WAY	
		ALLEY #212	
	0.03	MUN 7120	
			8' H
VALE		ST	10' CW
MUN	0.00	2390	

67-36
8' J 10' CW

Form 6 HPS (Rev. 1961)

CS

ROAD INVENTORY SHEET

Party Chief ~~R. VOUGHT~~
Recorder
Chainman ~~L. COFFELT~~ JR.

VER
7-20-76

Road No. 7100
Name ALLEY # 210
Sheet No. 1 OF 1
Date 11-5-63
County WASHINGTON

JEFFERSON		ST	
MD ~~MUN~~	0.16	~~1210~~ ~~64~~ 64	
			8'J
LIBERTY		ST	10'CW
MUN →	0.06	→ 1390	
			8' x I
E. FRANKLIN		ST	10'CW
MUN	0.00	840	

Form 6 HPS (Rev. 1961)

AT

ROAD INVENTORY SHEET

Party Chief R. VOUGHT
Recorder L. COFFELT JR.
Chainman

VER
7-20-2

Road No. 7110
Name ALLEY #211
Sheet No. 1 OF 1
Date 11-5-63
County WASHINGTON

88-24 11-28-88

N. Cannon Ave.
MU 021 0330

8'J
12'LW

N. Cleveland Ave
MD ~~MUN~~ 000 ~~480~~ 64

Form 6 HPS (Rev. 1961)

AT

ROAD INVENTORY SHEET

Party Chief R. VOUGHT
Recorder L. COFFELT JR.
Chainman

VER
7-20-76

Road No. 7120
Name ALLEY # 212
Sheet No. 1 OF 1
Date 11-5-63
County WASHINGTON

ALLEY MUN	0.09	# 209 7090	
SECURITY MUN	0.00	Rd. 2210	8 'J 10 'CW

Form 6 HPS (Rev. 1961)

AT

ROAD INVENTORY SHEET

Party Chief R. VOUGHT
Recorder L. COFFELT JR.
Chainman

VER
7-20-76

Road No. 7130
Name ALLEY #213
Sheet No. 1 OF 1
Date 11-5-63
County WASHINGTON

E. FRANKLIN		ST	
MUN	0.05	BAD	
		ALLEY #214	
	0.03	MUN 7140	8'J 10'CW
LIBERTY		ST	
MUN	0.00	7390	

Form 6 HPS (Rev. 1961)

AT

ROAD INVENTORY SHEET

Party Chief R. VOUGHT
Recorder L. COFFELT JR.
Chainman

VER
7-20-76

Road No. 7140
Name ALLEY #214
Sheet No. 1 OF 1
Date 11-5-63
County WASHINGTON

ALLEY		#213	
MUN	0.08	7130	
			8'J
ALLEY		~~214A~~ 231	10'CW
MUN	0.00	7310	

Form 6 HPS (Rev. 1961)

AT

ROAD INVENTORY SHEET

Party Chief R. VOUGHT
Recorder L. COFFELT JR.
Chainman

HAGERSTOWN

VER.
7-20-76

Road No. 7160
Name AHEY #216
Sheet No. 1 OF 1
Date 11-8-63
County WASHINGTON

ARMSTRONG		Ave	
Co 414	0 28	MV	~~XX~~ 0050
MARION		ST	
MUN CO	0 17	412 MUN	
	0 05	90°	
			8'J
VIRGINIA		AVE	10'CW
US	000	"	

Form 6 HPS (Rev. 1961)

88-24 A/T

ROAD INVENTORY SHEET

Party Chief R. VOUGHT
Recorder L. COFFELT JR.
Chainman

HAGERSTOWN

VER 7-20-76

Road No. 7170
Name ALLEY #217
Sheet No. 1 OF 1
Date 11-8-63
County WASHINGTON

	Road.	End		
		0 30		8'E
S	MARION		AVE	10'CW
	Co.	0 24	412	~~8'E~~
↑				~~10'CW~~
	APP CORP	0 21	LMTS HAGERSTOWN	
				8'J
	MOLLER		Ave	10'CW
	Co MUN	0 14	413 MUN	
↑90°		0 06		
				8'H
	VIRGINIA		Ave	10'CW
	US	0 00	"	

OP 195

MUN

Form 6 HPS (Rev. 1961)

AT

ROAD INVENTORY SHEET

Party Chief R. VOUGHT
Recorder L. COFFELT JR.
Chainman

VER
7-20-76

Road No. 7180
Name ALLEY #218
Sheet No. 1 OF 1
Date 11-5-63
County WASHINGTON

E. WASHINGTON	ST	
MUN 0.10	2STD	
		8' J
E. FRANKLIN	ST	10' CW
MUN 0.00	2LD	

Form 6 HPS (Rev. 1961)

OP 221 A/T

ROAD INVENTORY SHEET

Party Chief	R. VOUGHT	Road No.	7190
Recorder	L. COFFELT JR.	Name	ALLEY #219
Chainman		Sheet No.	1 OF 1
		Date	11-5-63
		County	WASHINGTON

VER 7-14-76

BROOKLINE		AVE	
MUN	0.13 (0.10)	260	
APP CORP LMTS	0.03 (~~0.00~~)	HAGERSTOWN	
DIVISION		AVE	
OP ~~CO~~	0.00	~~384~~ 139	
MUN		660	

MUN.

OP 221

8' J
12' CW

8' E
12 CW

Form 6 HPS (Rev. 1961)

OP 222 ✓ AT

ROAD INVENTORY SHEET

Party Chief	R. VOUGHT	Road No.	7200
Recorder	L. COFFELT JR.	Name	ALLEY #220
Chainman		Sheet No.	1 OF 1
		Date	11-5-63
		County	WASHINGTON

VER. 7-16-76

N

ALLEY #244			
MUN 740	0 24 (0.11)		
BROOKLINE		AVE	
MUN	0 21	260	8'J
			12'CW
APP CORP	0 13 (0.00	LMTS HAGERSTOWN	
			8'E
DIVISION		AVE	10'CW
CO	0 08	384	8'D
~~MUN~~		~~760~~	10'CW
	0 00		
Road	End		

MUN

OP 222

Form 6 HPS (Rev. 1961)

ROAD INVENTORY SHEET

Party Chief R. VOUGHT
Recorder L. COFFELT JR.
Chainman

VER 7-16-76

Road No. 7210
Name ALLEY #221
Sheet No. 1 OF 1
Date 11-5-63
County WASHINGTON

ROAD END

0 13

APP CORP LMTS HAGERSTOWN

0 09

BROOKLINE AVE

MUN 0 04 260

ALLEY #244

MUN 7440 0 00

PVT

MUN

8'E
10'CW

8 H
10'CW

8'J
12'CW

A/T

Form 6 HPS (Rev. 1961)

ROAD INVENTORY SHEET

Party Chief R. VOUGHT
Recorder L. COFFELT JR.
Chainman

HAGERSTOWN

VER. 7-16-76

Road No. 7220
Name ALLEY #222
Sheet No. 1 OF 1
Date 10-30-63
County WASHINGTON

CALVERT MUN 0.10	TERR 320
0.08	300
0.05	Alley #232 MUN 320
E. MAGNOLIA MUN 0.00	ST 1470

8.J
12.CW

Form 6 HPS (Rev. 1961)

ROAD INVENTORY SHEET

Party Chief R. VOUGHT
Recorder L. COFFELT JR.
Chainman

HAGERSTOWN

VER. 7-16-76

A/T 83-20

Road No. 7230
Name ALLEY #223
Sheet No. 1 OF 1
Date 10-30-63
County WASHINGTON

ALLEY	#233
MUN 003	7330
VIEW	ST
MUN 000	7420

9'H
12'CW

Form 6 HPS (Rev. 1961)

91-17 Ex#2 AT
BB/SP
3-19-92

ROAD INVENTORY SHEET

Party Chief R. VOUGHT
Recorder L. COFFELT JR.
Chainman
HAGERSTOWN

VER
7-16-76

Road No. 7240
Name ALLEY #224
Sheet No. 1 OF 1
Date 10-30-63
County WASHINGTON

Mealey ~~Irvin~~		PKWY	
MUN	011	~~[illegible]~~ 1620 (91-17 Ex#2)	
			8'H 12'CW
	006		12'H 12'CW
	003		8'H 12'CW
~~X~~ IRVIN		AVE	
MUN	000	~~[illegible]~~ 1130	

Form 6 HPS (Rev. 1961)

A/T 87-19 ✓ AT

ROAD INVENTORY SHEET

Party Chief R. VOUGHT
Recorder L. COFFELT JR.
Chainman

HAGERSTOWN

VER. 7-19-76

Road No. 7250
Name ALLEY #225
Sheet No. 1 OF 1
Date 10-28-63
County WASHINGTON

RHODE ISLAND		Ave.
MUN	0 28	2100
		ALLEY ~~#~~ #260
	0 24	MUN 7600
INDIANA		Ave
MUN	0 21	~~MUN~~ 1110
		ALLEY 226
	0 17	MUN 7260
Vermont		Ave
MUN	0 14	2410
		ALLEY #243
	0 11	MU 7430
Michigan		Ave
MUN	0 07	1660
		ALLEY ~~Ca~~ #1
	0 04	MUN 5010
WYOMING		AVE
MUN	0 00	2660

8'E
12'CW

8'J
10'CW

✓ CS ✓

Form 6 HPS (Rev. 1961)

ROAD INVENTORY SHEET

Party Chief R. VOUGHT
Recorder L. COFFELT JR.
Chainman

VER. 7-19-76

HAGERSTOWN

Road No. 7260
Name ALLEY #226
Sheet No. 1 of 1
Date 10-28-63
County WASHINGTON

80-11

ALLEY		#225
MUN	0 08	7250
CONNECTICUT		AVE
MUN	000	530

8' H
10' CW

Form 6 HPS (Rev. 1961)

AT

ROAD INVENTORY SHEET

Party Chief R. VOUGHT
Recorder L. COFFELT JR.
Chainman

VER.
7-16-76

Road No. 7270
Name ALLEY #227
Sheet No. 1 OF 1
Date 11-5-63
County WASHINGTON

VALE		ST	
MUN	0.08	0.04 2390	
190°	0.05		
			8'J
			12'CW
SECURITY		Rd	
Co MUN	0.00	378 MUN	

Form 6 HPS (Rev. 1961)

AT

ROAD INVENTORY SHEET

Party Chief R. VOUGHT
Recorder L. COFFELT JR.
Chainman

HAGERSTOWN

VER. 7-19-76

Road No. 7280
Name ALLEY # 228
Sheet No. 1 OF 1
Date 11-12-63
County WASHINGTON

E. FIRST ~~TOMBSTONE~~		ST	
MU	016	0800	
			10' J
Ravenswood MUN	000	2070 DR.	12' CW

Form 6 HPS (Rev. 1961)

91-17 EX #2 A/T
BB/SP
3-14-92

AT

ROAD INVENTORY SHEET

Party Chief R. VOUGHT
Recorder L. COFFELT JR.
Chainman

HAGERSTOWN

VER
7-16-76

Road No. 7290
Name ALLEY # 229
Sheet No. 1 OF 1
Date 10-31-63
County WASHINGTON

MEALY 0 16 PKWY
MUN 1620

90° 0 05

0 04 90

8'J
12'CW

E. MAGNOLIA ST
MUN 800 1470

Form 6 HPS (Rev. 1961)

AT

ROAD INVENTORY SHEET

Party Chief R. VOUGHT
Recorder L. COFFELT JR.
Chainman
HAGERSTOWN

VER 7-16-76

Road No. 7300
Name ALLEY #230
Sheet No. 1 OF 1
Date 10-30-63
County WASHINGTON

LINDEN AVE
MUN 0 10 1410

0 07 30°

0 06 60°

0 04 90°

8'J
12'CW

LINDEN AVE
MUN 0 00 1410

Form 6 HPS (Rev. 1961)

AT

ROAD INVENTORY SHEET

Party Chief R. VOUGHT
Recorder L. COFFELT JR.
Chainman

VER 7-20-76

Road No. 7310
Name ALLEY 231
Sheet No. 1 OF 1
Date 11-5-63
County WASHINGTON

LIBERTY	ST	
MUN 006	1390	
	ALLEY # 214	
003	MUN 740	
		8' J
E. FRANKLIN	ST	12' CW
MUN 000	840	

Form 6 HPS (Rev. 1961)

91-17 EX #2
BB/SP
3-19-92

ROAD INVENTORY SHEET

Party Chief R. VOUGHT
Recorder L. COFFELT JR.
Chainman

HAGERSTOWN

VER
7-16-76

Road No. 7320
Name ALLEY #232
Sheet No. 1 OF 1
Date 10-30-63
County WASHINGTON

ALLEY	#222
0.05	
MVM	7220
Mealey ~~IRVIN~~	PKWY.
MVM 0.00	~~1720~~ 1620 (91-17 EX #2)

8' J
12' CW

Form 6 HPS (Rev. 1961)

AT

ROAD INVENTORY SHEET

Party Chief R. VOUGHT
Recorder L. COFFELT JR.
Chainman

VER
7-16-76

HAGERSTOWN

Road No. 7330
Name ALLEY #223
Sheet No. 1 OF 1
Date 10-30-63
County ~~WASHINGTON~~

ROAD END
0.08

ALLEY #223
MUN 7330 0.03

8'H
14'CW

0.00
ROAD END

Form 6 HPS (Rev. 1961)

AT

ROAD INVENTORY SHEET

Party Chief R. VOUGHT
Recorder L. JOFFELT JR.
Chainman

HAGERSTOWN

VER 7-16-76

Road No. 7360
Name ALLEY #236
Sheet No. 1 OF 1
Date 10-30-63
County WASHINGTON

Road End

016

W IRVIN AVE #2

MU 013 1132

12'H 16'CW

004 90°

90° 003

8'H 12'CW

LAUREL ST

MUN 000 1350

Form 6 HPS (Rev. 1961)

AT

ROAD INVENTORY SHEET

Party Chief R. VOUGHT
Recorder L. COFFELT JR.
Chainman

VER 7-20-76

Road No. 7380
Name ALLEY # 238
Sheet No. 1 OF 1
Date 11-5-63
County WASHINGTON

	E. BALTIMORE	ST	
	MUN 0.21	90	
↑ 65°	0.08		
	0.04	BALL FIELD	8' J
	MILL	ST	10' CW
	MUN 0.00	1670	

WILM TN

WIL

WM

Form 6 HPS (Rev. 1961)

ROAD INVENTORY SHEET

Party Chief R. VOUGHT
Recorder L. COFFELT JR.
Chainman

HAGERSTOWN VER 7-16-76

Road No. 7400
Name ALLEY #240
Sheet No. 1 OF 1
Date 10-30-63
County WASHINGTON.

PROPOSED

MAY MON 0 14 1570 S1

ALLEY MON 0 00 65 60 #156

8'H
12'CW

Form 6 HPS (Rev. 1961)

2 AT

ROAD INVENTORY SHEET

Party Chief R. VOUGHT
Recorder L. COFFELT JR.
Chainman

HAGERSTOWN VER 7-16-76

Road No. 7410
Name ALLEY #241
Sheet No. 1 OF 1
Date 10-30-63
County WASHINGTON

MOLLER	PKWY
MUN 0.05	1120
↑60 0.04	
	AVE
R. IRVIN ARO	
MUN	1130

8'J
11'CW

Form 6 HPS (Rev. 1961)

AT

ROAD INVENTORY SHEET

Party Chief R. VOUGHT
Recorder L. COFFELT JR.
Chainman

HAGERSTOWN

VER 7-16-76

Road No. 7420
Name ALLEY # 2A2
Sheet No. 1 OF 1
Date 10-30-63
County WASHINGTON

76-8

VIEW ST ← 0.04 →

PANGBORN BLVD
MUN 0.16 1900

0.06

VIEW ST
MUN 0.03 2420

ALLEY #150
MUN 0.00 1500

N 90°

8'H
12'CW

10'J
CURB RT
14'CW

✓ At

Form 6 HPS (Rev. 1961)

DT REV.
FR 4-18-79

ROAD INVENTORY SHEET

Party Chief R. VOUGHT
Recorder L. COFFELT JR.
Chainman

HAGERSTOWN

VER.
7-19-76

Road No. 7430
Name ALLEY #243
Sheet No. 1 OF 1
Date 10-28-63
County WASHINGTON

ROAD ~~END~~	
CONNECTICUT ~~ST.~~ AVE.	
MUN. 008	0530
ALLEY	# 225
MUN 000	7250

8 'J
10 'CW

Form 6 HPS (Rev. 1961)

AT

ROAD INVENTORY SHEET

Party Chief R. VOUGHT
Recorder L. COFFELT JR.
Chainman

VER
7-16-76

Road No. 7440
Name ALLEY #244
Sheet No. 1 OF 1
Date 11-5-63
County WASHINGTON

Alley #221
MUN 7210 007

8'J
10'CW

Alley #220
MUN 7200 000

AT

Form 6 HPS (Rev. 1961)

ROAD INVENTORY SHEET

Party Chief R. VOUGHT
Recorder L. COFFELT JR.
Chainman

VER 1-20-76

HAGERSTOWN

Road No. 7460
Name ALLEY #246
Sheet No. 1 OF 1
Date 10-29-63
County WASHINGTON

ALLEY	# 65
MUN 0.03	5650
LANDVALE	ST
MUN 0.00	1340

12'G
CURB LT
14'CW

Form 6 HPS (Rev. 1961)

✓ AT

ROAD INVENTORY SHEET

Party Chief R. VOUGHT
Recorder L. COFFELT JR.
Chainman

HAGERSTOWN

VER
7-19-76

Road No. 1470
Name ALLEY #247
Sheet No. 1 OF 1
Date 11-8-63
County WASHINGTON

ALLEY	#104	
0.04		
		8'E
MARYLAND	AVE	10'W
0.06		

Form 6 HPS (Rev. 1961)

AT

ROAD INVENTORY SHEET

Party Chief R. VOUGHT
Recorder L. COFFELT JR.
Chainman
HAGERSTOWN

VER
7-19-76

Road No. 7480
Name ALLEY # 248
Sheet No. 1 OF 1
Date 11-8-63
County WASHINGTON

MARYLAND AVE
MUN 003 1550

69-40
8'J 12'CW

~~8'~~
12'CW

ALLEY #105
MUN 000 6050

Form 6 HPS (Rev. 1961)

✓ AT

ROAD INVENTORY SHEET

Party Chief	R. VOUGHT	Road No.	7500
Recorder	L. COFFELT JR.	Name	ALLEY #250
Chainman		Sheet No.	1 OF 1
		Date	11-13-63
	HAGERSTOWN	County	WASHINGTON

VER 7-20-76

Road End

0 04

8'6

S. Locust St

10'cw

MUN 0 00 1430

Form 6 HPS (Rev. 1961)

✓ AT

ROAD INVENTORY SHEET

Party Chief R. VOUGHT

Recorder L. COFFELT JR.

Chainman

HAGERSTOWN

VER 7-20-76

Road No. 7530

Name ALLEY #253

Sheet No. 1 OF 1

Date 10-29-63

County WASHINGTON

DEVONSHIRE	RD.
MUN 0.08	630
NOTTINGHAM	RD.
MUN 0.00	1930

8'J
12'CW

Form 6 HPS (Rev. 1961)

✓ AT

ROAD INVENTORY SHEET

1501+19

Party Chief R. VOUGHT
Recorder L. COFFELT JR.
Chainman

HAGERSTOWN

VER 7-20-76

Road No. 7590
Name Alley #259
Sheet No. 1 of 1
Date 11-4-63
County WASHINGTON

Harmon ~~Ave~~	~~Harmon~~ AVE ~~Williams~~ AVE
MUN ~~[illegible]~~ 005 ~~[illegible]~~	~~MUN 2585~~ 0990
W. Church	ST
MUN 000	+10

8'H
12'CW

OFFICE

✓ Ar

~~ROAD~~ INVENTORY SHEET

Party Chief
Recorder Tuvele
Chainman

VER.
7-19-76

HAGERSTOWN

Road No. 7600
Name Alley 260
Sheet No. 1 of 1
Date 12-1-64
County WASHINGTON

MUN	7610	
ALLEY 0	14 261	^
		8'-J
		64-3
MUN	530	
CONNECTICUT 0	08 AVE	^
		8'-J
		65-7
MUN	7250	
ALLEY 0	00 225	Y

OFFICE
~~ROAD~~ INVENTORY SHEET

M ✓

Party Chief
Recorder Twele
Chainman

VER.
7-19-76

HAGERSTOWN

Road No. 7610
Name Alley 261
Sheet No. 1 of 1
Date 12-1-64
County WASHINGTON

RHODE ISLAND		AVE	
~~ROAD~~	0 06	~~END~~	^
			8'-J
ALLEY 260			64-6
MUN 7600	0 03		
INDIANA	0 00	AVE MU 1110	Y

OFFICE
~~ROAD~~ INVENTORY SHEET

✓ AT

Party Chief
Recorder Turle
Chainman

VER
7-19-76

HAGERSTOWN

Road No. 7620
Name Alley 262
Sheet No. 1 of 1
Date 12-1-64
County WASHINGTON

MUN		1540	
MARSHALL	0.08	ST	↑
			8'-J
			64-5
MUN		5810	
ALLEY	0.00	81	✓

Form 6 HPS (Rev. 1961)

AT

OFFICE
~~ROAD~~ INVENTORY SHEET

Party Chief TWELE
Recorder
Chainman

VER
2-20-76

HAGERSTOWN

Road No. 7640
Name ALLEY 264
Sheet No. 1 of 1
Date 2-28-66
County WASHINGTON

	9100	
MUN GERBER'S	0 04 ALLEY	
		8'-J
		65-5
		10' EW
MUN →	1+30 →	
LOCUST	0 00 ST	

Form 6 HPS (Rev. 1961)

AT

OFFICE COPY

~~ROAD~~ INVENTORY SHEET

Party Chief GRIFFIN
Recorder
Chainman

VER
7-20-76

Road No. 7650
Name ALLEY # 265
Sheet No. 1-1
Date 2-6-67
County WASHINGTON

HAGERSTOWN

ELM ST
MUN 750

0 13 8'-J
66-9

FREDERICK ST
US 40 0 00 40 AL

Form 6 HPS (Rev. 1961)

DAB

OFFICE
ROAD INVENTORY SHEET

Party Chief
Recorder
Chainman

VER.
7-20-76

HAGERSTOWN

Road No. 7660
Name ALLEY 266
Sheet No. 1 OF 1
Date 12-16-69
County WASHINGTON
69-35

ALLEY MUN	003 268 7680	
		8'H 12' CH
WATER MUN	000 ST 2520	

Form 6 HPS (Rev. 1961)

D.A.B.

AT

OFFICE ROAD INVENTORY SHEET

Party Chief
Recorder
Chainman

VER
7-26-76

HAGERSTOWN

Road No. 7670
Name ALLEY 267
Sheet No. 1 OF 1
Date 12-16-69
County WASHINGTON
69-35

ALLEY MUN	0.03	268 7650	^
			8'H 12'SW
WATER MUN	0.00	ST 2520	Y

Form 6 HPS (Rev. 1961)

DAB

AT ✓

OFFICE
ROAD INVENTORY SHEET

Party Chief
Recorder
Chainman

VED.
7-20-76

HAGERSTOWN

Road No. 7680
Name ALLEY 268
Sheet No. 1 OF 1
Date 1 OF 1
County WASHINGTON
69-37

CORP LMTS AVE HAGERSTOWN
PARK
CO
007 477

ALLEY 266
003 MUN 7660

8'H
12'CW

ALLEY 267
000 MUN 7670

Form 6 HPS (Rev. 1961)

DAB

(92-31) BG-AH 4-1-73

AT

OFFICE ROAD INVENTORY SHEET

Party Chief
Recorder
Chainman

VER 7-20-76

HAGERSTOWN

Road No. 7690
Name ALLEY 209
Sheet No. 1 OF 1
Date 12-16-69
County WASHINGTON

69-39

KINSLOW ~~MITCHELL~~ MUN	005 ST 1700	
		8'J
90°	002	
MECHANIC MUN	000 ST 1630	

SHA 51.3-8
11-15-72

STATE HIGHWAY ADMINISTRATION OF MARYLAND

✓ AT

ROAD INVENTORY SHEET

7720

Party Chief T. LANDON
Recorder E. RHODES
Helper

Road No. MUN. ~~[illegible]~~
Road Name ALLEY W.
Sheet No. 1 OF 1
Date 2/20/75
County WASHINGTON
State Coordinates

Map No. 74-47 VER. 7-20-76

HAGERSTOWN

N

ROAD END
0 08

E. WILSON BLVD.
MUN. 0 00
2600

12'G
15'CW

SHA 51.3-8
11-15-72

ROAD INVENTORY SHEET

Road No. _____
Road Name _____
Sheet No. _____
Date _____
County _____
State Coordinates _____

Form 6 HPS (Rev. 1961)

AT

ROAD INVENTORY SHEET

Party Chief T. LANDON
Recorder W. WARFIELD
Helper

VER
7-20-76
72-16

Road No. MU 7700
Road Name AL. 270
Sheet No. 1 OF 1
Date 2-6-73
County WASH

ROAD 009 END		↑ 8' I
		2-3' E SHLD.
KEY	CIR.	16' CW
MUN. 000 1282		✓

Form 6 HPS (Rev. 1961)

ROAD INVENTORY SHEET

Road No. _____

Road Name _____

Sheet No. _____

Date _____

County _____

SHA 51.3-8
11-15-72

STATE HIGHWAY ADMINISTRATION OF MARYLAND

ROAD INVENTORY SHEET

Party Chief BR
Recorder FR.
Helper

Map No. 80-12
HAGERSTOWN

Road No. MUN. 7710
Road Name ALLEY 271
Sheet No. 1 OF 1
Date 4-15-81
County WASH
State Coordinates

ALLEY MU.	0 03	30. 5300	
90°	0 02		
			10'I 10'CW
JAMES MUN.	0 00	ST. 1200	

SHA 51.3-8
11-15-72

ROAD INVENTORY SHEET

Road No. _____
Road Name _____
Sheet No. _____
Date _____
County _____
State Coordinates _____

Form 6 HPS (Rev. 1961)

A1

ROAD INVENTORY SHEET

Party Chief R. VOUGHT
Recorder L. COFFELT JR.
Chainman

VGR
7-20-76

HAGERSTOWN

Road No. 9010
Name BERKSON Alley
Sheet No. 1 OF 1
Date 11-4-63
County WASHINGTON

W. Church St.
MUN 005 440

16'H
CURBLT
16'CW

002

20'H
20'CW

WELLERS ALLEY
MUN 000 ~~9150~~ 9160

Form 6 HPS (Rev. 1961)

M✓

ROAD INVENTORY SHEET

Party Chief R. VOUGHT
Recorder L. COFFELT JR.
Chainman

VER
7-20-76

Road No. 9020
Name BIXLERS ALLEY
Sheet No. 1 OF 1
Date 11-5-63
County WASHINGTON

S. MULBERRY		ST	
MUN	020	1760	
			10'J
		~~ALLEY #194~~	12'CW
	015	~~MUN 6440~~	
LOCUST		ST	
← ONE WAY MUN	010	1430	8'J
~~CRAMER~~		~~ALLEY~~	12'CW
ALLEY	000	20 MV 5200	

SHA 51.3-8
11-15-72

STATE HIGHWAY ADMINISTRATION OF MARYLAND

2001 MU Ex#3
3-14-02
GD/EF

ROAD INVENTORY SHEET

Party Chief R Vought
Recorder L Coffelt Jr
Helper

Map No.
Rewrit 11-23-81
Vere 7-20-76 HAGERSTOWN

Road No. 9030
Road Name BLOOMS ALLEY
Sheet No. 1 of 1
Date 10-31-63
County WASHINGTON
State Coordinates

ROAD	0 07	END	
			10'S
		ALLEY 176	12'CW
ENT TO TH	0 02	MU 6760	
(JONATHAN'S		ST)	
~~US~~ MU	0 00	~~H~~ 1230	

SHA 51.3-8
11-15-72

ROAD INVENTORY SHEET

Road No. _____
Road Name _____
Sheet No. _____
Date _____
County _____
State Coordinates _____

Form 6 HPS (Rev. 1961)

ROAD INVENTORY SHEET

Party Chief R. VOUGHT
Recorder L. COFFELT JR.
Chainman

HAGERSTOWN

VER. 7-20-76

Road No. 9040
Name BRAXTON ALLEY
Sheet No. 1 OF 1
Date 11-4-63
County WASHINGTON

WELLERS	ALLEY
MUN 0.05	9160
W. Church	ST
MUN 0.10	440

8' J
12' CW

Form 6 HPS (Rev. 1961)

AJ

ROAD INVENTORY SHEET

Party Chief R. Vought
Recorder L. Coffelt, Jr.
Chainman

VER
7-20-76

Road No. 9050
Name Burger Alley
Sheet No. 1 of 1
Date 11-12-63
County Wash.

Gerber S MUN	0 07	Alley 9100
S. Locust MUN	0 00	St. MUN

8' T
10' CW.

Form 6 HPS (Rev. 1961)

AT

ROAD INVENTORY SHEET

Party Chief R. Vought
Recorder L. Coffelt, Jr.
Chainman

VER. 7-20-76

Road No. 9060
Name Court Alley
Sheet No. 1 of 1
Date 10-29-63
County Wash.

Alley 68 MUN 5680	002	
Elgin MUN 0	00	Blvd 720

10'H
13'C.W.

Form 6 HPS (Rev. 1961)

A/T

ROAD INVENTORY SHEET

Party Chief R. Vought
Recorder L. Coffelt, Jr.
Chainman

VER 7-20-76

Road No. 9070
Name Cramers Alley
Sheet No. 1 of 2
Date 11-13-63
County Wash.

Wayside → MUN	0 52	→ Ave. 2540	
	0 47	Alley 197 MUN 6970	8'J 10'C.W.
	0 42		X
Broadway MUN	0 41	240	10'J 10'C.W.
	0 40		X
	0 36	Alley 201 MUN 7010	8'J 10'C.W.
North MUN	0 31	Ave. 1790	X
			12'J 12'C.W.
	0 29		X
	0 26	Alley 145 MUN 6450	
Randolph MUN →	0 21	→ Ave. 2050	
	0 16	Alley 146 MUN 6460	
East MUN	0 10	Ave. 690	8'J 9'C.W.
	0 05	Alley 139 MUN 6390	X
			10'J 10'C.W.
E. Franklin US ← East MUN 5200	0 00	St 40	✓
	← ALLEY #20		

ONE WAY

Form 6 HPS (Rev. 1961)

A|T

ROAD INVENTORY SHEET

Party Chief R. Vought
Recorder L. Coffelt, Jr.
Chainman

VER 7-20-76

Road No. 9070
Name Cramers Alley
Sheet No. 2 of 2
Date 11-13-63
County Wash.

Fairground Ave.
MUN 0 63 780
0 62 30° ~~8' J~~ 79-28 8' J
10' C.W.
Alley 200
0 58 MUN 7200

Form 6 HPS (Rev. 1961)

AT 88-23 A/T

ROAD INVENTORY SHEET

Party Chief R. VOUGHT
Recorder L. COFFELT J.
Chainman

HAGERSTOWN

VGR 7-20-75

Road No. 9080
Name Cromers Alley
Sheet No. 1 OF 1
Date 11-12-63
County WASHINGTON

E. Lee		St	
MUN	008	1360	
		Bester St	
	004	MUN 150	
			10' J
Bromers		Ave	14' CW
MUN	000	250	

Form 6 HPS (Rev. 1961)

87-17 A/T

AT

ROAD INVENTORY SHEET

Party Chief R. VOUGHT
Recorder L. COFFELT JR.
Chainman

HAGERSTOWN

VCR
7-20-76

Road No. 9082
Name CROMERS ALLEY #2
Sheet No. 1 OF 1
Date 11-12-63
County WASHINGTON

RAY		ST	
MUN	0.11	2080	
		ALLEY #171	
	0.08	MUN 6710	8'-I 80-19/20
		CD 0.00	
ELM.		ST	
MUN	0.05	750	
		ALLEY #172	
	0.03		
			8'J
E. LEE		ST	10'CW
MUN	0.00	1360	

Form 6 HPS (Rev. 1961)

AT

ROAD INVENTORY SHEET

Party Chief E. SCHUYLER
Recorder T. DOMBROSKI
Helper

Road No. 9090
Road Name (CUSHWA'S ALLEY)
Sheet No. 1 OF 1
Date 4-30-71
County WASHINGTON

VER 7-20-76

MUN 760
EUTAW 018 PL

VS
~~MUN~~ ~~0300~~ "
BURHANS 017 BLVD

MUN 5730
006 ALLEY #73

MUN 5740
ALLEY #74 005 COURT AV. 14'E/0.01 PARKING FOR 4 VECHICES

2500
ST

MUN
W. WASHINGTON 000

8' J
8' CW

Form 6 HPS (Rev. 1961)

ROAD INVENTORY SHEET

Road No. _____

Road Name _____

Sheet No. _____

Date _____

County _____

Form 6 HPS (Rev. 1961)

✓ AT

ROAD INVENTORY SHEET

Party Chief R. VOUGHT
Recorder L. COFFELT JR.
Chainman

HAGERSTOWN

VER 7-20-75

Road No. 9100
Name GERBERS ALLEY
Sheet No. 1 OF 1
Date 11-12-63
County WASHINGTON

MUN	1360	
E. LEE		
ALLEY # 264 0.15	ST	
0.13		
BURGER ALLEY		
MUN 9050 0.05		
		8.0
E. BALTIMORE		10 CW
~~MUN~~ US 0.00 ~~40~~	ST	
	40 ALT	

Form 6 HPS (Rev. 1961)

✓ AT

ROAD INVENTORY SHEET

Party Chief R. Vought
Recorder C. Coffelt, Jr.
Chainman

VER
7-20-76

Road No. 9110
Name ~~Alley #19~~ (Hayes Alley)
Sheet No. 1 of 1
Date 11-13-63
County Wash.

71-36

Rochester Pl
Mu 2130

W. Washington St.
← East U.S. 0 11 40

Alley #9
MUN 5090 0 08

(Wareham Pl.) #2
0 06 MUN 2490

79-27

10' J
10' C.W.

one - Way

W. Franklin St.
U.S. 0 00 40 West

Market Pl
Mu 1530

Form 6 HPS (Rev. 1961)

94 MUEX #1
BB/AH 12-7-94

AT

ROAD INVENTORY SHEET

Party Chief R. VOUGHT
Recorder L. COFFELT JR.
Chainman

HAGERSTOWN

VER
7-20-76

Road No. 9120
Name LIBRARY ALLEY
Sheet No. 1 OF 1
Date 11-12-63
County WASHINGTON

ROCHESTER ~~MARKET~~		PL	
MUN	0 20	2130	
COURT ~~[illegible]~~			8'J
~~COURT~~ ~~[illegible]~~ Barricade Removed		~~COURT~~ PL	10'CW
MU ~~[illegible]~~	0 13	~~[illegible]~~ 0565	
SUMMIT		AVE.	12'H 14'CW
MUN	0 10	~~2300~~ 2301	
			8'J
S. PROSPECT		ST	10'CW
MUN	000	2020	

71-33

Form 6 HPS (Rev. 1961)

AT

ROAD INVENTORY SHEET

Party Chief R. VOUGHT
Recorder L. COFFELT JR.
Chainman

VER 7-20-76

T. LANDON
F. RHODES
2/20/75 REVISED

Road No. 9130
Name RODGERS ALLEY
Sheet No. 1 OF 1
Date 11-5-63
County WASHINGTON

(RICHMOND ST.)
MUN. 0 20 2110

~~Road End~~
0 17 90°

9' J
~~8' E~~
12' CW

0 14

8' J
12' CW

E. FRANKLIN ST
MUN 0 11 840

LIBERTY ST
MUN 0 05 1390

CLEVELAND ST

67-34 8' J 12' CW
67-35 8' J 12' CW

10' E
12' CW

0 00
Road End

FCR-97
GD, MP
11/11/97

4T

Form 6 HPS (Rev. 1961)

ROAD INVENTORY SHEET

Party Chief R. VOUGHT
Recorder L. COFFELT JR.
Chainman

HAGERSTOWN VER 7-20-76

Road No. 9140
Name SUSAN ALLEY
Sheet No. 1 OF 1
Date 10-31-63
County WASHINGTON

JONATHAN ST
MU ~~OS~~ 005 ~~11~~ 1230

8'J
9'CW

003

8'H
C-C

SUMANS ~~PARK~~ ~~SUMANS~~ ~~PL~~ ~~AVE~~ AVE
MUN 000 1940

ΔT

Form 6 HPS (Rev. 1961)

ROAD INVENTORY SHEET

Party Chief R. Vought
Recorder L. Coffelt, Jr.
Chainman

VER.
7-20-76

Road No. 9150
Name Suter Alley
Sheet No. 1 of 1
Date 11-13-63
County Wash.

W. Church MUN 0 11 440 St.

0 05 Harmon Ave ~~Williams~~ MUN 990

8·J
12·CW.

W. Bethel MUN 0 00 160 St. ← one way

Bethlines Ave
MU 0965

Form 6 HPS (Rev. 1961)

A/T

ROAD INVENTORY SHEET

Party Chief R. VOUGHT
Recorder L. COFFELT JR.
Chainman

HAGERSTOWN

VER 7-20-76

Road No. 9160
Name WELLERS ALLEY
Sheet No. 1 OF 1
Date 11-4-63
County WASHINGTON

N. PROSPECT		ST	
MUN ←	0 20	← 2030	
		BRAXTON ALLEY	8'K 10'CW
	0 17	MUN 9040	
		BERKSON AVE	
PKING LOT	0 13	MUN 9010	8'J 10'CW
JONATHAN		ST	
US	0 10	11	8'H 10'CW
	0 07	MUN PKING LOT	18'J CURB LT
	0 03	MUN PKING LOT	18'J C-C
MARKET		P.L	
MUN	0 00	1530	

8'J 70:32