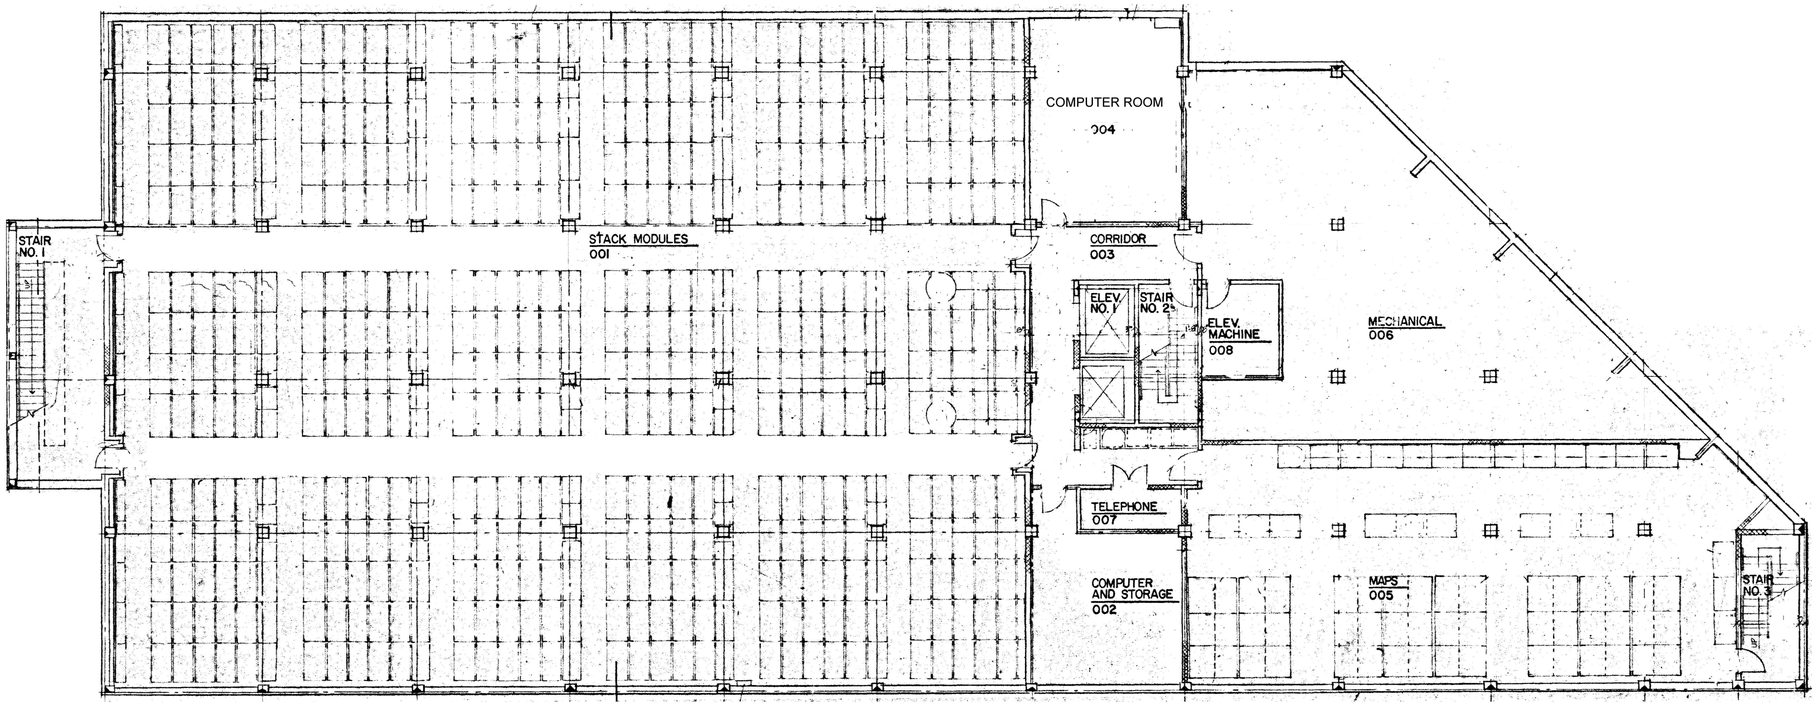

VVKR 81204

ARCHITECTURAL REGISTRATION BOARD 2864 STATE OF MARYLAND

VVKR Incorporated
Architecture Engineering Planning

USING AGENCY APPROVAL
TITLE State Curator 8/10/83 DATE

DEPARTMENT OF GENERAL SERVICES APPROVAL
PROJECT ADMINISTRATOR 8/17/83 DATE
DIRECTOR, ENGR. & CONST. 8/17 DATE

Revisions	Date

LOWER LEVEL -

Maryland State Archives Building
Annapolis, Maryland

Dwg. A-4 of
DGS No. BA-000-767-001
Date: APRIL 15, 1983
Scale:

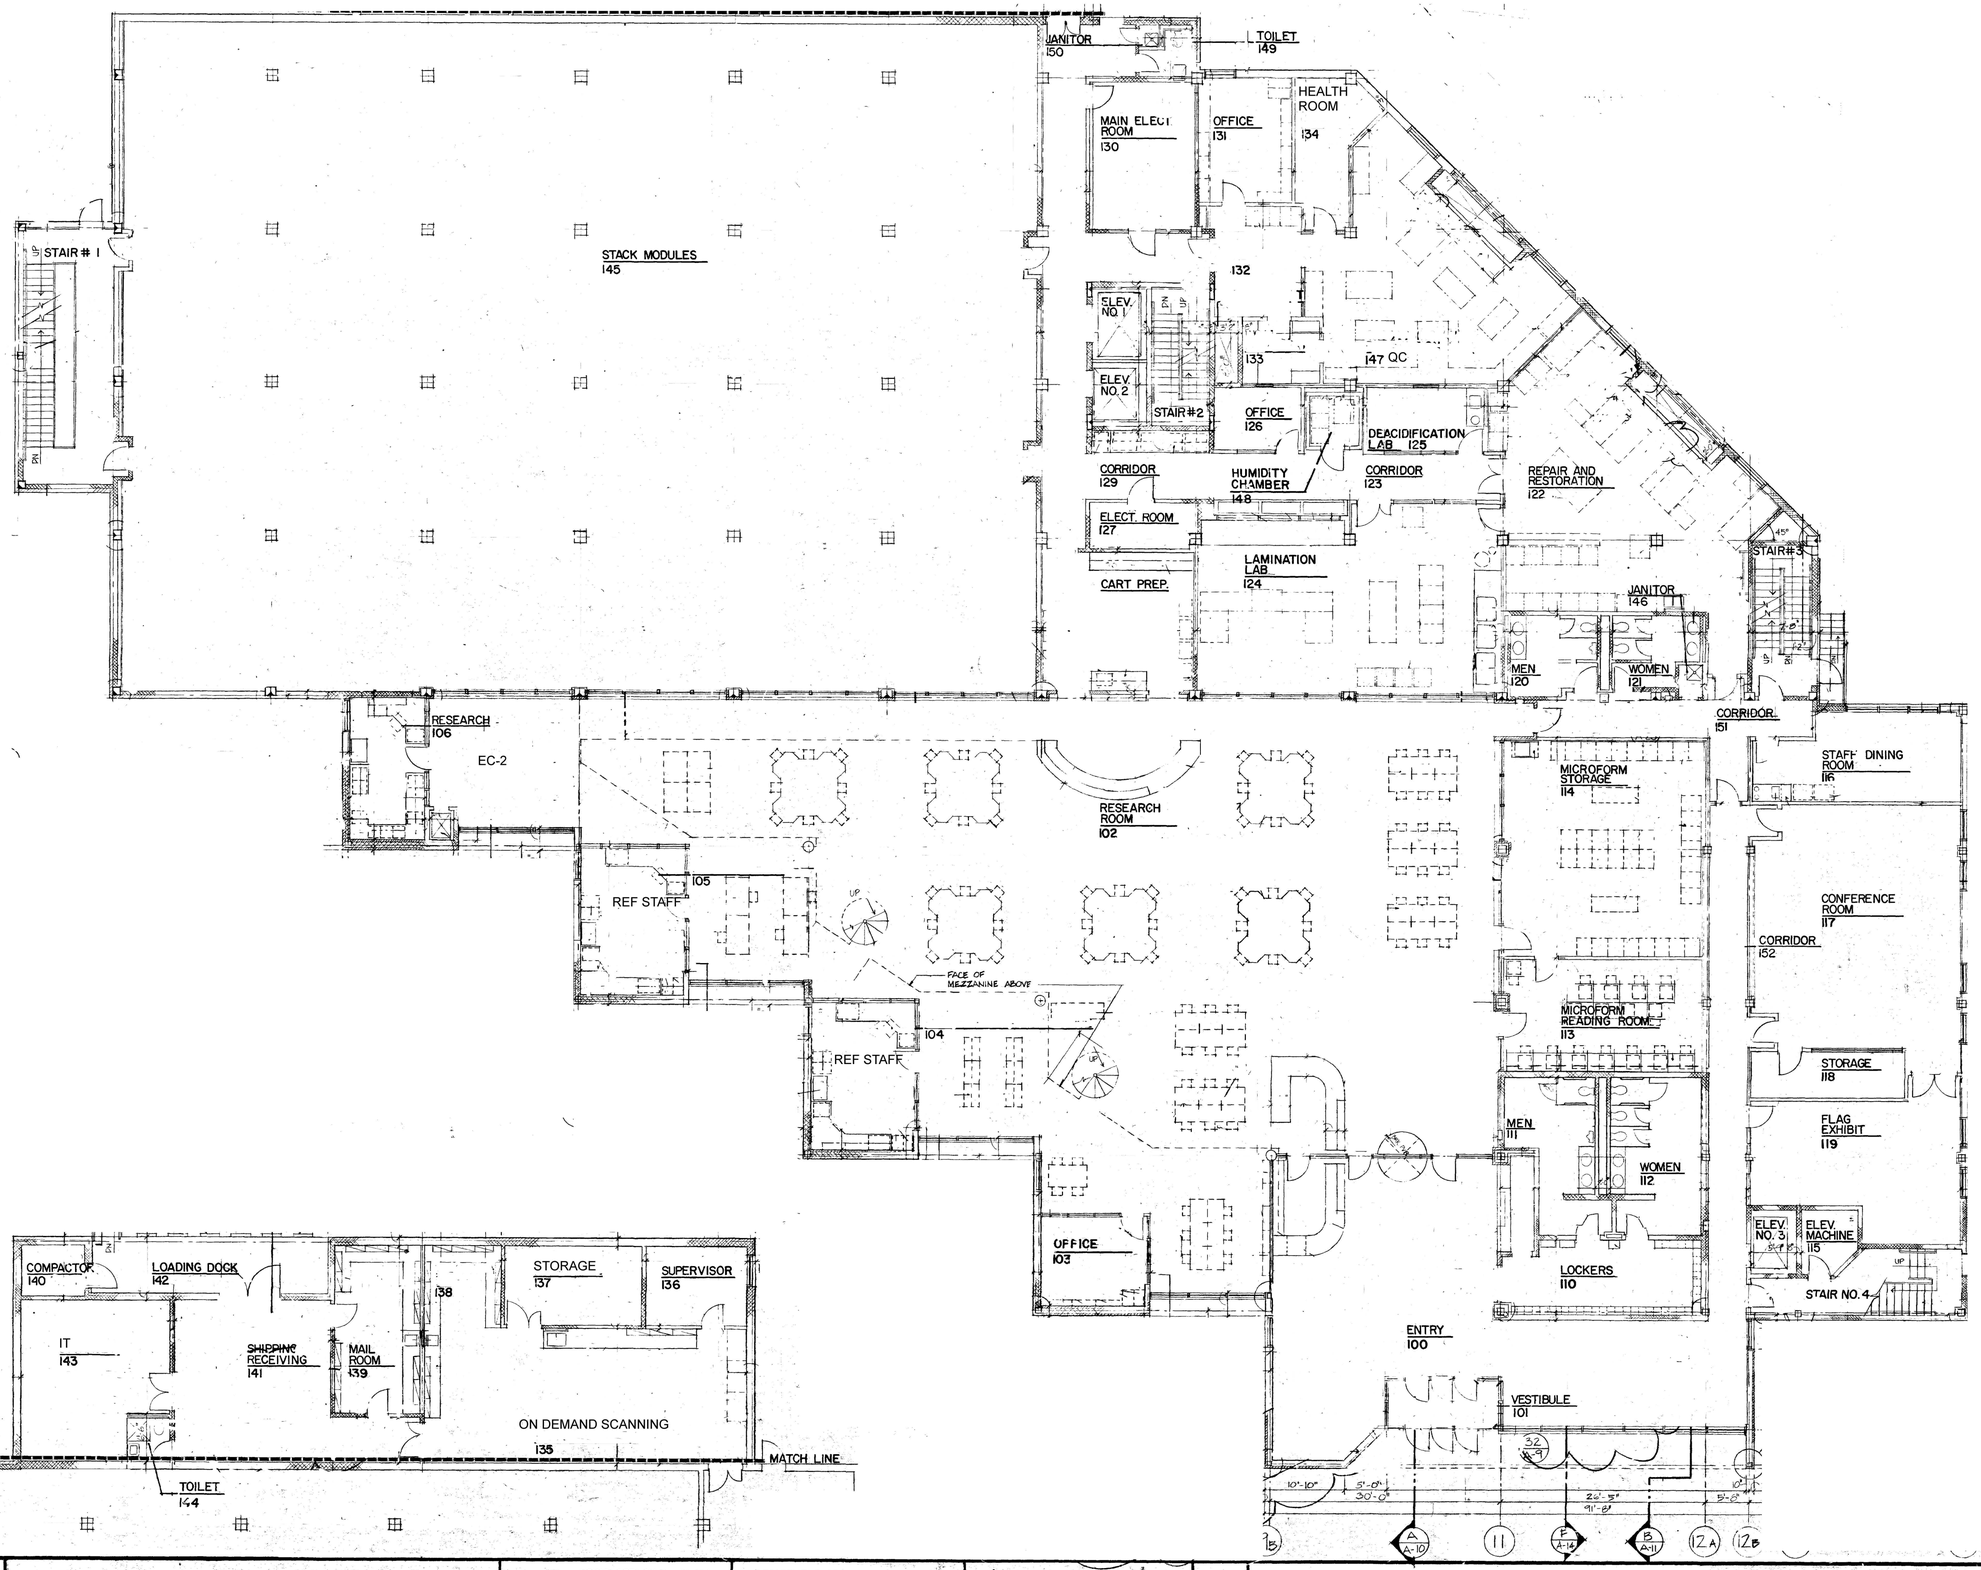

VVKR 81204

ARCHITECTURAL REGISTRATION BOARD 2964-R STATE OF MARYLAND

VVKR Incorporated
Architecture Engineering Planning

USING AGENCY APPROVAL
Edward K. Rogerson 8/10/83
TITLE State Archivist DATE

DEPARTMENT OF GENERAL SERVICES APPROVAL
PROJECT ADMINISTRATOR 8/17/83 DATE
DIRECTOR, ENGR. & CONST. 8/17 DATE

Revisions	Date
⚠ REVISED FOR RECORD DRAWINGS	8/7/87

LEVEL ONE

Maryland State Archives Building
Annapolis, Maryland

Dwg. A-5 of
DGS No. BA-000-767-001
Date: APRIL 15, 1983
Scale: AS SHOWN

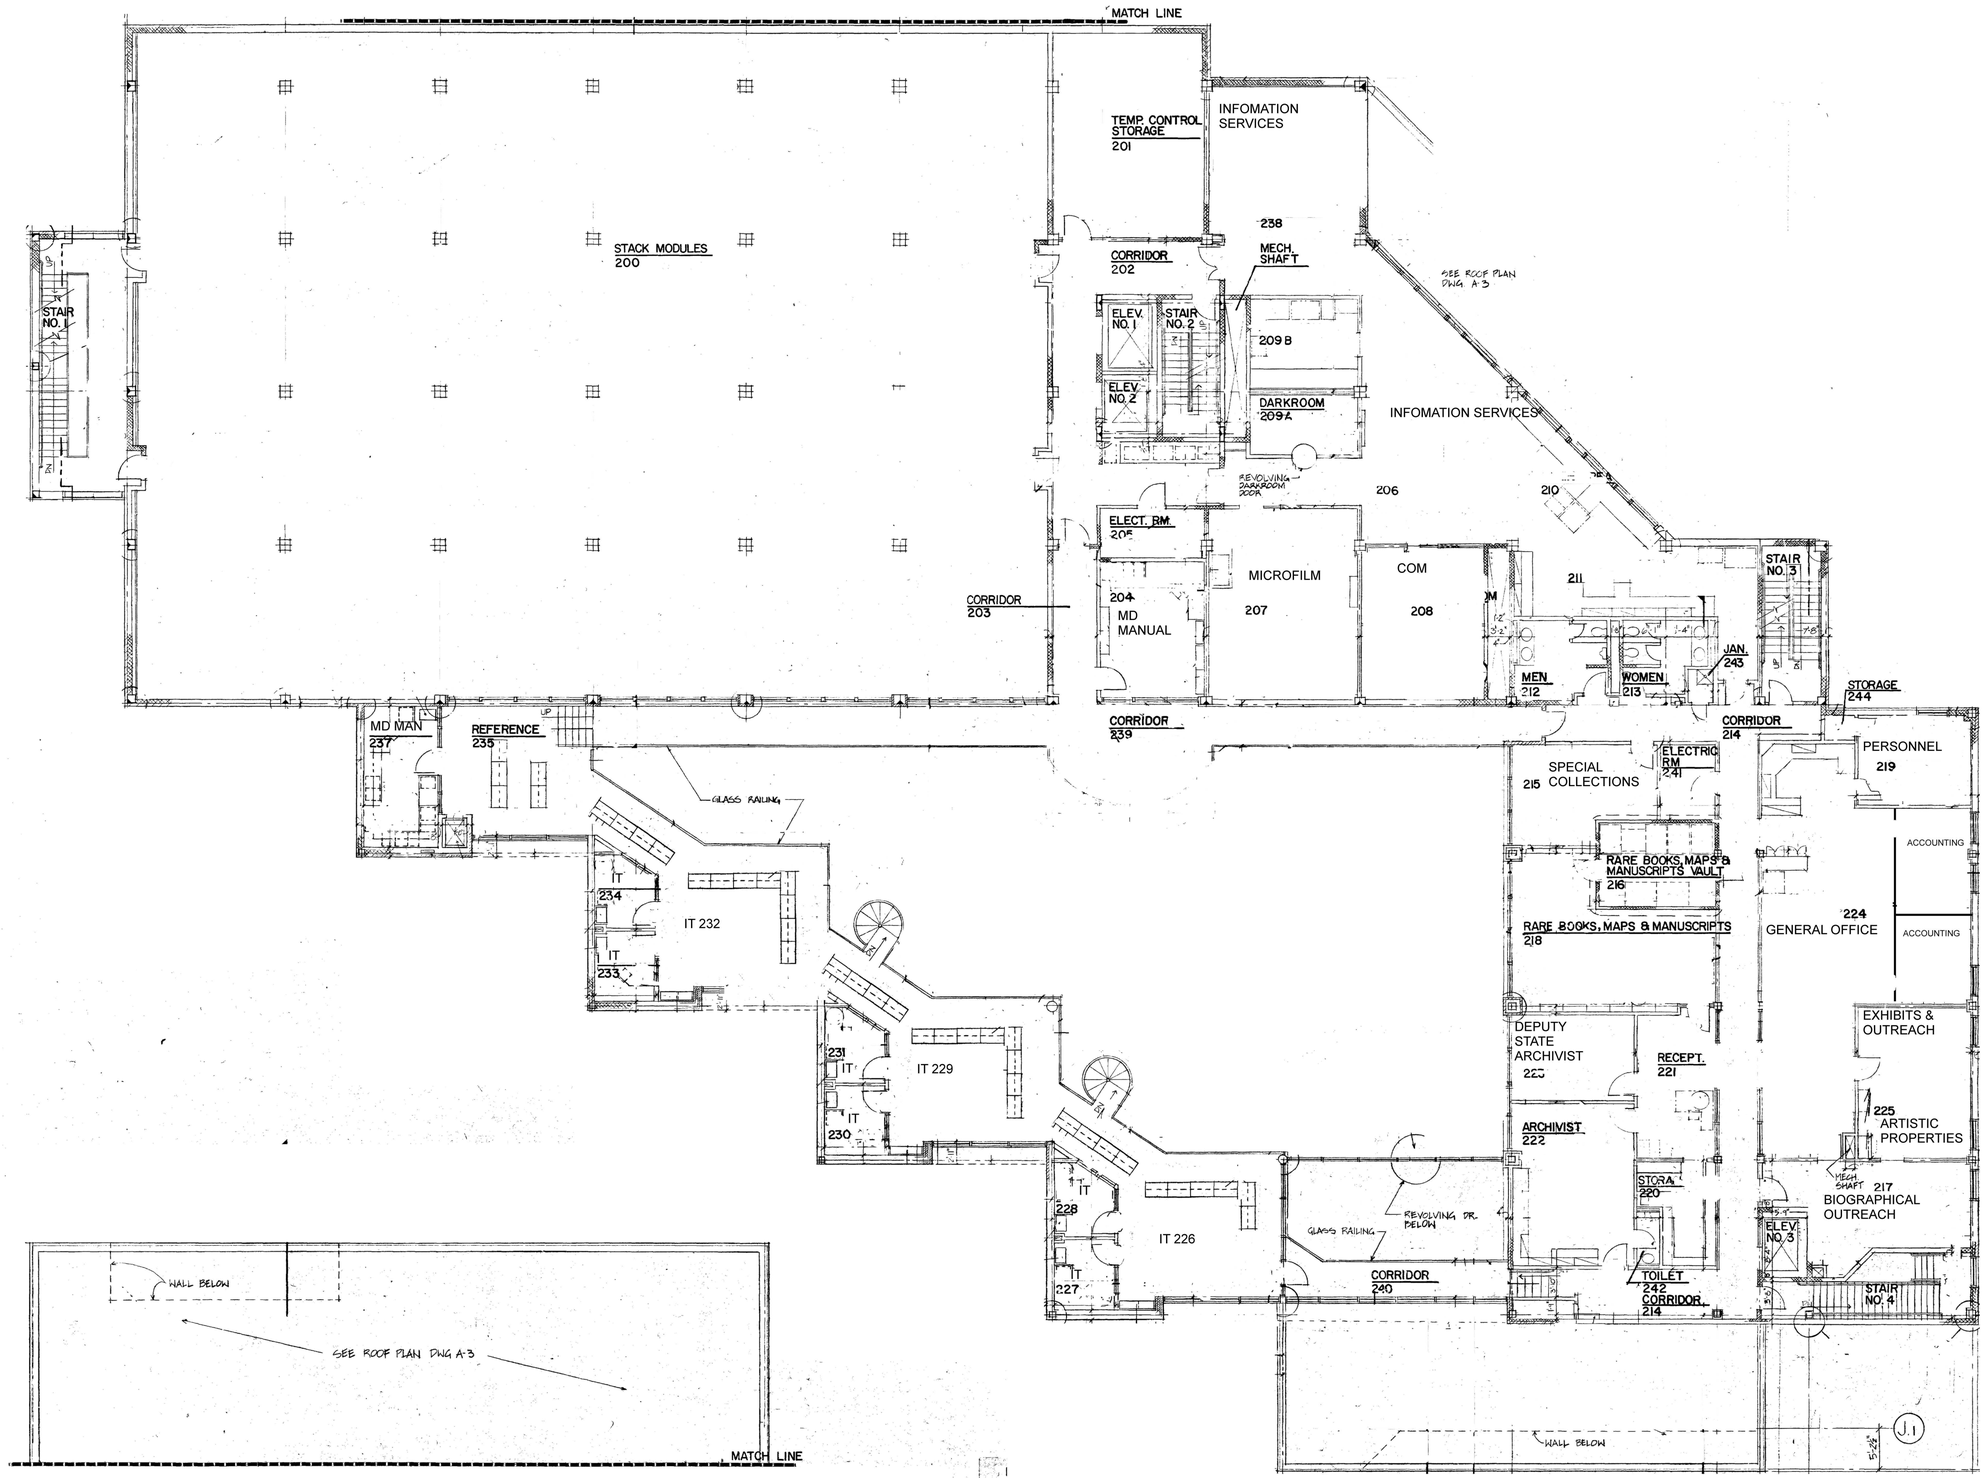

This drawing has been amended by incorporating information received from the Contractor represented to VVKR Inc. as the "AS-BUILT" conditions.

SCALE 0 4 8 16 FT

VVKR 81204

ARCHITECTURAL REGISTRATION BOARD 2064-R STATE OF MARYLAND

VVKR Incorporated
Architecture Engineering Planning

USING AGENCY APPROVAL
TITLE _____ DATE 5/2/83

DEPARTMENT OF GENERAL SERVICES APPROVAL
PROJECT ADMINISTRATOR DATE 8/17/87
DIRECTOR, ENGR. & CONST. DATE 8/17

Revisions	Date
⚠ REVISED FOR RECORD DRAWINGS	8/7/87

LEVEL TWO AND MEZZANINE

Maryland State Archives Building
Annapolis, Maryland

Dwg. A-6 of
DGS No. BA-000-767-001
Date: APRIL 15, 1983
Scale: AS SHOWN

STAIR NO. 1

STACK MODULES 300

SPECIAL COLLECTION 301

NOTE: SEE P.M.004 SHEET A-4 FOR COMPACT SHELVING

CORRIDOR 302

ELEV. NO. 1 6'-11"

ELEV. NO. 2

STAIR NO. 2

MECH. SHAFT

SPECIAL COLLECTION 303

MECHANICAL 304

MECHANICAL SHAFT

STAIR NO. 3

SHIP'S LADDER SEE DETAIL

SEE ROOF PLAN DWG. A-3

SLOPE UP

SEE ROOF PLAN DWG A-3

WALL BELOW

WALL BELOW

RECORD DRAWING

This drawing has been amended by incorporating information received from the Contractor represented to VVKR Inc. as the "AS-BUILT" conditions.

ADD 3.27

NORTH

SCALE 0 4 8 16FT

VVKR 81204

ARCHITECTURAL REGISTRATION BOARD 2864-R STATE OF MARYLAND

VVKR Incorporated
Architecture Engineering Planning

USING AGENCY APPROVAL

TITLE State Archivist DATE 8/16/83

DEPARTMENT OF GENERAL SERVICES APPROVAL

PROJECT ADMINISTRATOR DATE 8/17/83

DIRECTOR, ENGR. & CONST. DATE 8/17

Revisions	Date
⚠ REVISED FOR RECORD DRAWINGS	8/17/87

LEVEL THREE

Maryland State Archives Building
Annapolis, Maryland

Dwg. A-7 of

DGS No. BA-000-767-001

Date: APRIL 15, 1983

Scale: AS SHOWN